



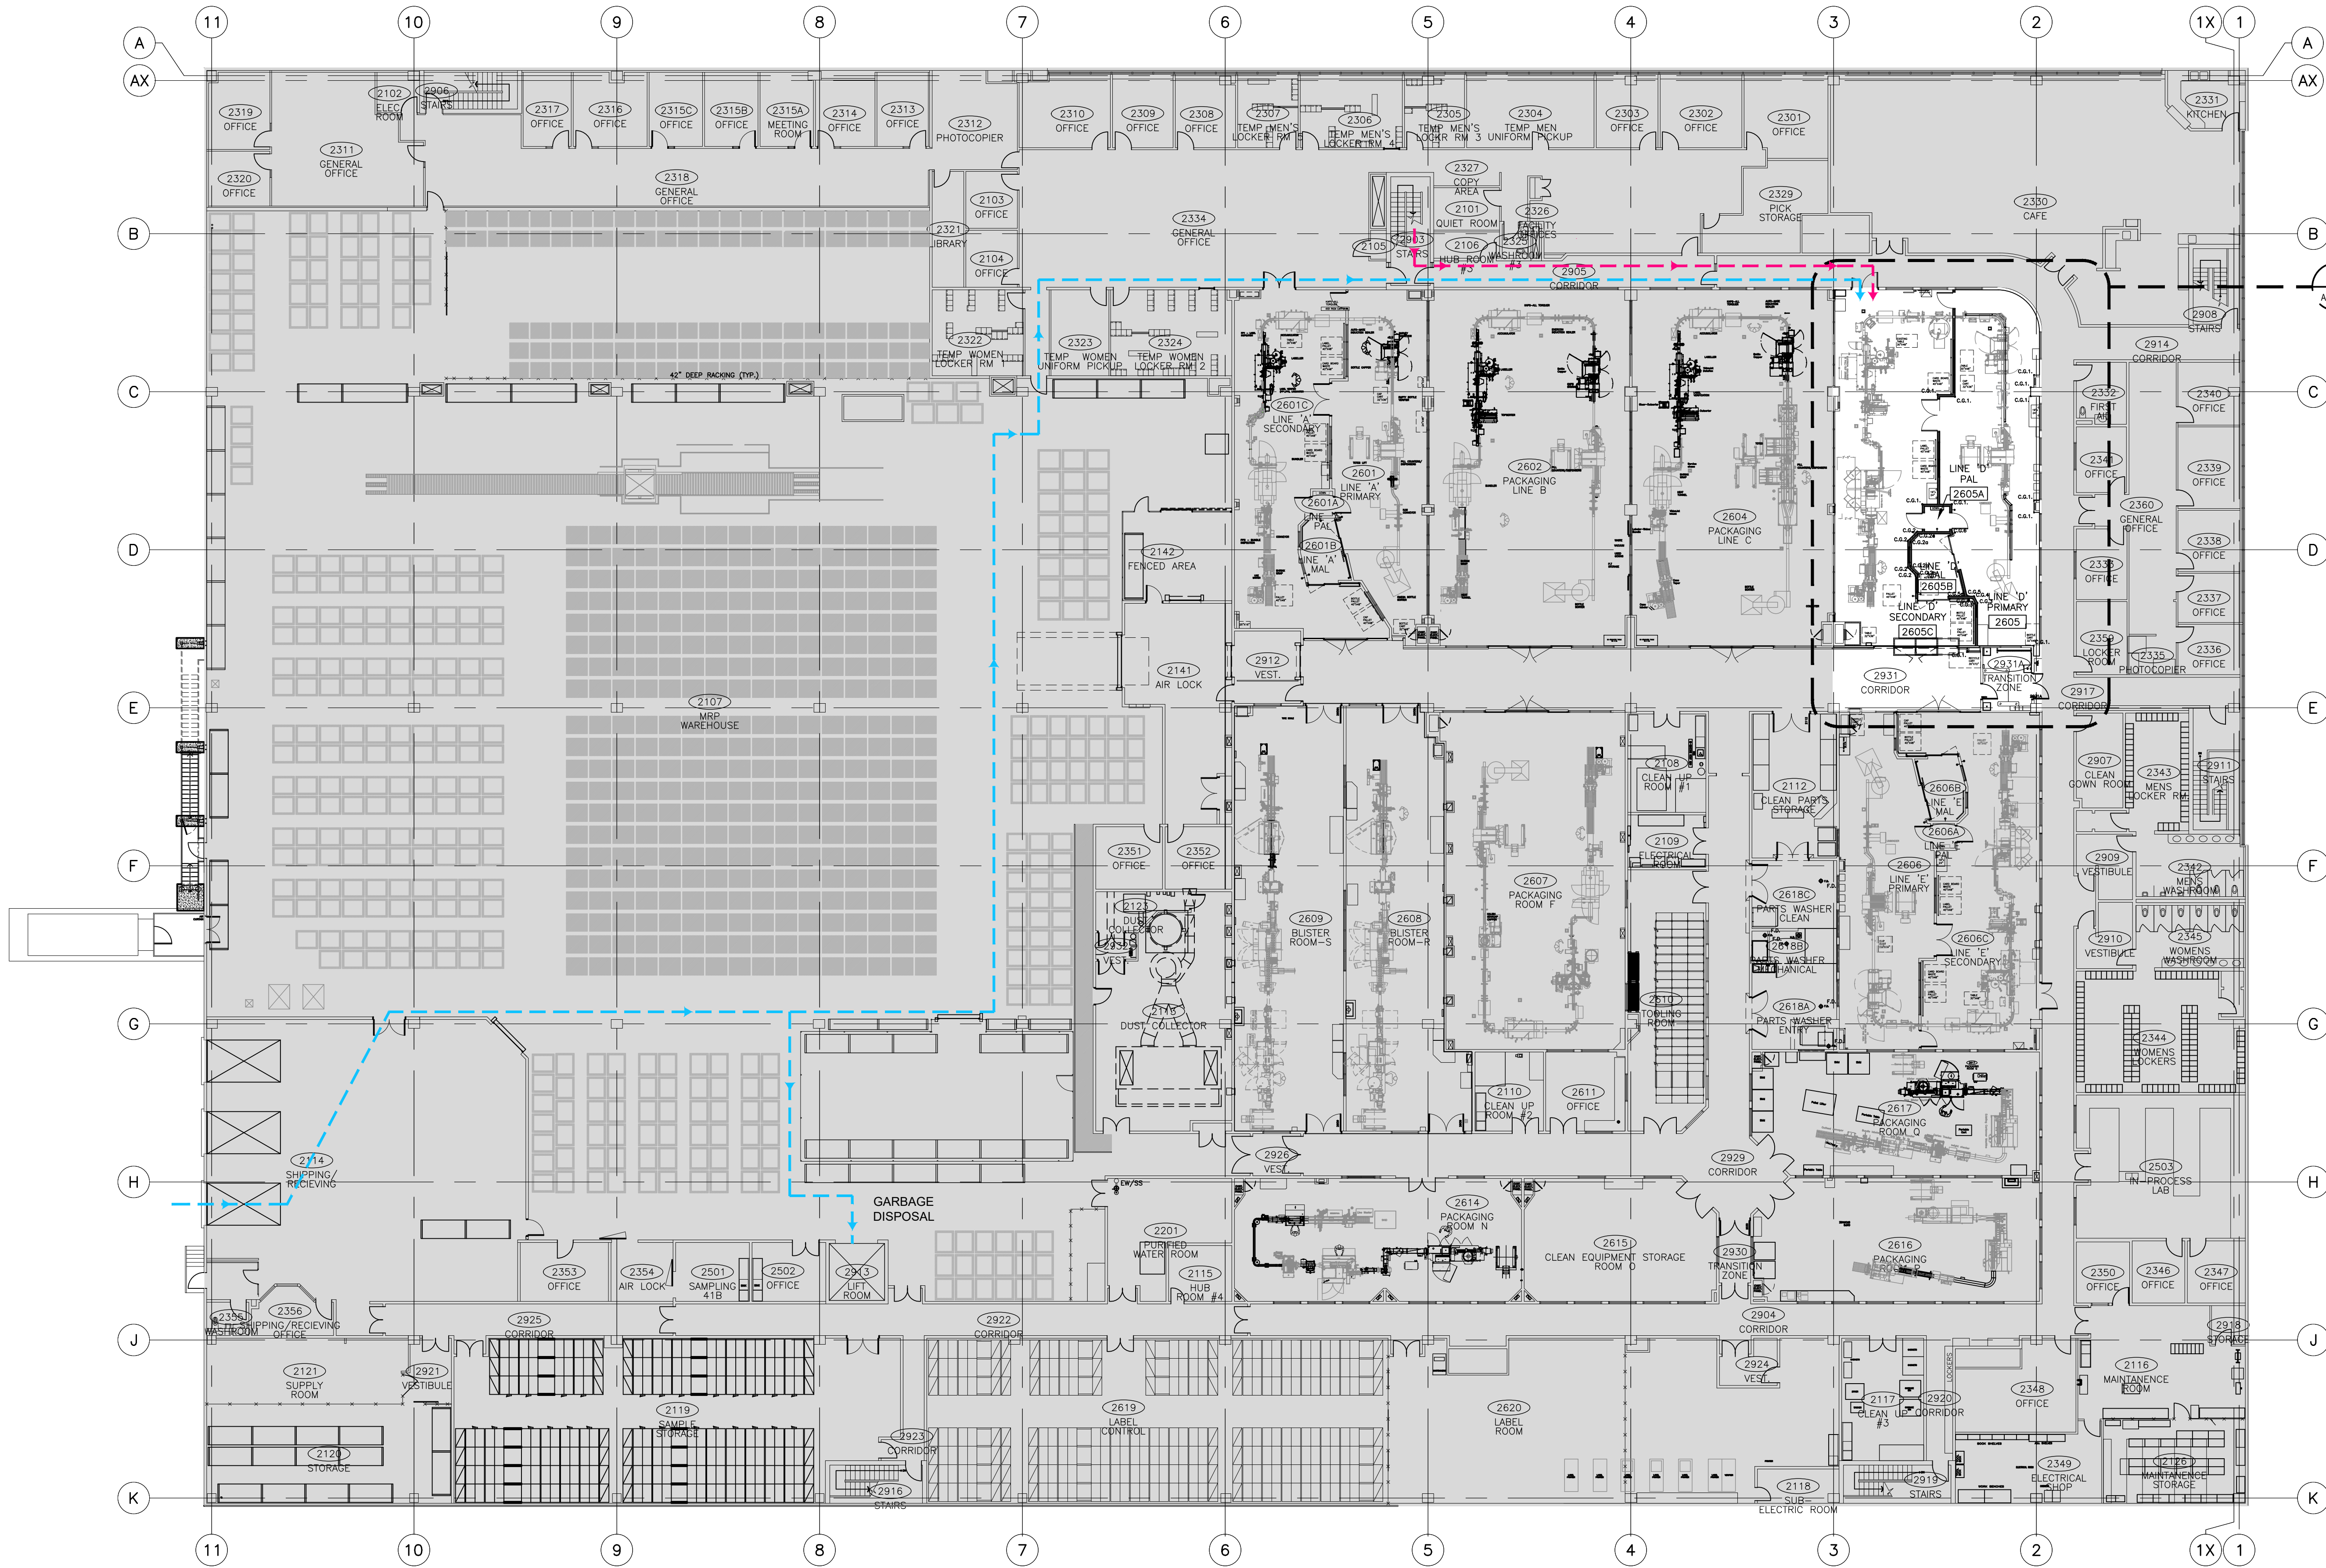

CONFIDENTIALITY NOTE:
This drawing shall not be copied, reproduced or distributed in any manner without the expressed written approval of APOTEX INC. or their designated agents.

No.	Date	Issued	By:
A	2023-11-23	ISSUED FOR REVIEW	WBA
B	2024-01-12	ISSUED FOR 30% REVIEW	WBA
C	2024-02-01	ISSUED FOR 60% REVIEW	WBA
D	2024-02-09	ISSUED FOR PERMIT	WBA
E	2024-02-15	ISSUED FOR 90% REVIEW	WBA
F	2024-02-21	ISSUED FOR TENDER	WBA

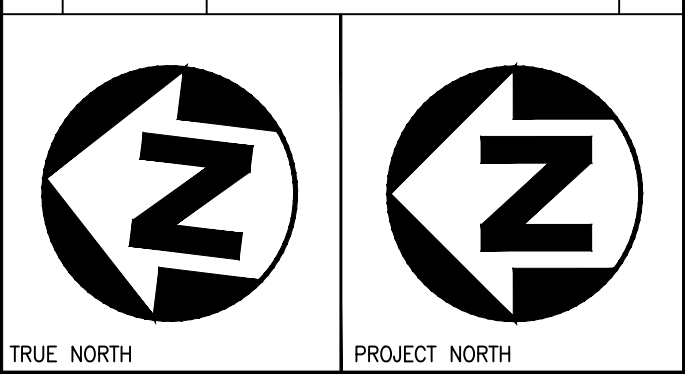

KEY PLAN N.T.S.

- LEGEND
- EXISTING AREA TO REMAIN
 - INTERIOR ALTERATION
- CONSTRUCTION FLOW
- CONSTRUCTION MATERIAL IN/ OUT
 - CONSTRUCTION PERSONNEL FLOW

No.	Date	Revision	By:
1	2024-10-21	ISSUED FOR AS-BUILT	WBA
2	2024-04-23	ISSUED FOR CONSTRUCTION	WBA

Contractor must check and verify all dimensions and be responsible for same, reporting any discrepancies to the Architect or Engineer before commencing work.
Prints shall not be used for construction until signed 'Approved For Construction' by the Architect or Engineer.
Prints are not to be scaled.



Client:
wba
architects and engineers inc.


Client:
APOTEX INC.
CANADA'S PHARMACEUTICAL COMPANY

Project Title:
**4100 WESTON ROAD, TORONTO
PACKAGING UPGRADES LINE 'D'**

Drawing Title:
**SECOND FLOOR REFERENCE
PLAN**

CAO System and Version:	Plot Scale:	Sheet Size:
Designed By: G.S.S. Date: NOV/2023	1:1	30" x 42"
Drawn By: J.A.J. Date: NOV/2023		
Checked By: G.S.S. Date: NOV/2023	Approved By: G.S.S. Date: NOV/2023	

Drawing Scale:	Consultant Project No.:	Consultant Day No.:
AS NOTED	2231108	A112
Apotex Project No.:	Site No.:	System:
4101-505	4101	AP PP
		02
		1

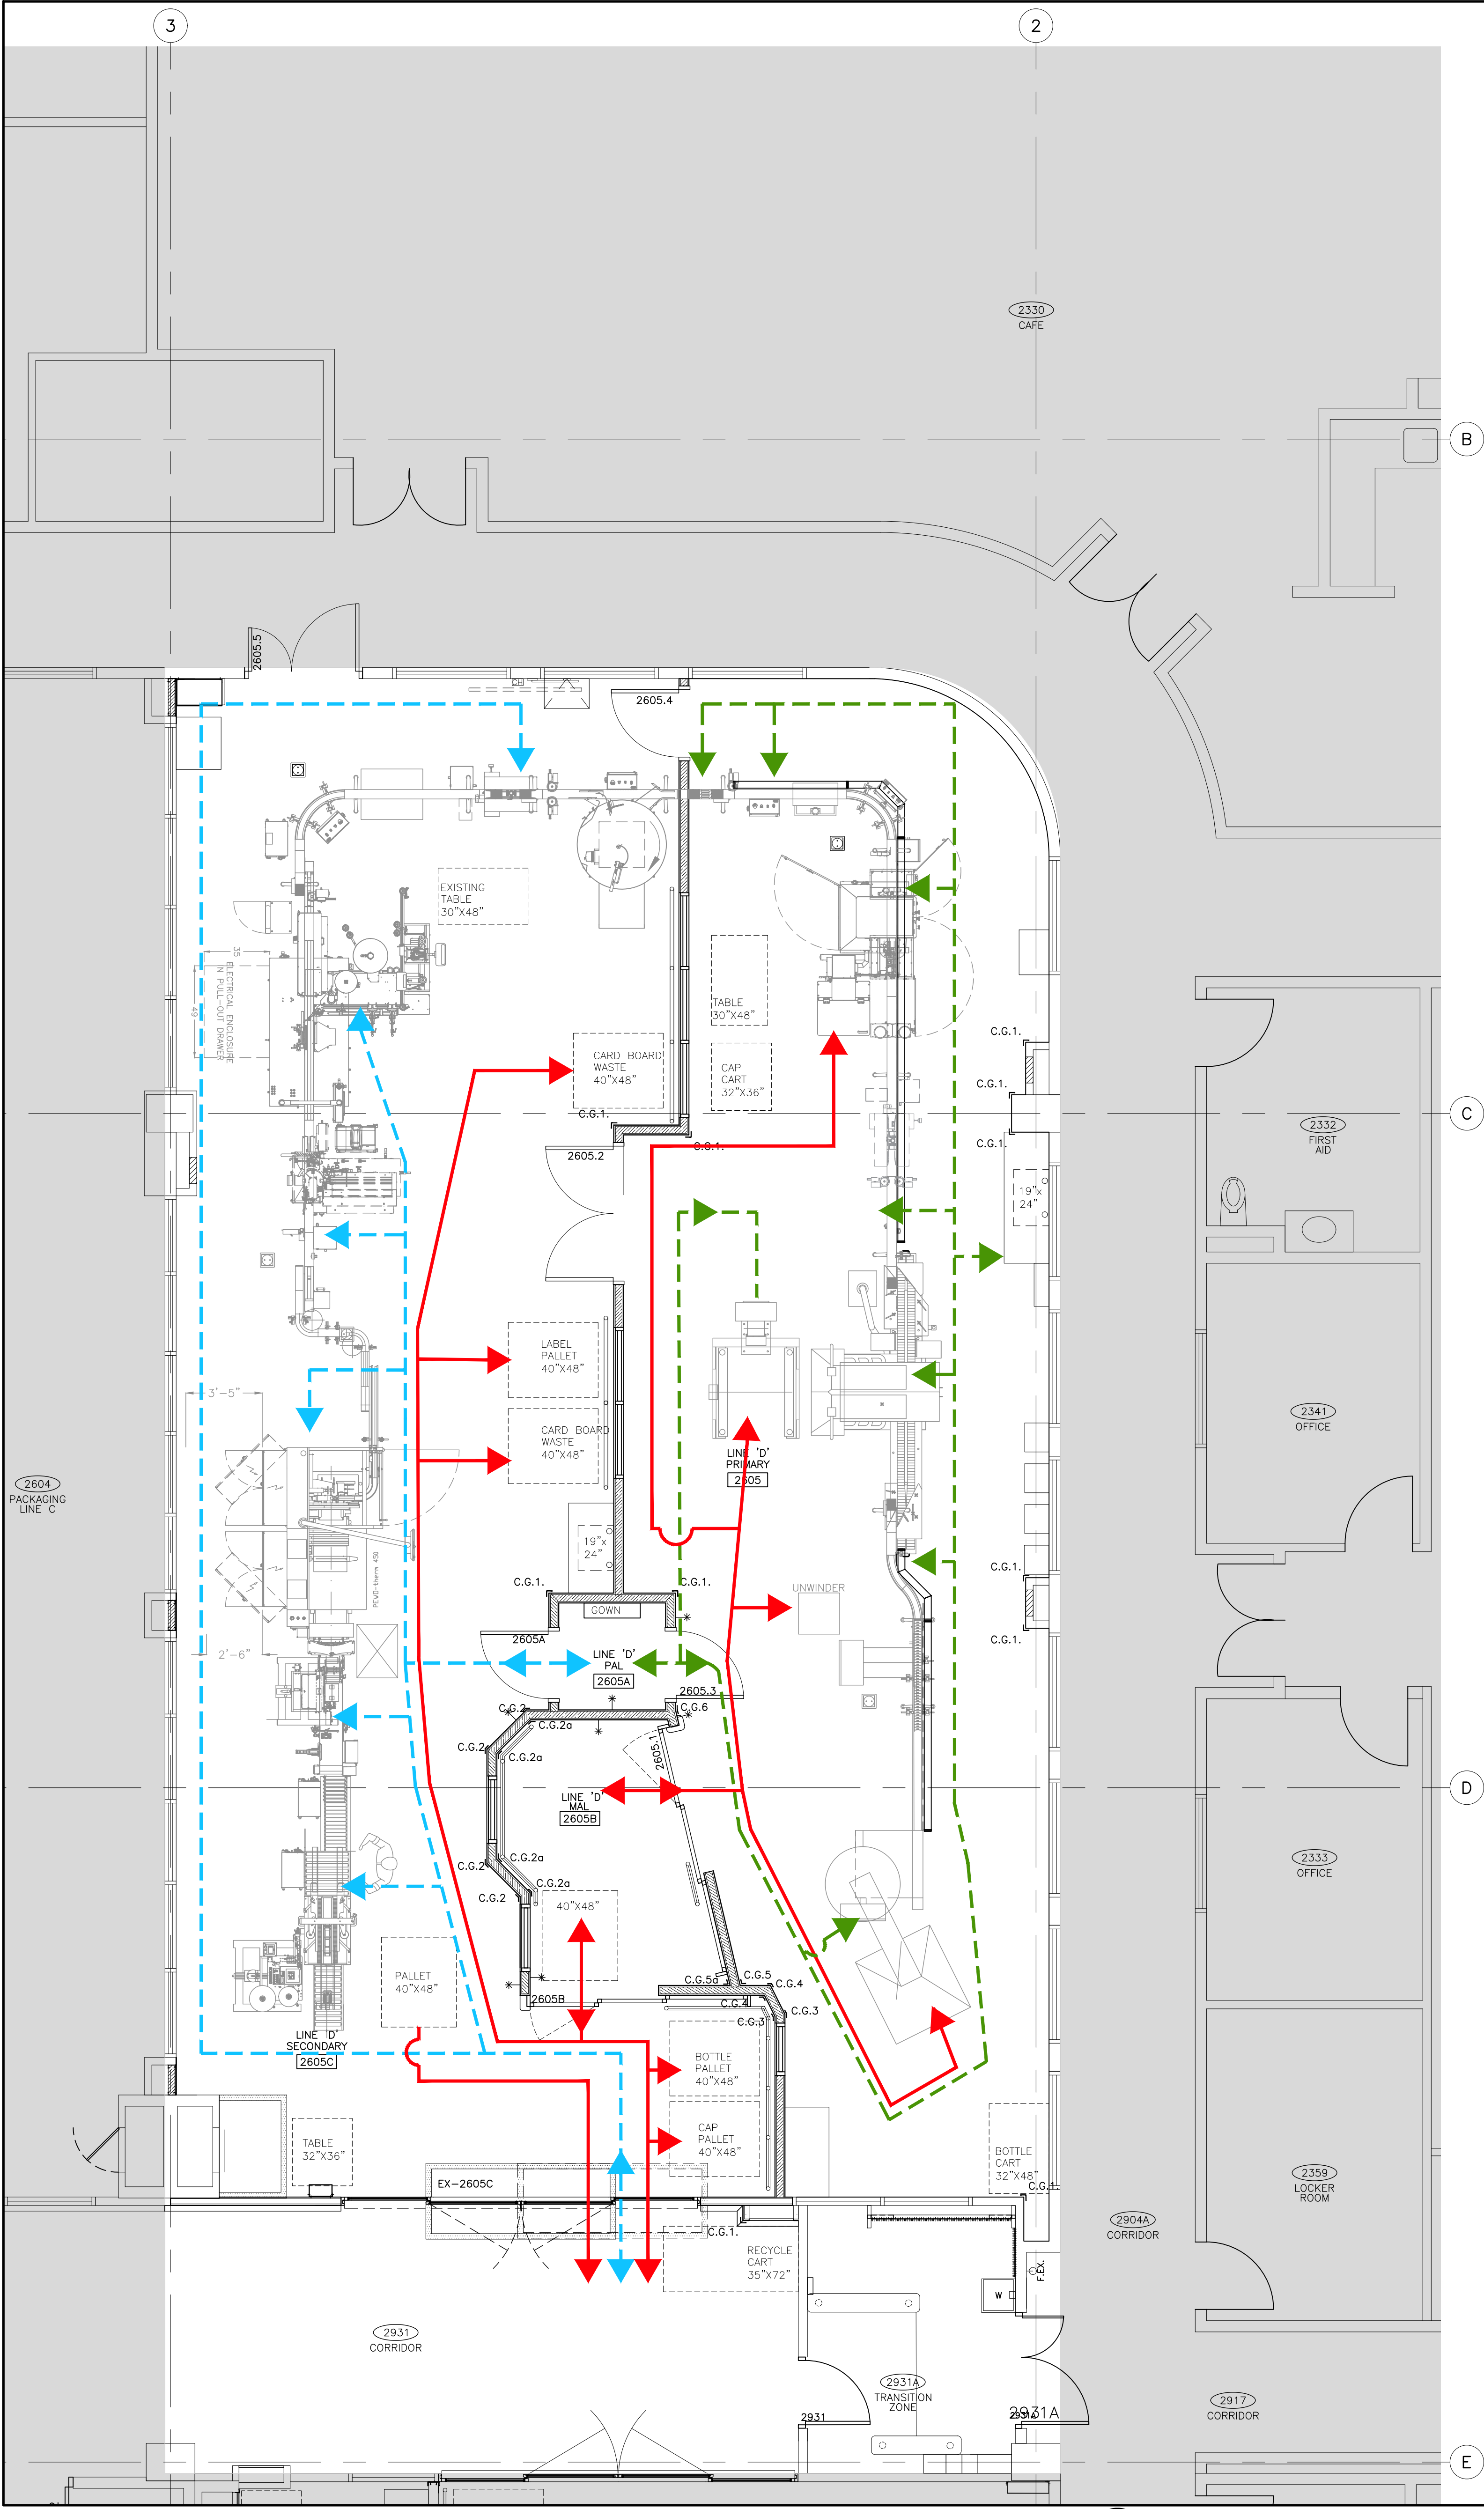

1
AP-PE-03
NEW SECOND FLOOR PLAN
1/4\"/>

CONFIDENTIALITY NOTE:
This drawing shall not be copied, reproduced or distributed in any manner without the expressed written approval of APOTEX INC. or their designated agents.

No.	Date	Issued	By:
A	2024-01-10	ISSUED FOR 30% REVIEW	WBA
B	2024-02-01	ISSUED FOR 60% REVIEW	WBA
C	2024-02-09	ISSUED FOR PERMIT	WBA
D	2024-02-15	ISSUED FOR 90% REVIEW	WBA

PEOPLE AND MATERIAL FLOW

- PERSONNEL FLOW PRIMARY (Green dashed arrow)
- PERSONNEL FLOW SECONDARY (Blue dashed arrow)
- MATERIAL FLOW (Red solid arrow)

No.	Date	Revision	By:
0	2024-10-21	ISSUED FOR AS-BUILT	WBA

Contractor must check and verify all dimensions and be responsible for same, reporting any discrepancies to the Architect or Engineer before commencing work.
Prints shall not be used for construction until signed "Approved For Construction" by the Architect or Engineer.
Prints are not to be scaled.

Professional Seal(s)

Consultant:

Client:

Project Title:
4100 WESTON ROAD, TORONTO
PACKAGING UPGRADES LINE 'D'

Drawing Title:
NEW SECOND FLOOR PLAN
PEOPLE AND MATERIAL FLOW

CADD System and Version:	Plot Scale:	Sheet Size:
G.S.S. NOV/2023	1:1	30" x 42"

Designed By:	Date:	Drawn By:	Date:
G.S.S. NOV/2023	NOV/2023	J.A.J.	NOV/2023

Checked By:	Date:	Approved By:	Date:
G.S.S. NOV/2023	NOV/2023	G.S.S.	NOV/2023

Drawing Scale:	Consultant Project No.	Consultant Draw No.
AS NOTED	2231108	A120

Apotex Project No.:	Site No.:	Discipline:	System:	Seq. No.:	Rev.:
4101-505	4101	AP	PM	03	0


CADD File Name: 4101-505-03-00.dwg
Plot Date: 2024-10-21 14:30



4101-505	4101 AP PE 02	1
----------	---------------	---





2 SECOND FLOOR NEW PLAN
1/4"=1'-0"

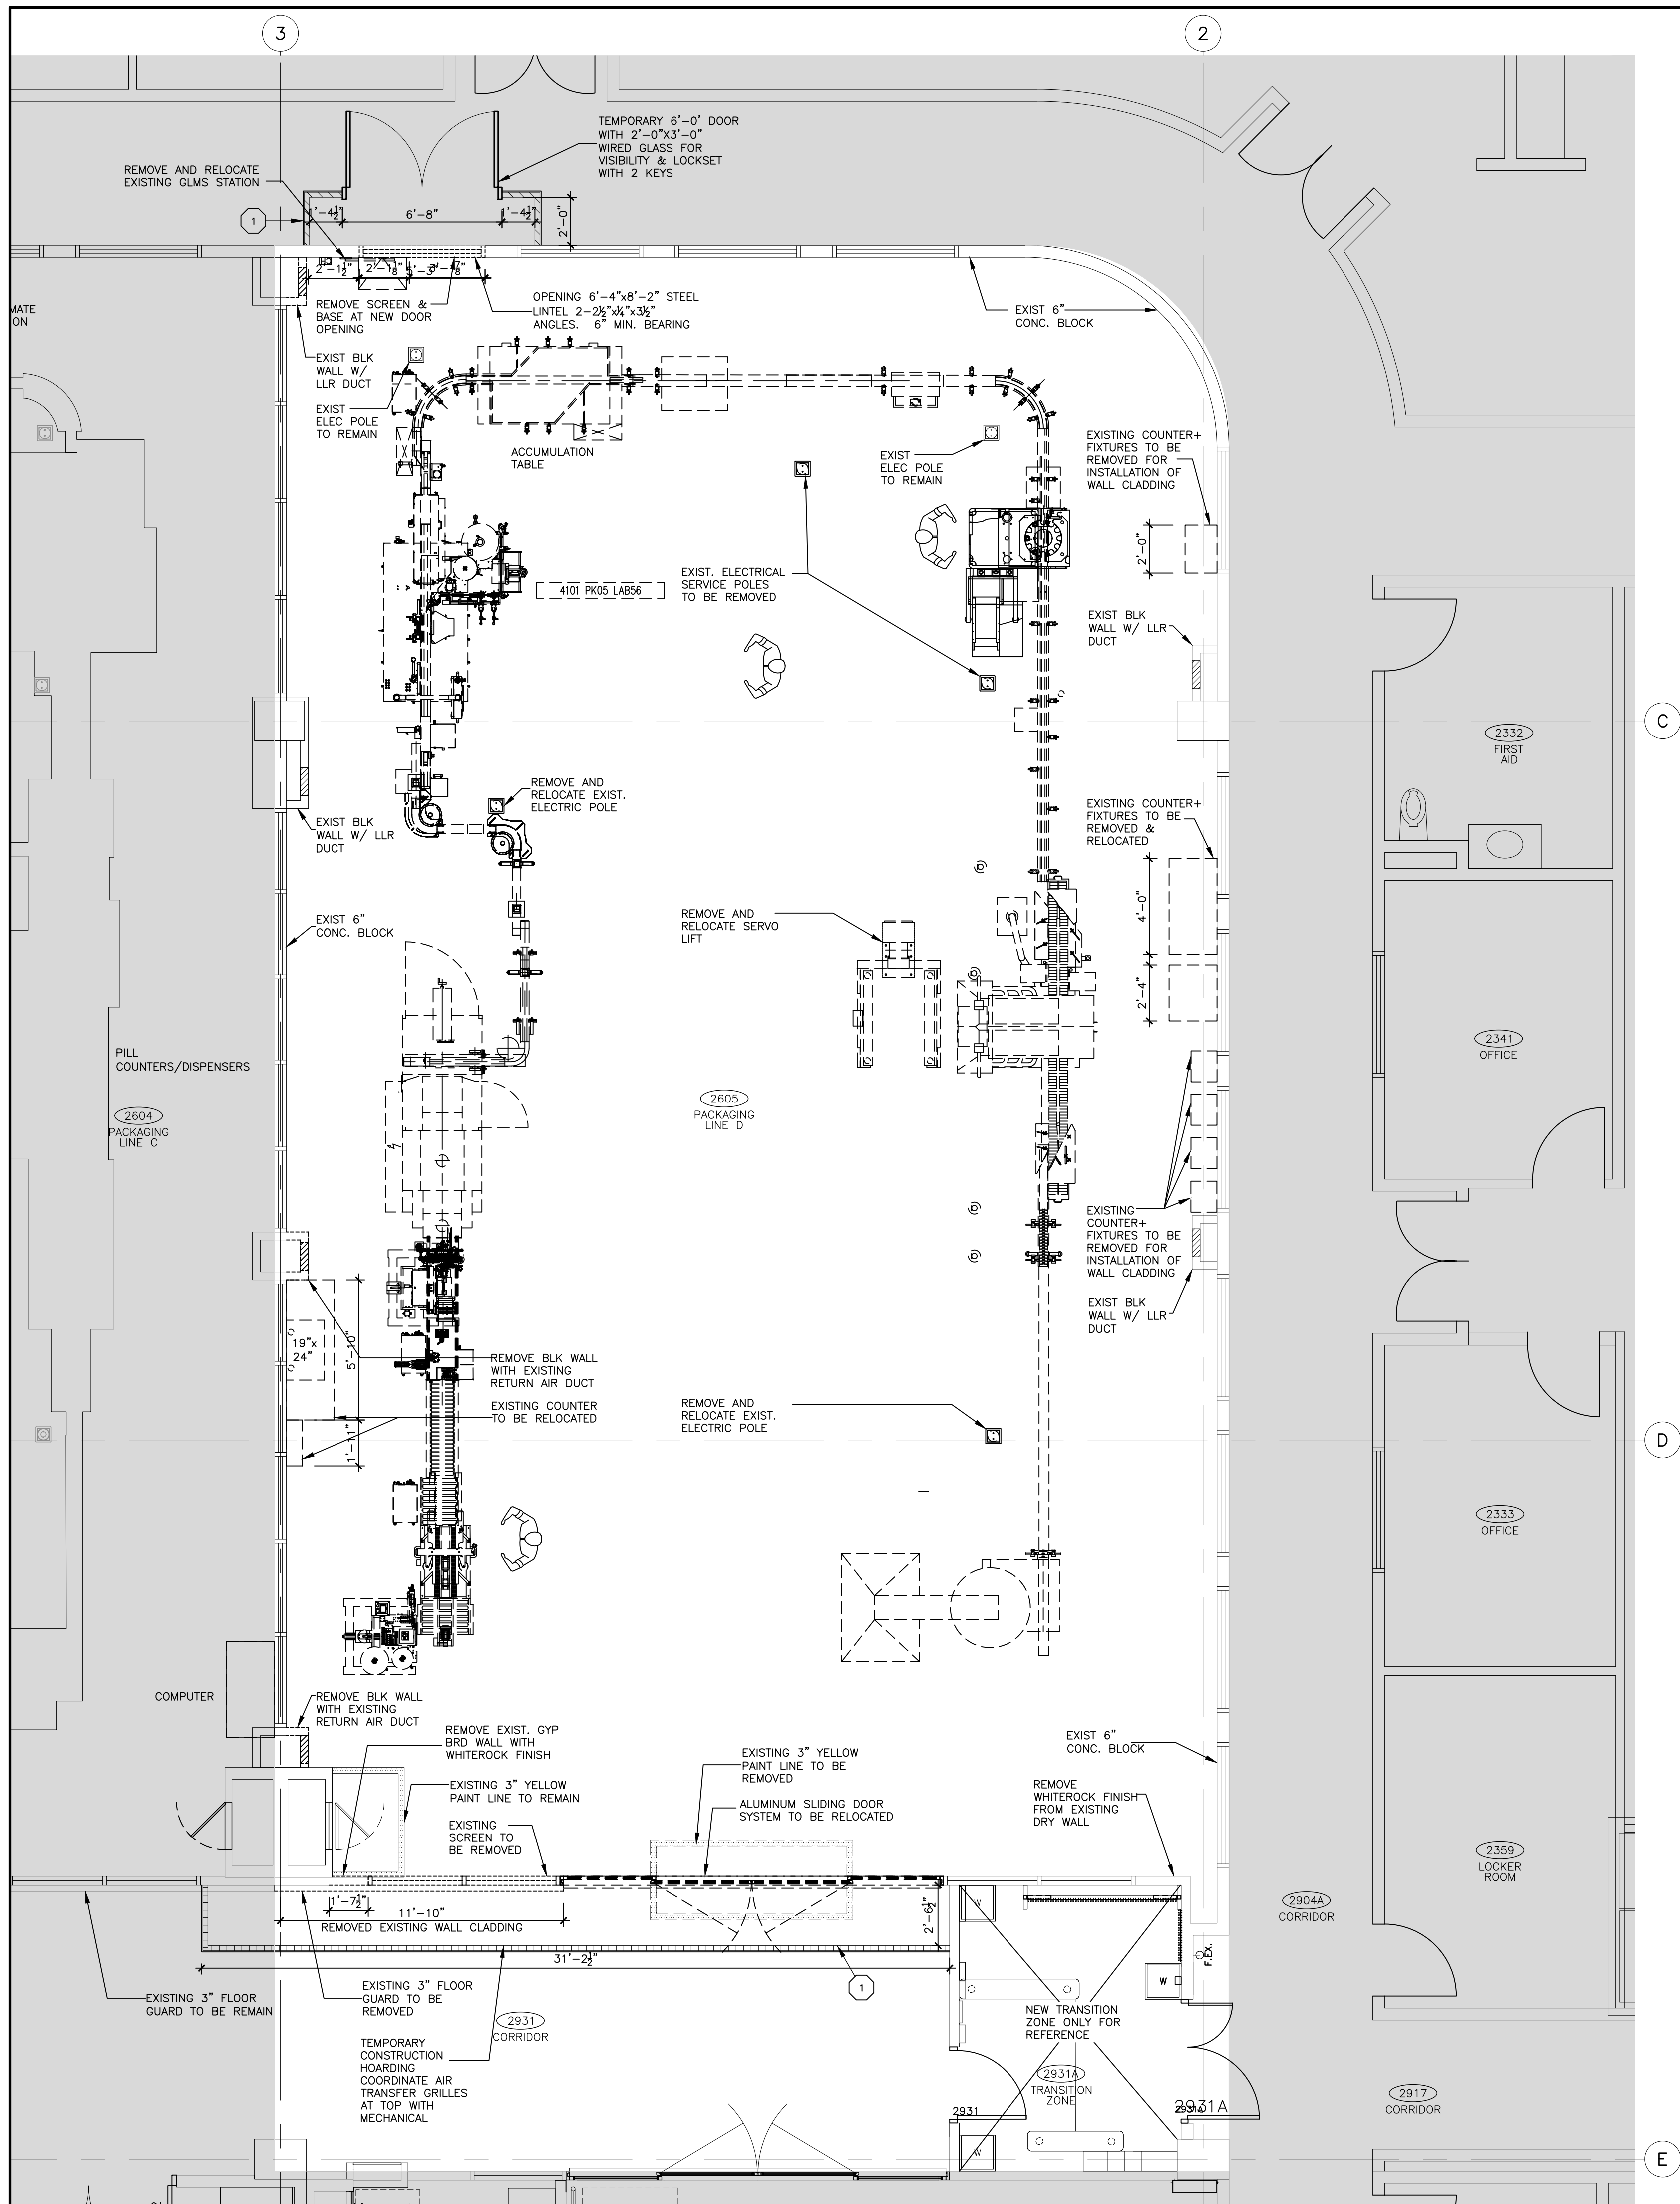

1 SECOND FLOOR DEMO PLAN
1/4"=1'-0"

CONFIDENTIALITY NOTE:
This drawing shall not be copied, reproduced or distributed in any manner without the expressed written approval of APOTEX INC. or their designated agents.

No.	Date	Issued	By:
A	2024-04-10	ISSUED FOR REVIEW	WBA

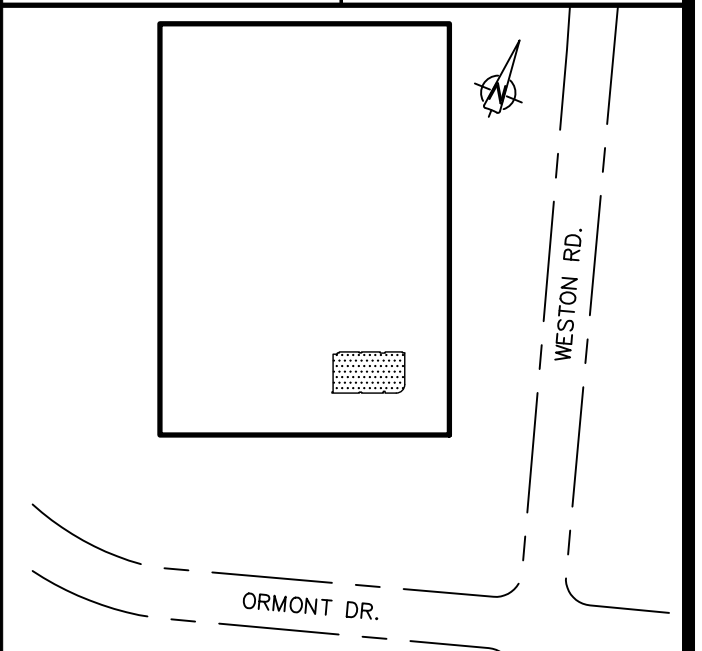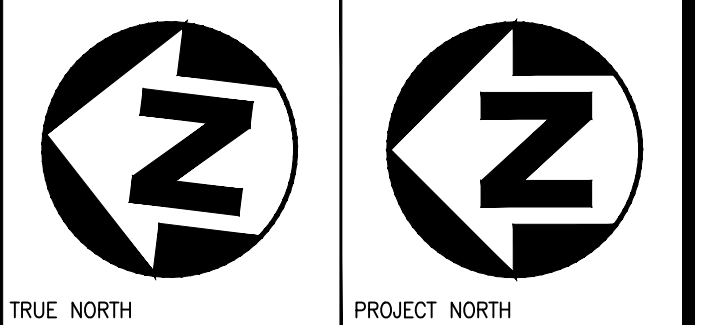

KEY PLAN N.T.S.

FLOOR PLAN LEGEND:	
[Solid Grey]	EXISTING AREA TO REMAIN
[Hatched Grey]	INTERIOR ALTERATION / NEW ADDITION
[Dashed Line]	NEW DOOR AND FRAME
[Dotted Line]	EXISTING DOOR AND FRAME TO BE REMOVED
[Solid Line]	EXISTING DOOR AND FRAME TO REMAIN

DEMOLITION LEGEND	
1	TEMP. CONST. HOARDING FOR DEMOLITION AND NEW WALL/ CLNG. CONSTRUCTION; 2" PRE-FINISHED VINYL GYP. BOARD ON ONE SIDE OF 3/8" METAL STUDS @ 24" O.C. (PRODUCTION SIDE) FROM FIN. FLOOR TO U/S OF EXISTING CEILING (DOUBLE SIDED TAPE TRACK TO FLOOR) PROVIDE VINYL BASE
2	SOFT TARP HOARDING FROM FLOOR TO CEILING FOR FINISHING STAGE
WALL LEGEND	
P1	1/2" TAKIRON- IRY ONE PVC CLADDING ON 3/8" GLASS MATT BOARD ON 3/8" METAL STUDS @ 16" O.C. UP TO U/S OF EXISTING CEILING. BOARD NOT REQUIRED JOINT FILLING/FINISHING
P2	1/2" TAKIRON- IRY ONE PVC CLADDING ON 3/8" GLASS MATT BOARD ON 3/8" METAL STUDS @ 16" O.C. UP TO U/S OF EXISTING CEILING.
P3	1/2" TAKIRON- IRY ONE PVC CLADDING ON EXISTING BLOCK WALL UP TO U/S OF EXISTING CEILING.
P4	1/2" TAKIRON- IRY ONE PVC CLADDING ON ONE SIDE ONLY OF 3/8" GYP. BOARD ON 3/8" METAL STUDS @ 16" O.C. UP TO U/S OF EXISTING CEILING.
P5	1/2" TAKIRON- IRY ON EXISTING DRYWALL

No.	Date	Revision	By:
D	2024-10-21	ISSUED FOR AS-BUILT	WBA

Contractor must check and verify all dimensions and be responsible for same, reporting any discrepancies to the Architect or Engineer before commencing work.
Prints shall not be used for construction until signed 'Approved For Construction' by the Architect or Engineer.
Prints are not to be scaled.




Consultant:
wba
architects and engineers inc.


Client:
APOTEX INC.
CANADA'S PHARMACEUTICAL COMPANY

Project Title:
**4100 WESTON ROAD, TORONTO
PACKAGING UPGRADES LINE 'D'
SECOND FLOOR DEMOLITION &
NEW LAYOUT PLAN**


CAD System and Version:		Plot Scale:	Sheet Size:
Designed By:	Date:	Drawn By:	1:1 30" x 42"
G.S.S.	NOV/2023	J.A.J.	NOV/2023
Checked By:	Date:	Approved By:	Date:
G.S.S.	NOV/2023	G.S.S.	NOV/2023
Drawing Scale:		Consultant Project No.:	Consultant Draw No.:
AS NOTED		2231108	A202A
Apotex Project No.:	Site No.:	Discipline:	System:
4101-505	4101	AP	PE
Rev.:		0	

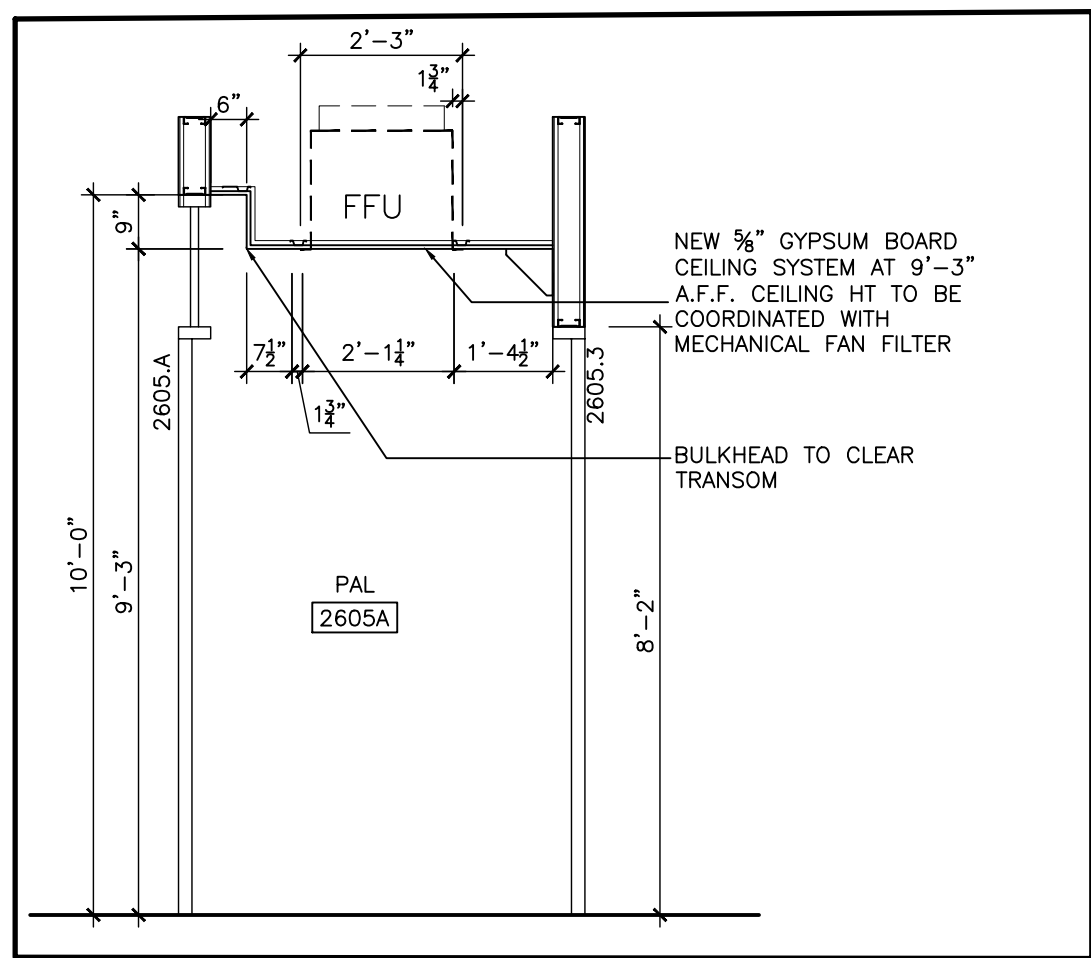


8 BULKHEAD IN PAL 2605A
3/8" x 1'-0"

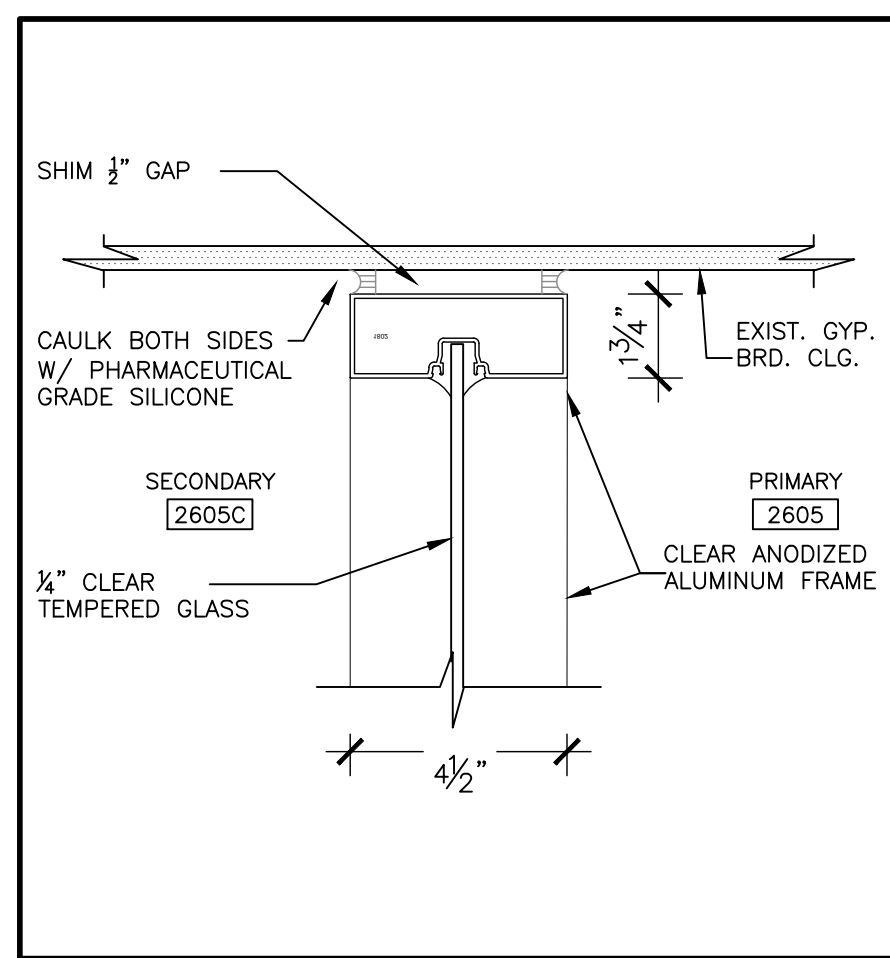


7 ALUMINUM SCREEN-TYP. HEAD DETAIL
3/8" x 1'-0"

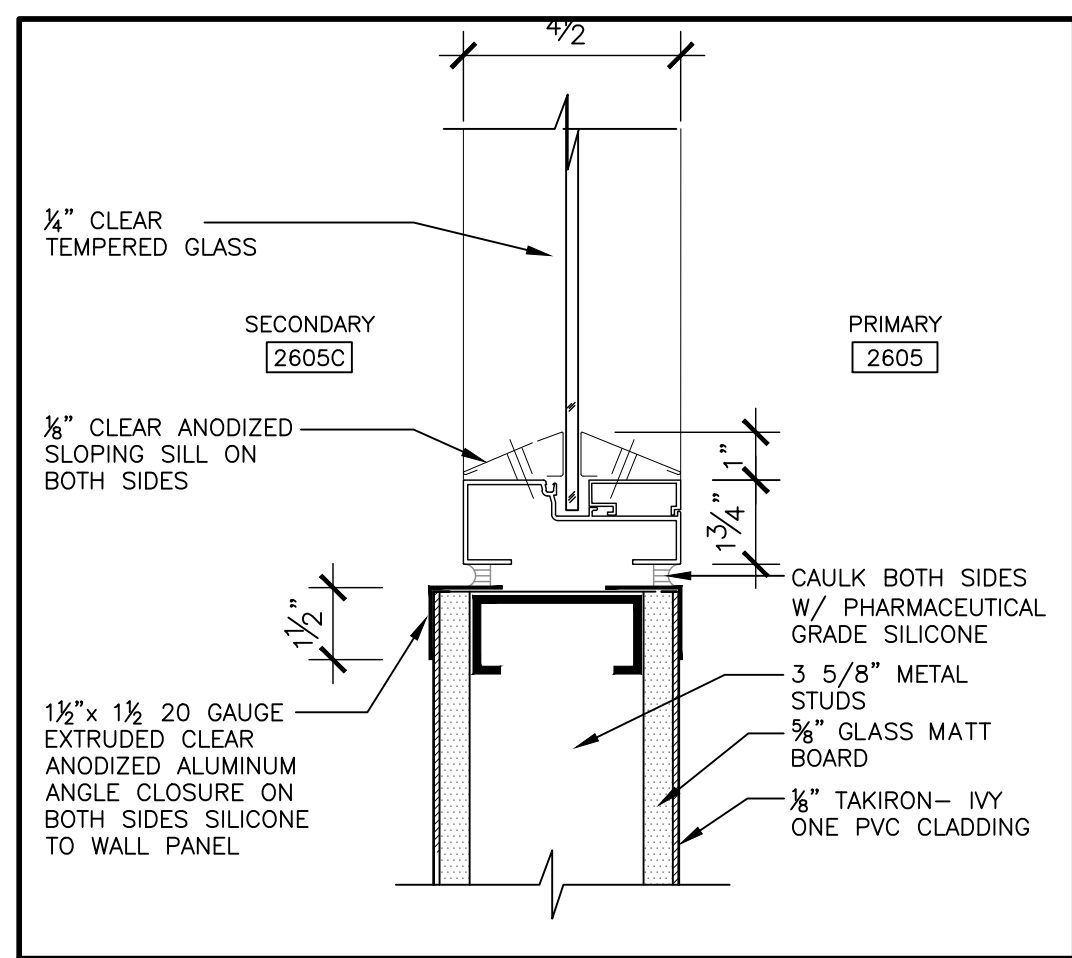


6 ALUMINUM SCREEN-TYP. SILL DETAIL
3/8" x 1'-0"

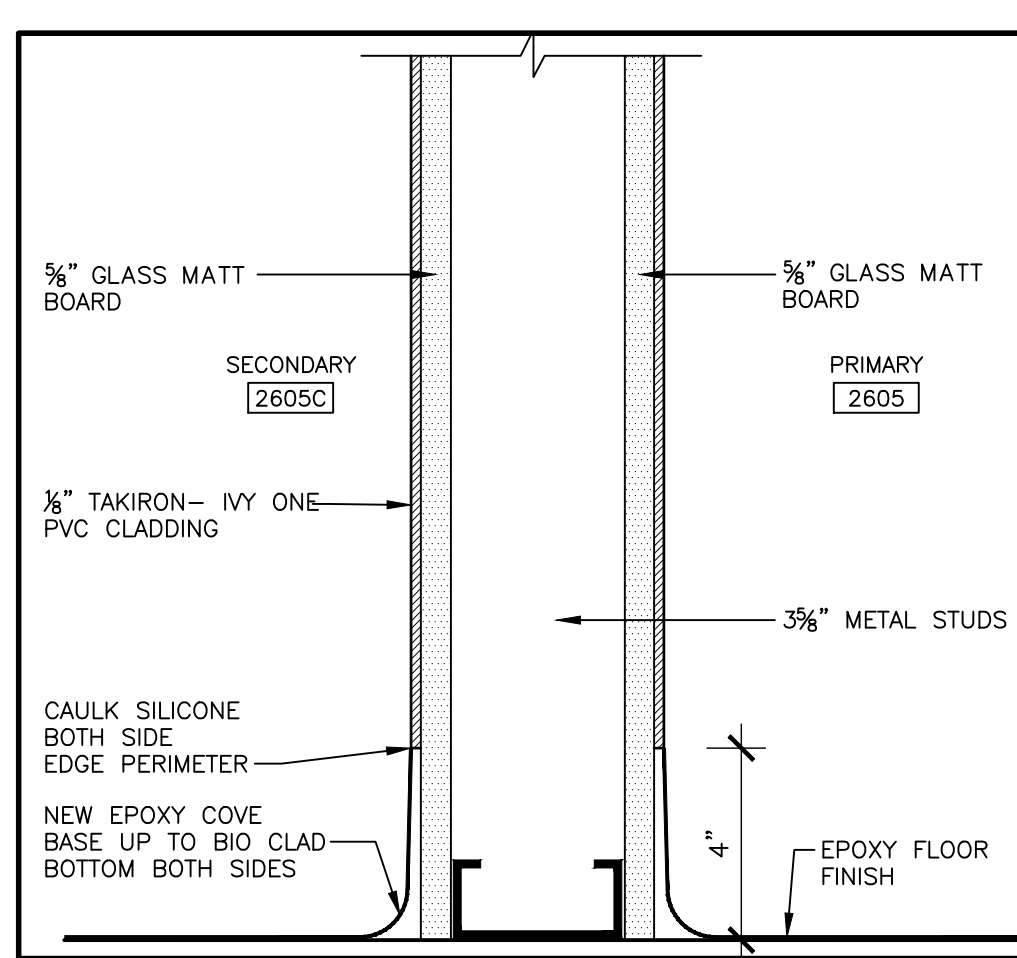


5 WALL BASE DETAIL
3/8" x 1'-0"

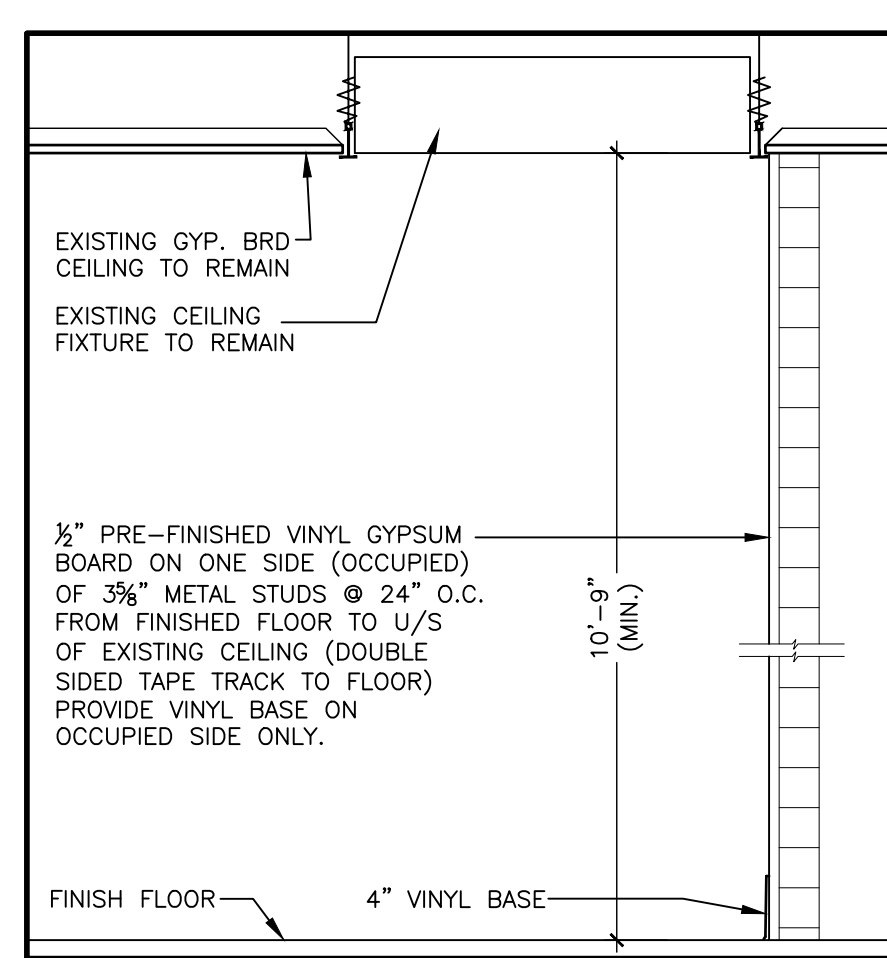


4 CONST. HOARDING WALL SECTION
1'-0" x 1'-0"

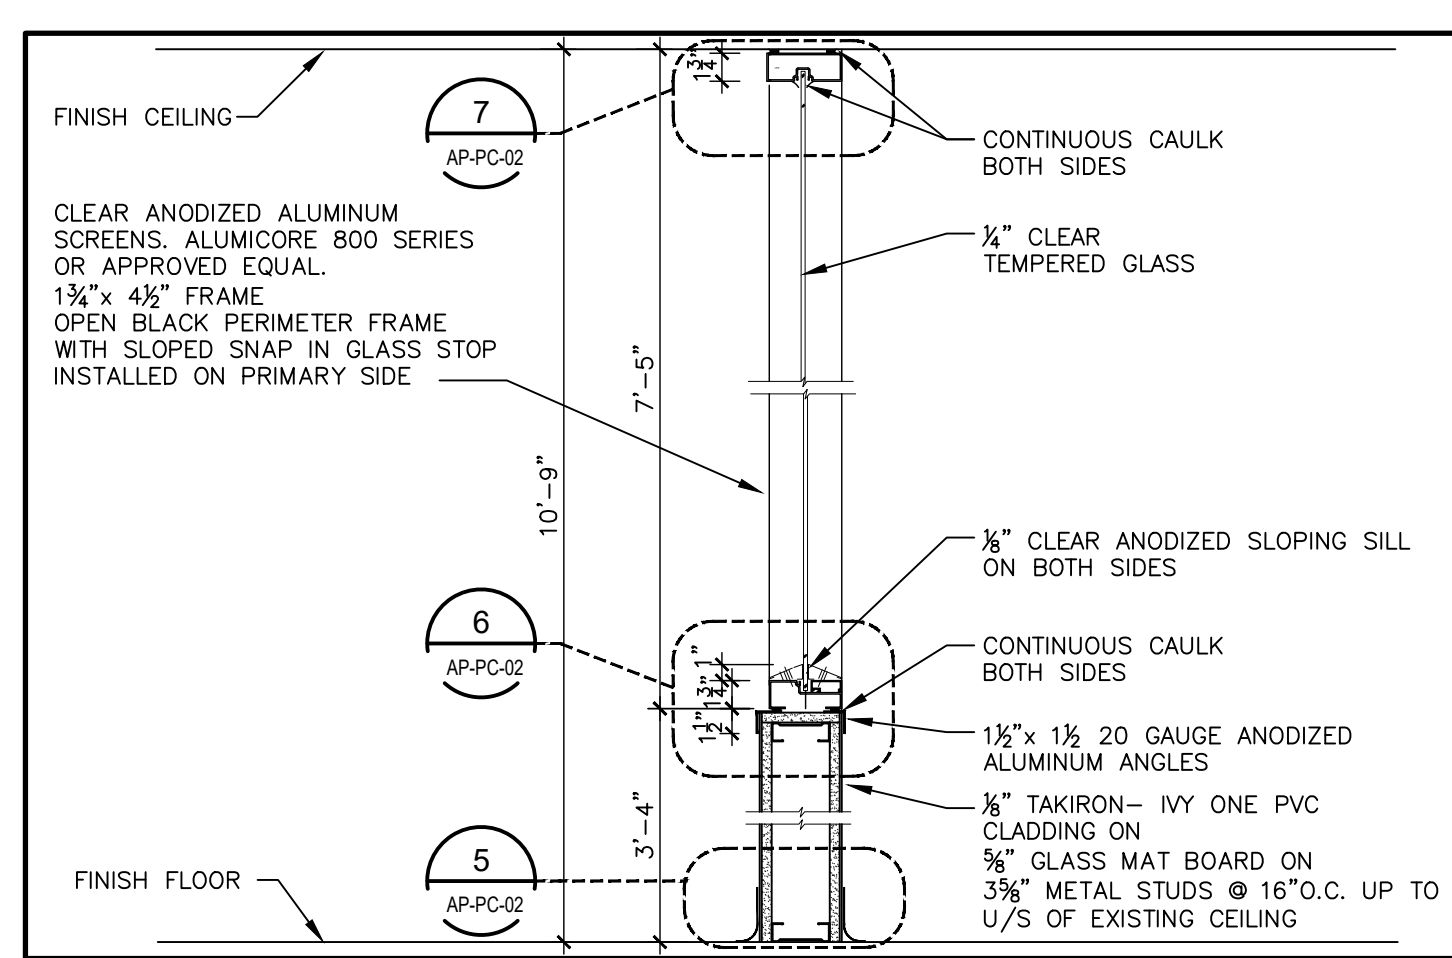

3 ALUMINUM SCREEN WALL SECTION
1'-0" x 1'-0"

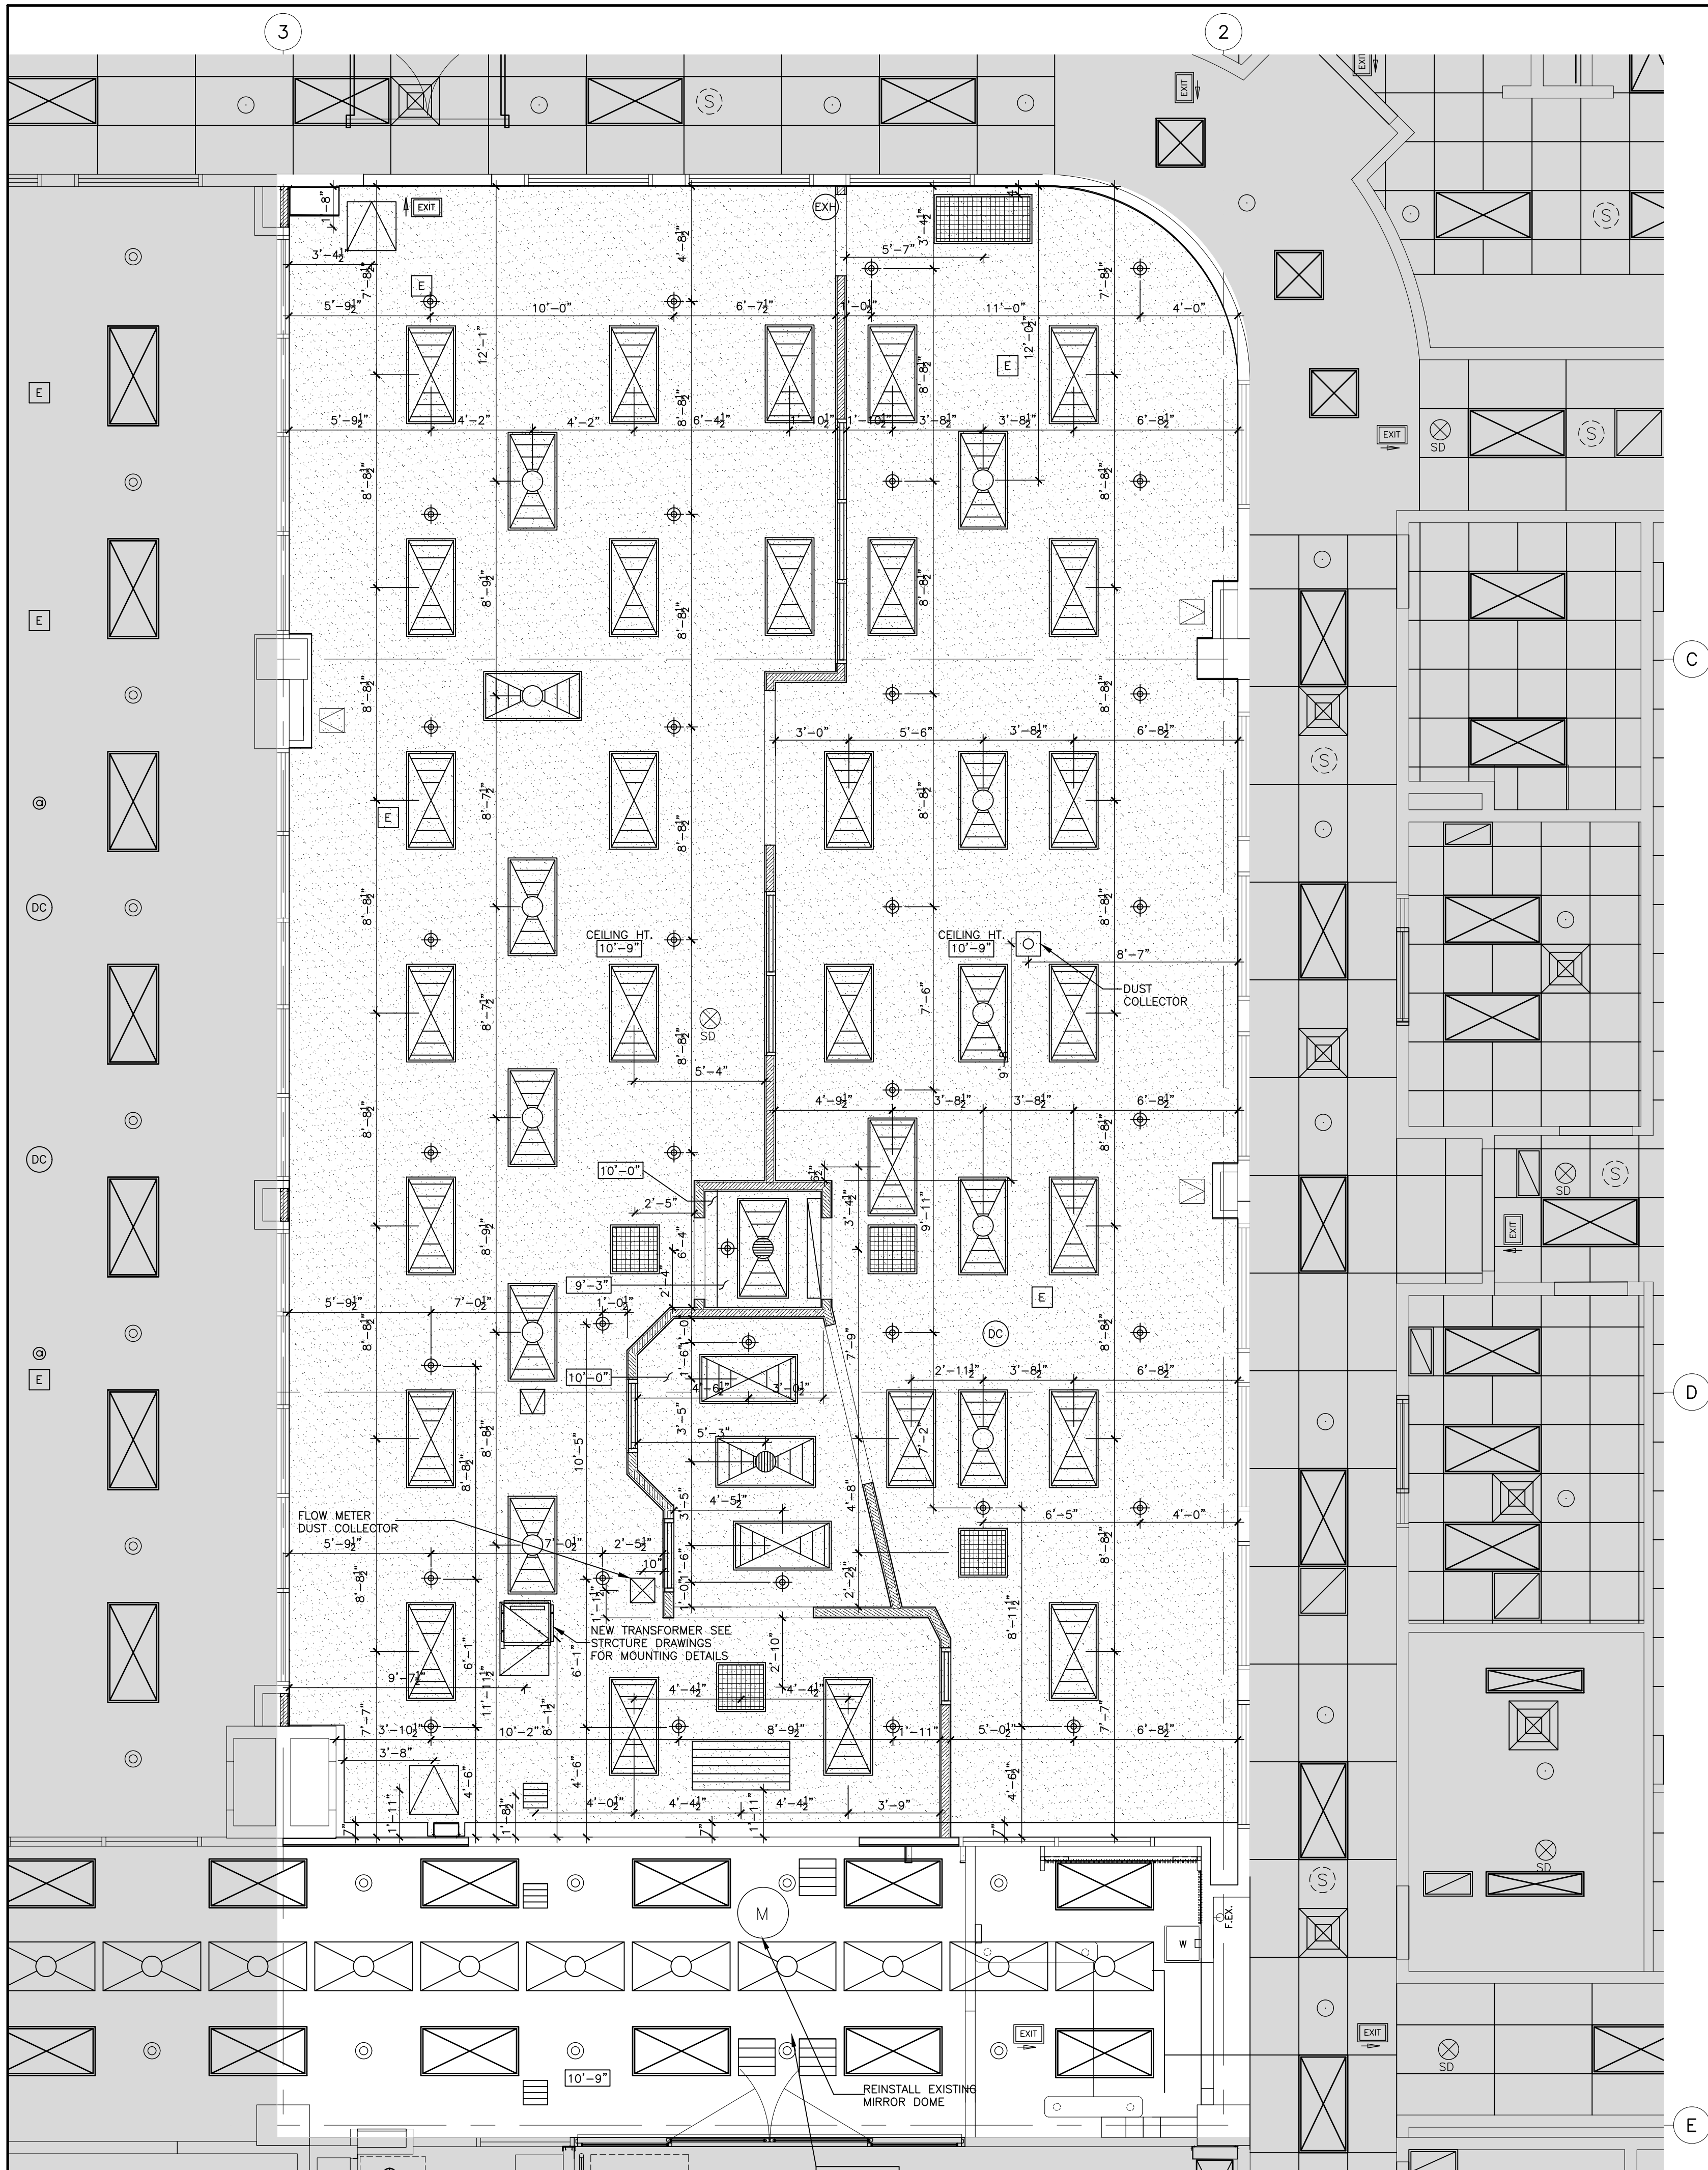

2 SECOND FLOOR NEW REFLECTED CEILING PLAN
1/4" = 1'-0"

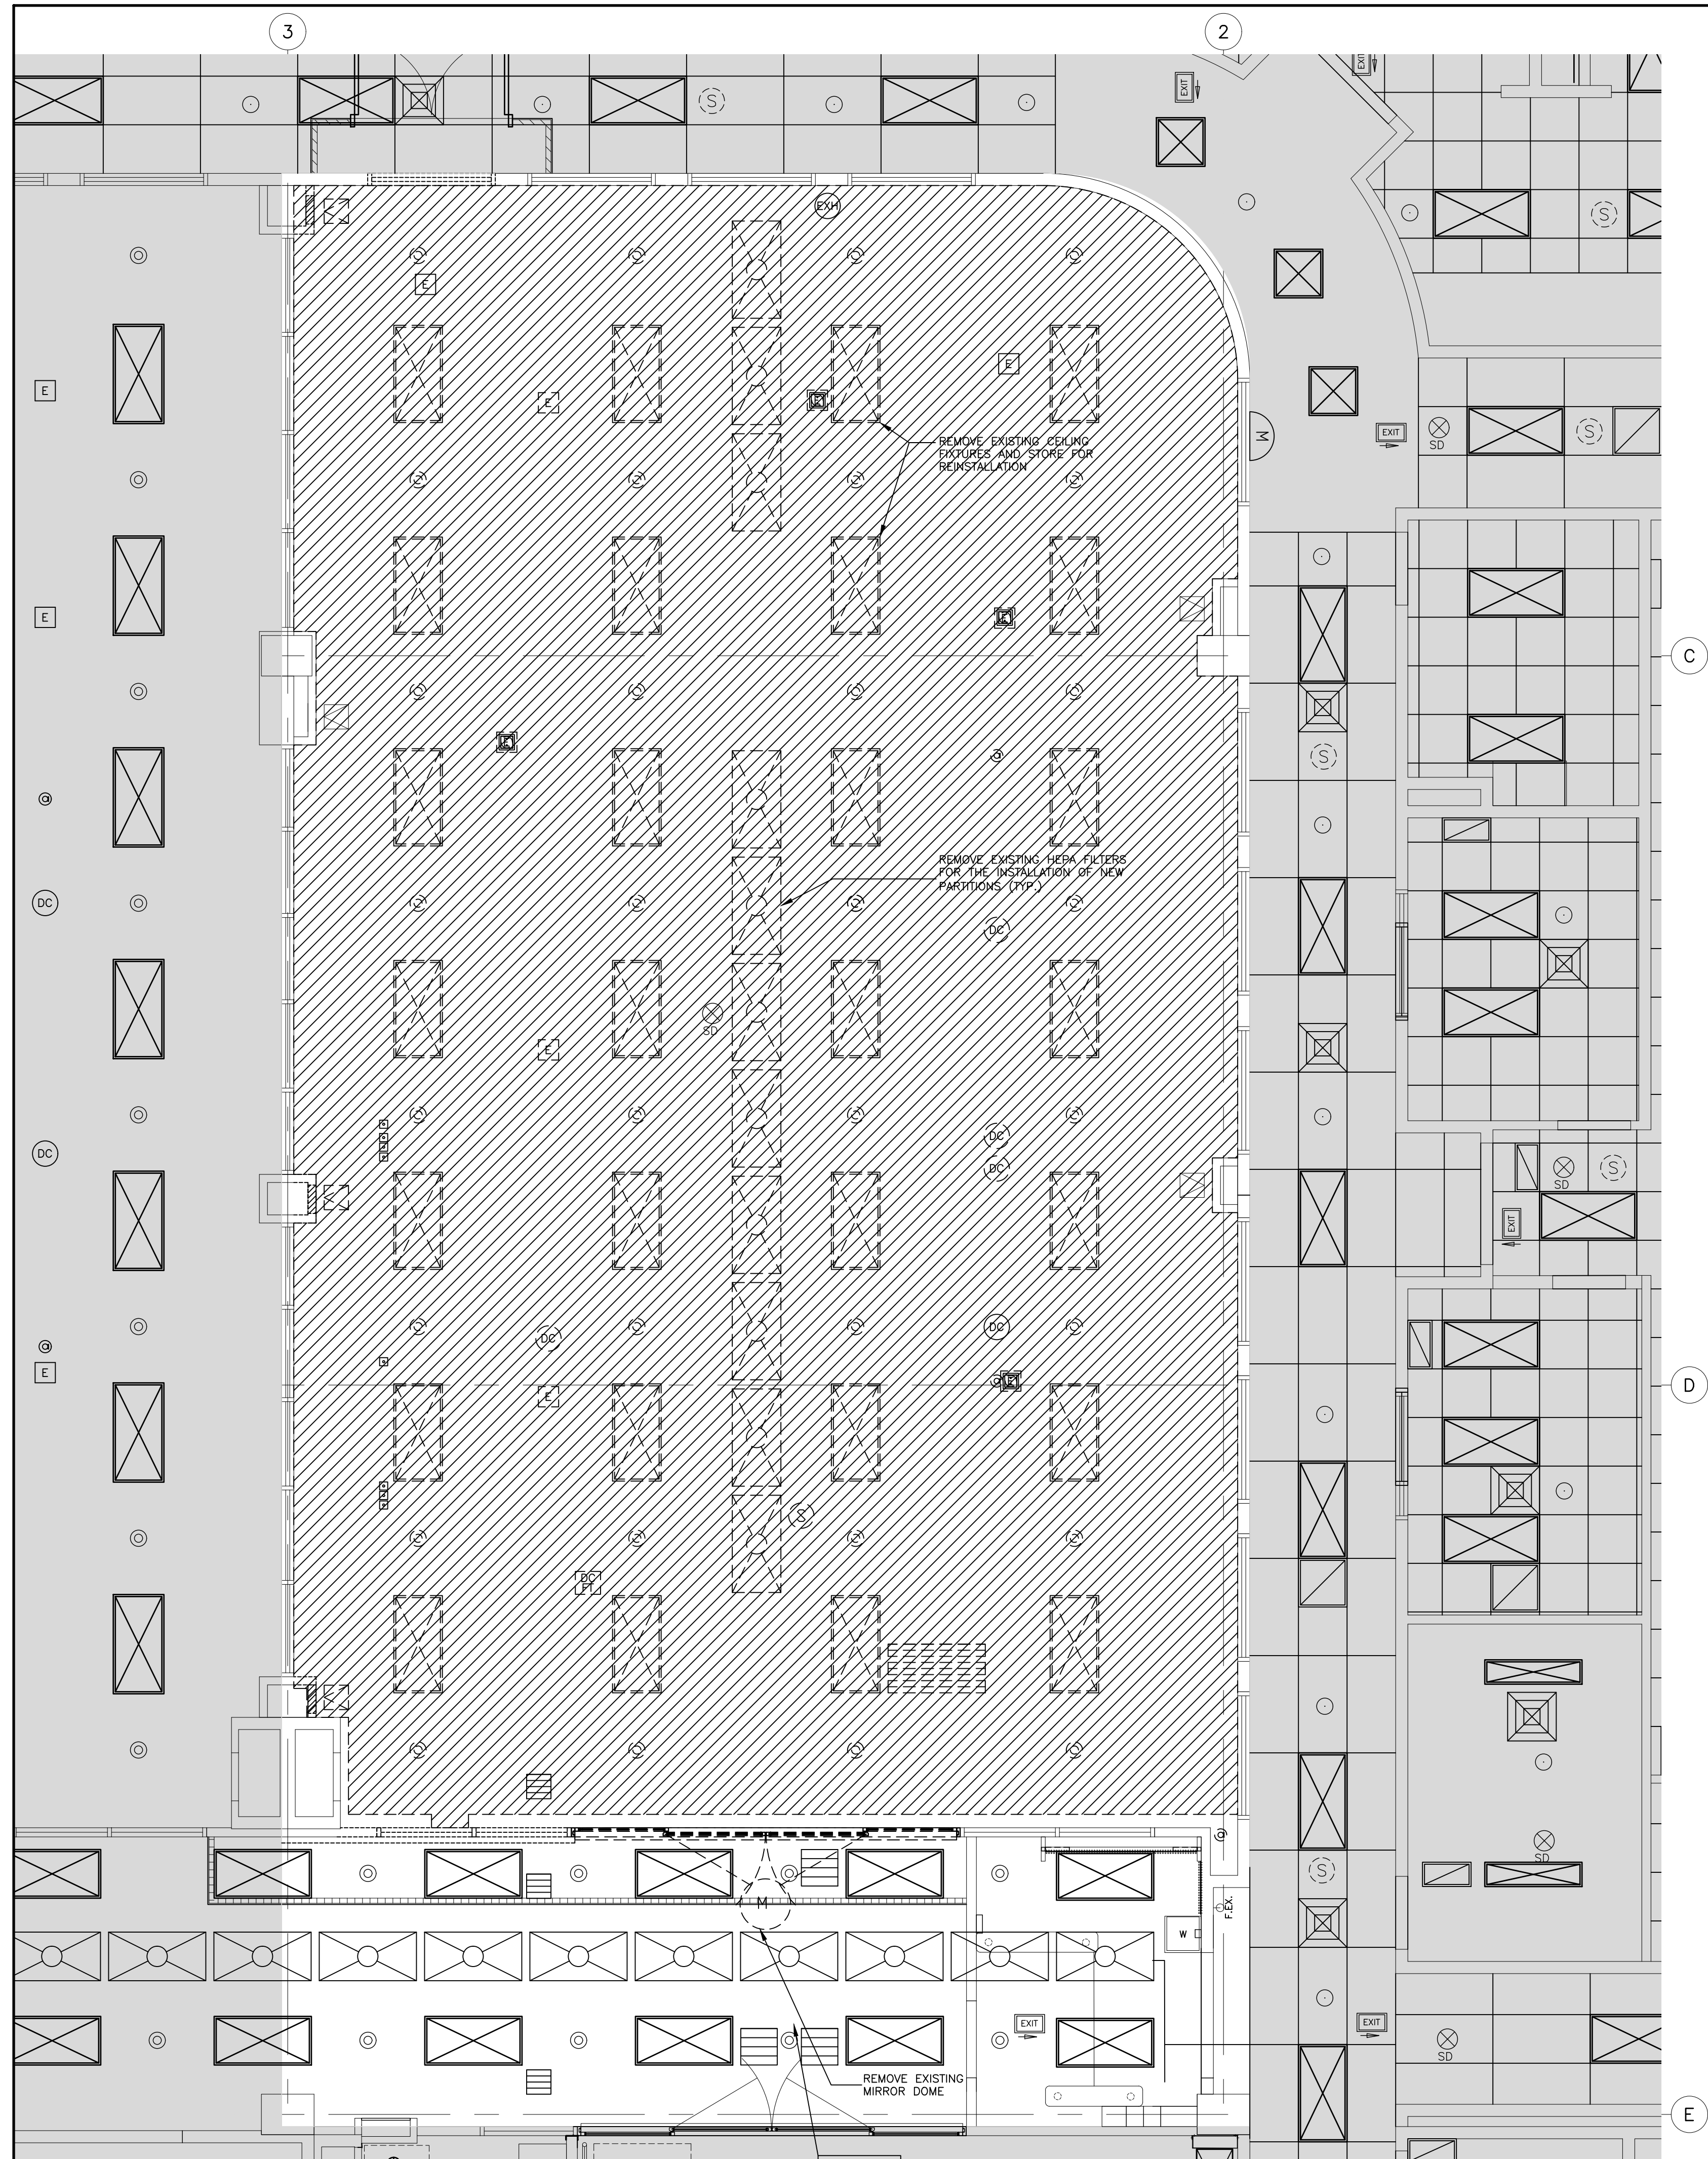

1 SECOND FLOOR DEMOLITION REFLECTED CEILING PLAN
1/4" = 1'-0"

CONFIDENTIALITY NOTE:
This drawing shall not be copied, reproduced or distributed in any manner without the expressed written approval of APOTEX INC. or their designated agents.

No.	Date	Issued	By:
A	2024-01-12	ISSUED FOR 30% REVIEW	WBA
B	2024-02-01	ISSUED FOR 50% REVIEW	WBA
C	2024-02-09	ISSUED FOR PERMIT	WBA
D	2024-02-15	ISSUED FOR 90% REVIEW	WBA
E	2024-02-21	ISSUED FOR TENDER	WBA

FLOOR PLAN LEGEND:

- EXISTING AREA TO REMAIN
- INTERIOR ALTERATION / NEW ADDITION

CEILING LEGEND

- EXISTING GYPSUM BOARD CEILING TO REMAIN
- EXISTING 2x4 LIGHT FIXTURE TO REMAIN
- EXISTING 2x4 HEPA FILTER TO REMAIN
- EXISTING GYPSUM BOARD CEILING TO BE REMOVED
- EXISTING 2x4 LIGHT FIXTURE TO BE REMOVED
- EXISTING HEPA FILTER TO BE REMOVED
- EXISTING SPRINKLER HEAD TO BE REMOVED
- EXISTING SPRINKLER HEAD TO BE RELOCATED
- EXISTING ELECTRICAL CONNECTOR TO BE REMOVED
- EXISTING RETURN AIR GRILLE TO REMAIN
- EXISTING RETURN AIR GRILLE TO BE REMOVED
- EXISTING COMPRESSED AIR FIXTURE TO REMAIN
- EXISTING COMPRESSED AIR FIXTURE TO BE REMOVED AND CAPED SEE MECHANICAL DRAWINGS
- RELOCATED EXISTING 2x4 LIGHT FIXTURE
- NEW CORNER LIGHT FIXTURE
- RELOCATED EXISTING 2x4 HEPA FILTER
- NEW 2x4 HEPA FILTER
- NEW SPRINKLER HEAD
- NEW RETURN AIR GRILLE PERFORATED PRE-FINISH METAL
- NEW 24"x24" RETURN AIR GRILLE
- NEW 48"x24" RETURN AIR GRILLE
- NEW RETURN AIR GRILLE PERFORATED PRE-FINISH METAL

No.	Date	Revision	By:
1	2024-10-21	ISSUED FOR AS-BUILT	WBA
0	2024-04-23	ISSUED FOR CONSTRUCTION	WBA

Contractor must check and verify all dimensions and be responsible for same, reporting any discrepancies to the Architect or Engineer before commencing work.
Prints shall not be used for construction until signed 'Approved For Construction' by the Architect or Engineer.
Prints are not to be scaled.

Professional Seal(s)








Client:

APOTEX INC.
CANADA'S PHARMACEUTICAL COMPANY

Project Title:
4100 WESTON ROAD, TORONTO
PACKAGING UPGRADES LINE 'D'

Drawing Title:
2ND FLOOR REFLECTED CEILING
DEMOLITION & NEW PLAN DETAILS

CADD System and Version:	Plot Scale:	Sheet Size:
Designed By: G.S.S.	Date: NOV/2023	Drawn By: J.A.J.
Checked By: G.S.S.	Date: NOV/2023	Approved By: G.S.S.
Drawing Scale: AS NOTED	Consultant Project No: 2231108	Consultant Draw No: A212
Apotex Project No: 4101-505	Site No: 4101	System: AP PC
		02
		1

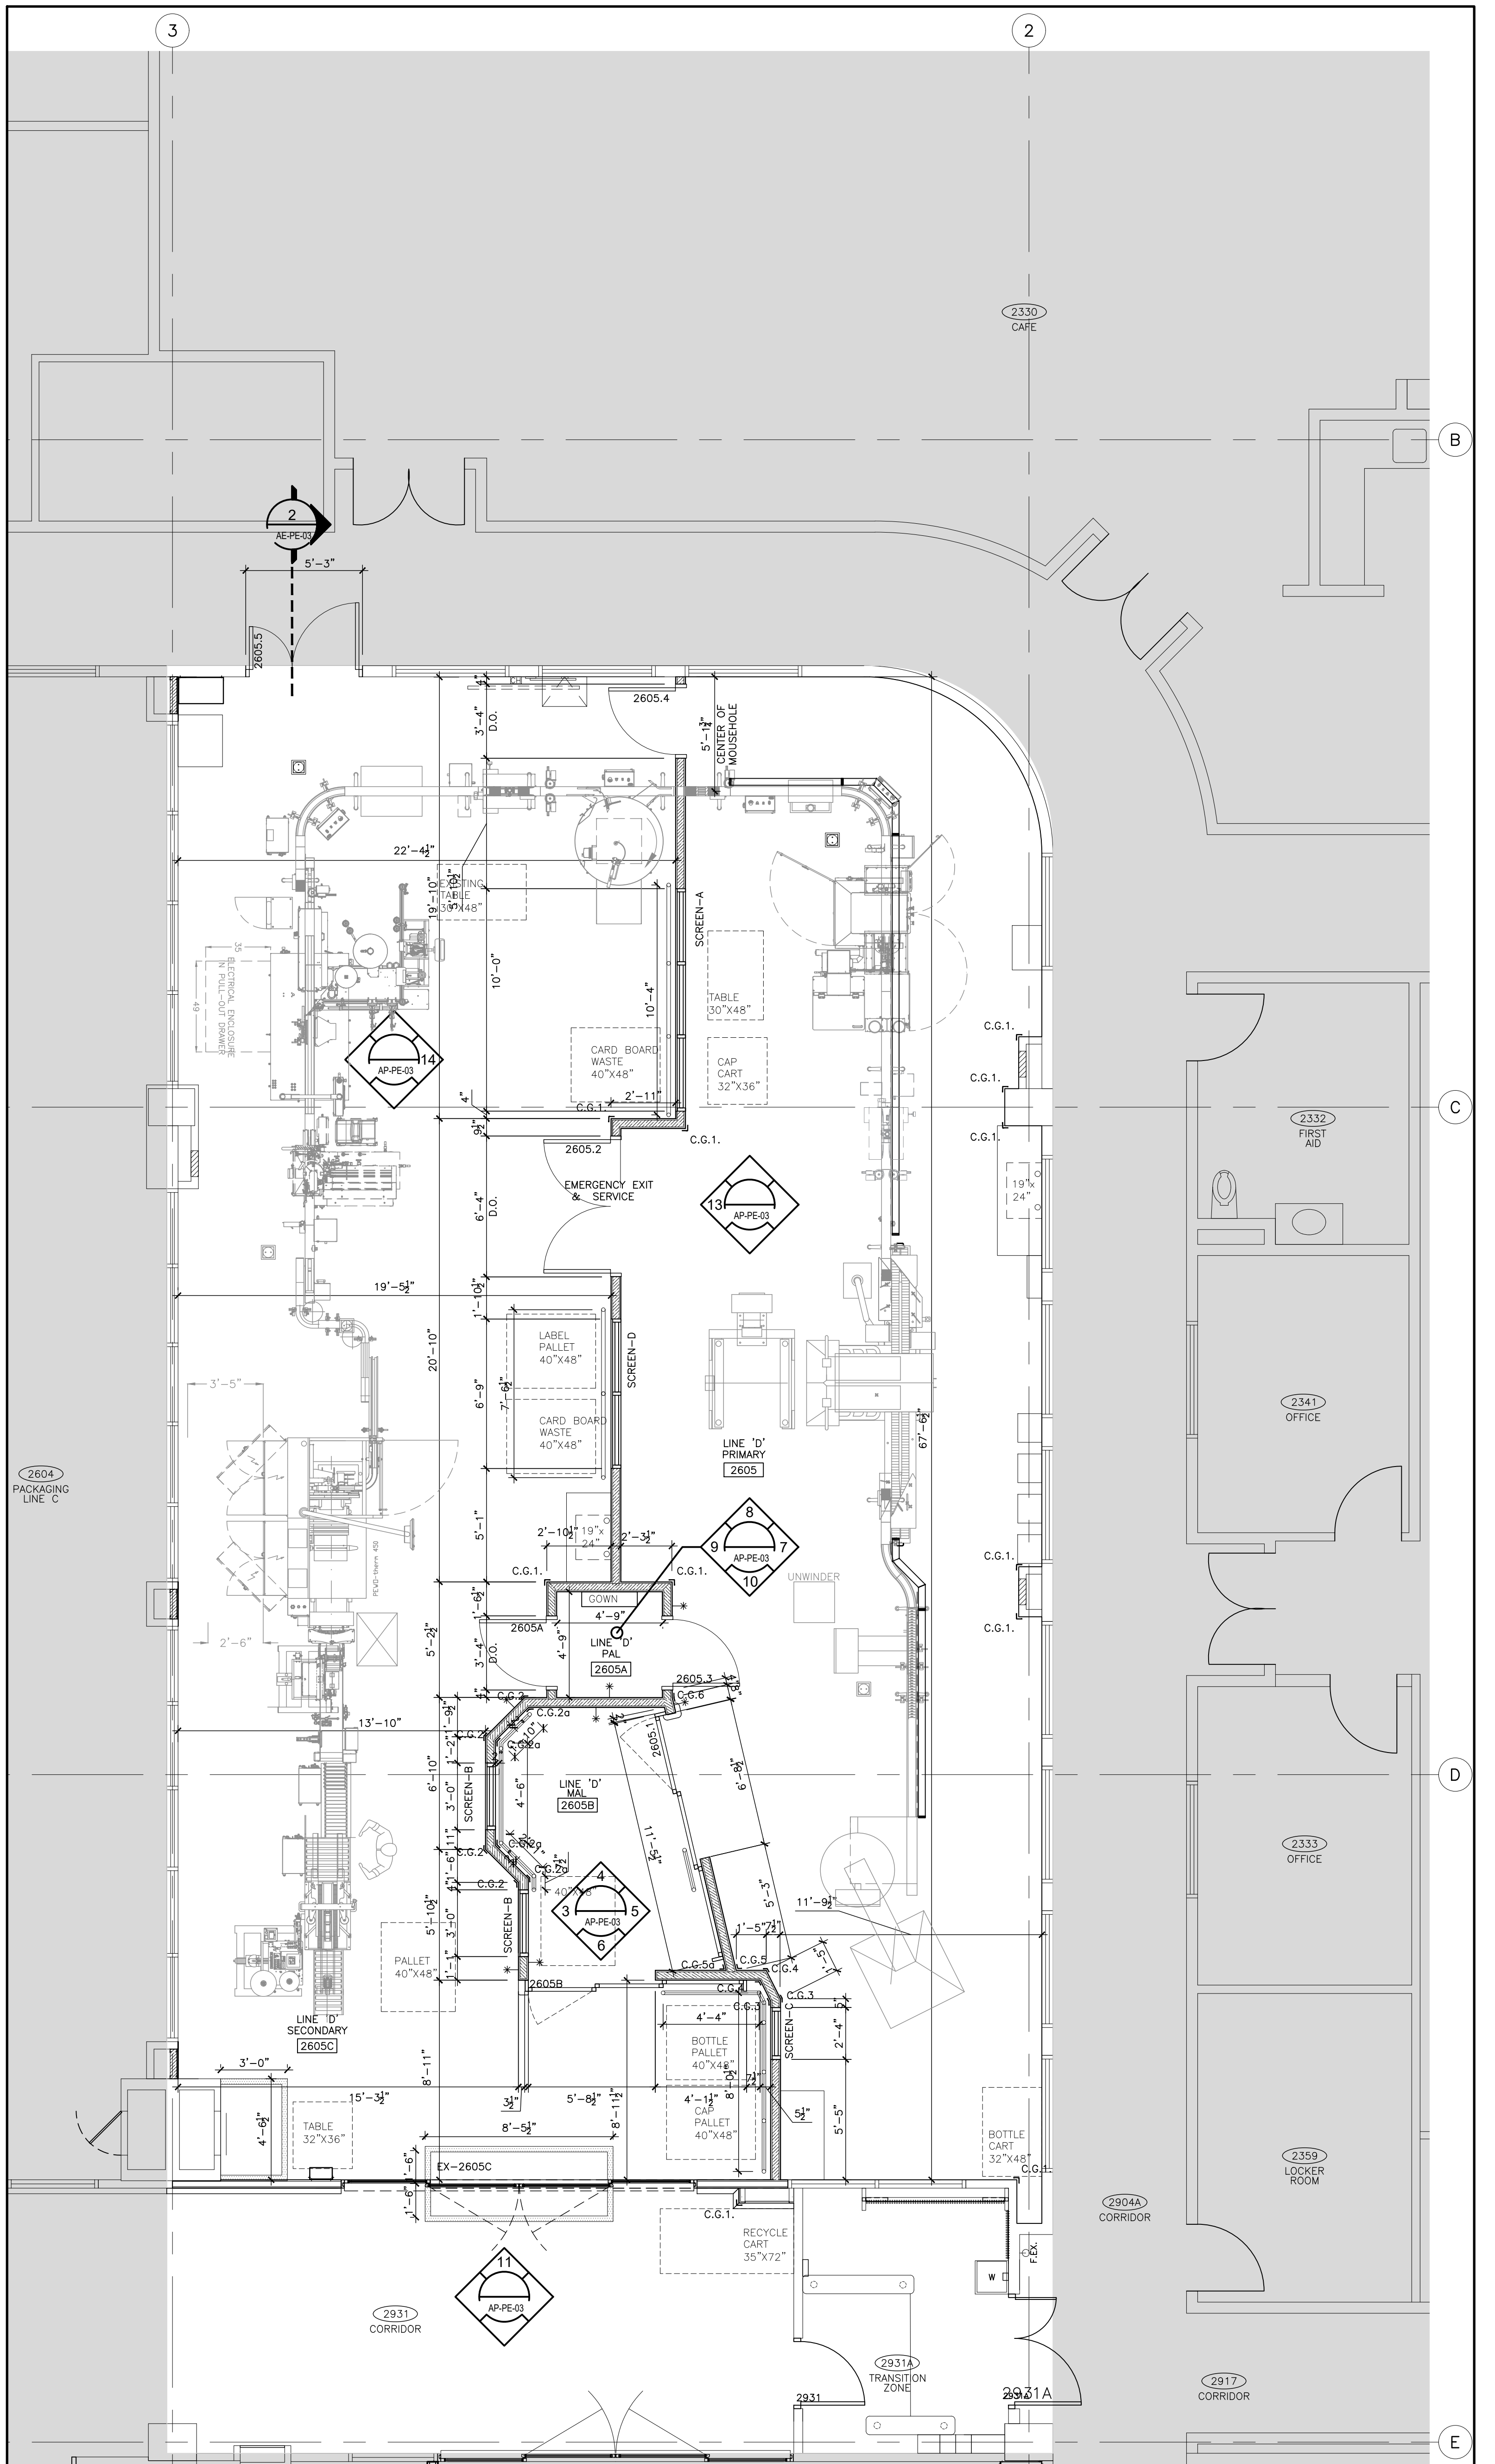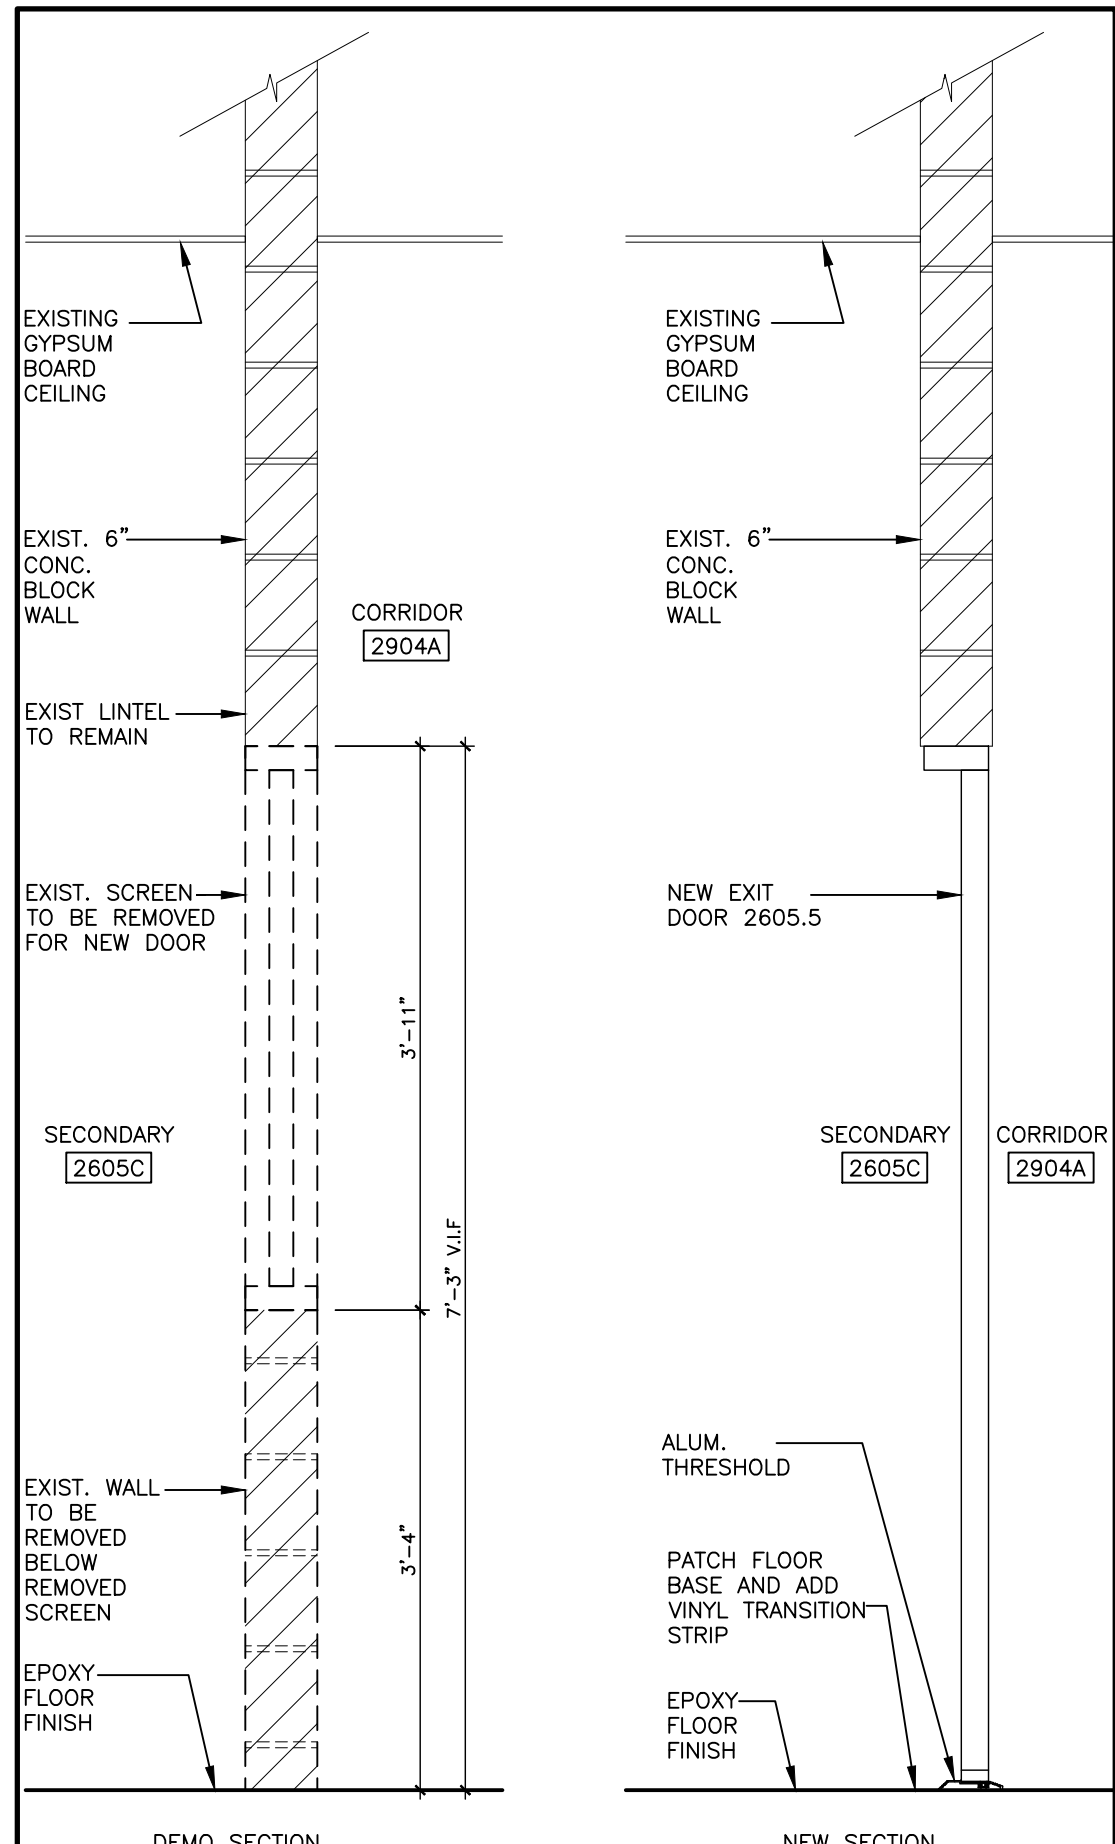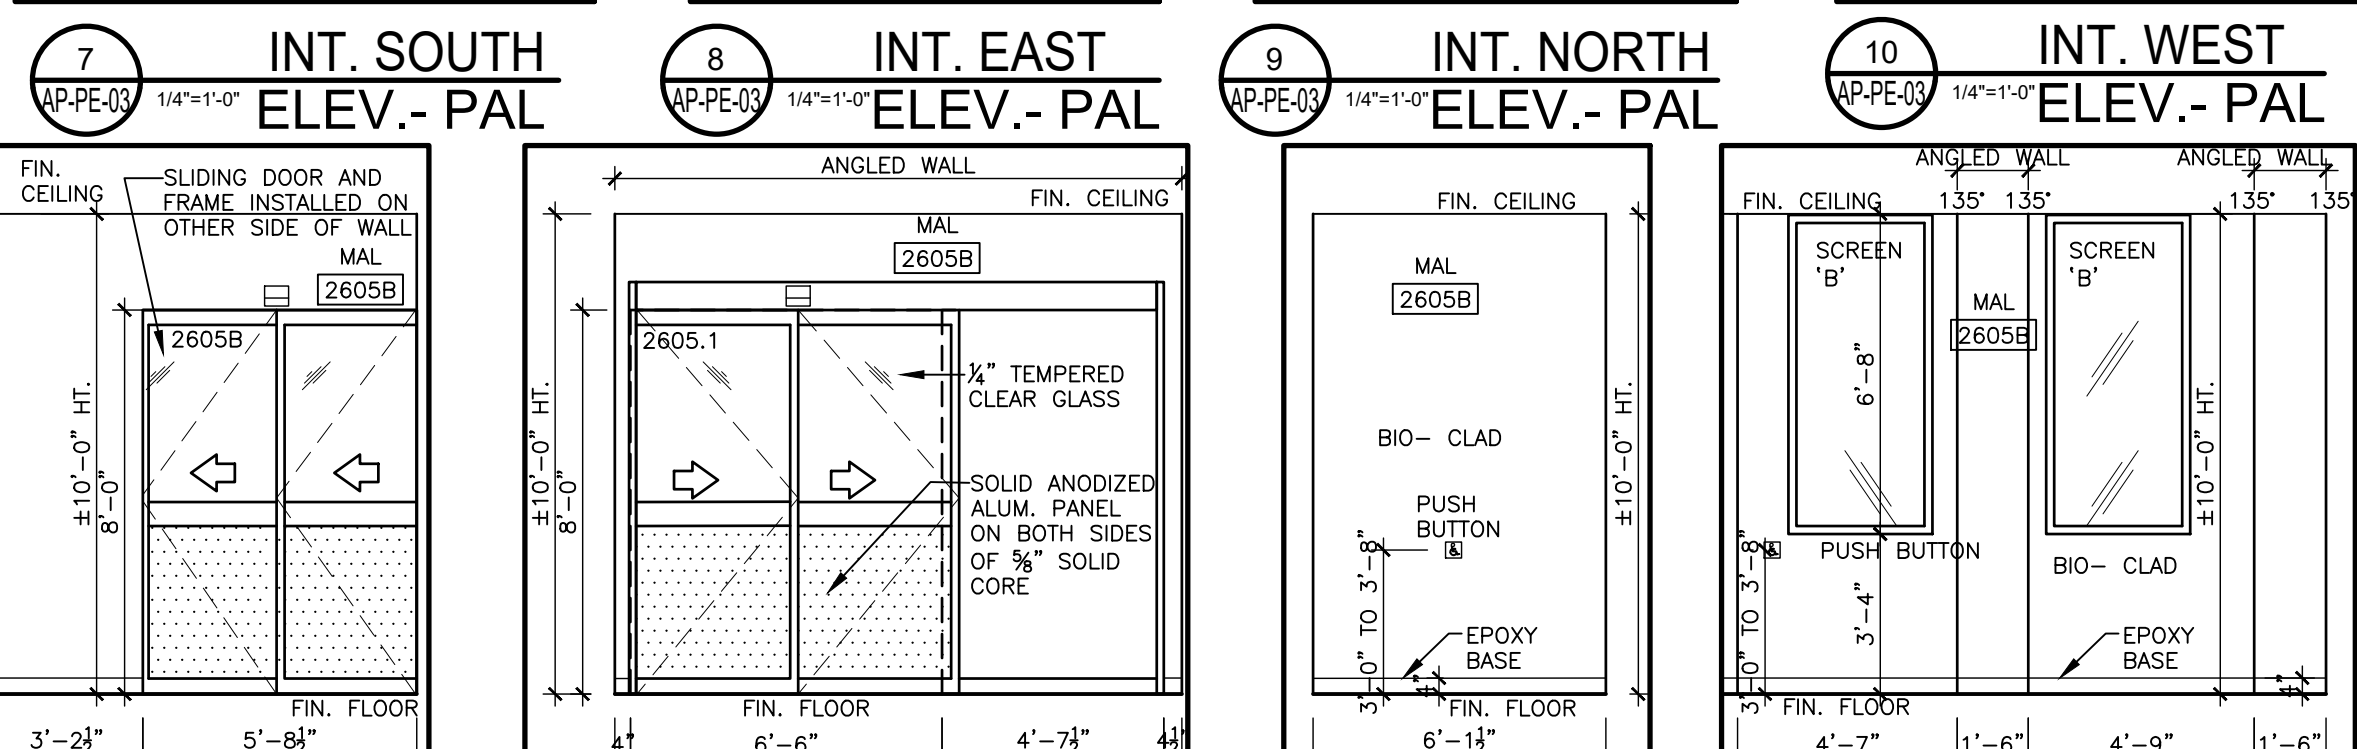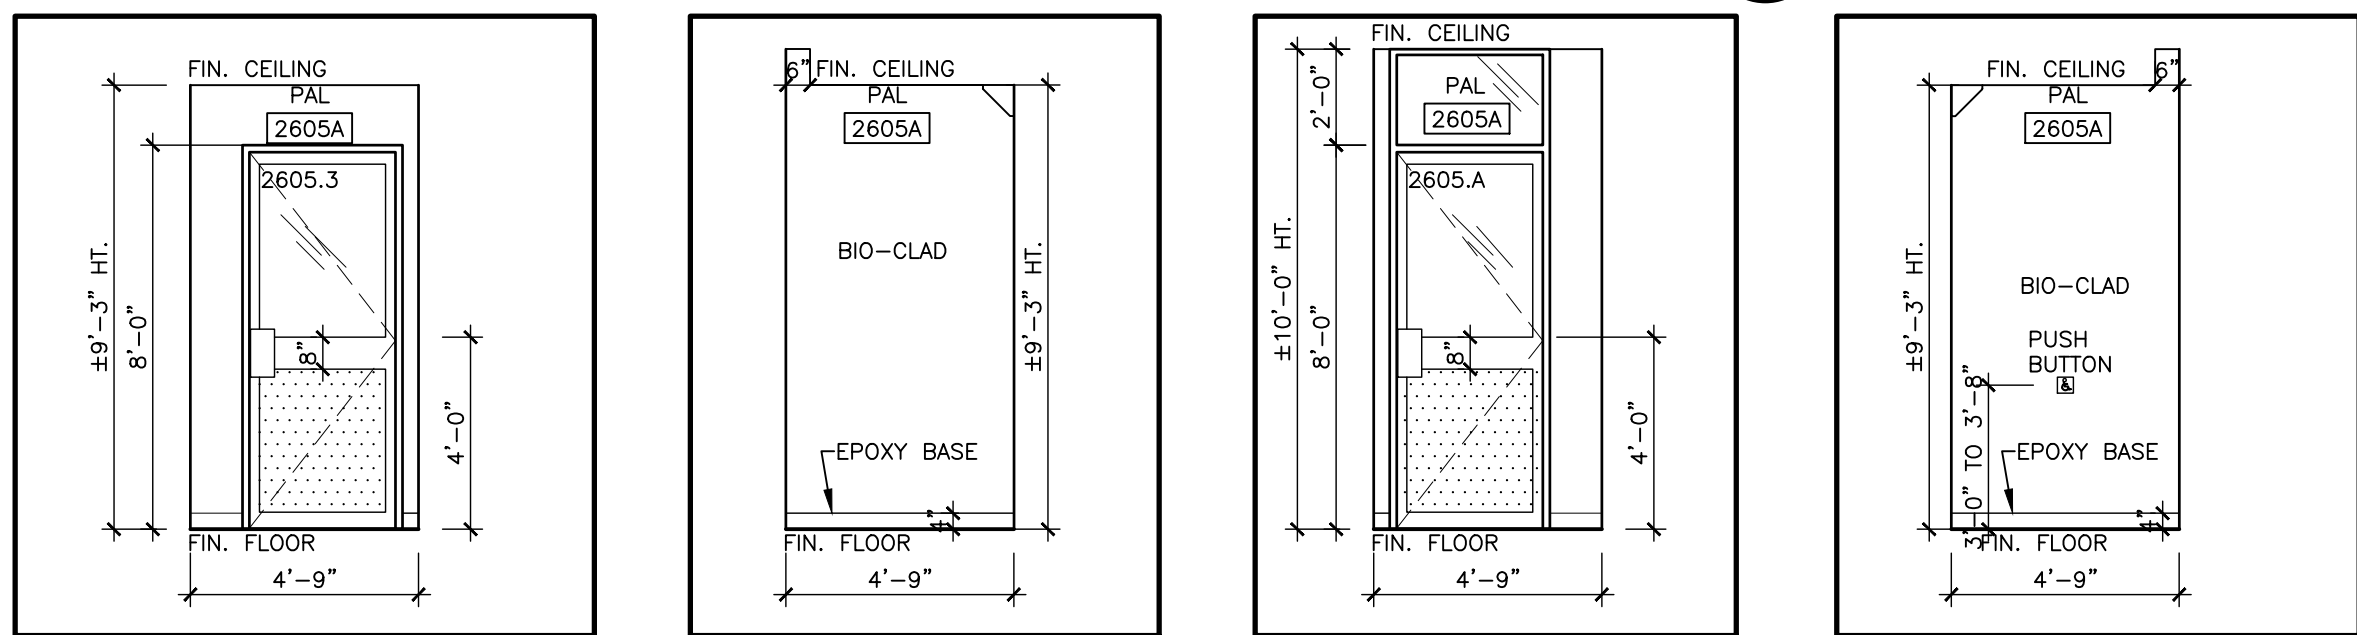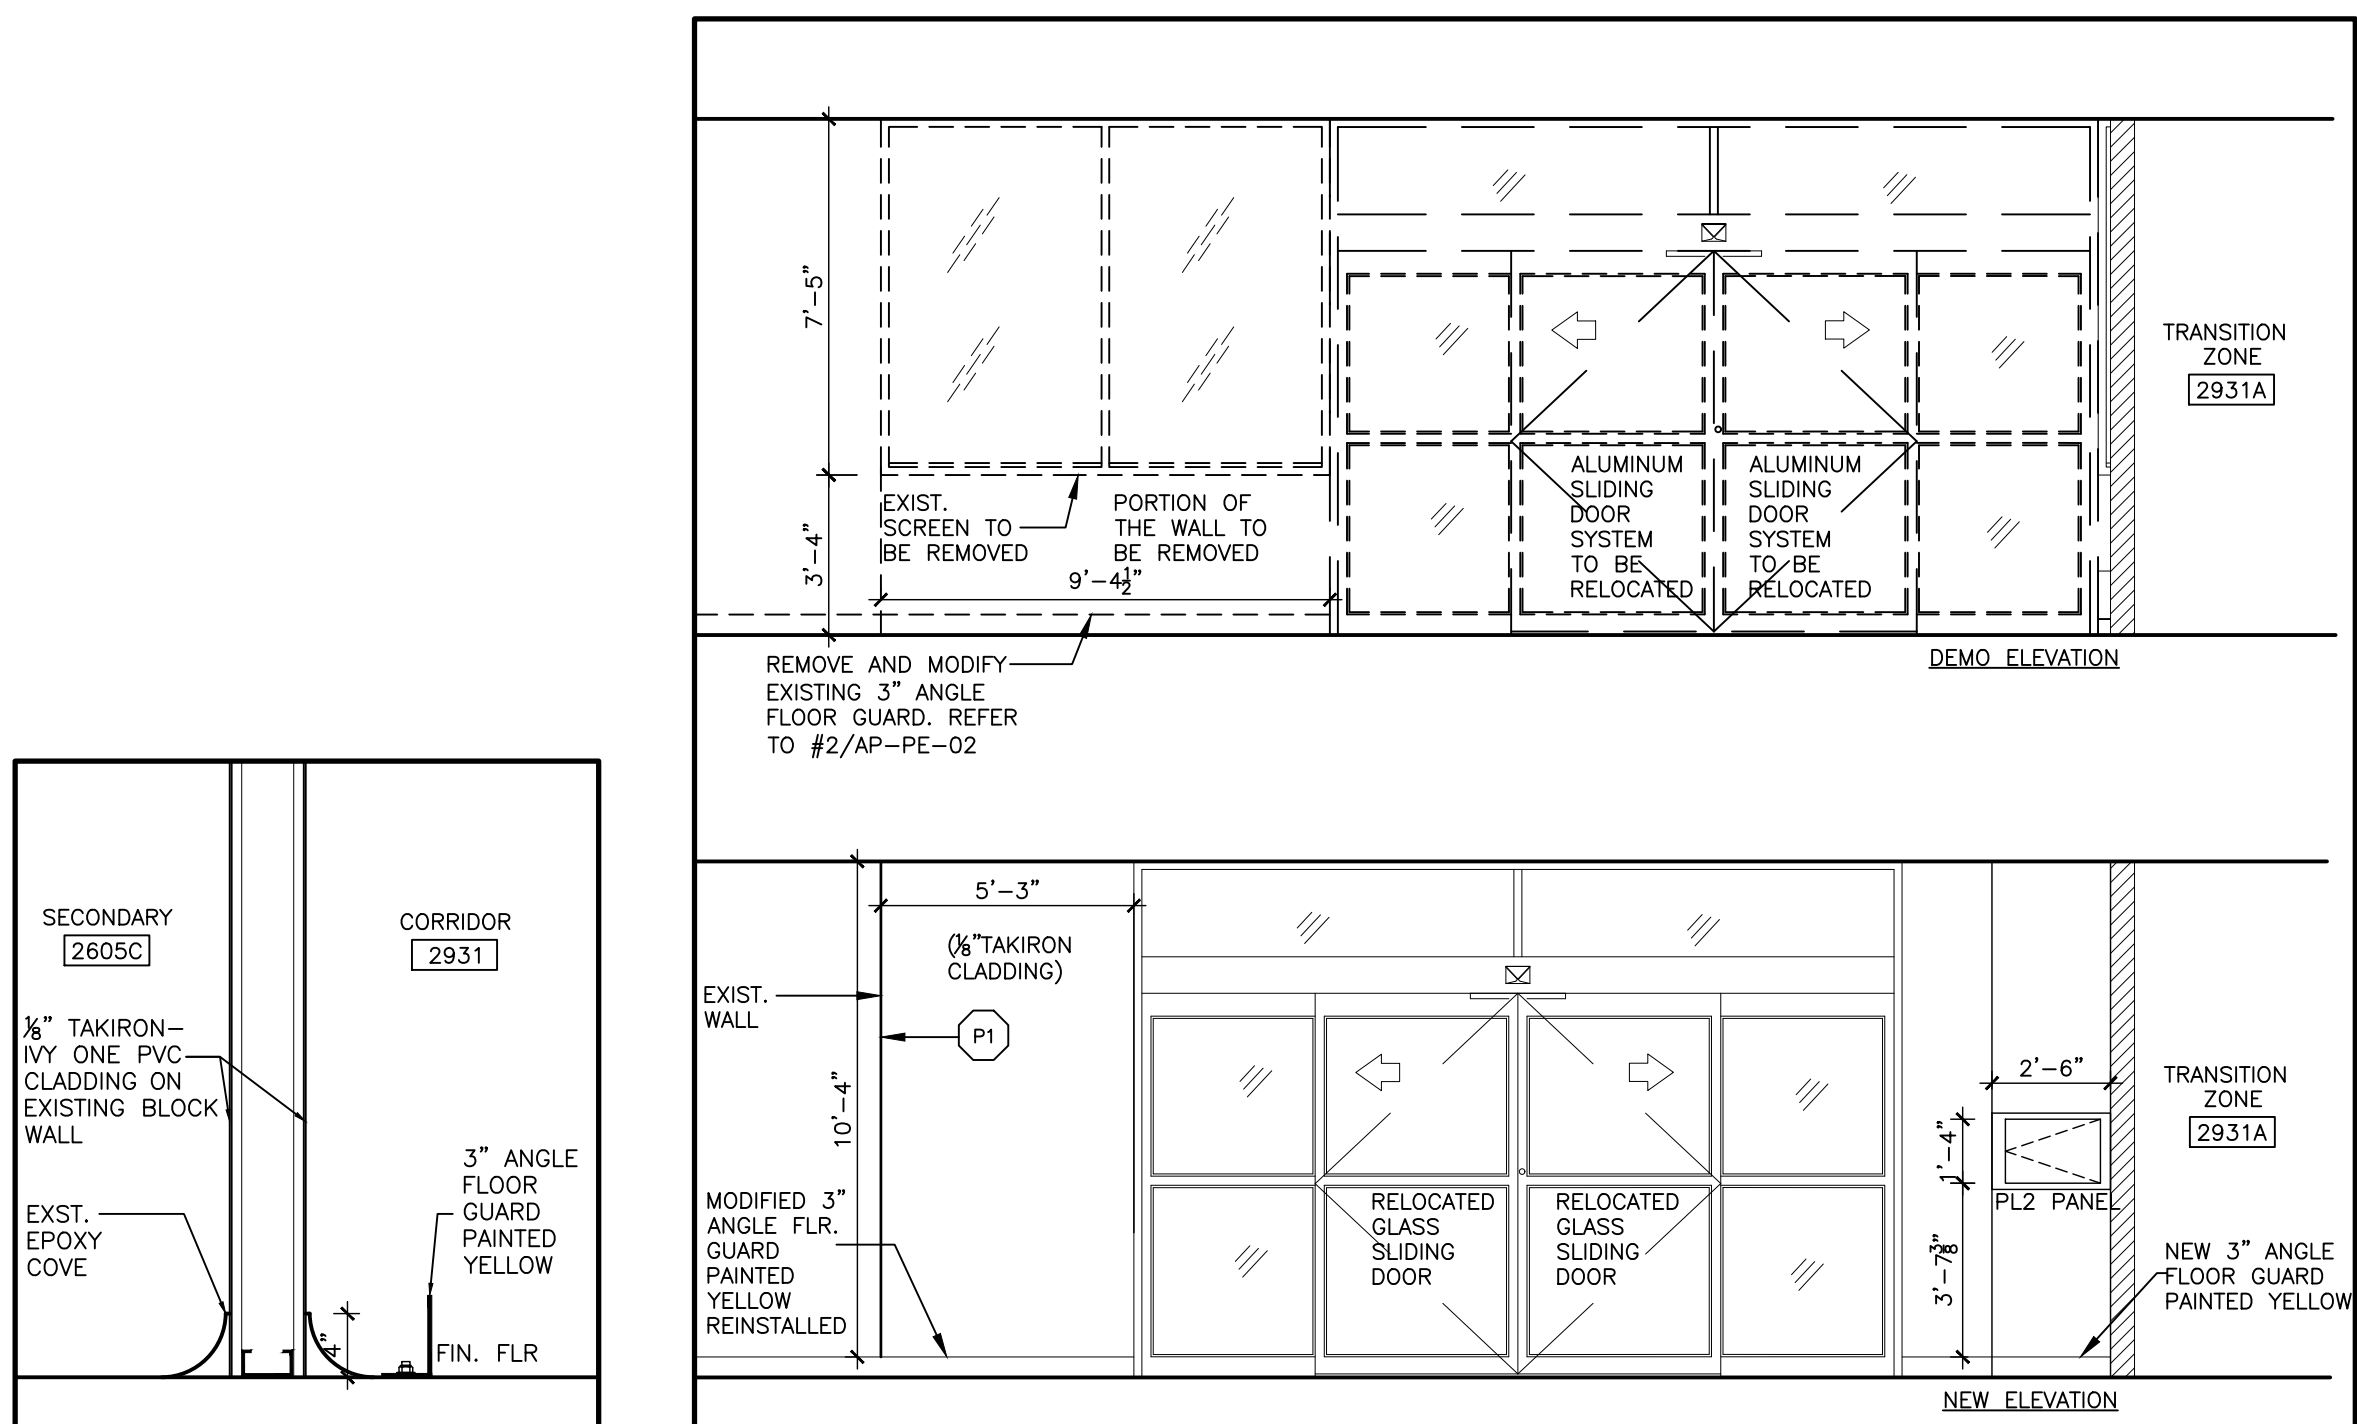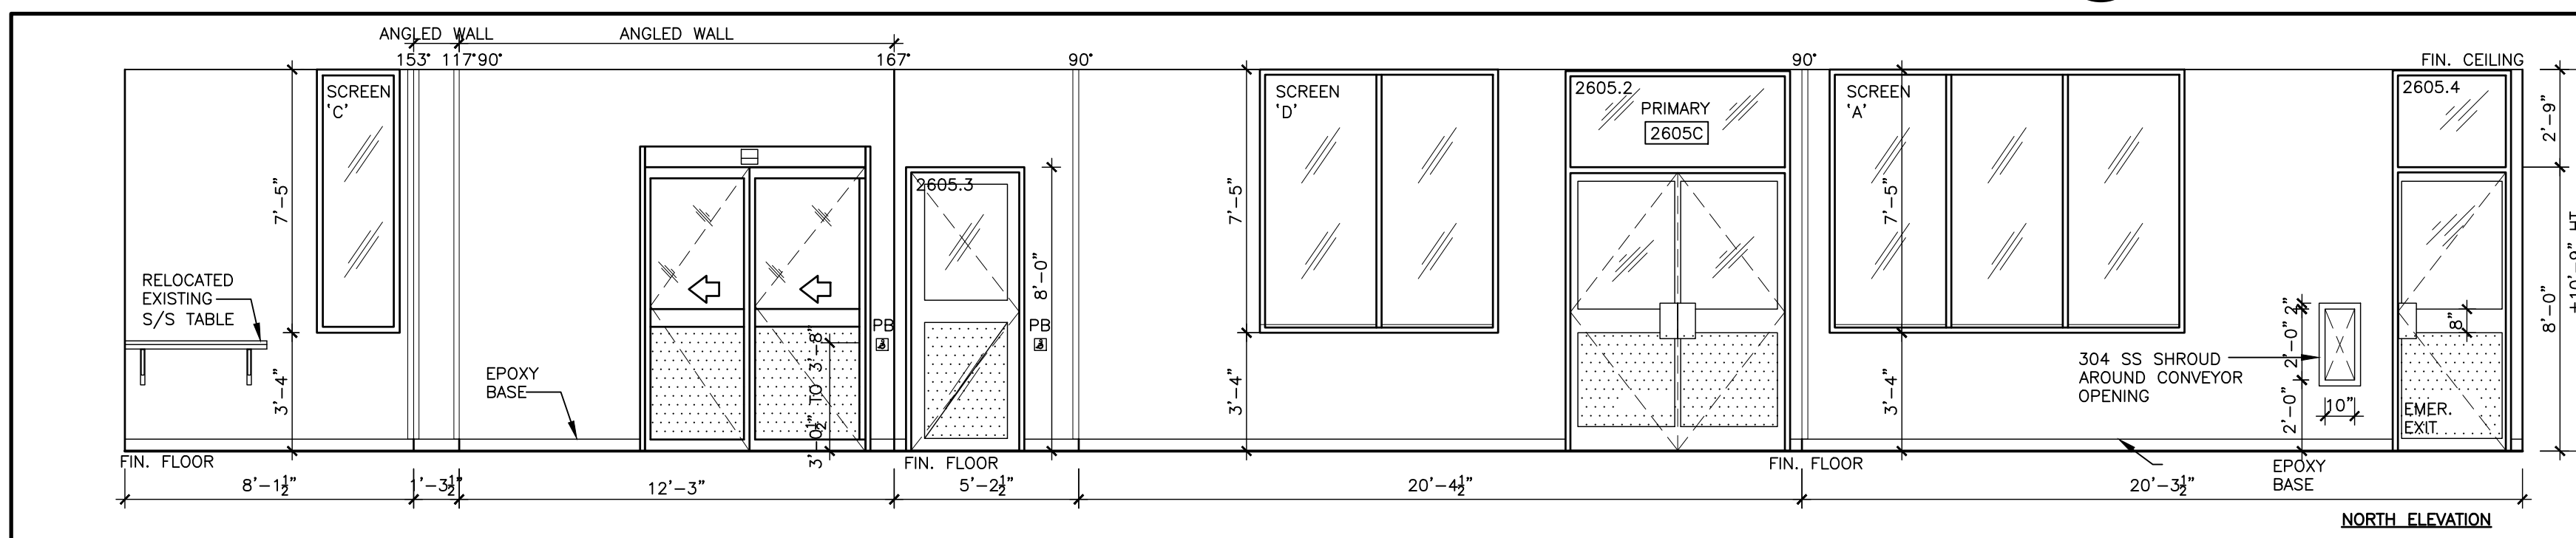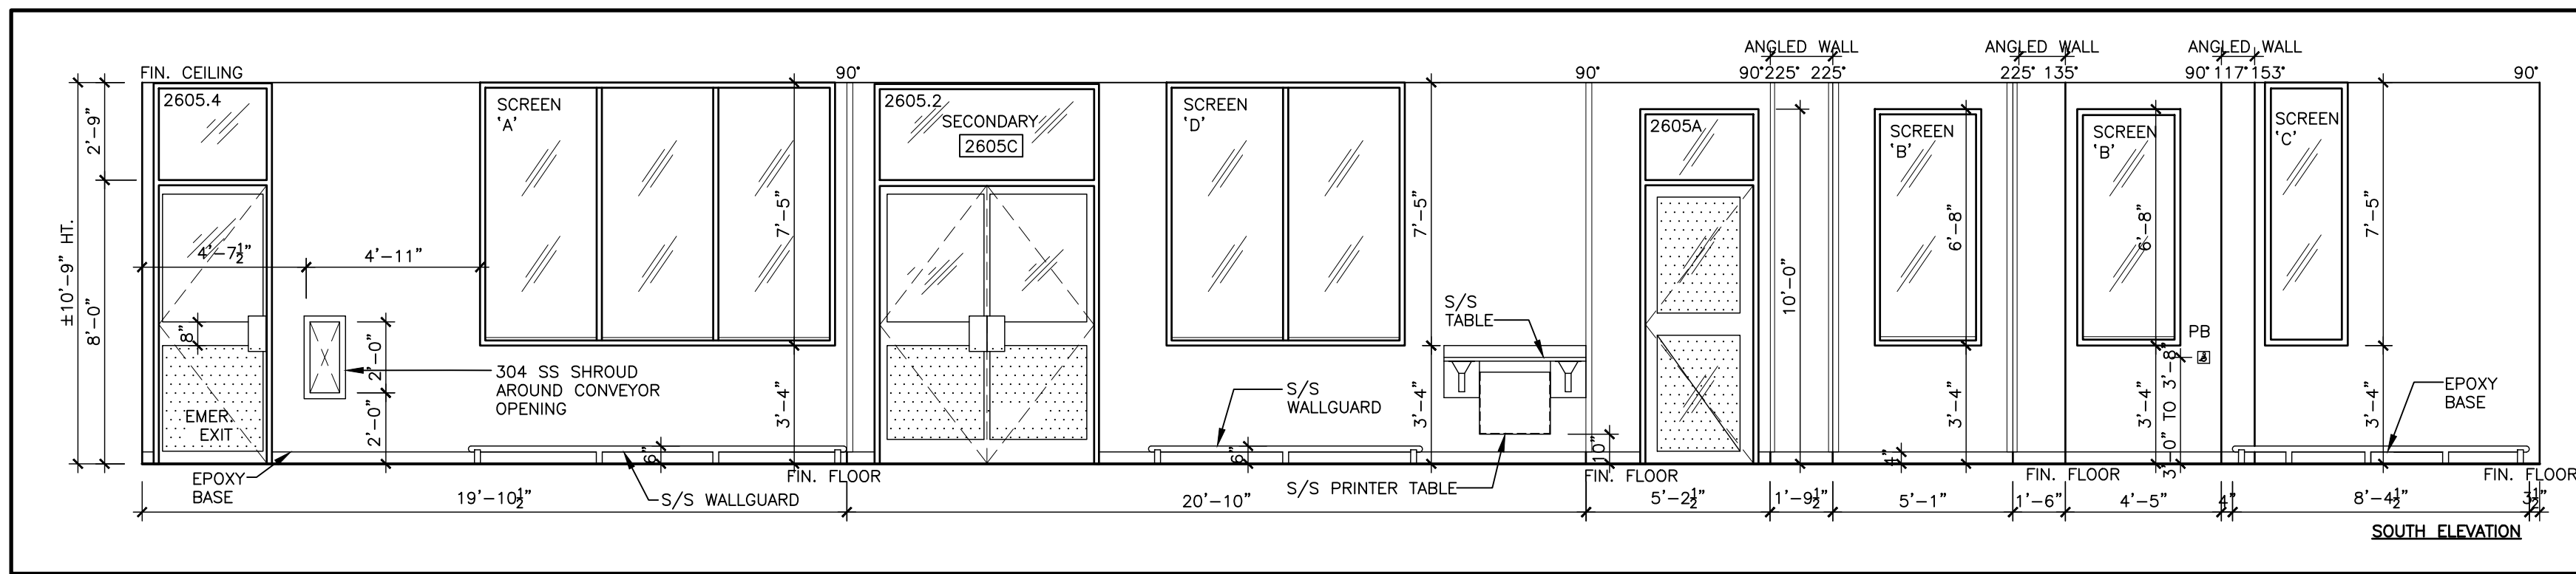

CONFIDENTIALITY NOTE:
This drawing shall not be copied, reproduced or distributed in any manner without the expressed written approval of APOTEX INC. or their designated agents.

No.	Date	Issued	By:
A	2024-02-01	ISSUED FOR 80% REVIEW	WBA
B	2024-02-09	ISSUED FOR PERMIT	WBA
C	2024-02-13	ISSUED FOR 90% REVIEW	WBA
D	2024-02-20	ISSUED FOR TENDER	WBA

TRUE NORTH PROJECT NORTH

FLOOR PLAN LEGEND:

- EXISTING AREA TO REMAIN
- INTERIOR ALTERATION / NEW ADDITION
- NEW DOOR AND FRAME
- EXISTING DOOR AND FRAME TO BE REMOVED
- EXISTING DOOR AND FRAME TO REMAIN

DEMOLITION LEGEND:

- TEMP. CONST. HOARDING FOR DEMOLITION AND NEW WALL/ CLNG. CONSTRUCTION.
- 1/2" PRE-FINISHED VINYL GYP. BOARD ON ONE SIDE OF 3/8" METAL STUDS @ 24" O.C. (PRODUCTION SIDE) FROM FIN. FLOOR TO U/S OF EXISTING CEILING (DOUBLE SIDED TAPE TRACK TO FLOOR) PROVIDE VINYL BASE.
- 2 SOFT TARP HOARDING FROM FLOOR TO CEILING FOR FINISHING STAGE.

WALL LEGEND:

- P1 1/2" TAKIRON- IYV ONE PVC CLADDING ON 3/8" GLASS MATT BOARD ON 3/8" METAL STUDS @ 16" O.C. UP TO U/S OF EXISTING CEILING. BOARD NOT REQUIRED JOINT FILLING/FINISHING.
- P2 1/2" TAKIRON- IYV ONE PVC CLADDING ON 3/8" GLASS MATT BOARD ON 2 1/2" METAL STUDS @ 16" O.C. UP TO U/S OF EXISTING CEILING.
- P3 1/2" TAKIRON- IYV ONE PVC CLADDING ON ONE SIDE ONLY OF 3/8" GYPSUM BOARD ON 3/8" METAL STUDS @ 16" O.C. UP TO U/S OF SLAB.
- PA 1/2" TAKIRON- IYV ONE PVC CLADDING ON ONE SIDE ONLY OF 3/8" GYPSUM BOARD ON 3/8" METAL STUDS @ 16" O.C. UP TO U/S OF SLAB.
- PS 1/2" TAKIRON- IYV ON EXISTING DRYWALL.

No.	Date	Revision	By:
1	2024-10-21	ISSUED FOR AS-BUILT	WBA
0	2024-04-23	ISSUED FOR CONSTRUCTION	WBA

Contractor must check and verify all dimensions and be responsible for same, reporting any discrepancies to the Architect or Engineer before commencing work.

Prints shall not be used for construction until signed "Approved For Construction" by the Architect or Engineer.

Prints are not to be scaled.

Professional Seal(s)

Ontario Association of Architects
Licence
ROYALEXANDER BASSO
7937

Client:
APOTEX INC.
CANADA'S PHARMACEUTICAL COMPANY

Project Title:
4100 WESTON ROAD, TORONTO
PACKAGING UPGRADES LINE 'D'


Drawing Title:
NEW SECOND FLOOR PLAN
DIMENSIONS
INTERIOR ELEVATIONS, DETAILS

CADD System and Version	Plot Scale	Sheet Size
111	111	30" x 42"

Designed By	Date	Drawn By	Date
G.S.S.	NOV/2023	J.A.J.	NOV/2023

Checked By	Date	Approved By	Date
G.S.S.	NOV/2023	G.S.S.	NOV/2023

Drawing Scale	AS NOTED	2231108	A302
Apotex Project No.	Site No.	Discipline	System
4101-505	4101	AP	PE
		03	1

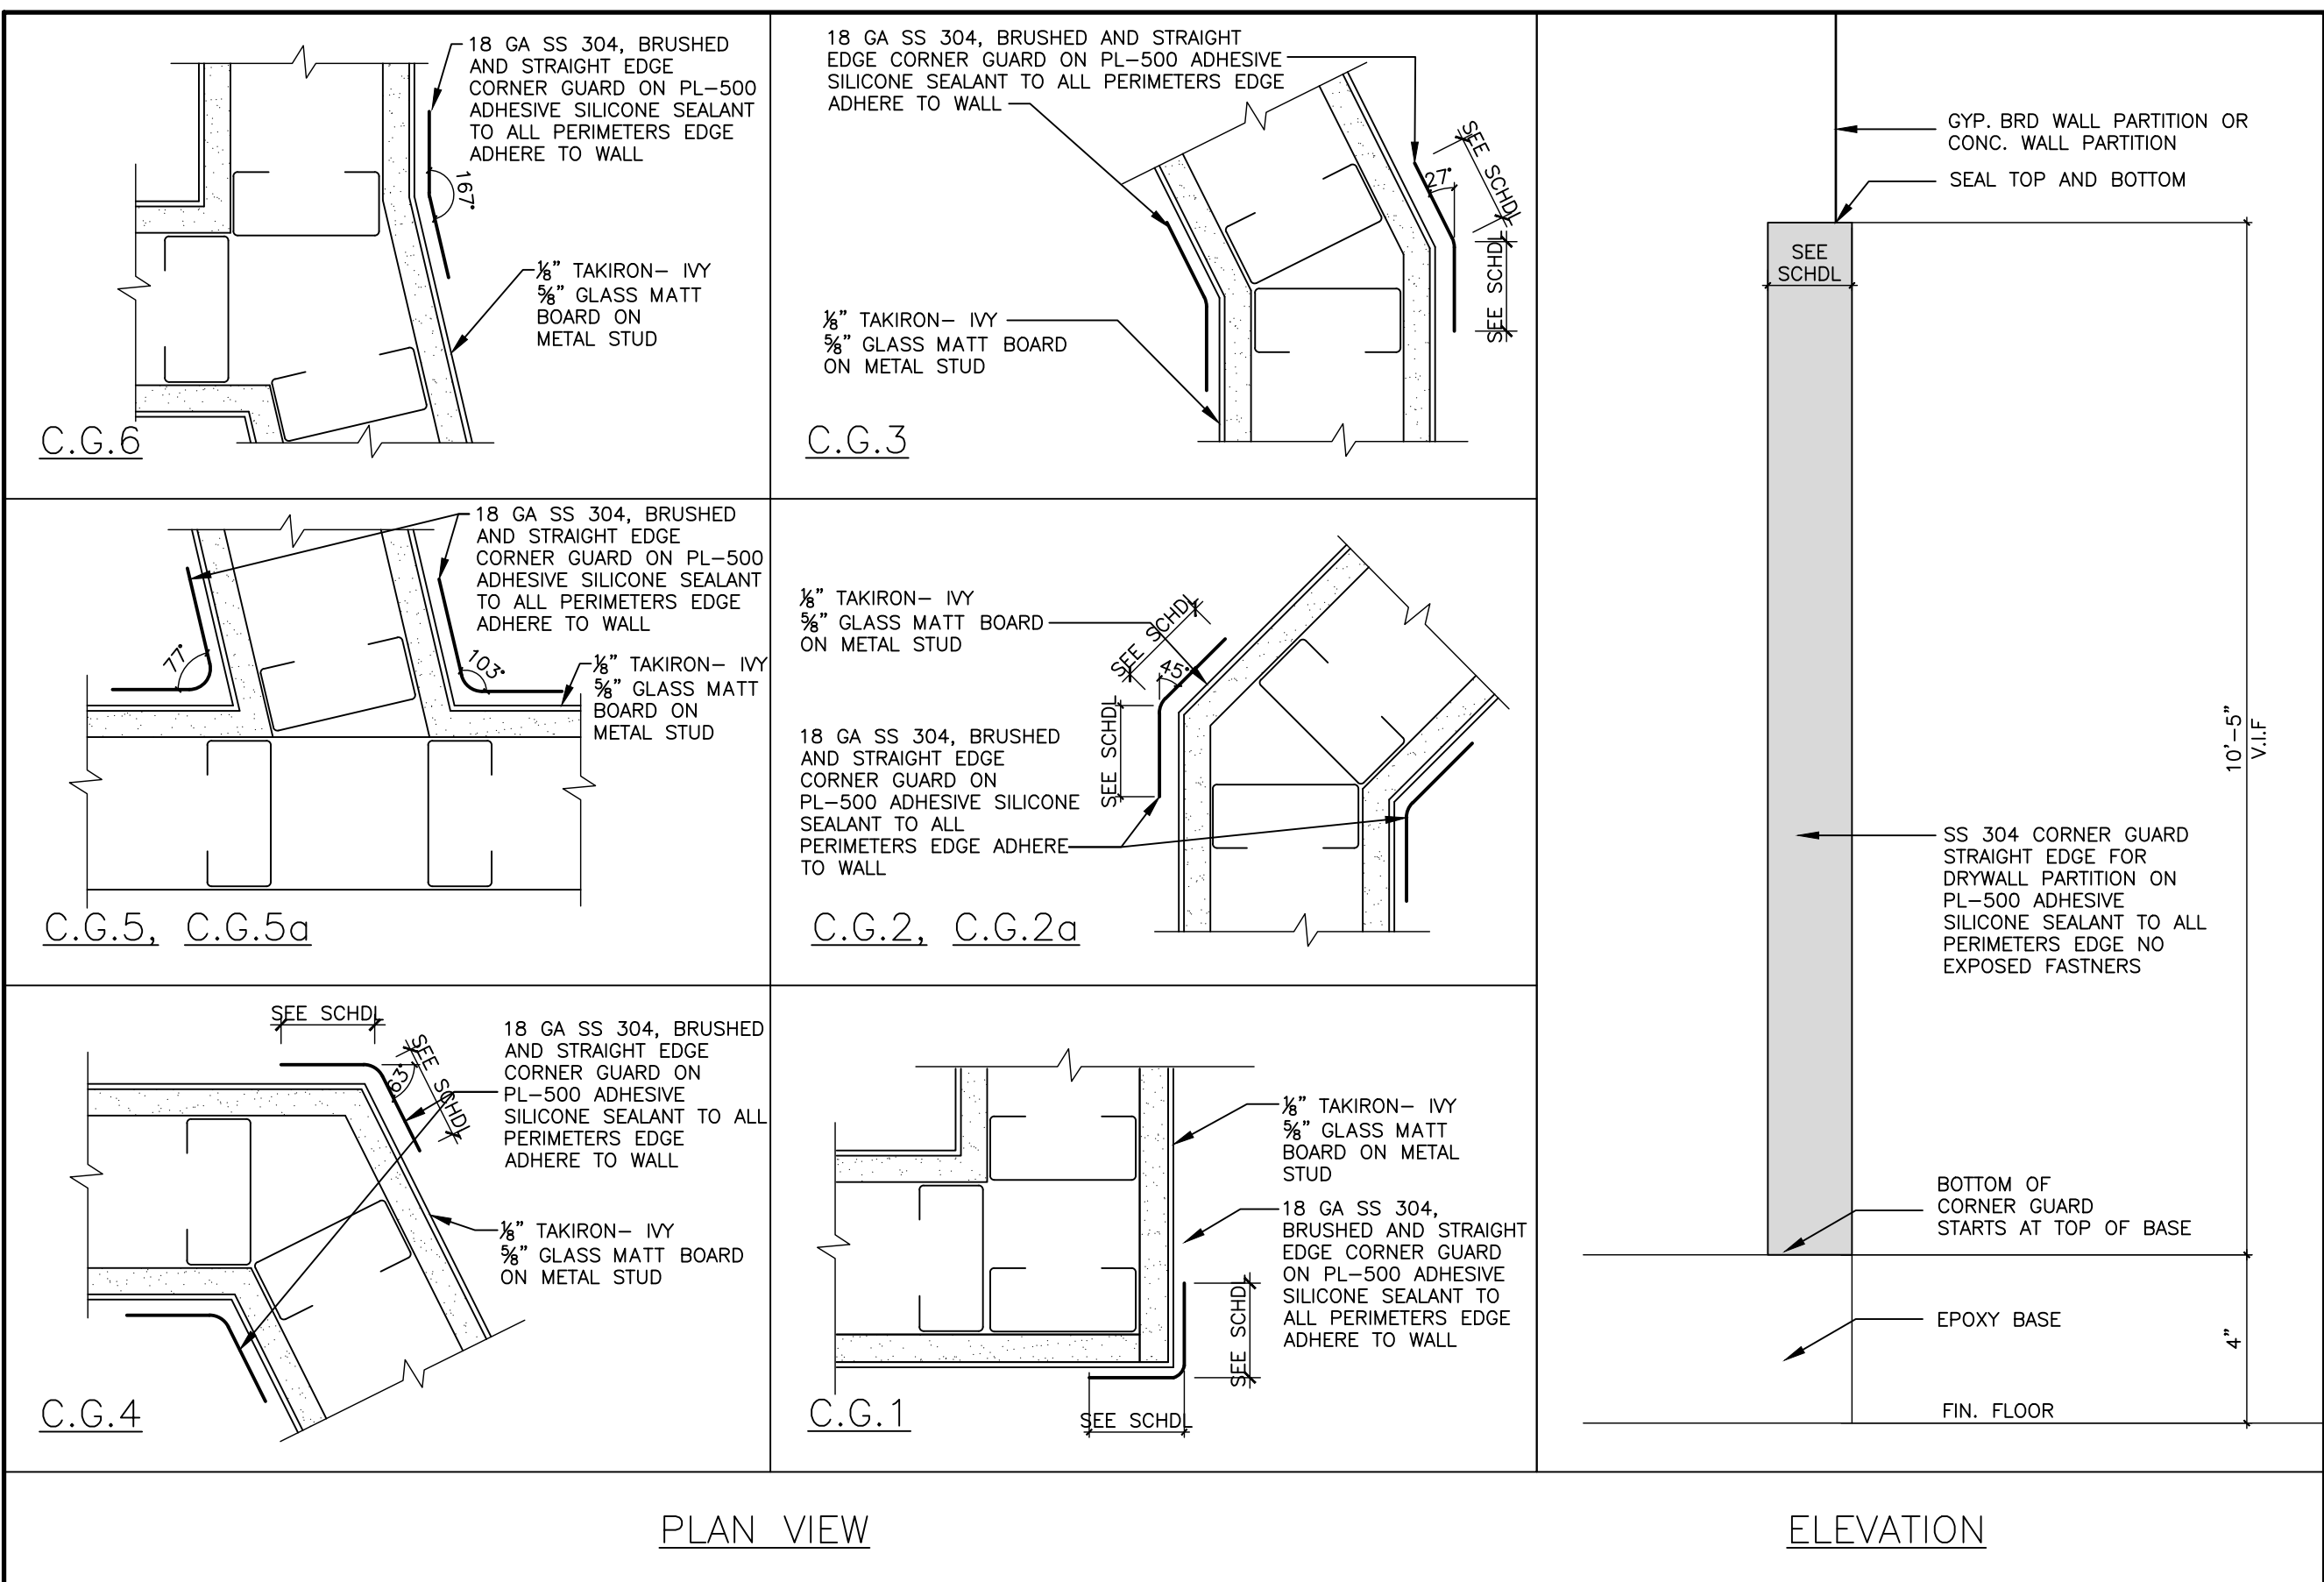


	SIZE	HEIGHT	THICKNESS	ANGLE	QTY
C.G.1.	2" X 2"	10'-5"	18 GA.	90°	11
C.G.2.	2" X 2"	10'-5"	18 GA.	135°	4
C.G.2a	2" X 2"	9'-8"	18 GA.	135°	4
C.G.3.	2" X 2"	10'-5"	18 GA.	153°	2
C.G.4.	2" X 2"	10'-5"	18 GA.	117°	2
C.G.5.	2" X 2"	10'-5"	18 GA.	103°	1
C.G.5a	2" X 2"	9'-8"	18 GA.	77°	1
C.G.6	2" X 2"	10'-5"	18 GA.	167°	1

PLEASE NOTE: SITE VERIFY ALL ANGLES

SS ANGLED WALL GUARD


AE-EE-01

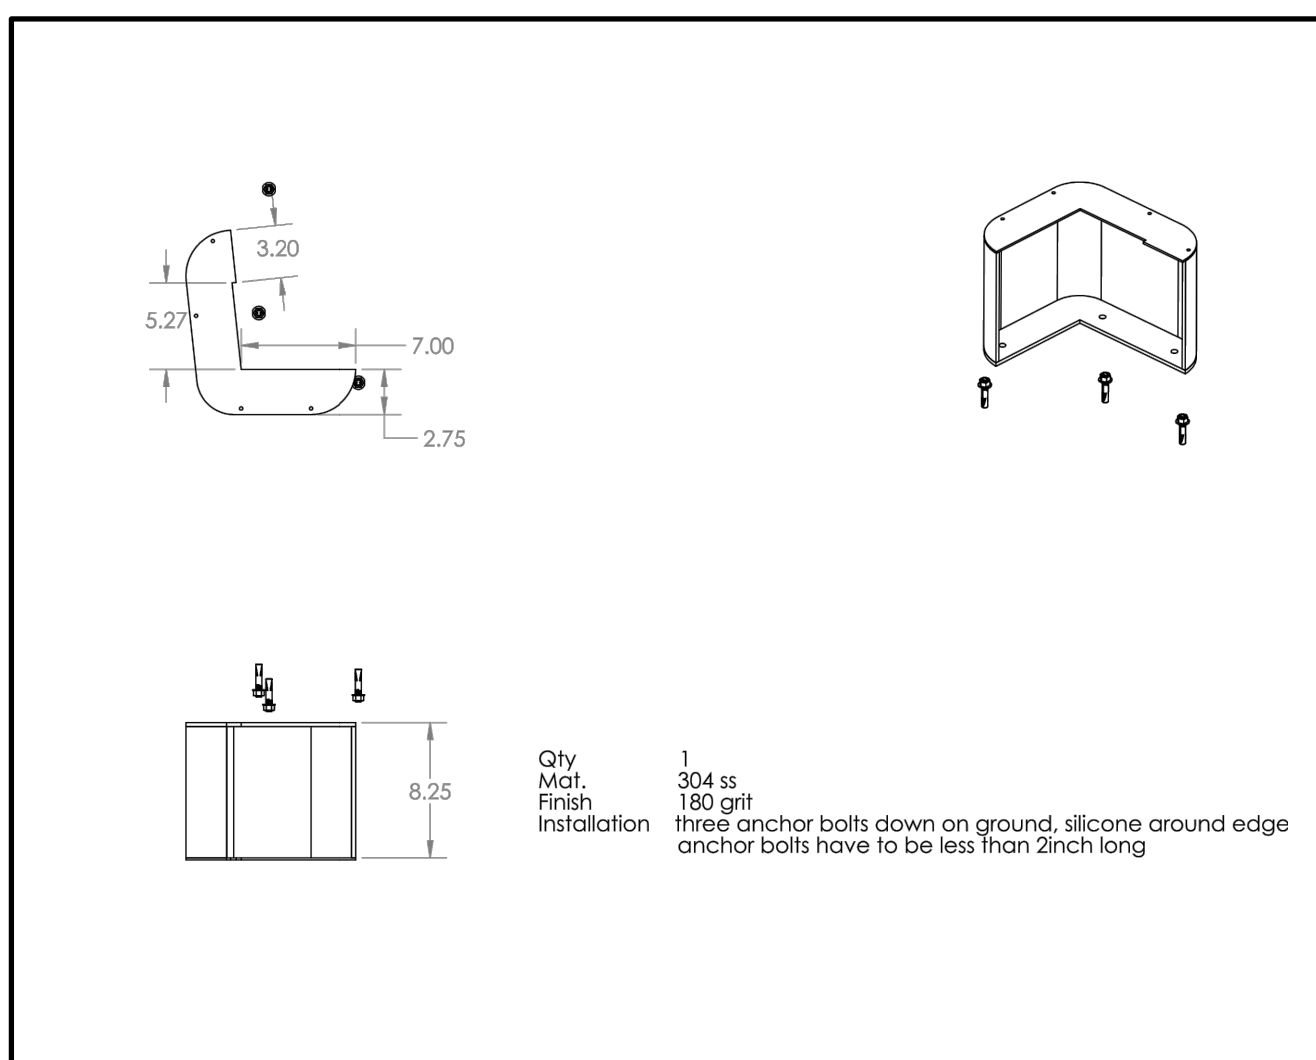

FLOOR GUARD AT BUMPER

AE-EE-01


V.I.F.

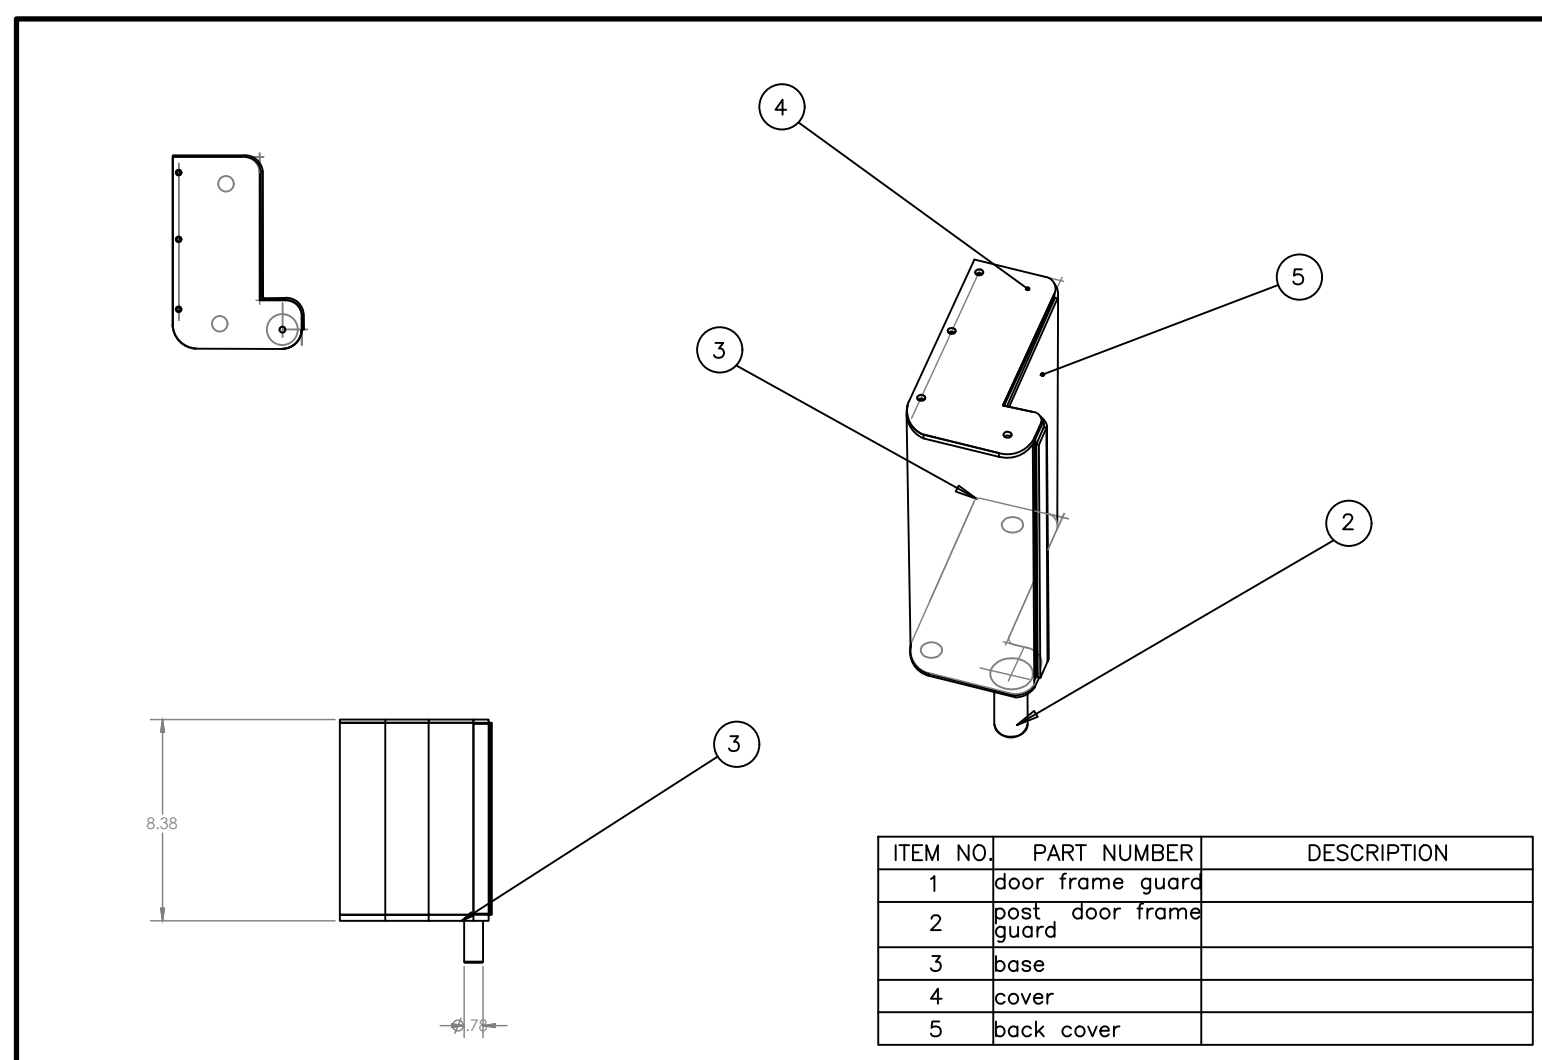

FLOOR GUARD AT DOOR FRAME

AE-EE-01

V.I.F.

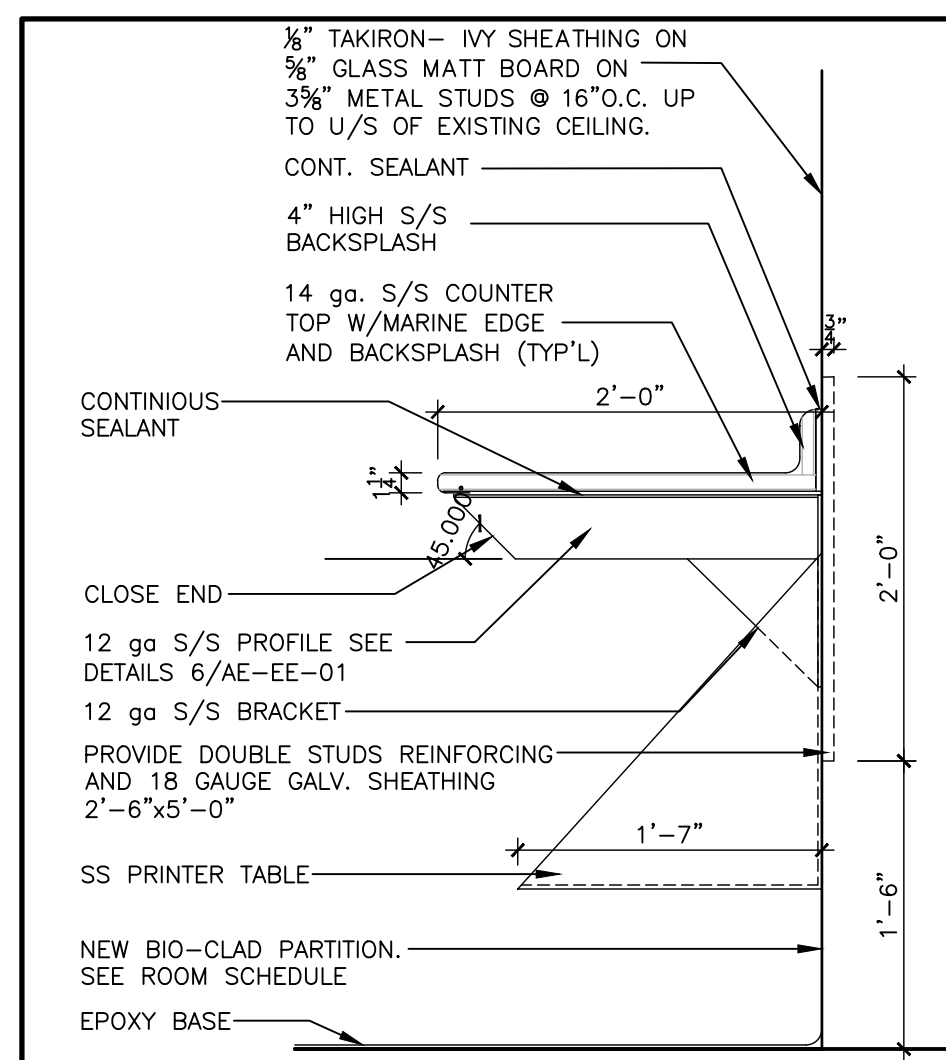

NEW SS TABLE @ BIO-CLAD WALL


AE-EE-01

1" = 1'-0"

STAINLESS STEEL COUNTER DETAILS

AE-EE-01

NTS

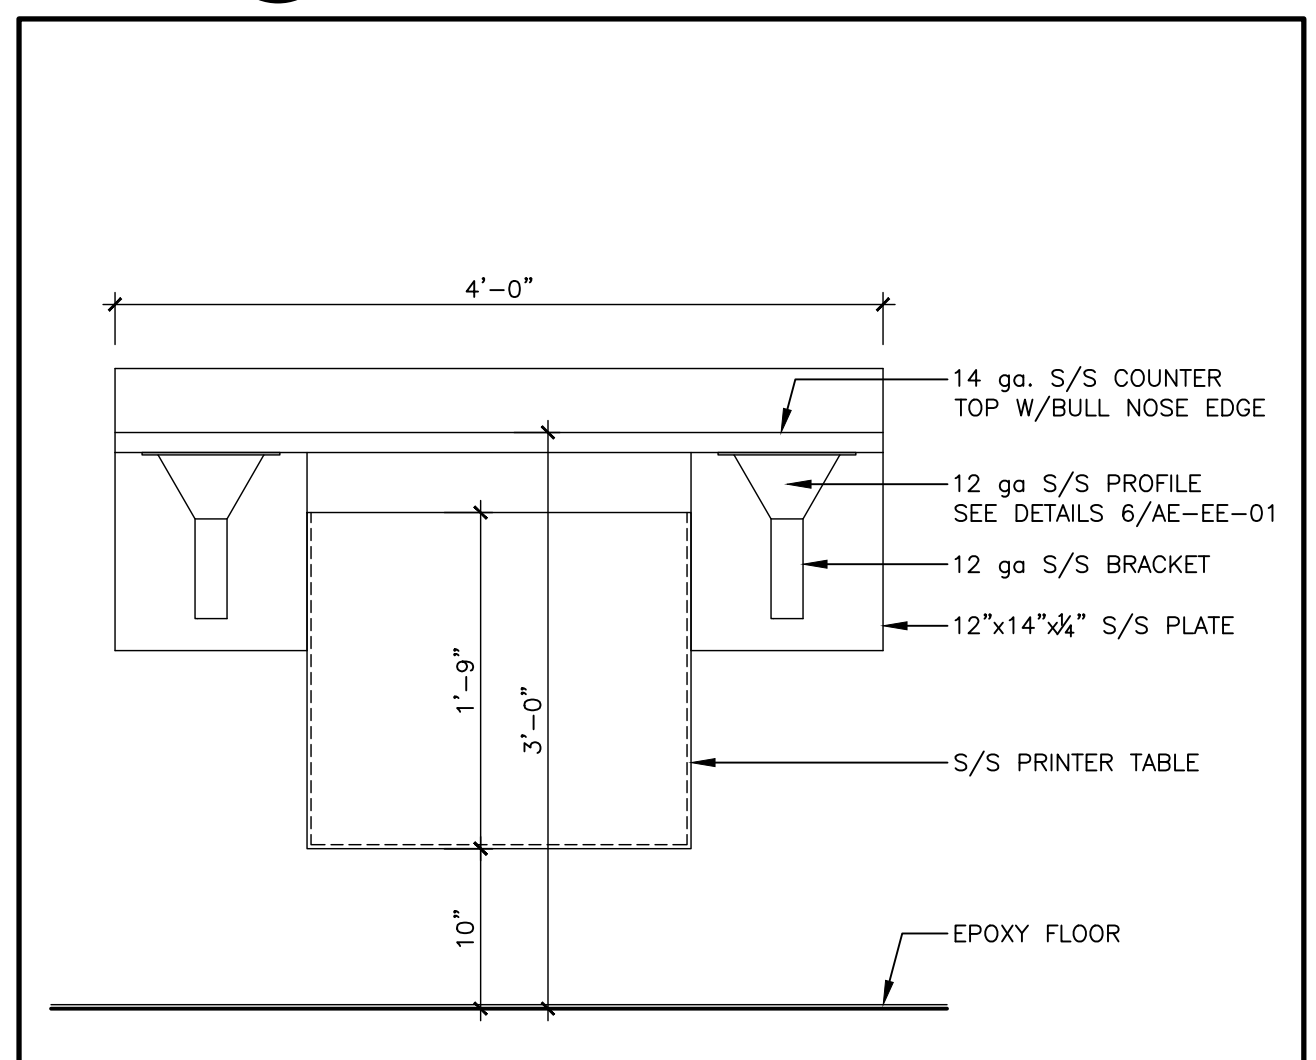

STAINLESS STEEL COUNTER

AE-EE-01

ELEVATION & SECTION

CONFIDENTIALITY NOTE:
This drawing shall not be copied, reproduced or distributed in any manner without the expressed written approval of APOTEX INC. or their designated agents.

No.	Date	Issued	By:
A	2024-02-01	ISSUED FOR 60% REVIEW	WBA
B	2024-02-09	ISSUED FOR PERMIT	WBA
C	2024-02-15	ISSUED FOR BOM REVIEW	WBA
D	2024-02-21	ISSUED FOR TENDER	WBA
E	2024-03-06	ISSUED FOR ADDENDUM 03	WBA

No.	Date	Revision	By:
1	2024-10-21	ISSUED FOR AS-BUILT	WBA
0	2024-04-23	ISSUED FOR CONSTRUCTION	WBA

Contractor must check and verify all dimensions and be responsible for same, reporting any discrepancies to the Architect or Engineer before commencing work.
Prints shall not be used for construction until signed 'Approved' For Construction by the Architect or Engineer.
Prints are not to be scaled.

Professional Seal(s)



Consultant:
wba
architects and engineers inc.

Client:
APOTEX INC.
CANADA'S PHARMACEUTICAL COMPANY

Project Title:
4100 WESTON ROAD, TORONTO
PACKAGING LINE 'D'

Drawing Title:
STAINLESS STEEL DETAILS

CADD System and Version: Plot Scale: 1:1 Sheet Size: 30" x 42"

Designed By: G.S.S. Date: NOV/2023 Drawn By: J.A.J. Date: NOV/2023

Checked By: G.S.S. Date: NOV/2023 Approved By: G.S.S. Date: NOV/2023

Drawing Scale: AS NOTED 2231108 Consultant Project No. Consultant Draw No. A701

Apotex Project No.: 4101-505 Site No.: 4101 AE EE 01 1

