

PROJECT NASH - JOHNSON & JOHNSON

890 WOODLAWN ROAD,
GUELPH, ONTARIO

ARCHITECTURAL NEW PROCESS BUILDING EXPANSION (a)

A000	COVER PAGE - DRAWING LIST
A001	SITE PLAN & BUILDING DATA MATRIX
A002a	ENLARGED DEMOLITION SITE PLAN
A003a	ENLARGED NEW SITE PLAN
A004	SITE DETAILS
L101	LIFE SAFETY GROUND FLOOR PLAN
L102	LIFE SAFETY SECOND FLOOR PLAN
A111	REFERENCE GROUND FLOOR PLAN
A112	REFERENCE SECOND FLOOR PLAN
A113	REFERENCE ROOF PLAN
A201a	DEMOLITION GROUND FLOOR PLAN
A202a	DEMOLITION SECOND FLOOR PLAN
A203a	DEMOLITION ROOF PLAN
A211a	DEMOLITION GROUND FLOOR REFLECTED CEILING PLAN
A212a	DEMOLITION SECOND FLOOR REFLECTED CEILING PLAN
A301	NEW GROUND FLOOR PLAN DIMENSIONAL
A301a	NEW GROUND FLOOR PLAN
A302	NEW SECOND FLOOR PLAN DIMENSIONAL
A302a	NEW SECOND FLOOR PLAN
A303a	NEW ROOF PLAN
A304a	ROOF DETAILS
A305a	NEW ROOF PLAN (FM GLOBAL)
A306a	NEW GROUND FLOOR - FLOOR FINISHES PLAN
A307a	NEW SECOND FLOOR - FLOOR FINISHES PLAN
A311a	NEW GROUND FLOOR REFLECTED CEILING PLAN
A312a	NEW SECOND FLOOR REFLECTED CEILING PLAN
A402a	NEW & DEMOLITION ELEVATIONS
A502a	NEW & DEMOLITION PARTIAL BUILDING SECTIONS
A503a	NEW & DEMOLITION PARTIAL BUILDING SECTIONS
A504a	SECTIONS AND PLAN TABLETING NO. 1 E122
A505a	SECTIONS AND PLAN TABLETING NO. 2 E123
A506a	SECTIONS AND PLAN TABLETING NO. 3 E127
A512a	NEW WALL SECTIONS
A513a	NEW WALL SECTIONS (PROCESS)
A514a	NEW WALL SECTIONS (PROCESS)
A601a	SECTION DETAILS
A701a	PLAN DETAILS
A702a	CEILING DETAILS
A703a	STAINLESS STEEL DETAILS
A704a	STAINLESS STEEL DETAILS
A705a	STAINLESS STEEL PLATFORM DETAILS
A706a	STAINLESS STEEL DETAILS
A707a	MISCELLANEOUS DETAILS
A708a	SUMP PIT DETAILS
A711a	WASHER DETAILS
A712a	WASHER DETAIL ELEVATION
A721	STAIR DETAILS
A722	STAIR DETAILS
A731	ELEVATOR DETAILS
A732	ELEVATOR DETAILS
A801a	GROUND FLOOR INTERIOR ROOM ELEVATIONS
A801b	GROUND FLOOR INTERIOR ROOM ELEVATIONS
A802	SECOND FLOOR INTERIOR ROOM ELEVATIONS
A901	DOOR SCHEDULE & DETAILS
A902	ROOM FINISHES SCHEDULE & DETAILS

STRUCTURAL NEW PROCESS BUILDING EXPANSION (a)

S001	GENERAL NOTES
S002	TYPICAL DETAILS
S100A	FOUNDATION PLAN
S101A	SLAB ON GRADE PLAN
S102A	SECOND FLOOR FRAMING PLAN
S103A	ROOF FRAMING PLAN
S201A	SLAB ON GRADE CONCRETE PLAN
S202A	SECOND FLOOR CONCRETE PLAN
S300A	ELEVATOR DETAILS
S301A	SUMP PIT DETAILS
S310A	FRAMING ELEVATIONS
S400A	FOUNDATION SECTIONS
S401A	FOUNDATION SECTIONS
S602A	SECOND FRAMING SECTIONS
S603A	ROOF FRAMING SECTIONS
S701A	AHU FRAMING PLAN

NOTES

These drawings are the property of, and shall not be used or reproduced without the consent of WBA Architects and Engineers Inc. The Contractor shall check and verify all dimensions and report all discrepancies to the Architect and/or Engineer.

No.	Date	Issued	By:
A	2022-02-18	ISSUED FOR BUDGET ESTIMATE	WBA
B	2022-03-23	ISSUED FOR 75% DESIGN REVIEW	WBA
C	2022-04-08	ISSUED FOR 90% DESIGN REVIEW	WBA
D	2022-04-29	ISSUED FOR TENDER	WBA

1	2024-04-11	ISSUED FOR AS-BUILT	WBA
0	2022-07-13	ISSUED FOR CONSTRUCTION	WBA

No.	Date	Revision	Professional Seal	By:

Consultant:
 3 - 530 Rosetree Dairy Road
Wexham, Ontario L4L 8H2
Tel: 905-851-0616
Fax: 905-851-1148
email: info@wbawae.com


Client:

890 WOODLAWN ROAD,
GUELPH, ON

Project Title:
PROJECT NASH

Drawing Title:
COVER PAGE

CADD System :	Plot Scale:	Sheet Size:
AUTOCAD 2016	1:1	30" x 42"
Drawn By:	Date:	Drawing Scale:
R.R.	JAN/2022	AS NOTED
Checked By:	Date:	Rev:
G.S.S	JAN/2022	1
Project No:	Dwg No:	
2210711	A000	

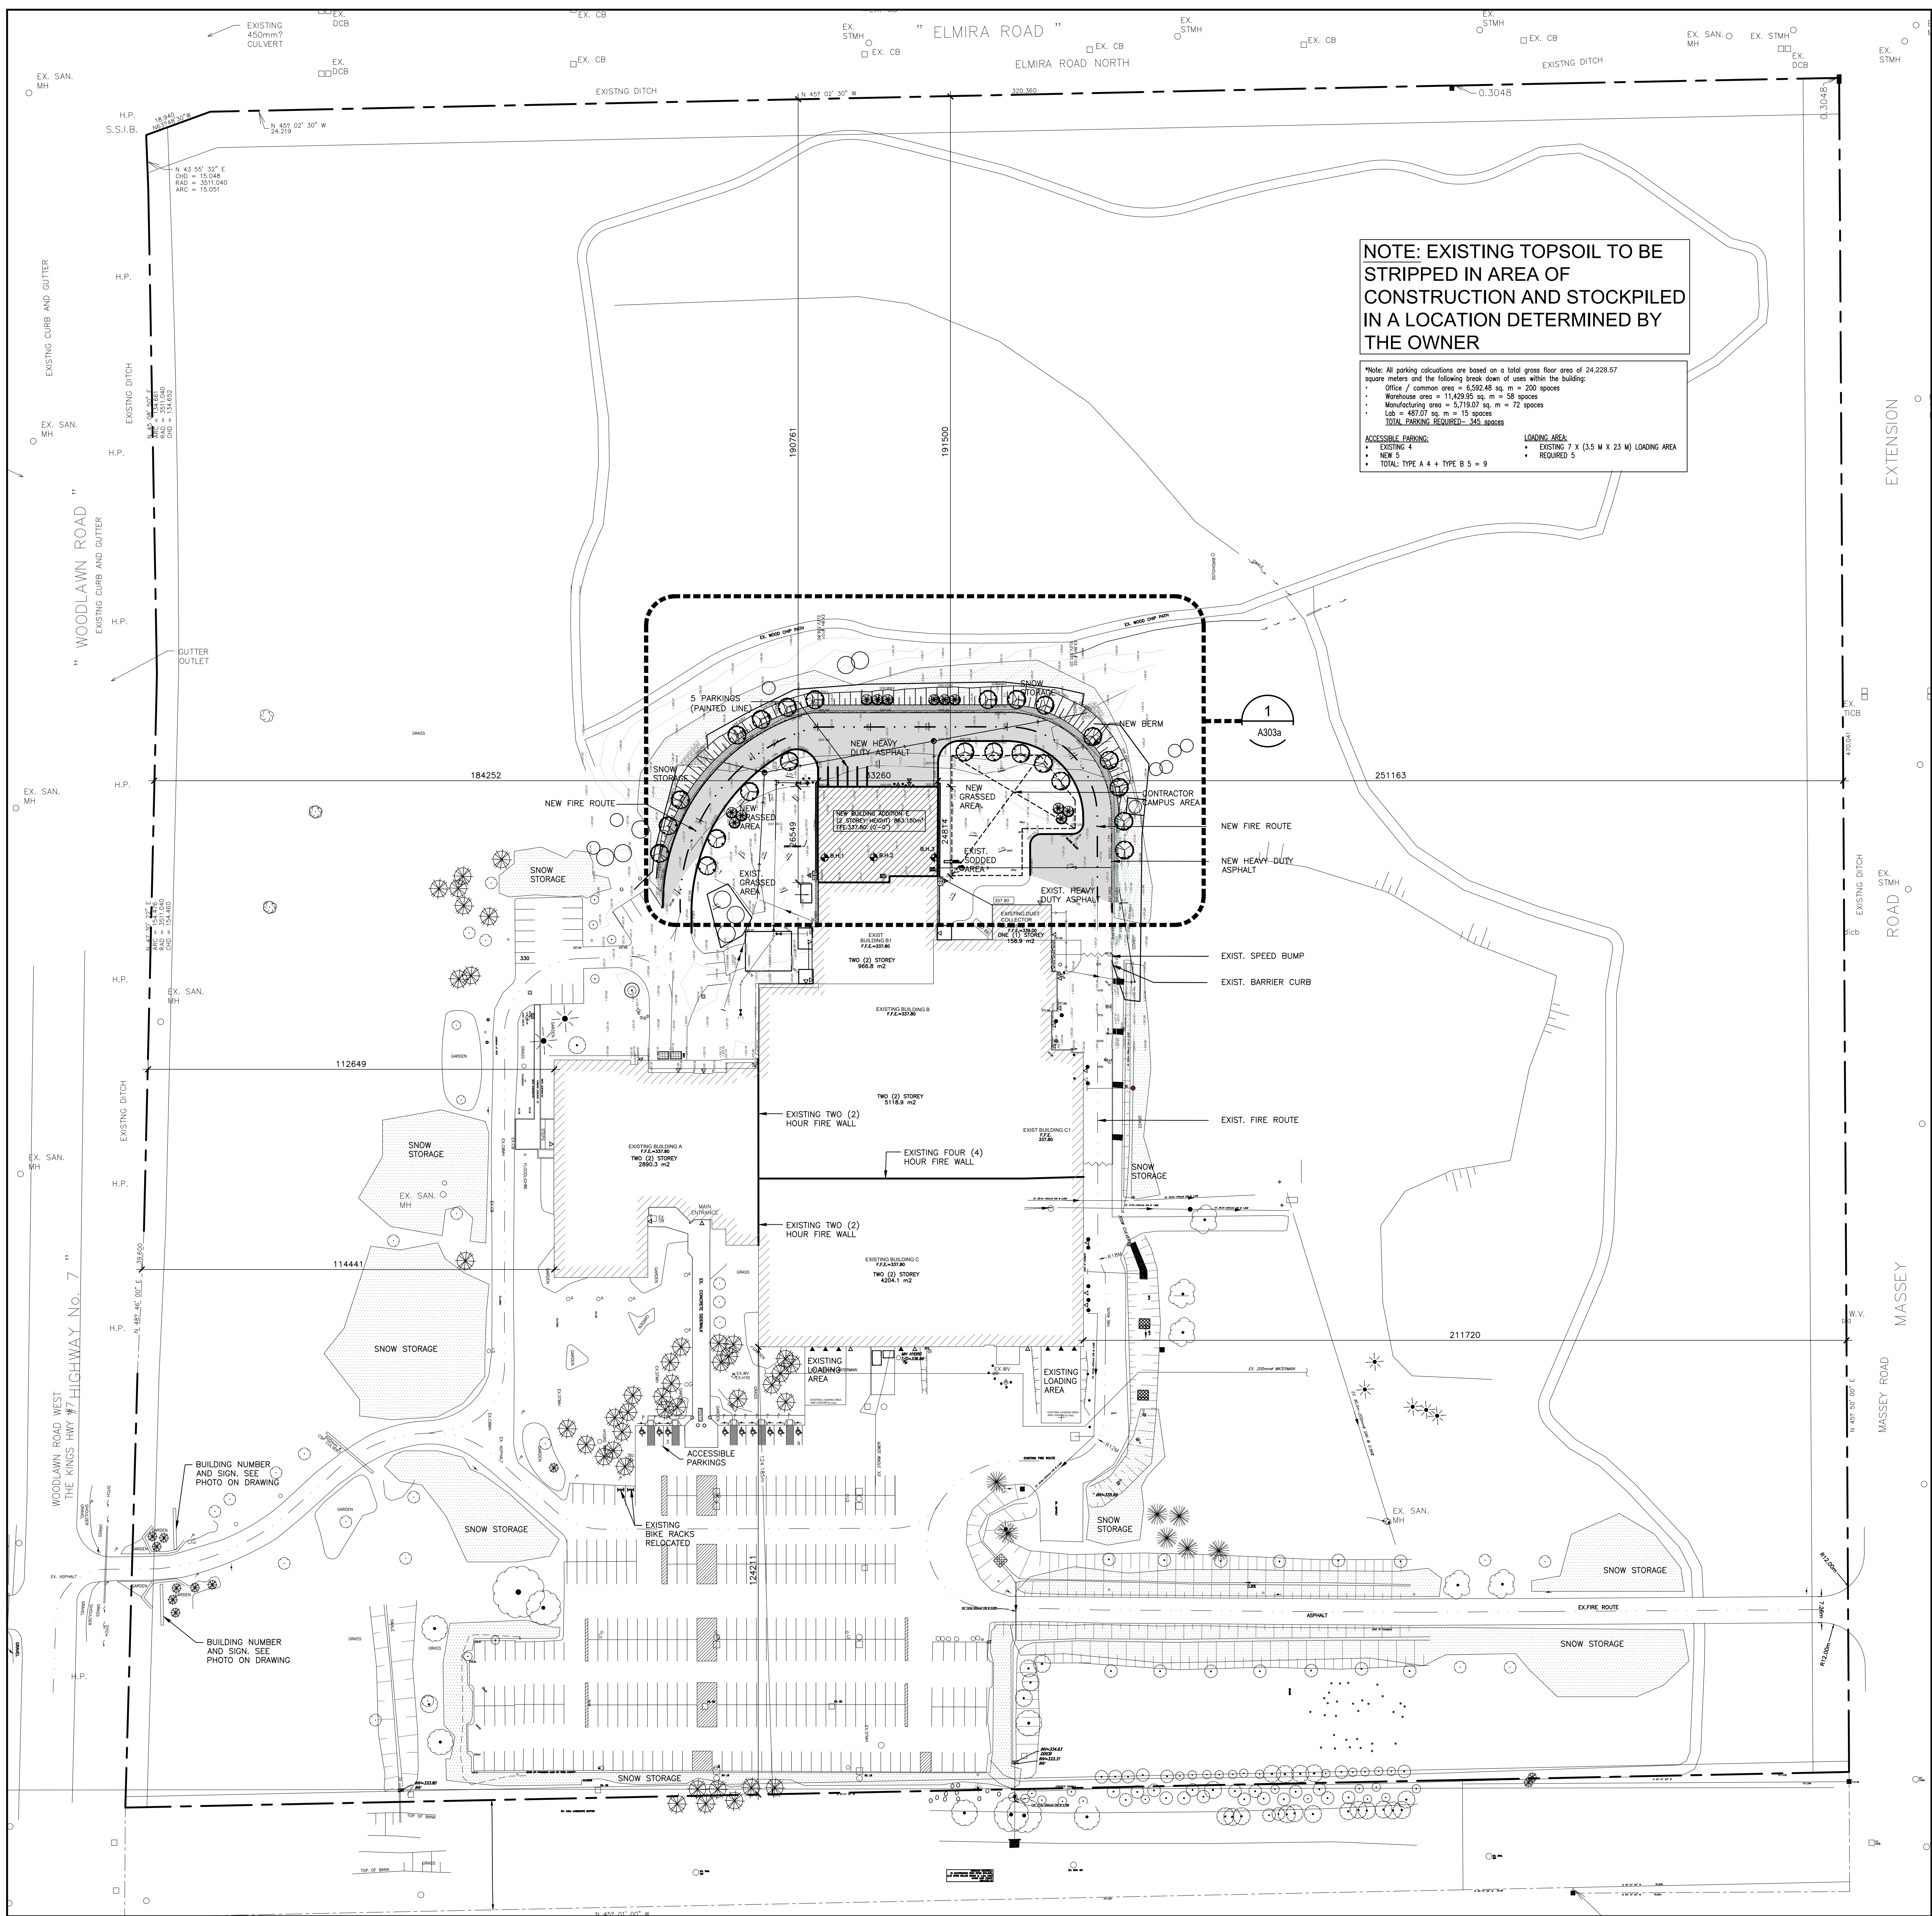


ZONING CHART & REGULATIONS / PROJECT STATISTICS

ZONE: B.3 PROPOSED USE: INDUSTRIAL				
REGULATION	REQUIREMENT	EXISTING	PROPOSED	COMPLIES
MINIMUM LOT FRONTAGE	30 METERS	464 METERS	464 METERS	YES
MINIMUM FRONT YARD	6 METERS	112.681 METERS	112.681 METERS	YES
MINIMUM SIDE YARD	10 METERS OR ONE-HALF BUILDING HT WHICH EVER IS GREATER	124.185 METERS	124.185 METERS	YES
MINIMUM EXTERIOR SIDE YARD	6 METERS	217.310 METERS	190.761 METERS	YES
MINIMUM REAR YARD	10 METERS OR ONE-HALF BUILDING HT WHICH EVER IS GREATER	196.134 METERS	196.134 METERS	YES
ACCESSORY USES	NOT MORE THAN 25% OF THE BUILDING FLOOR AREA SHALL BE USED FOR ANY ACCESSORY USE PERMITTED IN A B ZONE. SEE SECTION 7.3.2 FOR REGULATIONS GOVERNING MALLS IN THE B.2 ZONE.	NONE	NONE	YES
OFF-STREET PARKING	345 SPACES	344 SPACES	346 SPACES	YES
OFF-STREET LOADING	5 SPACES	8 SPACES	8 SPACES	YES
OUTDOOR STORAGE	SEE SECTION 4.12	N/A	N/A	YES
MINIMUM LANDSCAPED OPEN SPACE	THE REQUIRED FRONT AND EXTERIOR SIDE YARD ON ANY LOT, EXCEPTING THE DRIVEWAY, PARKING AREAS, OR LOADING AREAS, SHALL BE LANDSCAPED.	YES	YES	YES
BUFFER STRIPS	WHERE A B ZONE ABUTS ANY RESIDENTIAL, INSTITUTIONAL, PARK, WETLAND OR URBAN RESERVE ZONE, A BUFFER STRIP SHALL BE DEVELOPED	3 METERS	3 METERS	YES
MAXIMUM BUILDING HEIGHT	20 METERS AND IN ACCORD WITH SECTION 4.18	11.278 METERS	11.278 METERS	YES
FENCES	MAXIMUM HT OF 3 METERS MEASURED FROM GROUND LEVEL TO TOP OF FENCE IN THE FRONT YARD SHALL BE AN OPEN CHAIN LINK AND MAY HAVE A WIRE TOP PROVIDED THE OVERALL HT OF THE FENCE AND WIRE TOP IS NOT GREATER THAN 3 METERS IN HEIGHT	N/A	N/A	YES
GARBAGE, REFUSE STORAGE AND COMPOSTERS	SECTION 4.9	PRIVATE PICK UP SCREENED FROM STREET	PRIVATE PICK UP SCREENED FROM STREET	YES
MAX. PUBLIC FLOOR SPACE	A MAXIMUM OF 30% OF THE GROSS FLOOR AREA OF AN INDUSTRIAL MALL BUILDING MAY BE USED FOR DISPLAY AND SALES AREAS OR ASSEMBLY OCCUPANCIES OPEN TO THE PUBLIC. IN THE CASE OF PHASED CONSTRUCTION, NOT MORE THAN 30% OF THE ACTUAL AREA SHALL BE USED FOR DISPLAY AND SALES AREA OR PUBLIC ASSEMBLY OCCUPANCIES AT ANY TIME.	NONE	NONE	YES
MINIMUM BUILDING SIZE	NEW INDUSTRIAL DEVELOPMENT - 464.5 M2 GROUND FLOOR AREA	13,339.0 M2 GROUND FLOOR AREA	14,202 M2 GROUND FLOOR AREA	YES
ACCESSORY BUILDINGS OR STRUCTURES		NONE	NONE	YES

Name of Practice: WBA ARCHITECTS & ENGINEERS INC. 3-530 ROWNTREE DRIVE ROAD, VAUGHAN, ONTARIO L4L 8P2	
Name of Project: NEW PROCESS ADDITION	
Location: JOHNSON & JOHNSON 690 WOODLAWN ROAD, GUELPH, ON	
Item Ontario Building Code Data Matrix Part 3 Building Code Reference	
3.00 Building Code Version	O. Reg. 332/12 Last Amendment O. Reg. 191/14
3.01 Project Type:	☐ New ☒ Addition ☐ Change of Use ☐ Addition and Renovation ☐ Renovation Description: NEW PROCESS ADDITION
3.02 Major Occupancy Classification:	Occupancy Group: F-2 Use INDUSTRIAL 3.1.2.1(1)
3.03 Superimposed Major Occupancies:	☒ No ☐ Yes 3.2.2.70
3.04 Building Area (m²):	Description: Existing New Total BUILDING A 2890.3 2890.3 BUILDING B 5277.8 5277.8 BUILDING C 4204.1 4204.1 BUILDING D 955.8 955.8 BUILDING E 863.2 863.2 Total: 13,339.0 863.2 14,202.2
3.05 Gross Area (m²):	Description: Existing New Total GROUND FLOOR 13,305.22 863.2 14,168.42 SECOND FLOOR 9,196.95 863.2 10,060.15 Total: 22,502.17 1,726.4 24,228.57
3.06 Mezzanine Area (m²):	Description: N/A Existing New Total Total: 3.2.1.1
3.07 Building Height	TWO (2) Storeys above grade 11.28 (m) above grade 3.2.1.1
3.08 High Building	☒ No ☐ Yes 3.2.6
3.09 No. of Storeys/Firefighter access	TWO (2) Streets 3.2.2.10 & 3.2.6
3.10 Building Classification:	3.2.2.688 Group/Div F-2 SPRINKLED 3.2.2.69
3.11 Sprinkler System:	☒ Required ☐ Not Required ☒ Entire building ☐ Selected floor areas ☐ Selected compartments ☐ In lieu of roof rating ☐ None 3.2.1.5 & 3.2.1.7
3.12 Standpipe System	☐ Required ☒ Not Required 3.2.8
3.13 Fire Alarm System	☐ Required ☒ Not Required ☐ Single stage ☒ Two stage ☐ None 3.2.4
3.14 Water Service / Supply is Adequate	☐ No ☒ Yes 3.2.4.1
3.15 Construction Type:	Restriction: ☒ Combustible permitted ☒ Non-combustible required Actual: ☐ Combustible ☒ Non-combustible ☐ Combination ☐ No ☐ Yes 3.2.2.20 - 83 & 3.2.1.4
3.16 Importance Category:	☐ Low ☐ Low human occupancy ☐ Post-disaster shelter ☐ High ☐ Minor storage building ☐ Explosive or hazardous substances 4.1.2.1(3) & 14.1.2.18
3.17 Seismic Hazard Index:	(A) Fa Sa (0.2) Seismic design required for Table 4.1.8.18 Items 6 to 21: ☐ No ☒ Yes 4.1.2.1(3) & 14.1.8.18(2)
3.18 Occupant Load:	Floor Level Area Type Based On Occupant Load GROUND FLOOR GROUP F-2 DESIGN 210 SECOND FLOOR GROUP F-2 DESIGN 40 3.1.17
3.19 Barrier-free Design:	☒ Yes ☐ EXISTING 3.8.3
3.20 Hazardous substances:	☐ Yes ☒ No 3.3.1.2 & 3.3.1.19
3.21 Required Fire Resistance Ratings	Horizontal Assembly Rating Supporting Assembly (H) Noncombustible in lieu of rating? Floors over basement 1.5HR 1.5HR ☐ No ☒ Yes ☐ N/A Floors EXISTING ☐ No ☒ Yes ☐ N/A Platform ☐ No ☒ Yes ☐ N/A Roof ☐ No ☒ Yes ☐ N/A 3.2.2.20 - 83 & 3.2.1.4
3.22 Spatial Separation	Wall EBF L.D. L.H. Required Permitted Actual Construction Cladding Area (m²) or FRR Openings Type Type (m²) (m²) (m²) (m²) N 215.3 N/A 100% 100% ☐ Noncombustible ☒ Noncombustible S 24.1 N/A 100% 100% ☐ Noncombustible ☒ Noncombustible E 11.2 N/A 100% 100% ☐ Noncombustible ☒ Noncombustible W 112.8 N/A 100% 100% ☐ Noncombustible ☒ Noncombustible 3.2.3
3.23 Plumbing Fixture Requirements	Ratio: Male/Female = 50/50 Except as noted otherwise Floor Level/Area Occupant OBC Fixtures Fixtures Load Reference Required Provided GROUND FLOOR 210 3.7.4.9 10 20 SECOND FLOOR 40 3.7.4.9 3 12 3.7.4
3.24 Energy Efficiency:	Compliance Path: (A) ACHIEVE THE ENERGY EFFICIENCY LEVELS ATTAINED BY CONFORMING TO THE CANADIAN STANDARD STANDARD FOR BUILDINGS EXCEPT LOW-RISE RESIDENTIAL BUILDINGS" AS MODIFIED BY CHAPTER 1.1 OF THIS DIVISION. Climate Zone: ZONE 6
3.25 Notes:	


NOTES

These drawings are the property of, and shall not be used or reproduced without the consent of WBA Architects and Engineers Inc. The Contractor shall check and verify all dimensions and report all discrepancies to the Architect and/or Engineer.

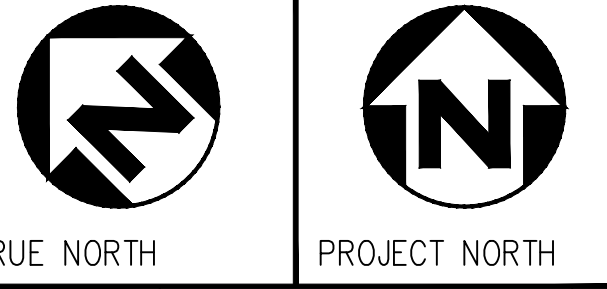

No.	Date	Issued	By
J	2022-05-02	ISSUED FOR SPA SALT/SNOW MANAGEMENT	WE
B	2021-11-25	ISSUED FOR REVIEW	WE
C	2021-11-28	ISSUED FOR REVIEW	WE
D	2022-02-18	ISSUED FOR BUDGET ESTIMATE	WE
E	2022-03-23	ISSUED FOR 75% DESIGN REVIEW	WE
F	2022-04-06	ISSUED FOR 90% DESIGN REVIEW	WE
G	2022-04-19	ISSUED FOR SITE PLAN APPROVAL	WE
H	2022-04-25	ISSUED FOR TENDER	WE

LEGEND	
PROPERTY LINE	---
SITE BENCHMARK	⊙
CATCHBASIN	⊕
MANHOLE	⊙
HYDRANT SET	⊕
SIAMENSE CONNECTION	⊕
OBSERVATION WELL	⊕
STORM SEWER	---
SANITARY SEWER	---
WATERMAIN	---
SLOPE	---
BOLLARD	⊕
POST	⊕
BELL PEDESTAL	⊕
HYDRO POLE	⊕
GUY WIRE	---
SIGN	---
TREES	⊕
SHRUB	⊕
ELEVATION	---
CONTOUR	---
CONCRETE PAD	---
EXISTING BEACHSTONE	---
EX MAN DOOR	---
EX OVERHEAD DOOR	---
EXISTING 1.0m WIDE X 150mm HIGH SPEED BUMP	---
NEW SANITARY LINE	---
NEW MAN DOOR	---
NEW OVERHEAD DOOR	---
NEW BOLLARD	---
NEW HEAVY DUTY ASPHALT	---
NEW PEST CONTROL GRAVEL STRIP	---
NEW CONCRETE PAD	---

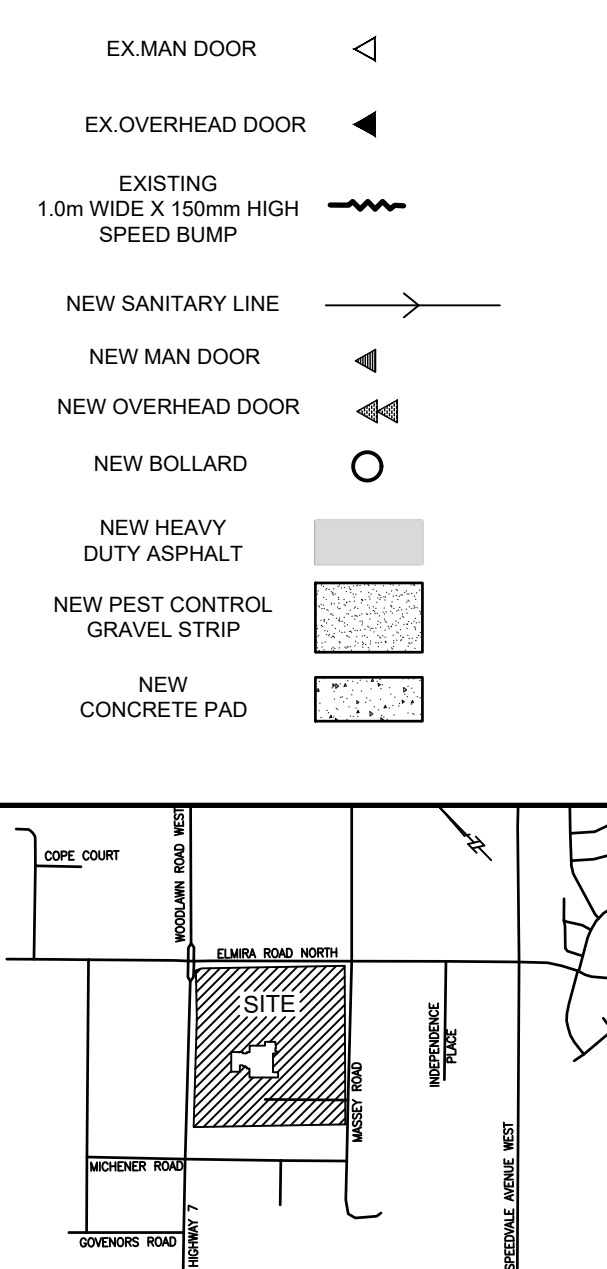

No.	Date	Revision	Professional Seal
3	2024-04-11	ISSUED FOR AS-BUILT	WE
2	2023-12-12	ISSUED FOR S1 #21	WE
1	2022-11-24	ISSUED FOR SPA REVISION	WE
0	2022-07-13	ISSUED FOR CONSTRUCTION	WE




wba architects and engineers inc

Johnson & Johnson
890 WOODLAWN ROAD WEST
GUELPH, ON

Project Title: PROJECT NASH

Drawing Title: NEW SITE PLAN

CADD System:	Plot Scale:	Sheet Size:
AUTOCAD 2016	1:1	30" x 42"
Drawn By:	Date:	Drawing Date:
A.P.	OCT/2021	AS NOTED
Checked By:	Date:	Rev:
G.S.S.	OCT/2021	3
Project No:	Draw No:	
2210711	A001	

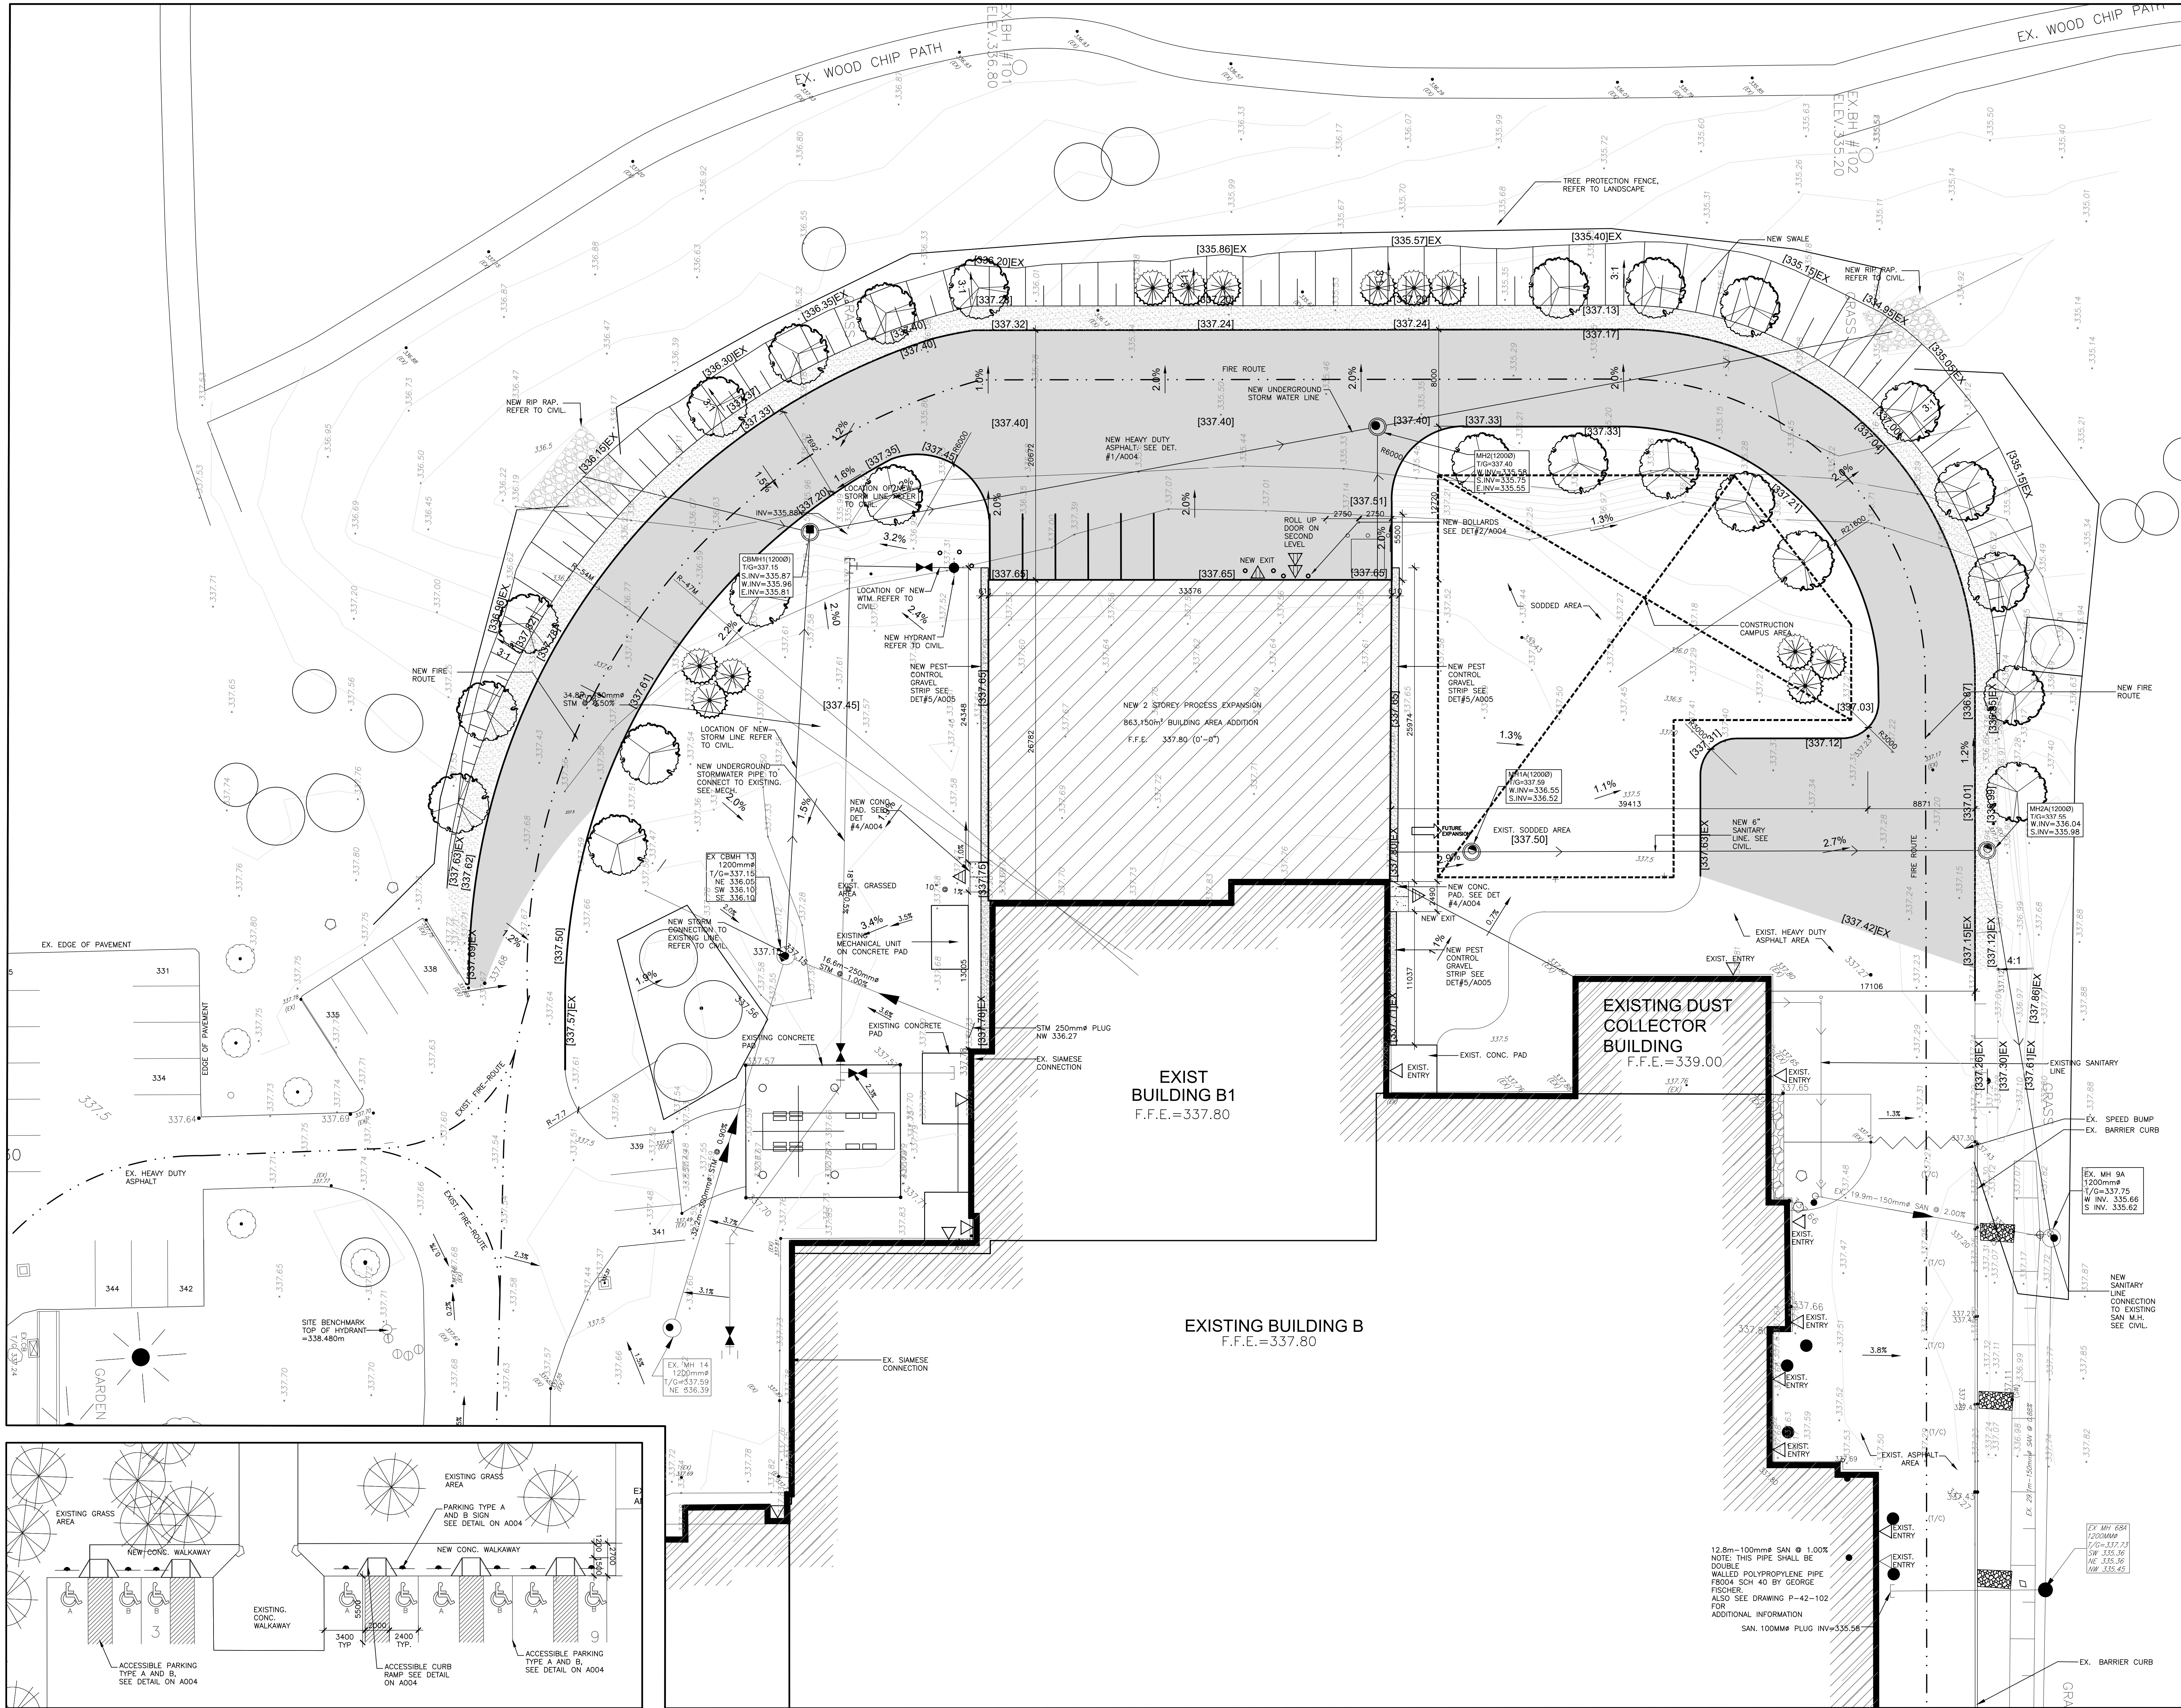

NOTES

These drawings are the property of, and shall not be used or reproduced without the consent of WBA Architects and Engineers Inc. The Contractor shall check and verify all dimensions and report all discrepancies to the Architect and/or Engineer.

TRUE NORTH

PROJECT NORTH

No.	Date	Issued	By
A	2022-02-18	ISSUED FOR BUDGET ESTIMATE	WBA
B	2022-03-23	ISSUED FOR 75% DESIGN REVIEW	WBA
C	2022-04-19	ISSUED FOR SITE PLAN APPROVAL	WBA
D	2022-04-29	ISSUED FOR TENDER	WBA

LEGEND

PROPERTY LINE

SITE BENCHMARK

CATCHBASIN

MANHOLE

HYDRANT SET

SIAMENSE CONNECTION

OBSERVATION WELL

STORM SEWER

SANITARY SEWER

WATERMAIN

SLOPE

BOLLARD

POST

BELL PEDESTAL

HYDRO POLE

GUY WIRE

SIGN

TREES

SHRUB

ELEVATION

CONTOUR

EXISTING NEW CONCRETE PAD

EXISTING BEACHSTONE

EX MAN DOOR

EX OVERHEAD DOOR

NEW/EXISTING 1.0m WIDE X 150mm HIGH SPEED BUMP

NEW SANITARY LINE

NEW STORM WATER LINE

NEW WATERMAIN LINE

NEW MAN DOOR

NEW OVERHEAD DOOR

NEW BOLLARD

NEW HEAVY DUTY ASPHALT

NEW PEST CONTROL GRAVEL STRIP

KEY PLAN

No.	Date	Revision	By
1	2024-04-11	ISSUED FOR AS-BUILT	WBA
0	2022-07-13	ISSUED FOR CONSTRUCTION	WBA

Professional Seal

Consultant

3, 530 Rowntree Dairy Road
Vaughan, Ontario L4L 8H2
Tel: 905.851.0418
Fax: 905.851.7148
Email: info@wba.com

Client

890 WOODLAWN ROAD WEST
GUELPH, ON

Project Title

PROJECT NASH

Drawing Title

PARTIAL NEW SITE PLAN - PROCESS

CADD System

Autocad 2016

Drawn By

R.R.

Checked By

G.S.S.

Project No.

2210711

Plot Scale

1:1

Sheet Size

30" x 42"

Drawing Date

OCT/2021

AS NOTED

Date

OCT/2021

Rev

1

Dwg No.

A003a

2 ACCESSIBLE PARKING

1 PARTIAL NEW SITE PLAN - PROCESS




PROJECT NORTH

Date	Issued	By:
2022-03-23	ISSUED FOR 75% DESIGN REVIEW	WBA
2022-04-06	ISSUED FOR 90% DESIGN REVIEW	WBA
2022-04-25	ISSUED FOR TENDER	WBA
		WBA



2024-04-11	ISSUED FOR AS-BUILT	WBA
2022-07-13	ISSUED FOR CONSTRUCTION	WBA
Date	Revision	By.

Professional Seal

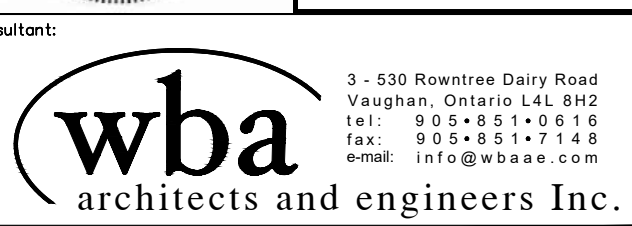


Johnson & Johnson
890 WOODLAWN ROAD WEST
GUELPH, ON

Project Title: PROJECT NASH

SITE PLAN DETAILS


ID System : TOCAD 2016 m By: G.M. Checked By: S.S Project No: 210711	Plot Scale: 1:1 Date: OCT/2021 Date: OCT/2021	Sheet Size: 30" x 42" Drawing Scale: AS NOTED Rev.: 1
Draw No: A004		

Plot Date: Plotted By: CADD File Name:

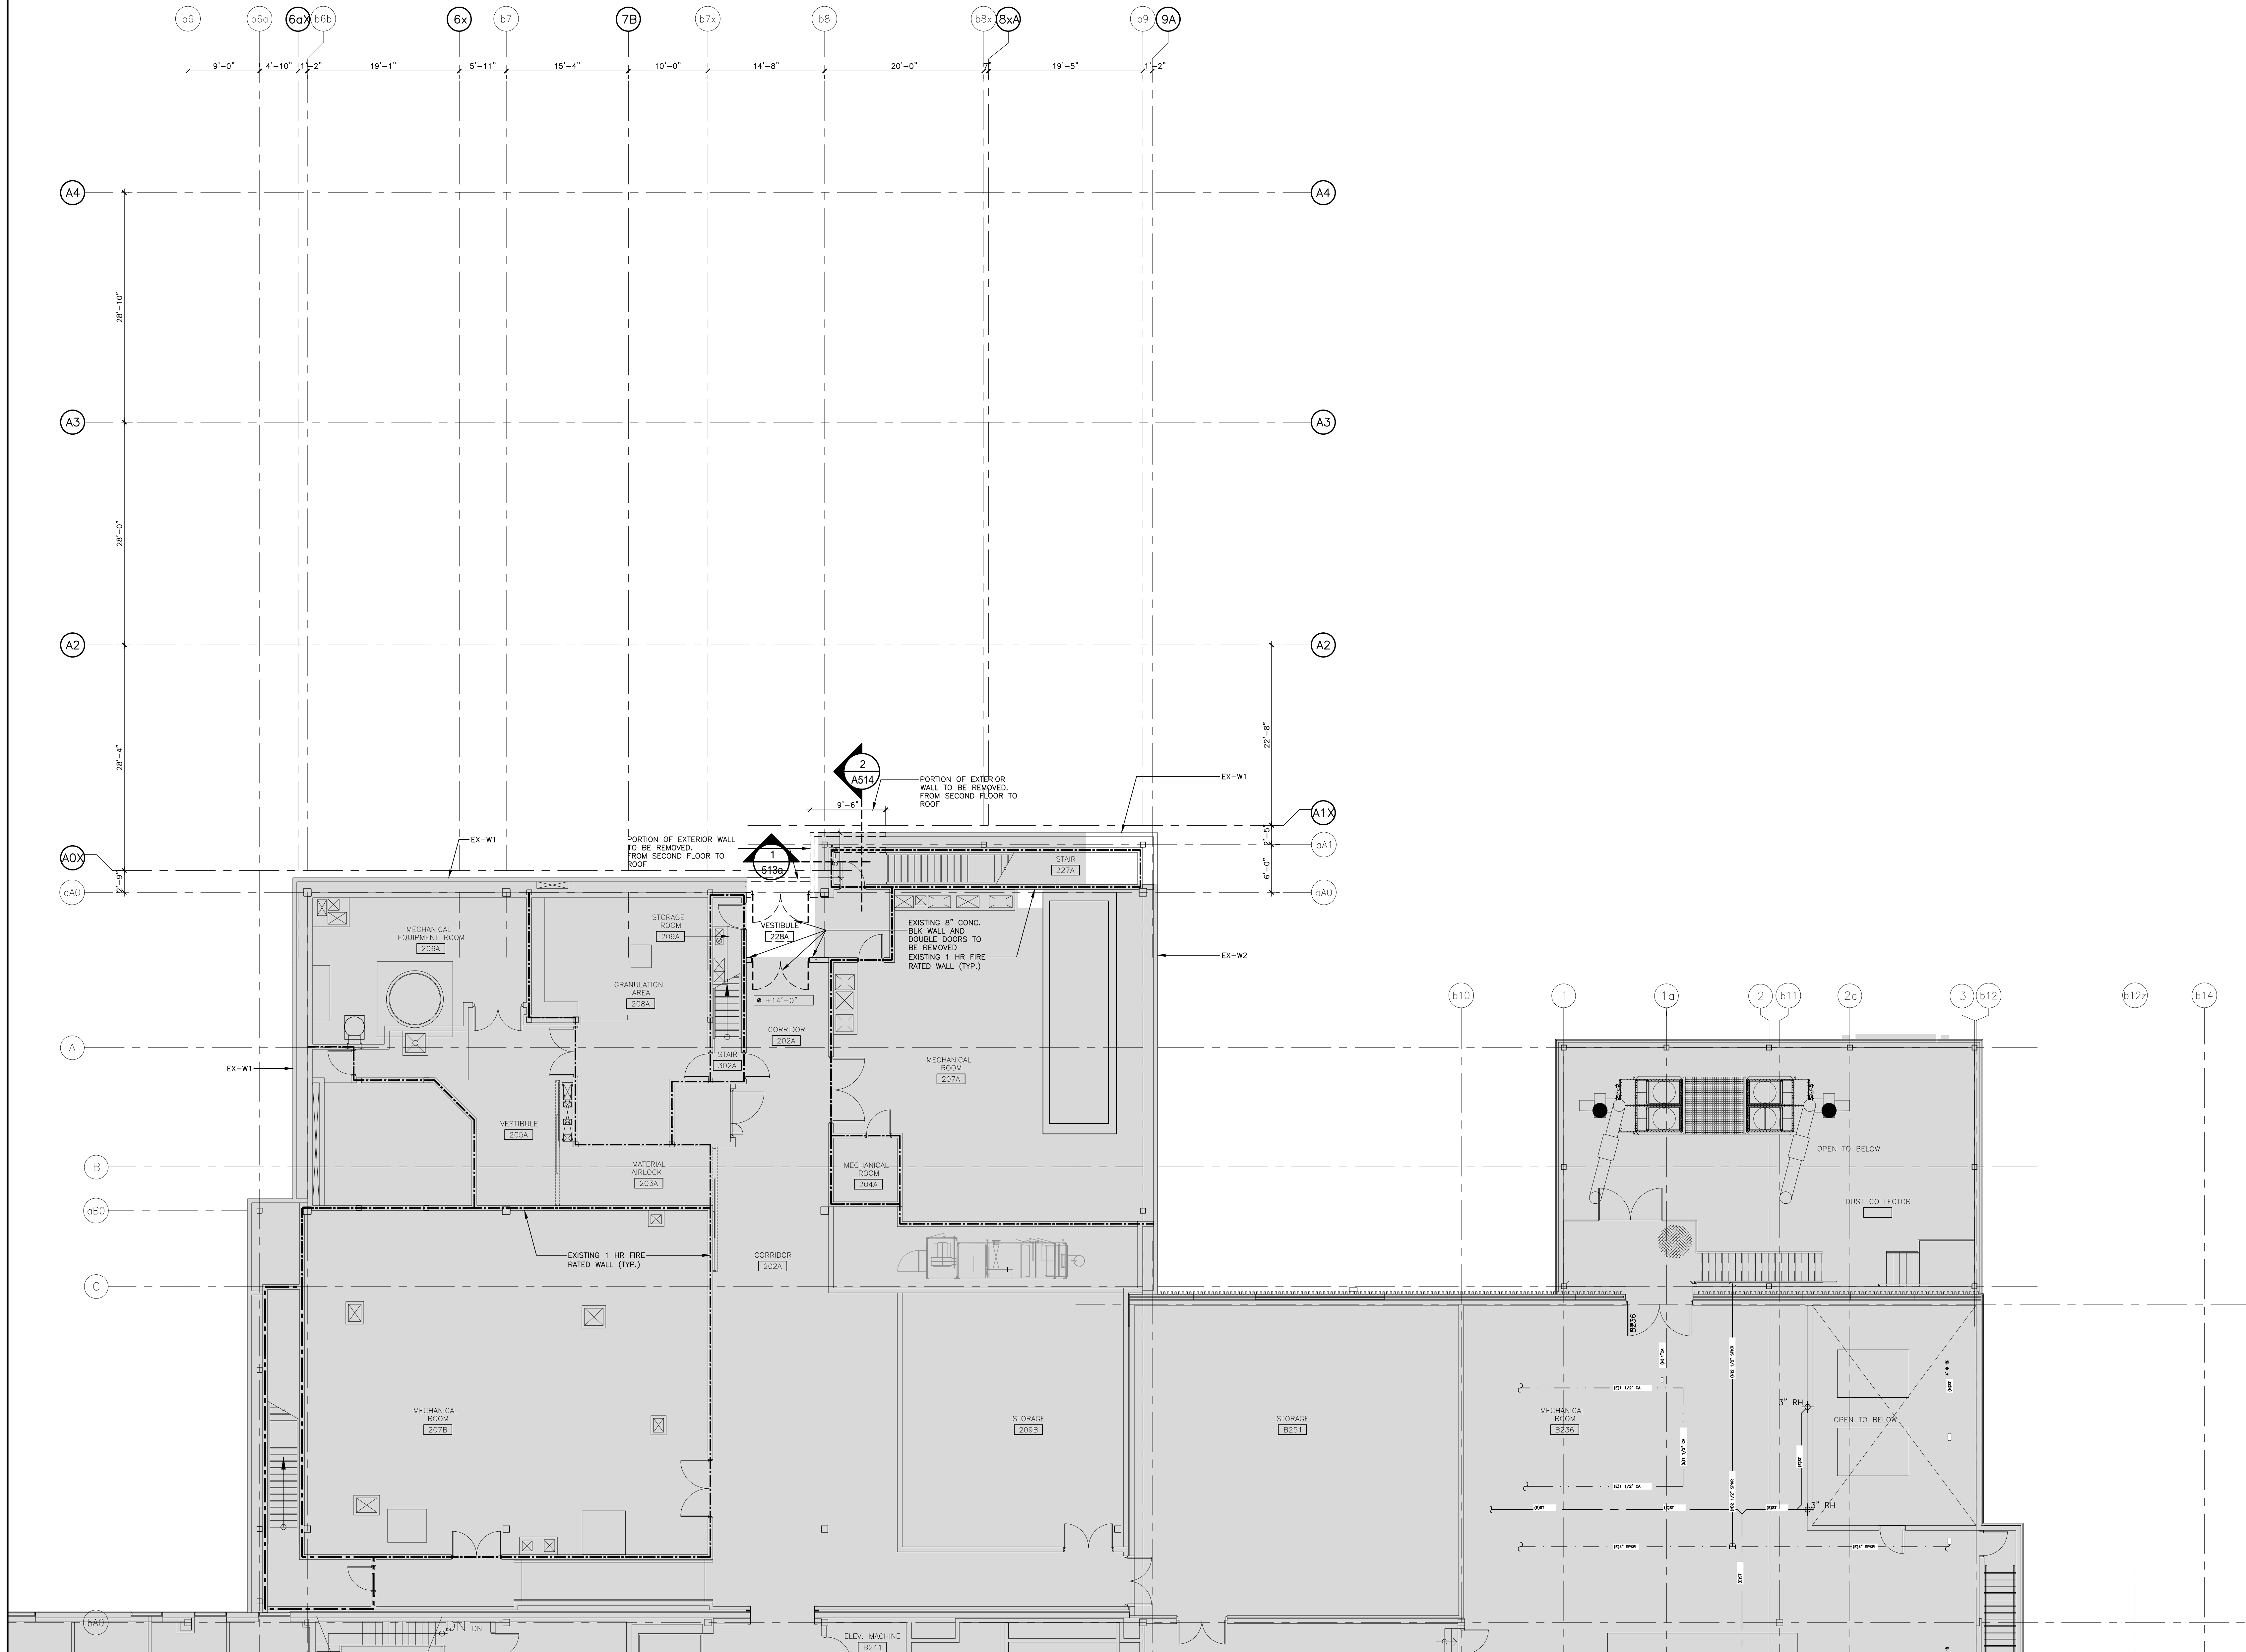

NOTES

These drawings are the property of, and shall not be used or reproduced without the consent of WBA Architects and Engineers Inc. The Contractor shall check and verify all dimensions and report all discrepancies to the Architect and/or Engineer.

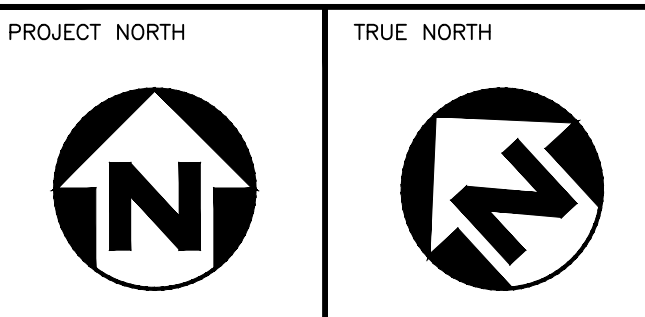

No.	Date	Issued	By:
A	2022-02-18	ISSUED FOR BUDGET ESTIMATE	WBA
B	2022-03-23	ISSUED FOR 75% DESIGN REVIEW	WBA
C	2022-04-08	ISSUED FOR 90% DESIGN REVIEW	WBA
D	2022-04-29	ISSUED FOR TENDER	WBA


- FLOOR PLAN LEGEND:**
- EXISTING AREA TO REMAIN
 - INTERIOR ALTERATION / NEW ADDITION
 - EXISTING DOOR AND FRAME TO REMAIN
 - EXISTING DOOR AND FRAME TO BE REMOVED

- EXIST. EXTERIOR WALL LEGEND**
- EX-W1** EXIST. EXTERIOR WALL SYSTEM
6" METAL CLAD INSULATED SANDWICH PANEL ON GALVANIZED SUB-GIRTS WITH AIR SPACE OF 1"-2" ON 8" CONCRETE BLOCK WALL
- EX-W2** EXIST. EXTERIOR WALL SYSTEM
6" METAL CLAD INSULATED SANDWICH PANEL ON GALVANIZED SUB-GIRTS
- EX-W3** EXIST. EXTERIOR WALL SYSTEM
6" METAL CLAD INSULATED SANDWICH PANEL ON STEEL FRAMING WITH CONCRETE BLOCK BACK UP
- EX-P1** EXIST. 8" LIGHTWEIGHT CONC. BLK.
- EX-P2** EXIST. 12" CONCRETE BLOCK FIREWALL (FOUR (4) HOUR FIREWALL) 50 COURSES HIGH (MIN. 4'-0") ABOVE TOP OF STEEL DECK
- TEMP. CONST. HOARDING FOR DEMOLITION AND NEW WALL / CLNG. CONSTRUCTION;
1/2" PRE-FINISHED VINYL OYSPUM BOARD ON ONE SIDE OF 3/8" METAL STUDS @ 24" O.C. (PRODUCTION SIDE) FROM FIN. FLOOR TO 1/2" OF EXISTING CEILING (DOUBLE SIDED TAPE TRACK TO FLOOR.) PROVIDE VINYL BASE ON OCCUPIED SIDE

- FIRE RATING LEGEND:**
- 1 HR FIRE RATED WALL
 - 2 HR FIRE RATED WALL
 - 4 HR FIREWALL

No.	Date	Revision	By:
1	2024-04-11	ISSUED FOR AS-BUILT	WBA
0	2022-07-13	ISSUED FOR CONSTRUCTION	WBA

Professional Seal

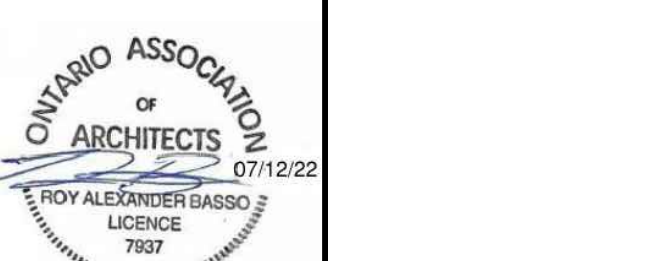

Consultant:
wba
architects and engineers Inc.
3 - 530 Rosetree Dairy Road
Westphal, Ontario L4L 8H0
Tel: 905-851-0616
Fax: 905-851-1148
email: info@wbawae.com


Client:
Johnson & Johnson
890 WOODLAWN ROAD WEST
GUELPH, ON

Project Title: PROJECT NASH

Drawing Title:
DEMOLITION SECOND FLOOR PLAN - PROCESS

CADD System : AUTOCAD 2016	Plot Scale: 1:1	Sheet Size: 30" x 42"
Drawn By: R.R.	Date: JAN 2022	Drawing Scale: AS NOTED
Checked By: G.S.S	Date: JAN 2022	Rev: 1
Project No.: 2210711	Draw No.: A202a	

1 DEMOLITION SECOND FLOOR PLAN - PROCESS
1/8"=1'-0"

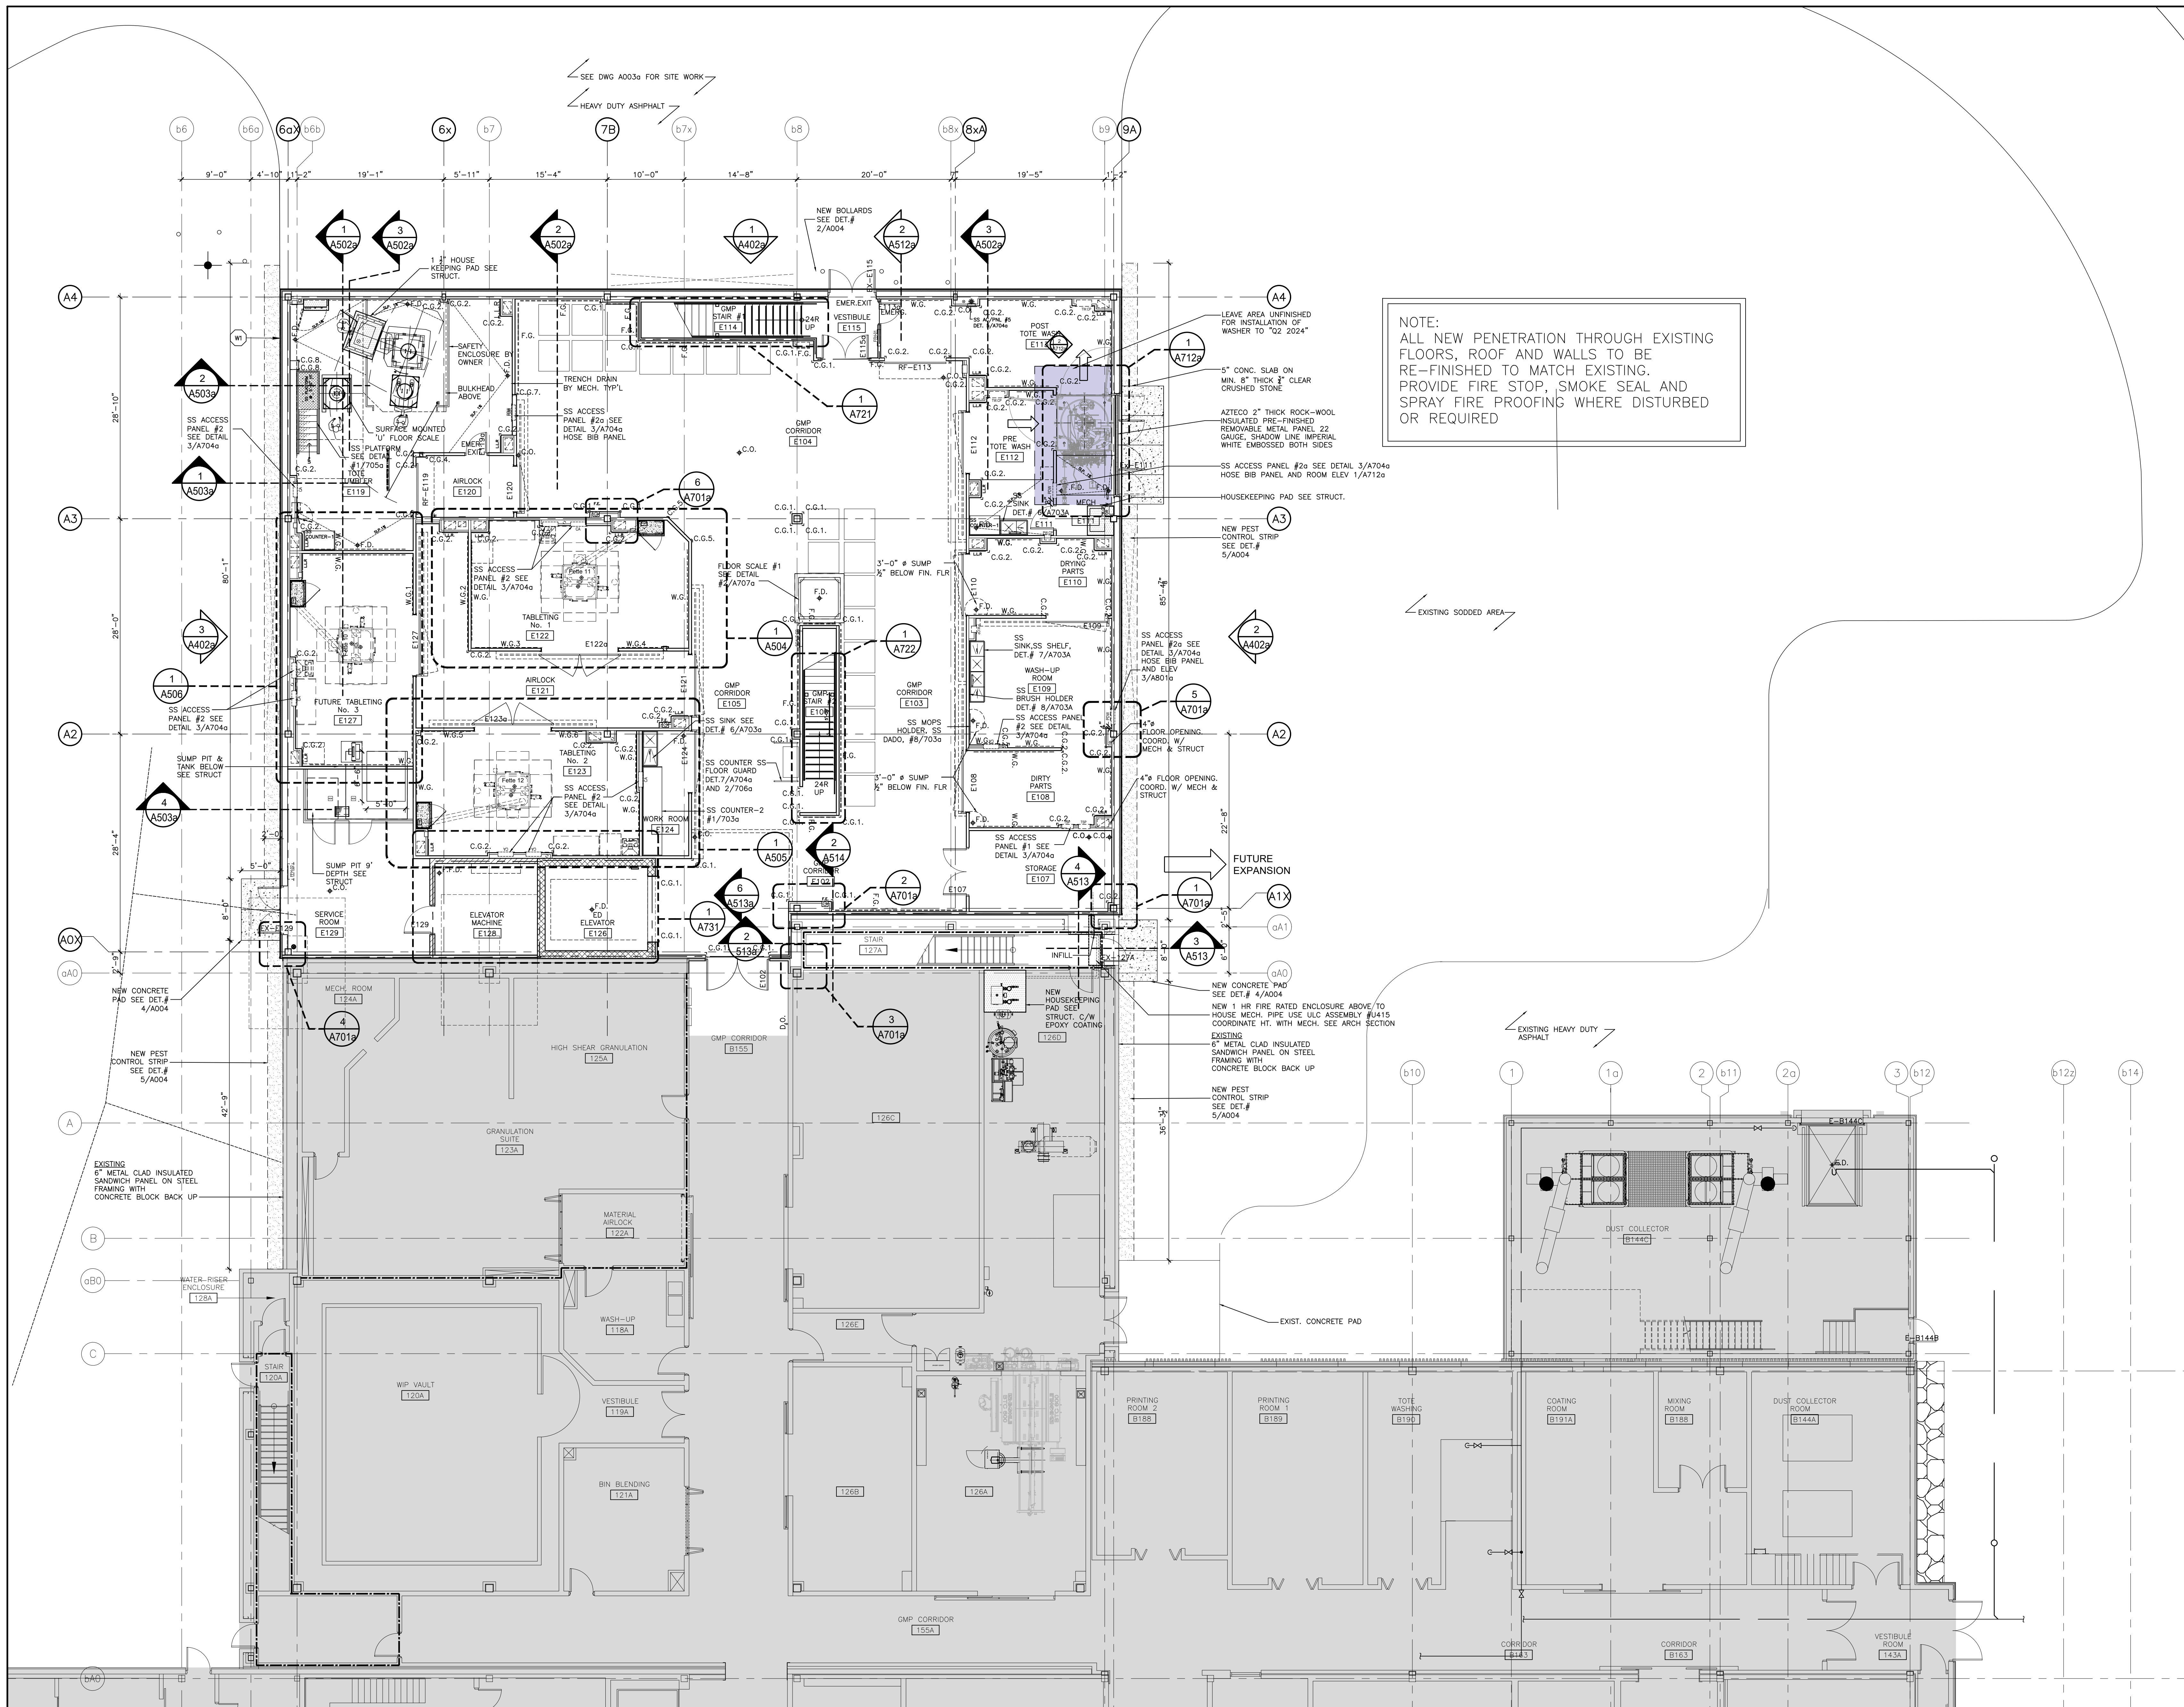

NOTE:
ALL NEW PENETRATION THROUGH EXISTING FLOORS, ROOF AND WALLS TO BE RE-FINISHED TO MATCH EXISTING. PROVIDE FIRE STOP, SMOKE SEAL AND SPRAY FIRE PROOFING WHERE DISTURBED OR REQUIRED

NOTES

These drawings are the property of, and shall not be used or reproduced without the consent of WBA Architects and Engineers Inc. The Contractor shall check and verify all dimensions and report all discrepancies to the Architect and/or Engineer.

PROJECT NORTH

TRUE NORTH

No.	Date	Issued	By:
I	2023-06-20	ISSUED FOR REVISION TO PERMIT	WBA
B	2022-03-14	ISSUED FOR REVIEW	WBA
C	2022-03-23	ISSUED FOR 75% DESIGN REVIEW	WBA
D	2022-04-08	ISSUED FOR 90% DESIGN REVIEW	WBA
E	2022-04-25	ISSUED FOR TENDER	WBA
F	2022-04-12	ISSUED FOR ADDENDUM #001	WBA
G	2022-06-21	ISSUED FOR POST TENDER ADDENDUM #1	WBA
H	2023-02-27	ISSUED FOR COORDINATION	WBA

WALL LEGEND

1

PRE-FINISHED 4" INSULATED METAL PANELS ON STEEL SUB-ORTS

2

1-HR. FIRE-RATED WALL 12" REINFORCED CONCRETE BLOCK UP TO U/S OF STRUCTURE. FIRE STOP AND SMOKE SEAL AT TOP.

3

1-HR. FIRE-RATED WALL 8" REINFORCED CONCRETE BLOCK WALL SEE STRUCTURAL. FIRE STOP AND SMOKE SEAL AT TOP.

4

1-HR. FIRE-RATED WALL 8" REINFORCED CONCRETE BLOCK WALL UP TO U/S OF STRUCTURE. FIRE STOP AND SMOKE SEAL AT TOP. SEE STRUCTURAL.

5

1/2" GLASS-MAT PANEL ON ONE SIDE OF 3/8" METAL STUD @ 16" O.C. UP TO MIN. 4" ABOVE FINISHED CEILING

6

1/2" GLASS-MAT PANEL ON BOTH SIDE OF 3/8" METAL STUD @ 16" O.C. UP TO MIN. 4" ABOVE FINISHED CEILING

7

1-HR. FIRE-RATED WALL ULC #552 12" REINFORCED CONCRETE BLOCK UP TO U/S OF STRUCTURE. FIRE STOP AND SMOKE SEAL AT TOP.

8

1-HR. FIRE-RATED WALL ULC #552 12" REINFORCED CONCRETE BLOCK UP TO U/S OF STRUCTURE. FIRE STOP AND SMOKE SEAL AT TOP.

FLOOR PLAN LEGEND:

1

EXISTING AREA TO REMAIN

2

INTERIOR ALTERATION / NEW ADDITION

3

NEW DOOR AND FRAME

4

FIRE EXTINGUISHER IN RECESSED STAINLESS STEEL CABINET BY OTHER.

5

STAINLESS STEEL CORNER GUARD F.C.G. FULL HEIGHT STAINLESS STEEL CORNER GUARD SEE DET. #1/A704g

6

STAINLESS STEEL WALL BUMPER GUARD. SEE DET. #1/A704g

7

STAINLESS STEEL FLOOR GUARD. SEE DET. #1/A704g

FIRE RATING LEGEND

1

DENOTES AND DELINEATES ZERO-HOUR (0) FIRE SEPARATION.

2

DENOTES AND DELINEATES ONE-HOUR (1) FIRE SEPARATION.

3

DENOTES AND DELINEATES TWO-HOUR (2) FIRE SEPARATION.

4

DENOTES AND DELINEATES THREE-HOUR (3) FIRE SEPARATION.

5

DENOTES AND DELINEATES FOUR-HOUR (4) FIRE SEPARATION.

CORNER GUARDS

1

C.G.1 - 5'-0" HT.

2

C.G.2 - 5'-2" HT.

3

C.G.3 - 9'-8" HT.

5.1

2023-04-25

ISSUED FOR CON #21 R1

WBA

5

2023-04-17

ISSUED FOR CON #21

WBA

4

2023-04-13

ISSUED FOR SI #003

WBA

10

2024-04-11

ISSUED FOR AS-BUILT

WBA

9

2024-03-12

ISSUED FOR CON #46

WBA

8

2023-09-14

ISSUED FOR SI #018

WBA

7

2023-05-30

ISSUED FOR CON #21 R2

WBA

6

2023-05-08

ISSUED FOR CON #24

WBA

No.

Date

Revision

By:

Professional Seal

Professional Seal

ONTARIO ASSOCIATION OF ARCHITECTS

ROY ALEXANDER BASSO

7032

07/12/22

Consultant:

wba

architects and engineers inc.

3 - 530 Rosedale Dairy Road

Westphal, Ontario L4L 8H9

TEL: 905-851-0616

FAX: 905-851-1148

EMAIL: info@wbaae.com

Client:

Johnson & Johnson

890 WOODLAWN ROAD,

GUELPH, ON

Project Title:

PROJECT NASH

Drawing Title:

NEW GROUND FLOOR PLAN PROCESS

CADD System :

Autocad 2016

Plot Scale:

1:1

Sheet Size:

30" x 42"

Drawn By:

R.R.

Date:

JAN. 2022

Drawing Scale:

AS NOTED

Checked By:

G.S.S

Date:

JAN. 2022

Rev:

10

Project No.:

2210711

Draw No.:

A301a

Proj. Date:

Jul 31, 2026

Printed By:

Rev10

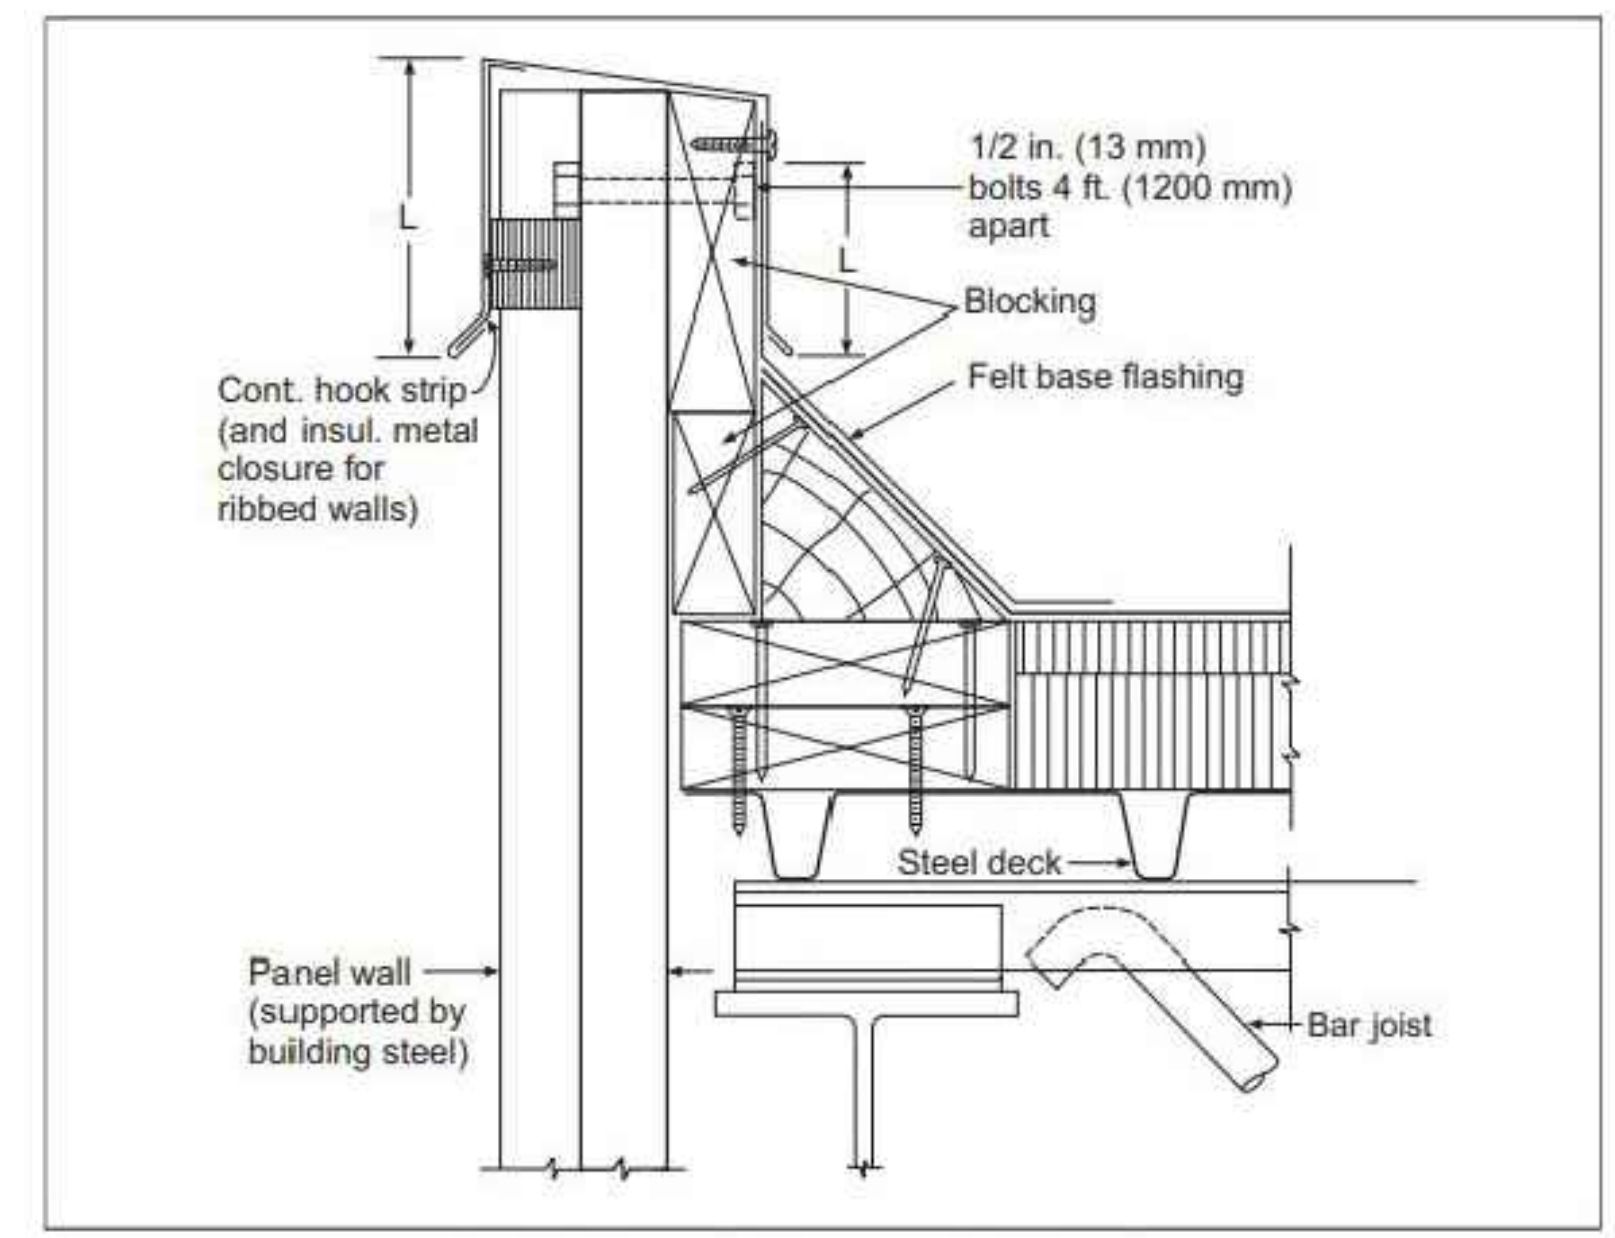
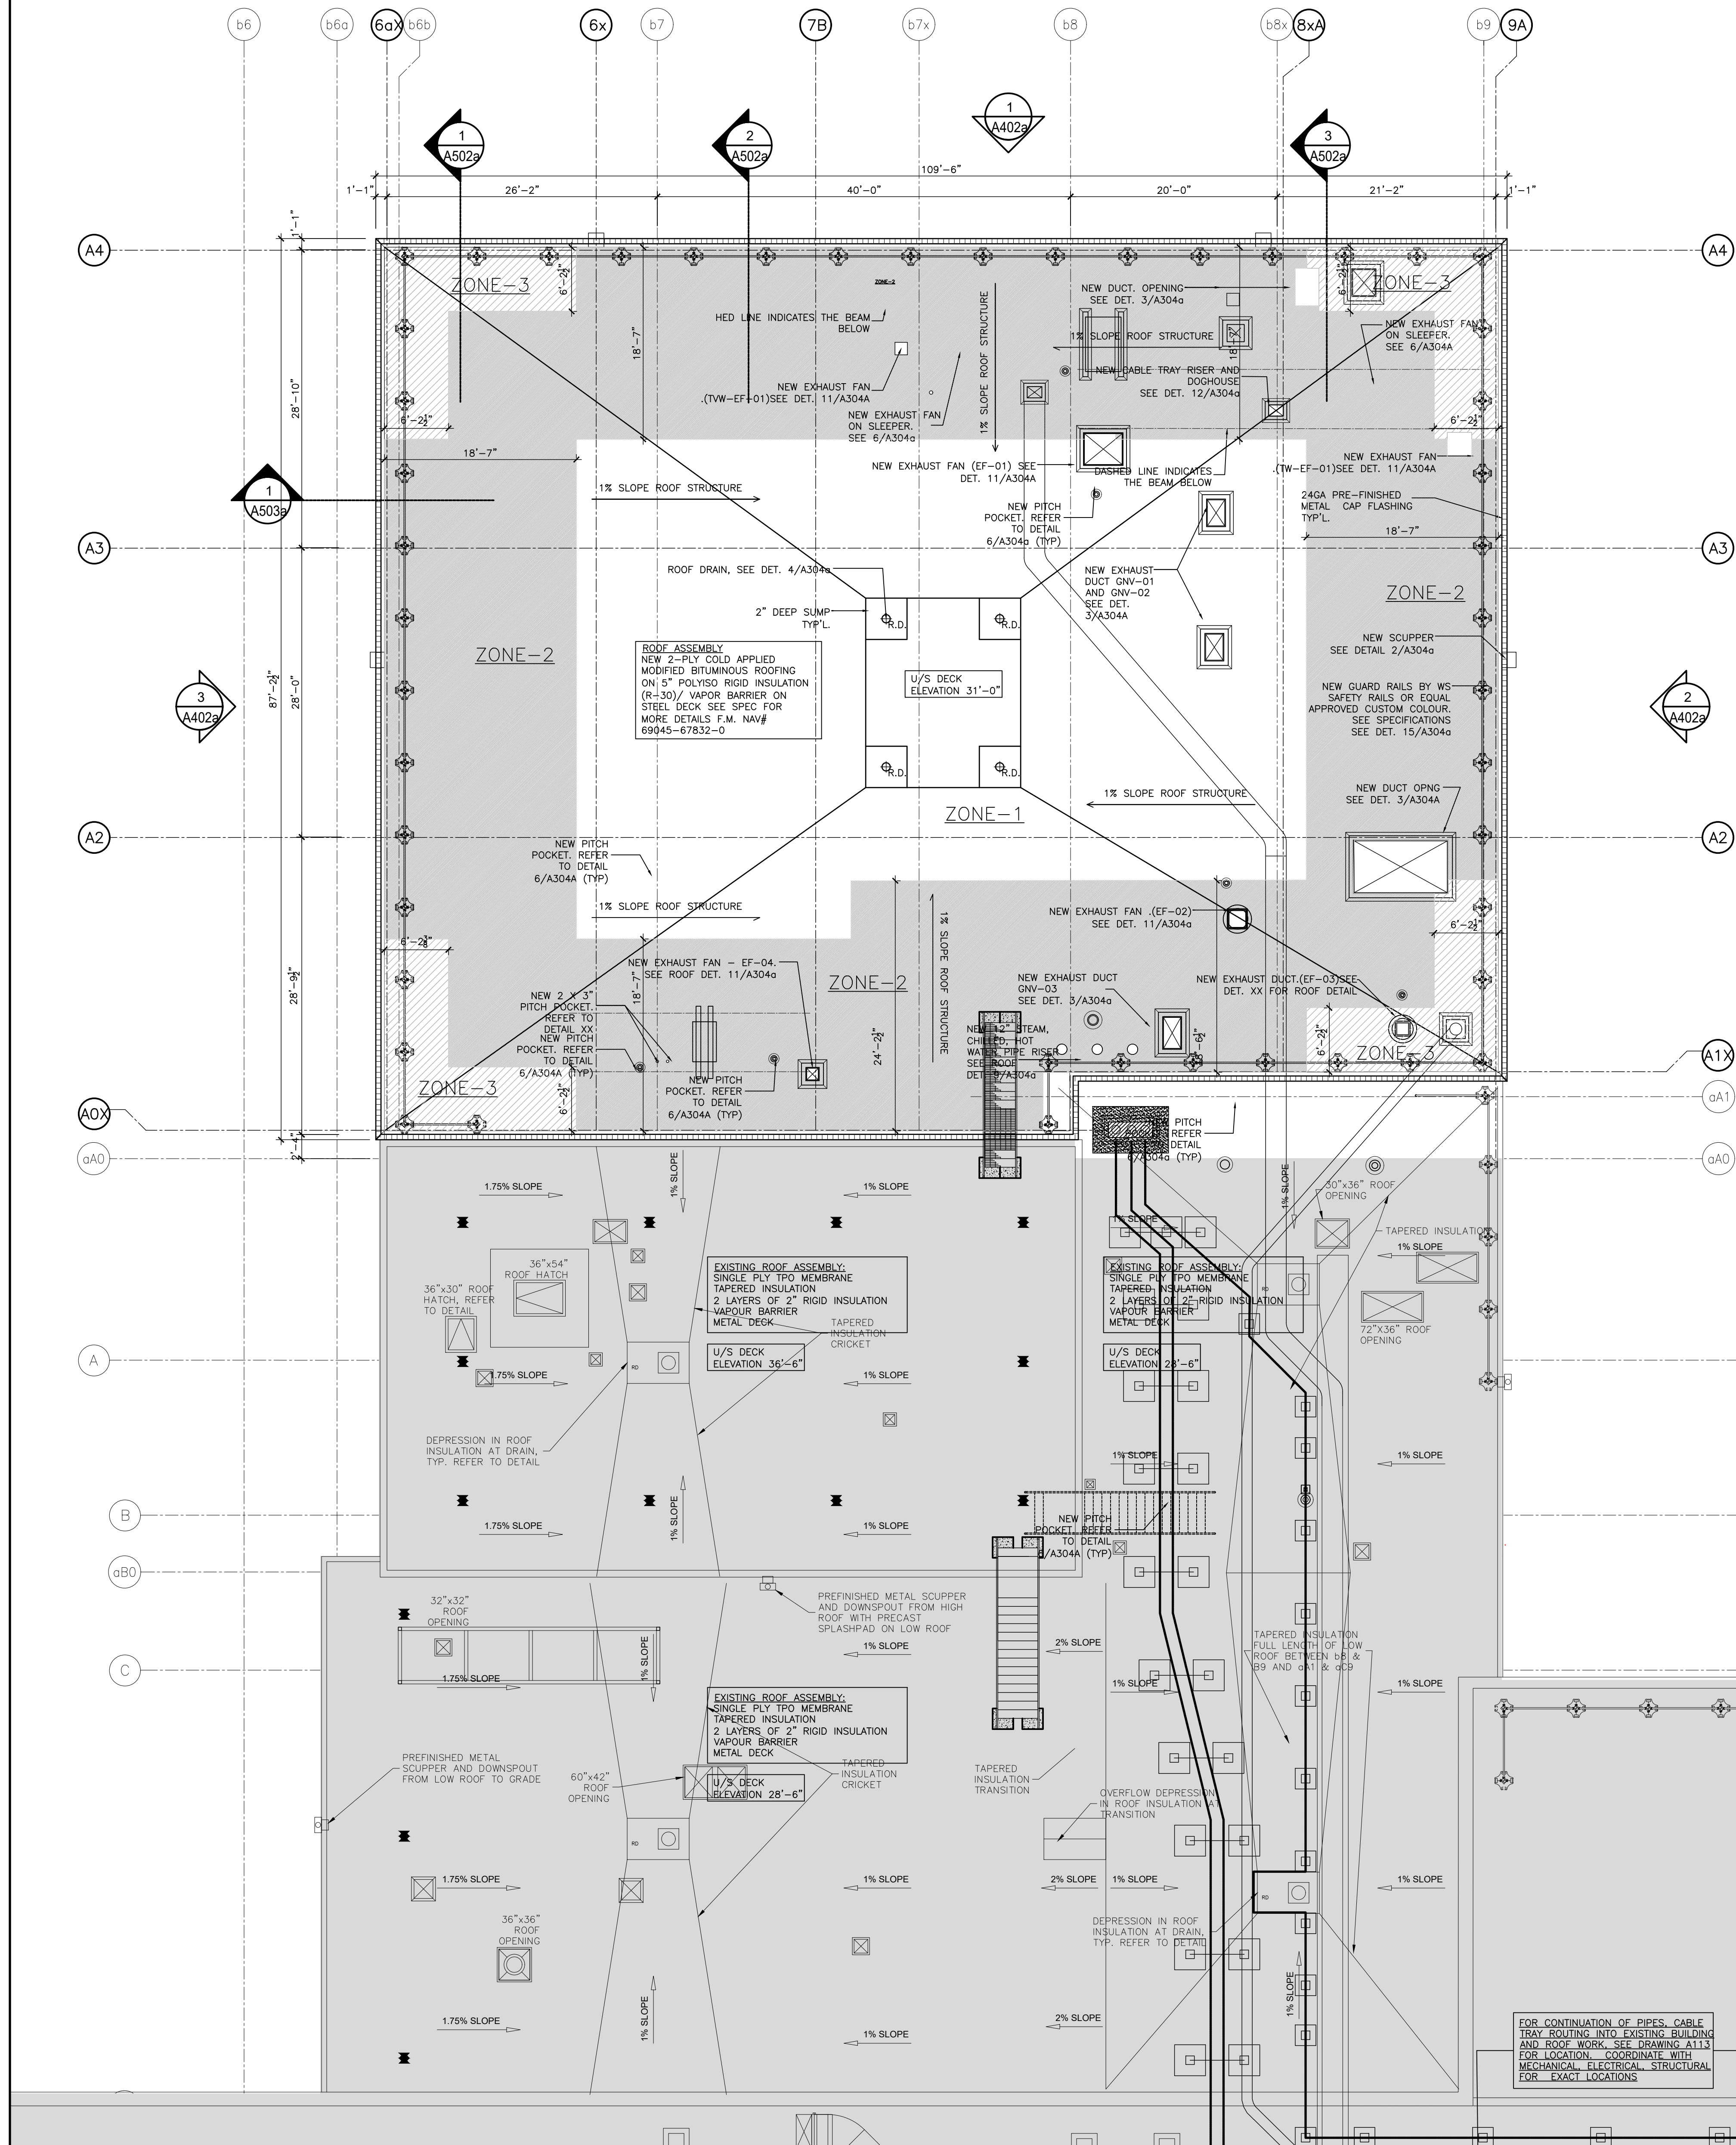


Fig. 3.1.4-1. Panel wall with parapet and multi-ply roof cover

2 FM GLOBAL FLASHING DETAIL
A305a NTS


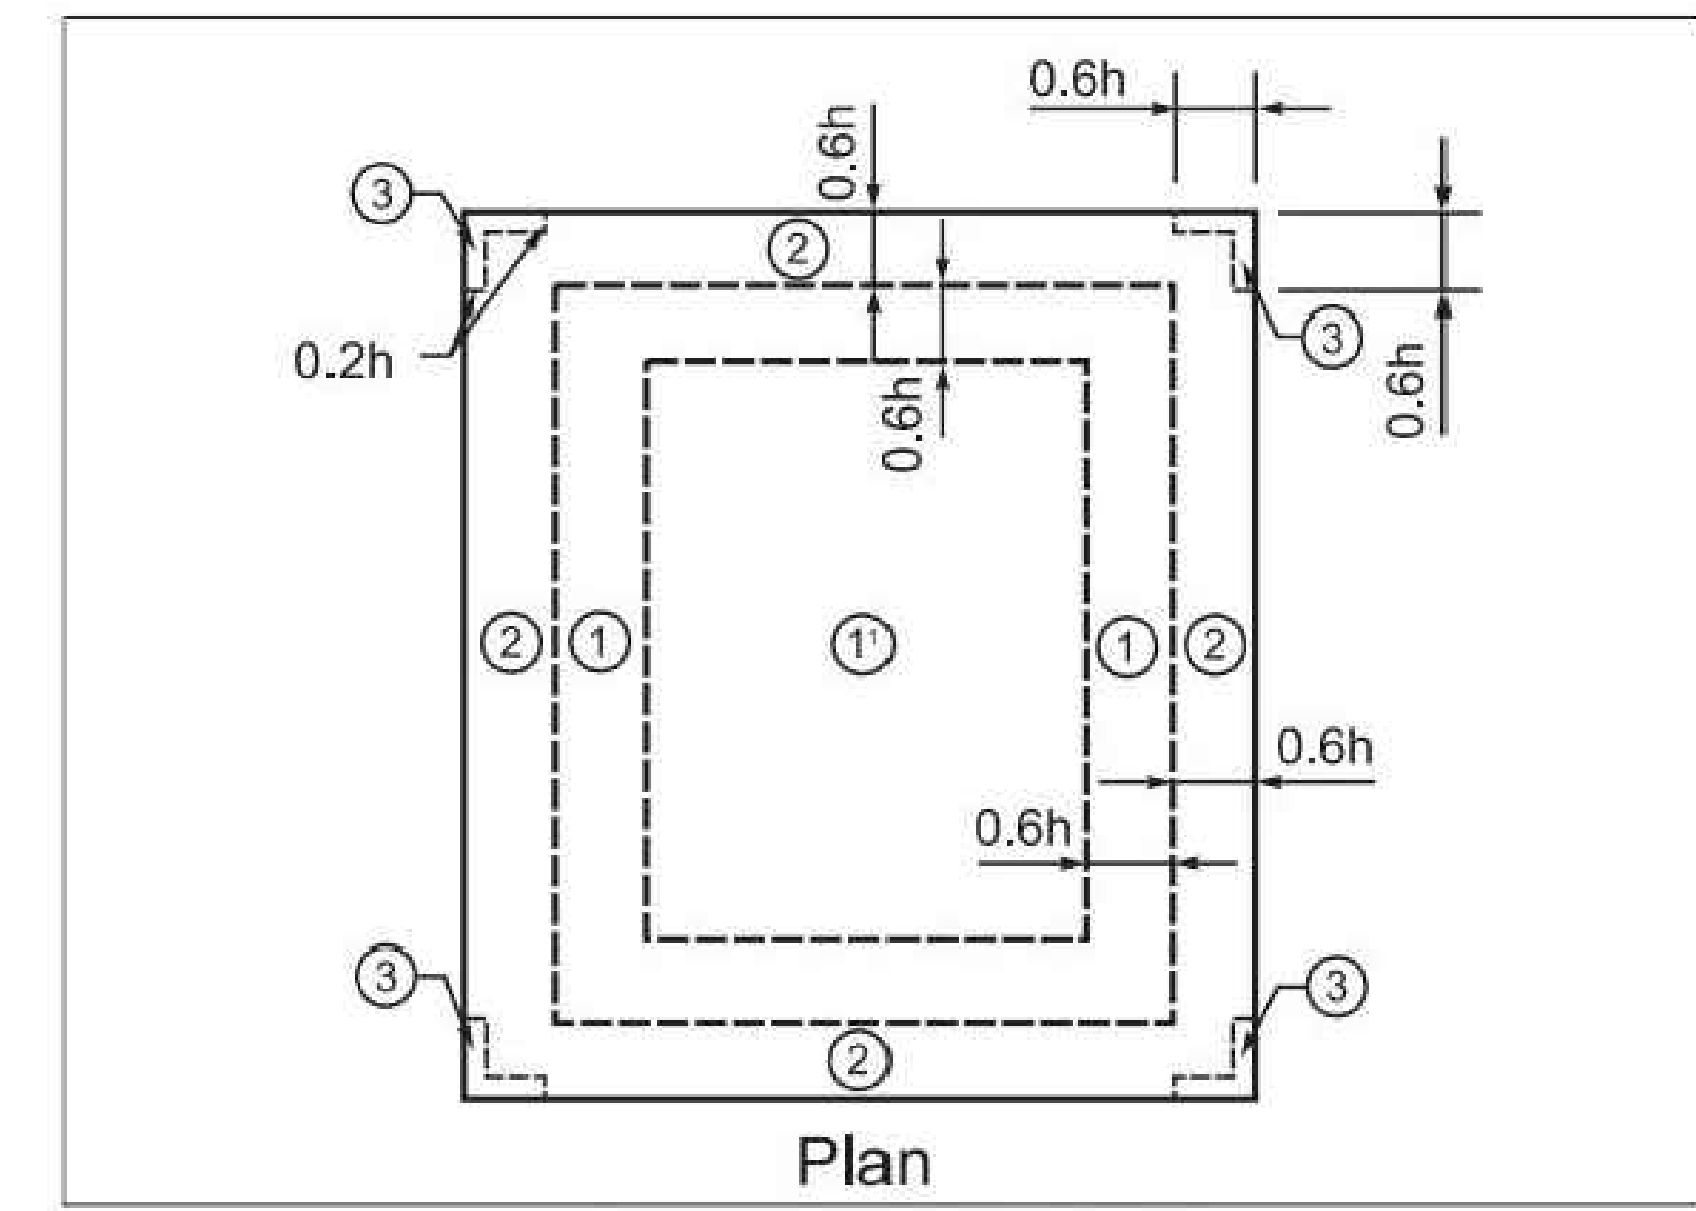


Fig. 3.2.2a Roof zones for roof slopes <= 7°


3 FM GLOBAL INSULATION ZONE PLAN
A305a NTS

NOTES

These drawings are the property of, and shall not be used or reproduced without the consent of WBA Architects and Engineers Inc. The Contractor shall check and verify all dimensions and report all discrepancies to the Architect and/or Engineer.

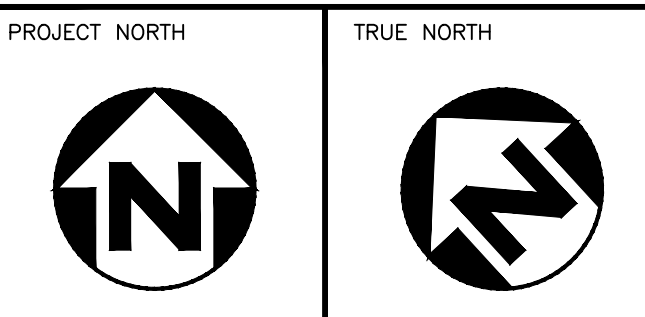

No.	Date	Issued	By:
A	2022-02-18	ISSUED FOR BUDGET ESTIMATE	WBA
B	2022-03-23	ISSUED FOR 75% DESIGN REVIEW	WBA
C	2022-04-08	ISSUED FOR 90% DESIGN REVIEW	WBA
D	2022-04-29	ISSUED FOR TENDER	WBA

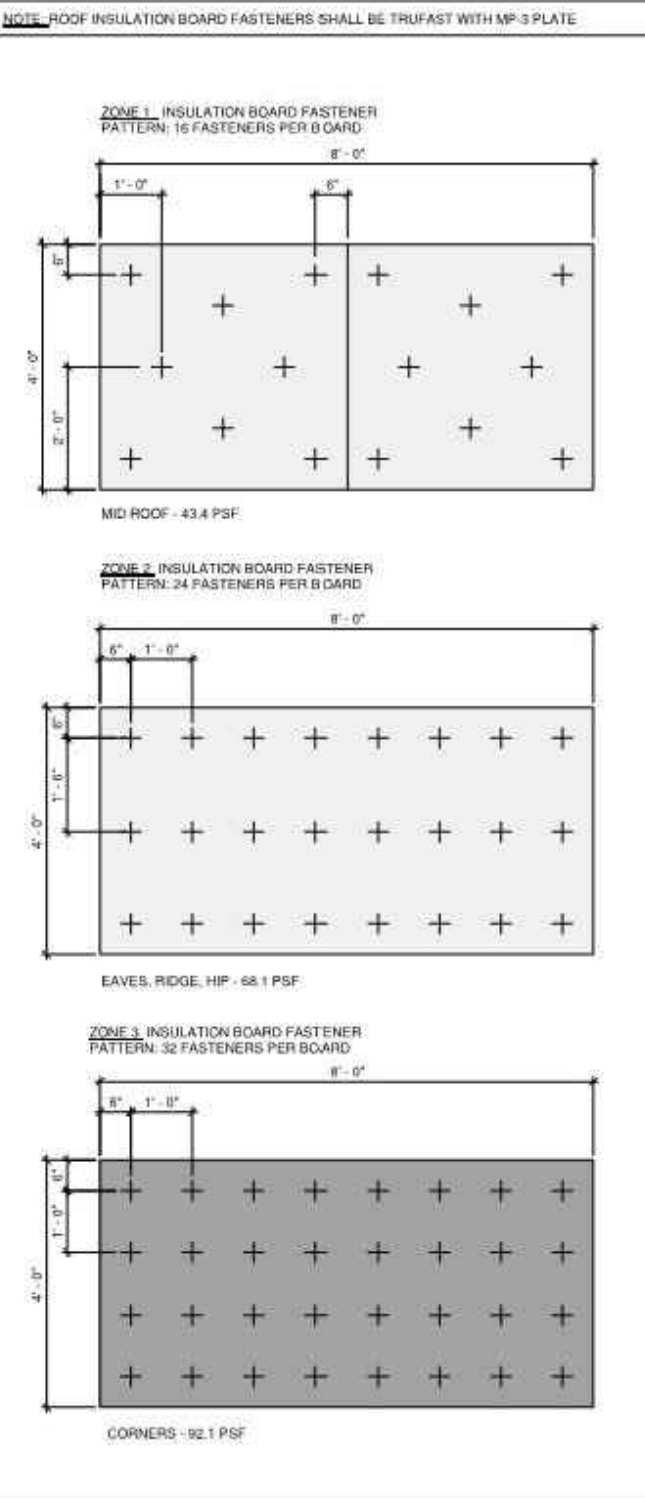

4 FM GLOBAL INSULATION FASTENING DET'L
A305a NTS

No.	Date	Revision	Professional Seal
1	2024-04-11	ISSUED FOR AS-BUILT	WBA
2	2022-07-13	ISSUED FOR CONSTRUCTION	WBA



Consultant:
wba
architects and engineers inc.
3 - 530 Rosedale Dairy Road
Vaughan, Ontario L4L 1B1
Tel: 905-851-0616
Fax: 905-851-0618
Email: info@wbaae.com


Client:
Johnson & Johnson
890 WOODLAWN ROAD WEST
GUELPH, ON

Project Title:
PROJECT NASH

Drawing Title:
NEW ROOF PLAN
FM GLOBAL

CADD System: AUTOCAD 2016	Plot Scale: 1:1	Sheet Size: 30" x 42"
Drawn By: R.R.	Date: JAN. 2022	Drawing Scale: AS NOTED
Checked By: G.S.S	Date: JAN. 2022	Rev: 1
Project No.: 2210711	Drawn By: A305a	

1 NEW ROOF PLAN - (FM GLOBAL)
A305a 1/8"=1'-0"

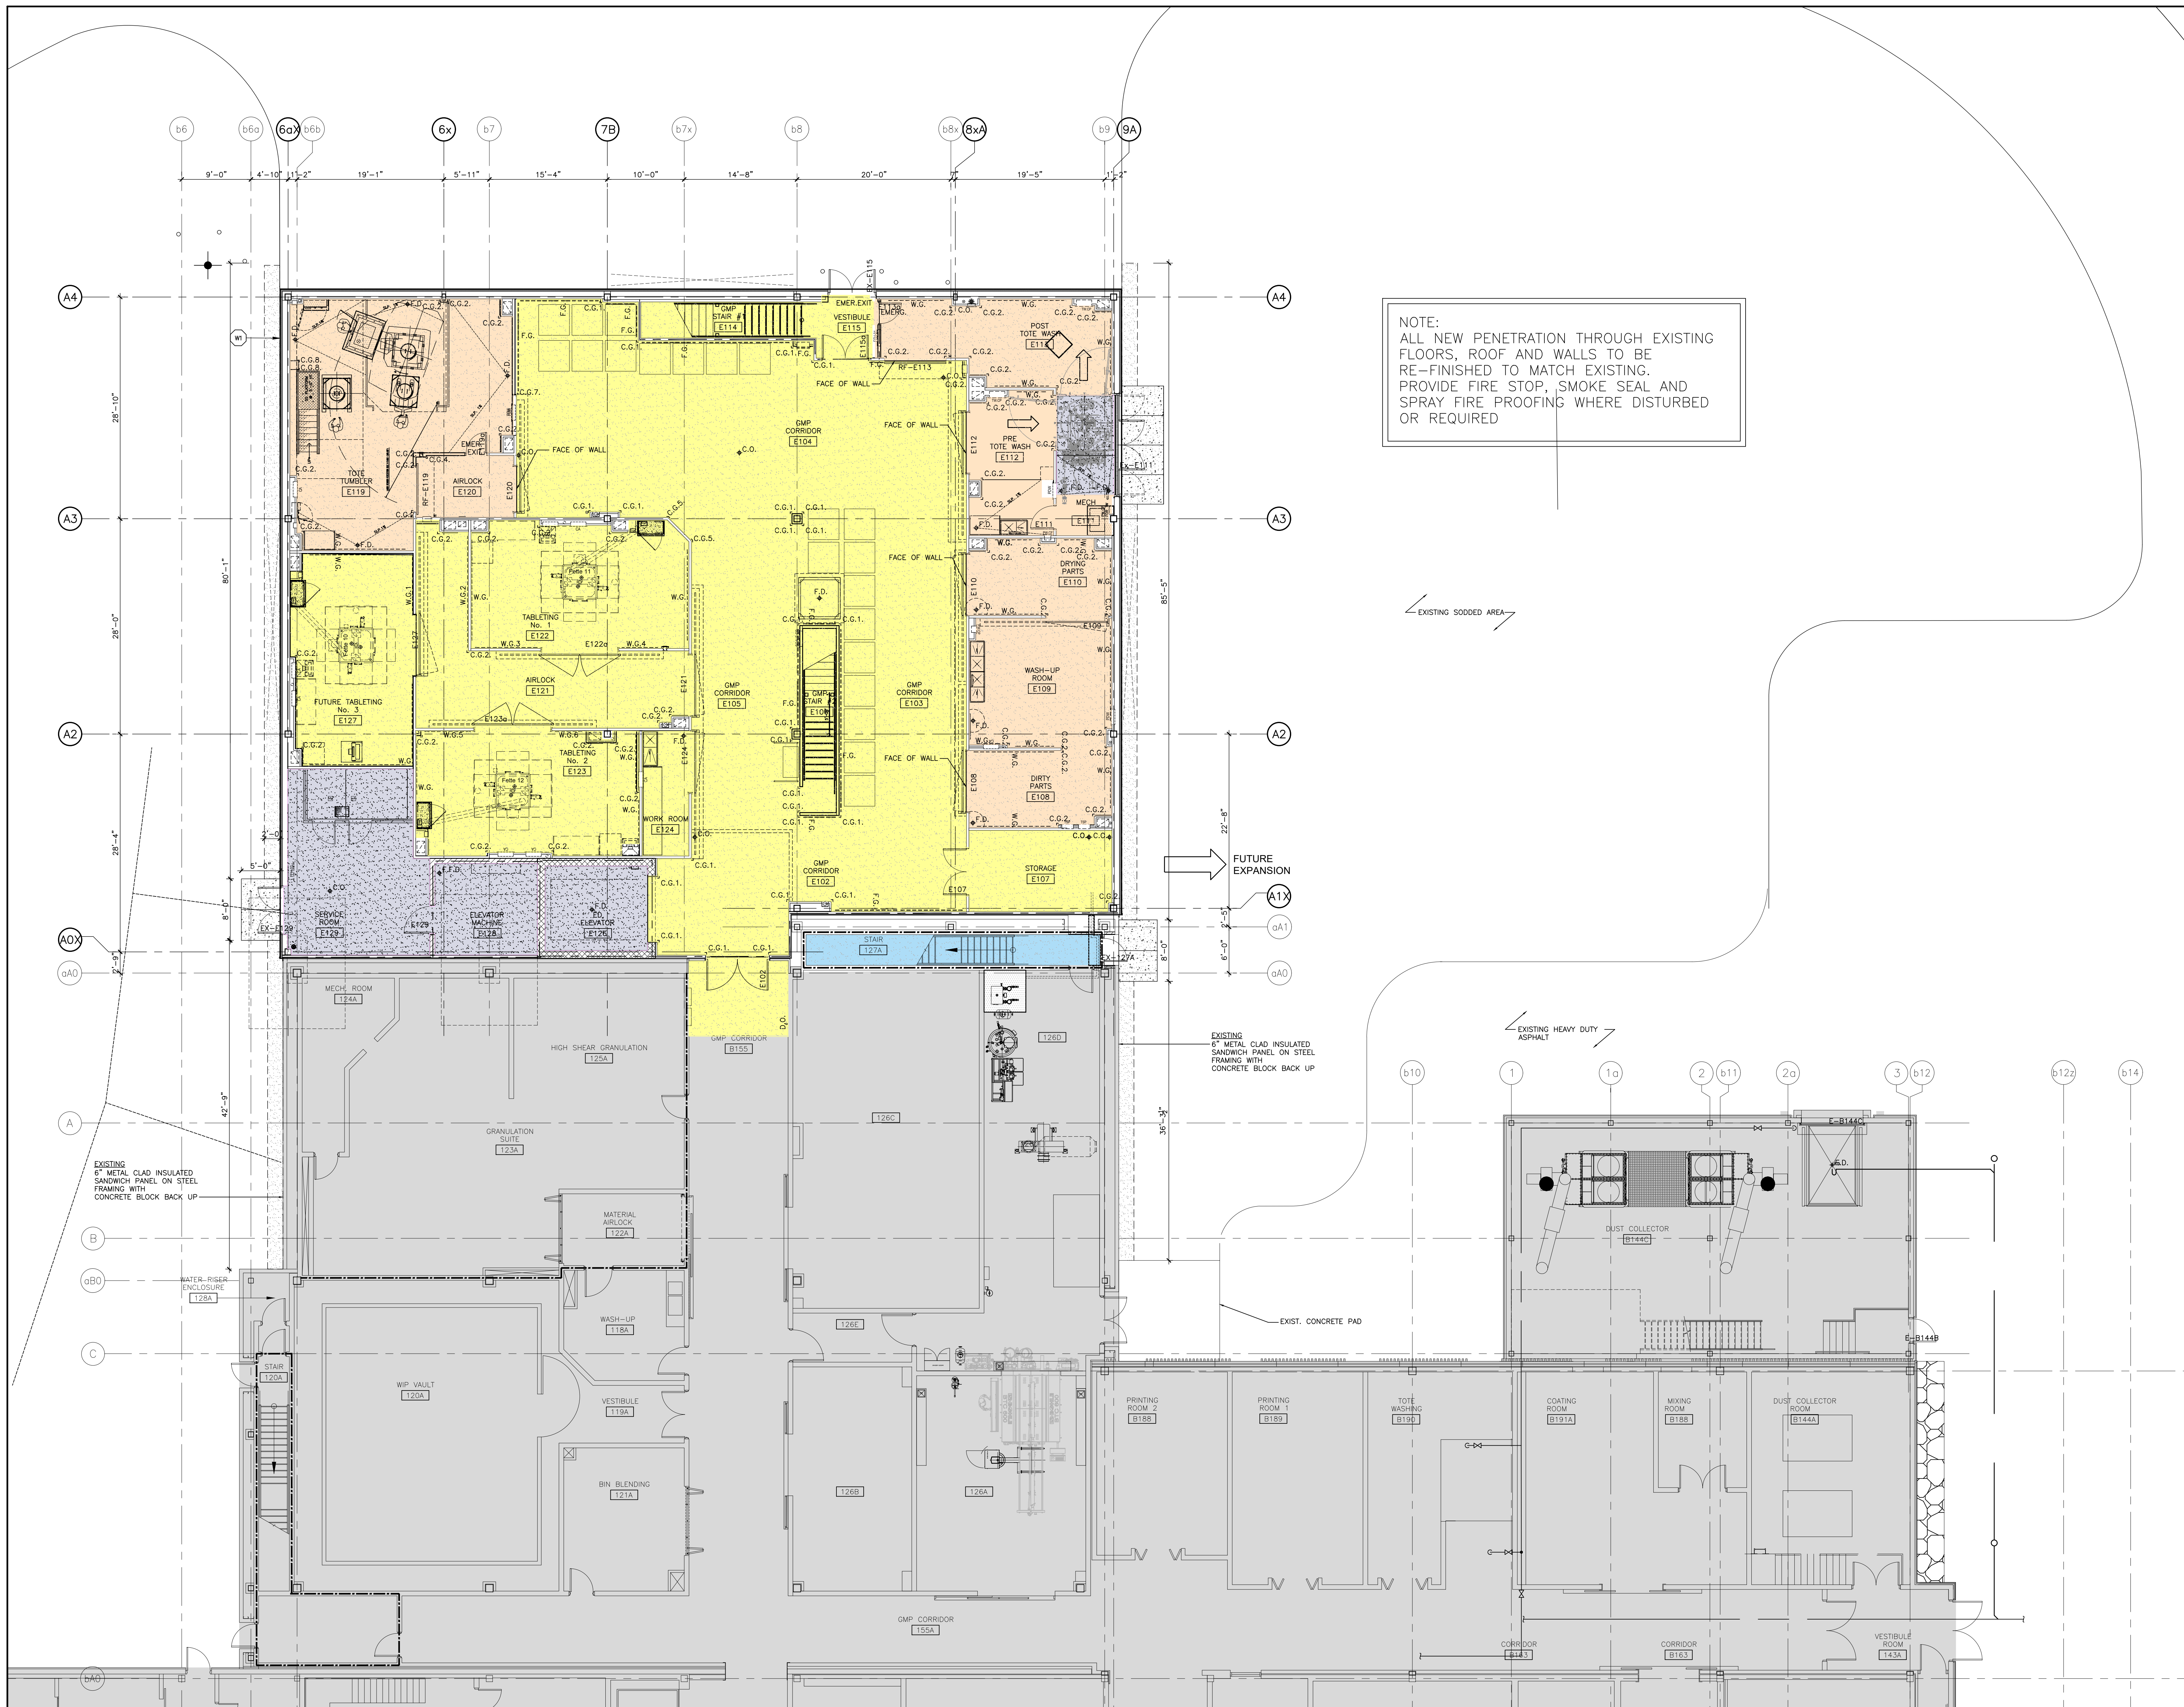

NOTE:
ALL NEW PENETRATION THROUGH EXISTING
FLOORS, ROOF AND WALLS TO BE
RE-FINISHED TO MATCH EXISTING.
PROVIDE FIRE STOP, SMOKE SEAL AND
SPRAY FIRE PROOFING WHERE DISTURBED
OR REQUIRED

NOTES

These drawings are the property of, and shall not be used or reproduced without the consent of WBA Architects and Engineers Inc. The Contractor shall check and verify all dimensions and report all discrepancies to the Architect and/or Engineer.

PROJECT NORTH

TRUE NORTH

No.	Date	Issued	By:
A	2023-06-23	ISSUED FOR REVIEW	WBA
B	2023-06-28	ISSUED FOR REVIEW	WBA

WALL LEGEND

W1

PRE-FINISHED 4" INSULATED METAL PANELS ON STEEL SUB-ORTS

W2

1-HR. FIRE-RATED WALL 12" REINFORCED CONCRETE BLOCK UP TO 1/3 OF STRUCTURE. FIRE STOP AND SMOKE SEAL AT TOP.

W3

1-HR. FIRE-RATED WALL 12" REINFORCED CONCRETE BLOCK WALL SEE STRUCTURAL. FIRE STOP AND SMOKE SEAL AT TOP.

W4

1-HR. FIRE-RATED WALL 8" REINFORCED CONCRETE BLOCK WALL UP TO 1/3 OF STRUCTURE. FIRE STOP AND SMOKE SEAL AT TOP. SEE STRUCTURAL.

W5

1/2" GLASS-MAT PANEL ON ONE SIDE OF 3/8" METAL STUD @ 16" O.C. UP TO MIN. 4" ABOVE FINISHED CEILING

W6

1/2" GLASS-MAT PANEL ON BOTH SIDE OF 3/8" METAL STUD @ 16" O.C. UP TO MIN. 4" ABOVE FINISHED CEILING

W7

1-HR. FIRE-RATED WALL U.L.C. #552

W8

1-HR. FIRE-RATED WALL U.L.C. #552

W9

1-HR. FIRE-RATED WALL U.L.C. #552

W10

1-HR. FIRE-RATED WALL U.L.C. #552

W11

1-HR. FIRE-RATED WALL U.L.C. #552

W12

1-HR. FIRE-RATED WALL U.L.C. #552

W13

1-HR. FIRE-RATED WALL U.L.C. #552

W14

1-HR. FIRE-RATED WALL U.L.C. #552

W15

1-HR. FIRE-RATED WALL U.L.C. #552

W16

1-HR. FIRE-RATED WALL U.L.C. #552

W17

1-HR. FIRE-RATED WALL U.L.C. #552

W18

1-HR. FIRE-RATED WALL U.L.C. #552

W19

1-HR. FIRE-RATED WALL U.L.C. #552

W20

1-HR. FIRE-RATED WALL U.L.C. #552

W21

1-HR. FIRE-RATED WALL U.L.C. #552

W22

1-HR. FIRE-RATED WALL U.L.C. #552

W23

1-HR. FIRE-RATED WALL U.L.C. #552

W24

1-HR. FIRE-RATED WALL U.L.C. #552

W25

1-HR. FIRE-RATED WALL U.L.C. #552

W26

1-HR. FIRE-RATED WALL U.L.C. #552

W27

1-HR. FIRE-RATED WALL U.L.C. #552

W28

1-HR. FIRE-RATED WALL U.L.C. #552

W29

1-HR. FIRE-RATED WALL U.L.C. #552

W30

1-HR. FIRE-RATED WALL U.L.C. #552

W31

1-HR. FIRE-RATED WALL U.L.C. #552

W32

1-HR. FIRE-RATED WALL U.L.C. #552

W33

1-HR. FIRE-RATED WALL U.L.C. #552

W34

1-HR. FIRE-RATED WALL U.L.C. #552

W35

1-HR. FIRE-RATED WALL U.L.C. #552

W36

1-HR. FIRE-RATED WALL U.L.C. #552

W37

1-HR. FIRE-RATED WALL U.L.C. #552

W38

1-HR. FIRE-RATED WALL U.L.C. #552

W39

1-HR. FIRE-RATED WALL U.L.C. #552

FLOOR PLAN LEGEND:

EX-1

EXISTING AREA TO REMAIN

EX-2

INTERIOR ALTERATION / NEW ADDITION

EX-3

NEW DOOR AND FRAME

EX-4

FIRE EXTINGUISHER IN RECESSED STAINLESS STEEL CABINET BY OTHER

EX-5

C.G. STAINLESS STEEL CORNER GUARD

EX-6

F.C.G. FULL HEIGHT STAINLESS STEEL CORNER GUARD

EX-7

SEE DET. #1/A7046

EX-8

STAINLESS STEEL WALL BUMPER GUARD. SEE DET. #1/A7046

EX-9

STAINLESS STEEL FLOOR GUARD. SEE DET. #1/A7046

EX-10

SEE DET. #1/A7046

EX-11

SEE DET. #1/A7046

EX-12

SEE DET. #1/A7046

EX-13

SEE DET. #1/A7046

EX-14

SEE DET. #1/A7046

EX-15

SEE DET. #1/A7046

EX-16

SEE DET. #1/A7046

EX-17

SEE DET. #1/A7046

EX-18

SEE DET. #1/A7046

EX-19

SEE DET. #1/A7046

EX-20

SEE DET. #1/A7046

EX-21

SEE DET. #1/A7046

EX-22

SEE DET. #1/A7046

EX-23

SEE DET. #1/A7046

EX-24

SEE DET. #1/A7046

EX-25

SEE DET. #1/A7046

EX-26

SEE DET. #1/A7046

EX-27

SEE DET. #1/A7046

EX-28

SEE DET. #1/A7046

EX-29

SEE DET. #1/A7046

EX-30

SEE DET. #1/A7046

EX-31

SEE DET. #1/A7046

EX-32

SEE DET. #1/A7046

EX-33

SEE DET. #1/A7046

EX-34

SEE DET. #1/A7046

EX-35

SEE DET. #1/A7046

EX-36

SEE DET. #1/A7046

EX-37

SEE DET. #1/A7046

EX-38

SEE DET. #1/A7046

EX-39

SEE DET. #1/A7046

EX-40

SEE DET. #1/A7046

EX-41

SEE DET. #1/A7046

EX-42

SEE DET. #1/A7046

EX-43

SEE DET. #1/A7046

EX-44

SEE DET. #1/A7046

EX-45

SEE DET. #1/A7046

EX-46

SEE DET. #1/A7046

EX-47

SEE DET. #1/A7046

EX-48

SEE DET. #1/A7046

EX-49

SEE DET. #1/A7046

EX-50

SEE DET. #1/A7046

EX-51

SEE DET. #1/A7046

EX-52

SEE DET. #1/A7046

EX-53

SEE DET. #1/A7046

EX-54

SEE DET. #1/A7046

EX-86

SEE DET. #1/A7046

EX-87

SEE DET. #1/A7046

EX-88

SEE DET. #1/A7046

EX-89

SEE DET. #1/A7046

EX-90

SEE DET. #1/A7046

EX-91

SEE DET. #1/A7046

EX-92

SEE DET. #1/A7046

EX-93

SEE DET. #1/A7046

EX-94

SEE DET. #1/A7046

EX-95

SEE DET. #1/A7046

EX-96

SEE DET. #1/A7046

EX-97

SEE DET. #1/A7046

EX-98

SEE DET. #1/A7046

EX-99

SEE DET. #1/A7046

EX-100

SEE DET. #1/A7046

FIRE RATING LEGEND

EX-1

DENOTES AND DELINEATES ZERO-HOUR (0) FIRE SEPARATION.

EX-2

DENOTES AND DELINEATES ONE-HOUR (1) FIRE SEPARATION.

EX-3

DENOTES AND DELINEATES TWO-HOUR (2) FIRE SEPARATION.

EX-4

DENOTES AND DELINEATES THREE-HOUR (3) FIRE SEPARATION.

EX-5

DENOTES AND DELINEATES FOUR-HOUR (4) FIRE SEPARATION.

CORNER GUARDS

EX-1

C.G.1 - 5'-0" HT.

EX-2

C.G.2 - 9'-2" HT.

EX-3

C.G.3 - 9'-8" HT.

FLOOR FINISHES

EX-1

BLACK/BROWN TERRAZZO (TERR. 'A')

EX-2

AMBER TERRAZZO (TERR. 'B')

EX-3

GREY EPOXY COATING (REFER TO SCHEDULE)

EX-4

RECOATING/MATCH EXIST. (EPOXY 'C')

No.	Date	Revision	By:
2	2024-04-11	ISSUED FOR AS-BUILT	WBA
1	2023-06-30	ISSUED FOR CON. #30	WBA
0	2023-03-08	ISSUED FOR CON. #19	WBA

Professional Seal

Professional Seal

ONTARIO ASSOCIATION OF ARCHITECTS

ROY ALEXANDER BASSO

7032

07/12/22

Consultant:

wba

architects and engineers inc.

3 - 530 Rosedale Dairy Road

Westphal, Ontario L4L 1M0

TEL: 905-851-0616

FAX: 905-851-1148

EMAIL: info@wbaae.com

Client:

Johnson & Johnson

890 WOODLAWN ROAD,

GUELPH, ON

Project Title:

PROJECT NASH

Drawing Title:

NEW GROUND FLOOR FLOOR FINISHES PLAN

CADD System:

Autocad 2016

Plot Scale:

1:1

Sheet Size:

30" x 42"

Drawn By:

M.B.

Date:

JAN. 2022

Drawing Scale:

AS NOTED

Checked By:

G.S.S.

Date:

JAN. 2022

Rev:

2

Project No:


2210711

Dwg. No.:


A306a

1
A306a
NEW GROUND FLOOR FLOOR FINISHES PLAN


Plot Date: Jul 31, 2028 - 11:02am - Printed By: Rev#18 CADD File Name: 2023\2210711-A-306a-NEW PLAN GROUND A - FLOORING.dwg

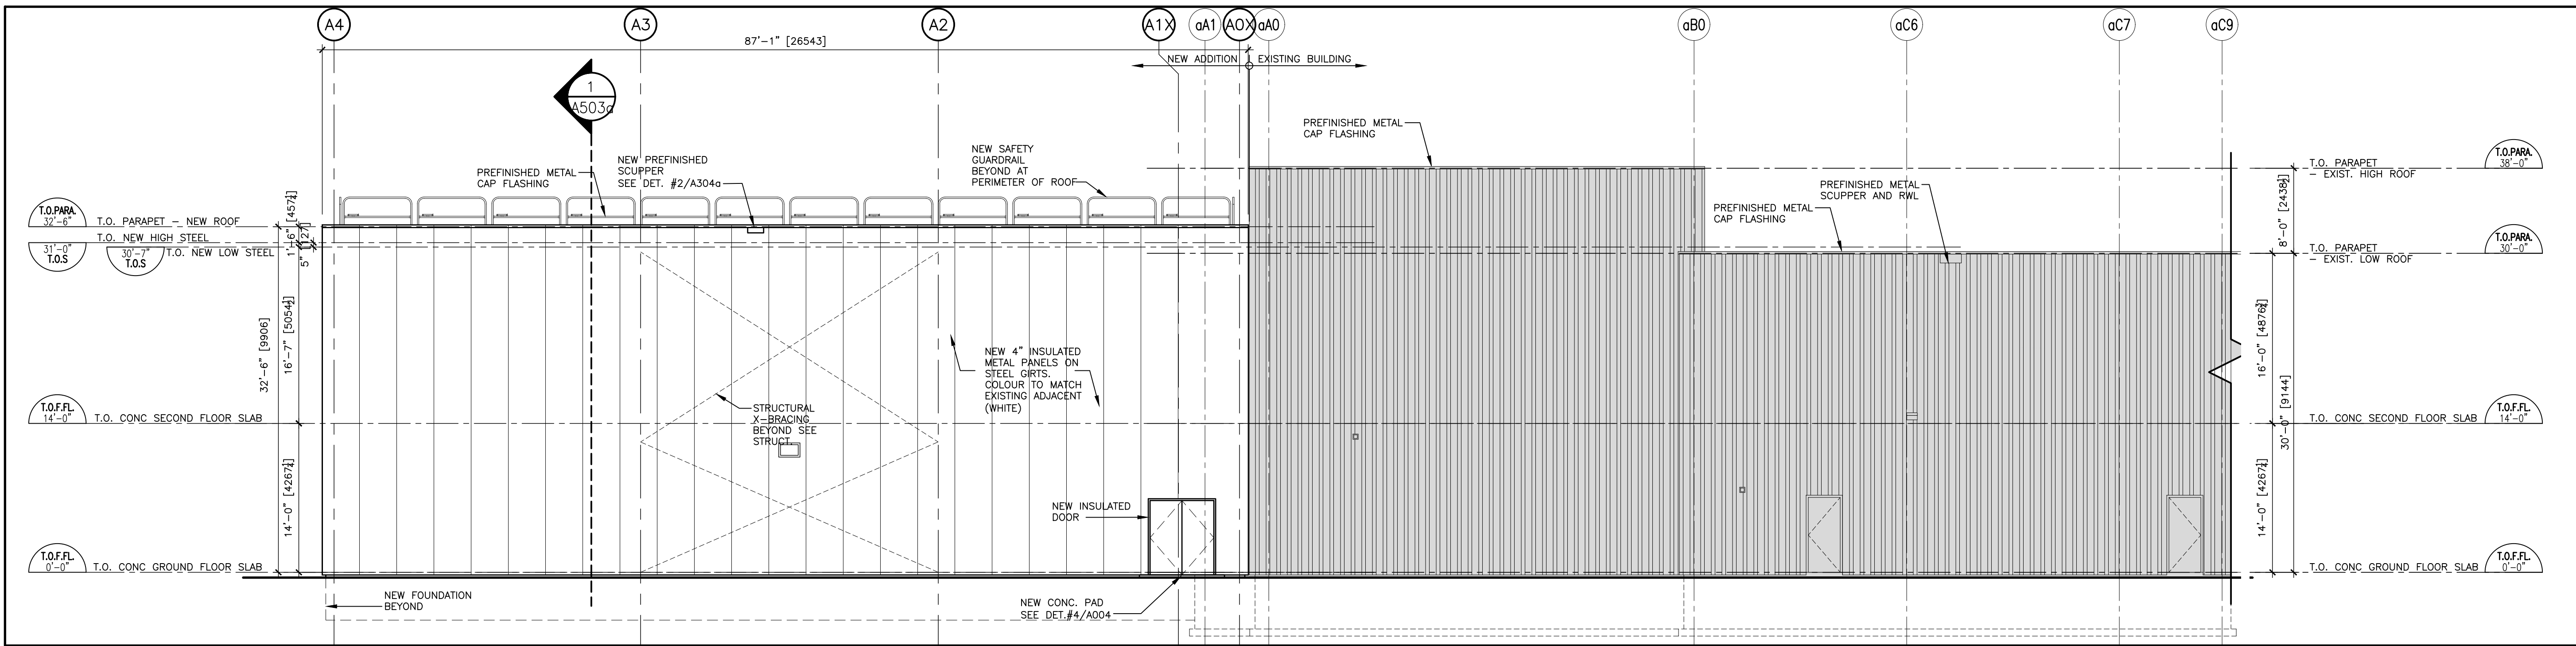

3 NEW WEST ELEVATION - PROCESS
1/8\"=1'-0"

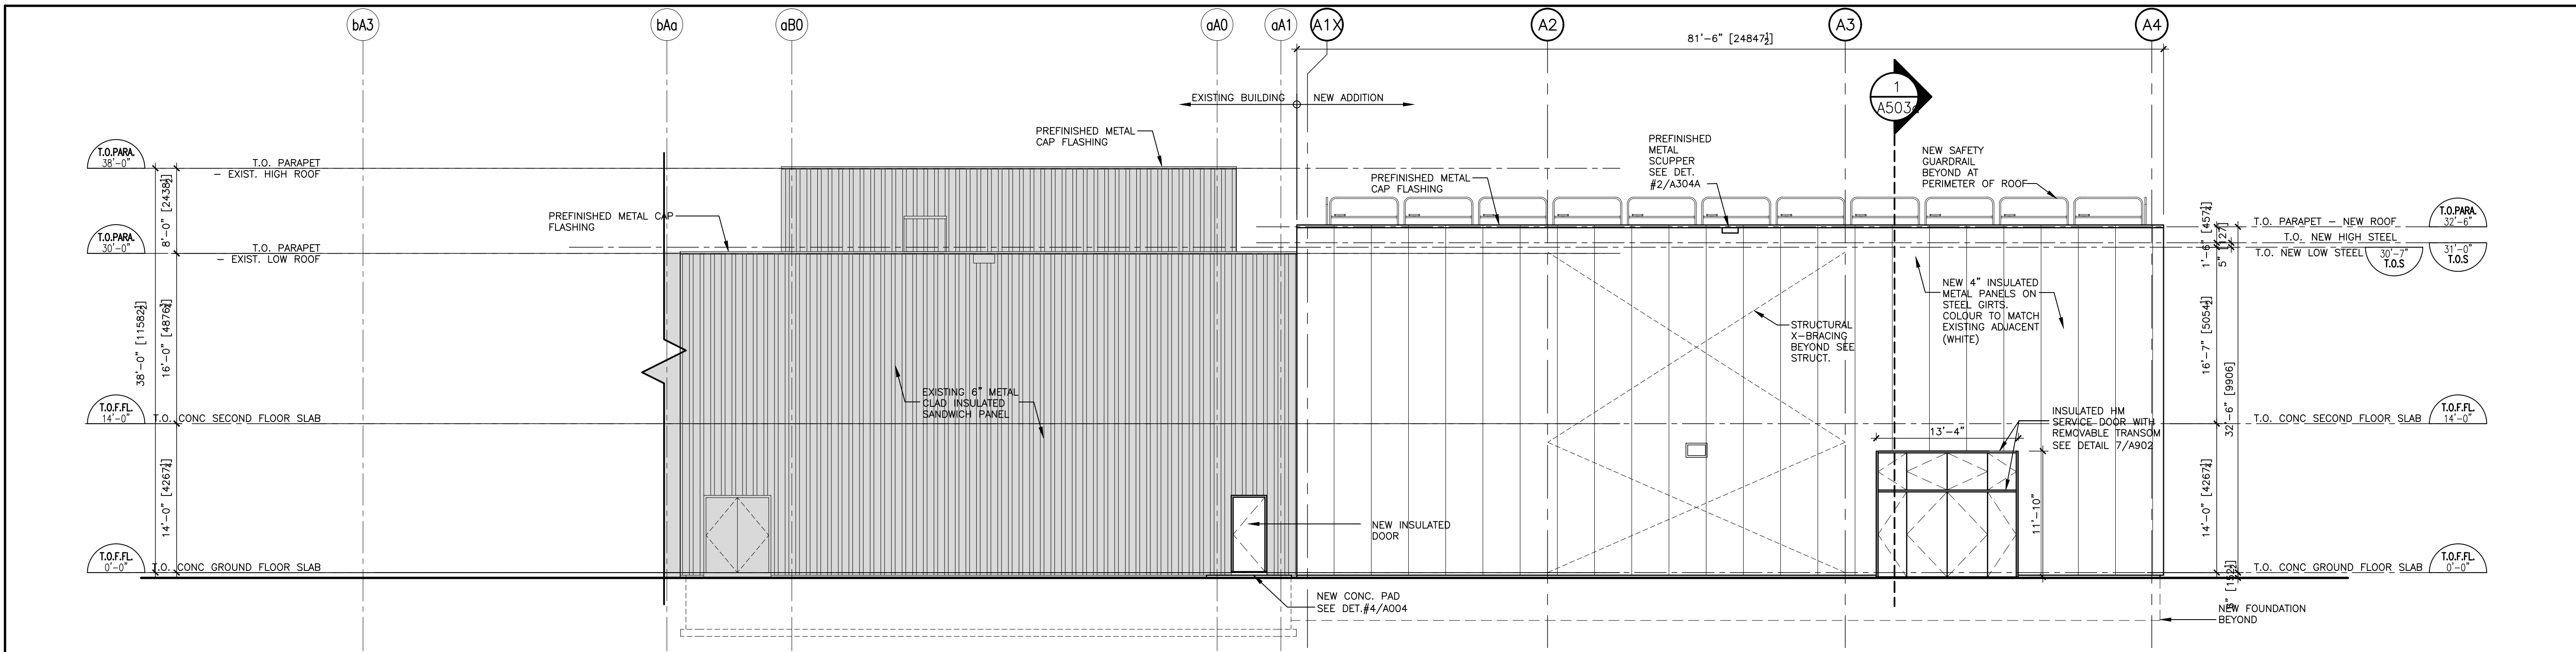

2 NEW EAST ELEVATION - PROCESS
1/8\"=1'-0"

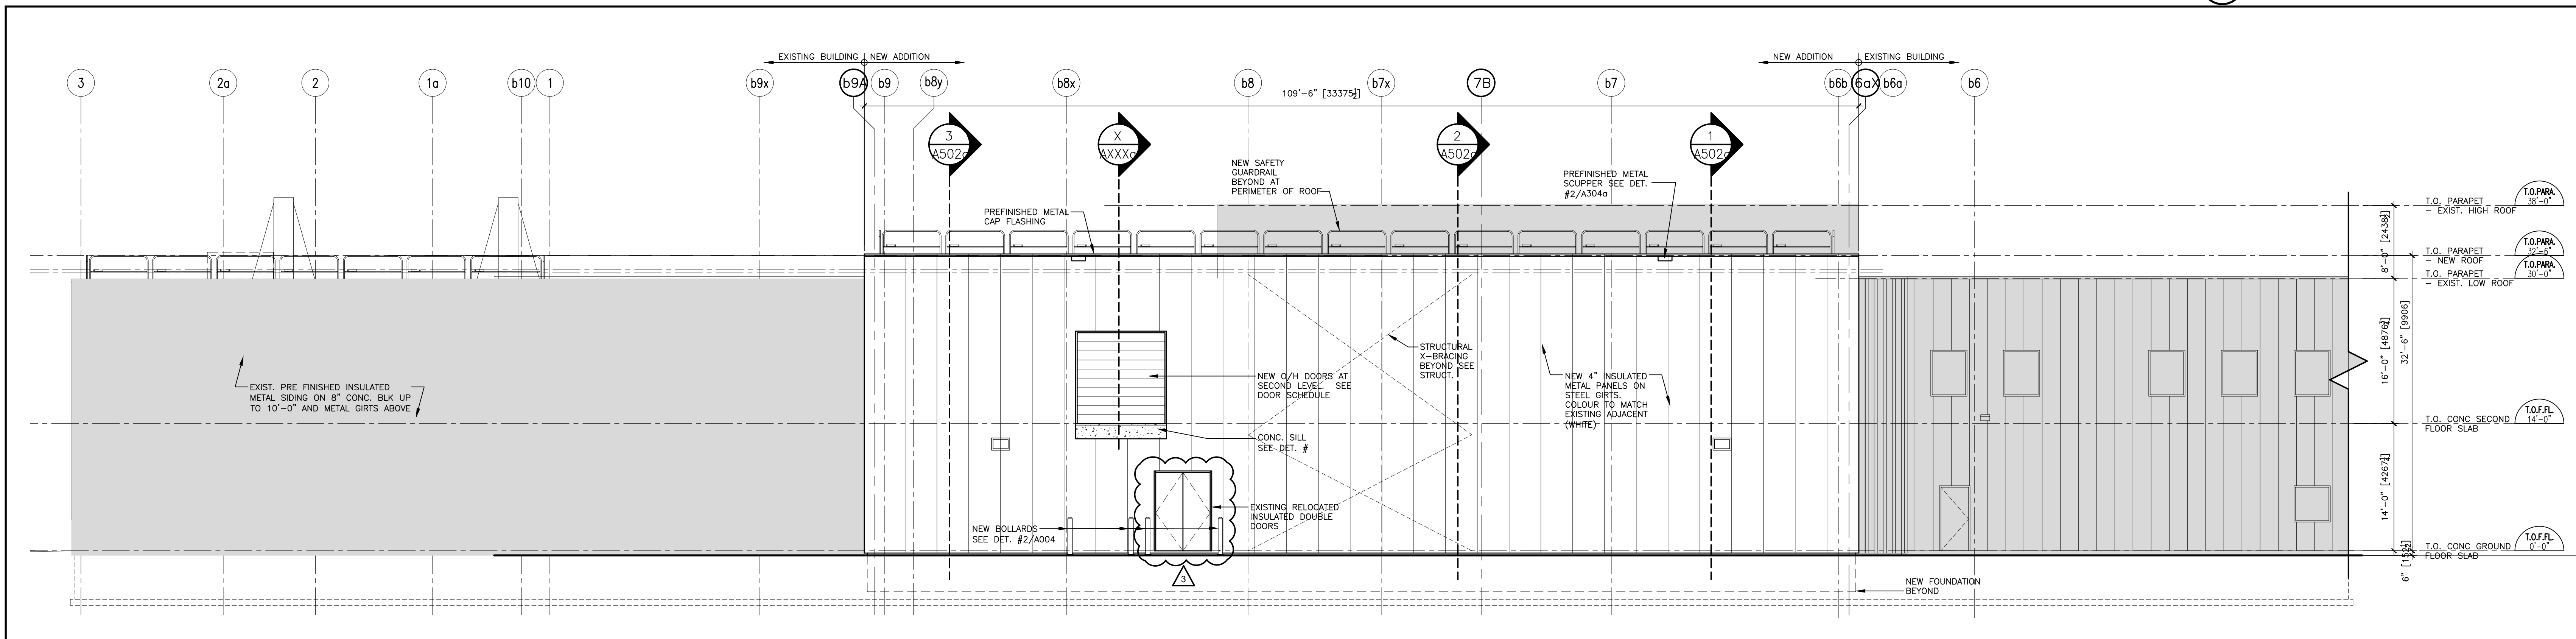

1 NEW NORTH ELEVATION - PROCESS
1/8\"=1'-0"


NOTES

These drawings are the property of, and shall not be used or reproduced without the consent of WBA Architects and Engineers Inc. The Contractor shall check and verify all dimensions and report all discrepancies to the Architect and/or Engineer.

No.	Date	Issued	By:
A	2022-02-18	ISSUED FOR BUDGET ESTIMATE	WBA
B	2022-03-23	ISSUED FOR 75% DESIGN REVIEW	WBA
C	2022-04-08	ISSUED FOR 90% DESIGN REVIEW	WBA
D	2022-04-29	ISSUED FOR TENDER	WBA
E	2023-06-20	ISSUED FOR REVISION TO PERMIT	WBA

4	2024-04-11	ISSUED FOR AS-BUILT	WBA
3	2023-08-10	ISSUED FOR S. #011	WBA
2	2023-03-13	ISSUED FOR CON. #20	WBA
1	2023-02-06	ISSUED FOR CON. #13	WBA
0	2022-07-13	ISSUED FOR CONSTRUCTION	WBA

No.	Date	Revision	Construction	By:
-----	------	----------	--------------	-----

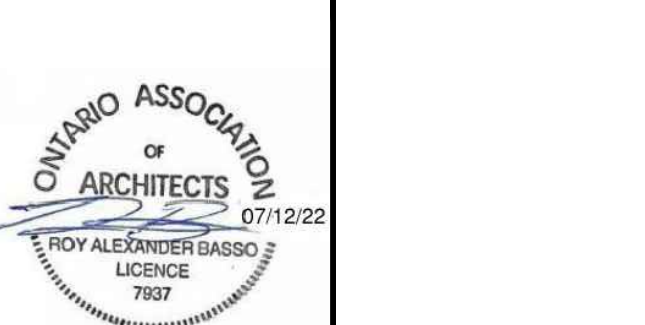


Consultant:
3 - 530 Rossmore Dairy Road
Westport, Ontario L4L 4B0
Tel: 905-851-0616
Fax: 905-851-1748
email: info@wbae.com

Client:
Johnson & Johnson
890 WOODLAWN ROAD WEST
GUELPH, ON


Project Title:
PROJECT NASH

Drawing Title:
NEW BUILDING ELEVATIONS
PROCESS


CADD System :	Plot Scale:	Sheet Size:
AUTOCAD 2016	1:1	30" x 42"
Drawn By:	Date:	Drawing Scale:
R.R.	JAN. 2022	AS NOTED
Checked By:	Date:	Rev:
G.S.S	JAN. 2022	4
Project No.:	Dwg. No.:	
2210711	A402a	

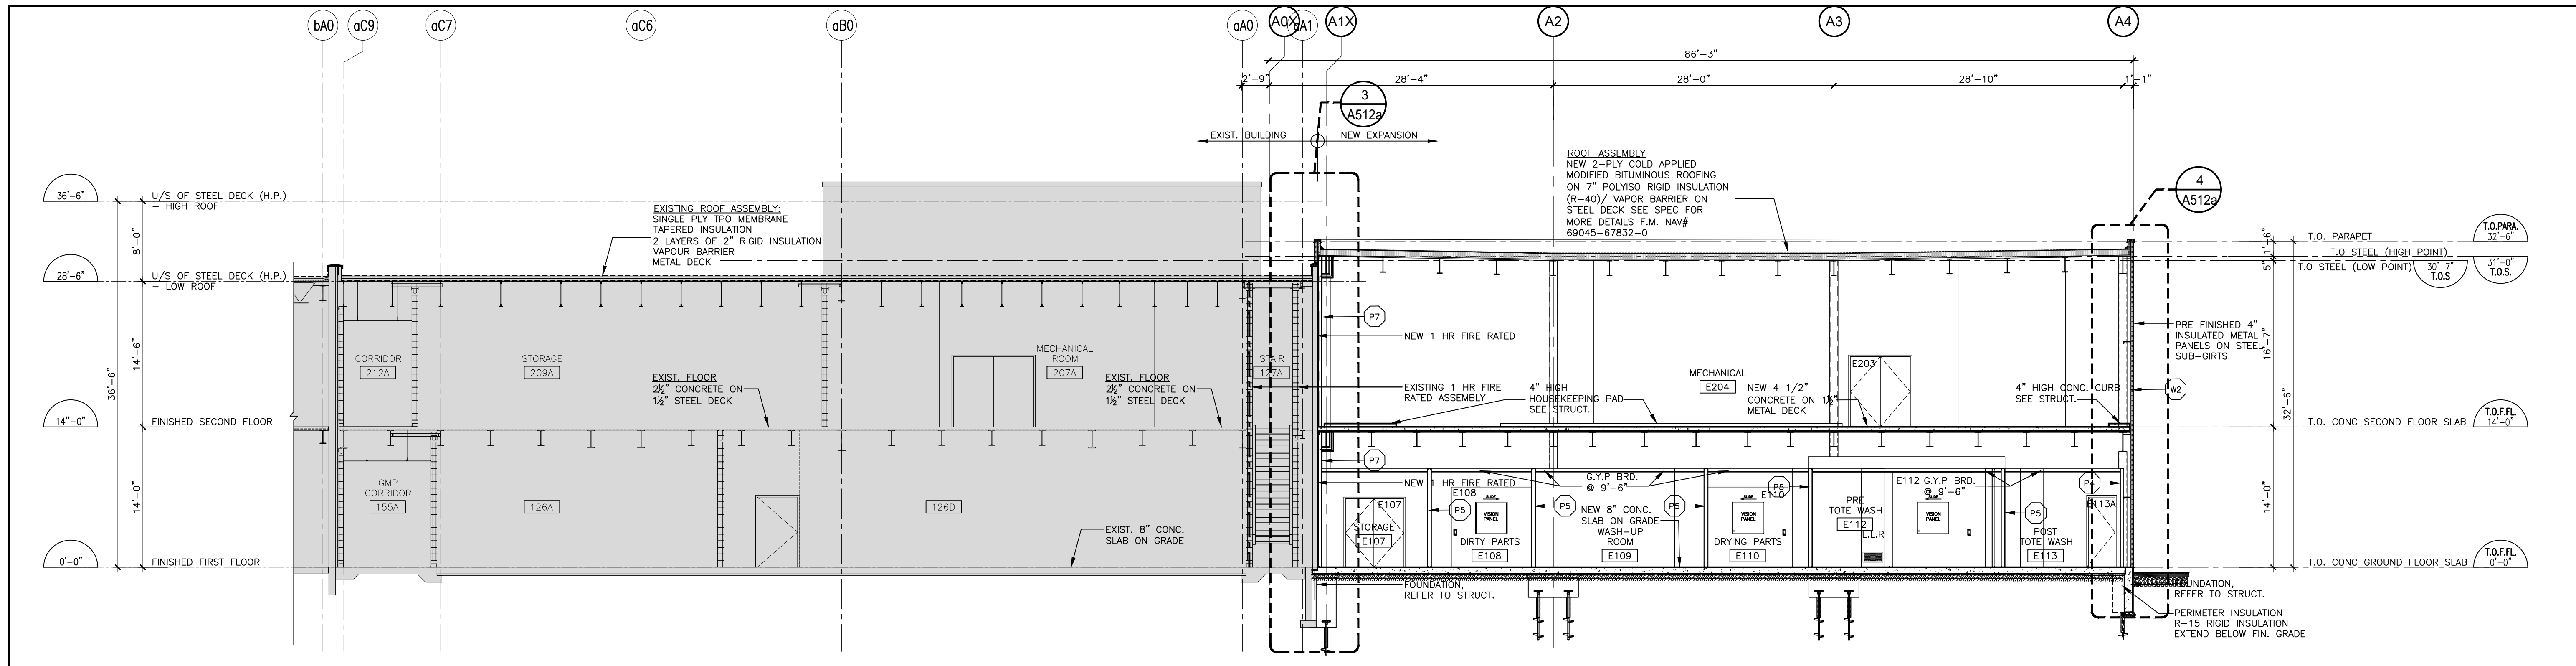

3 PARTIAL NEW BUILDING SECTION
NORTH - SOUTH

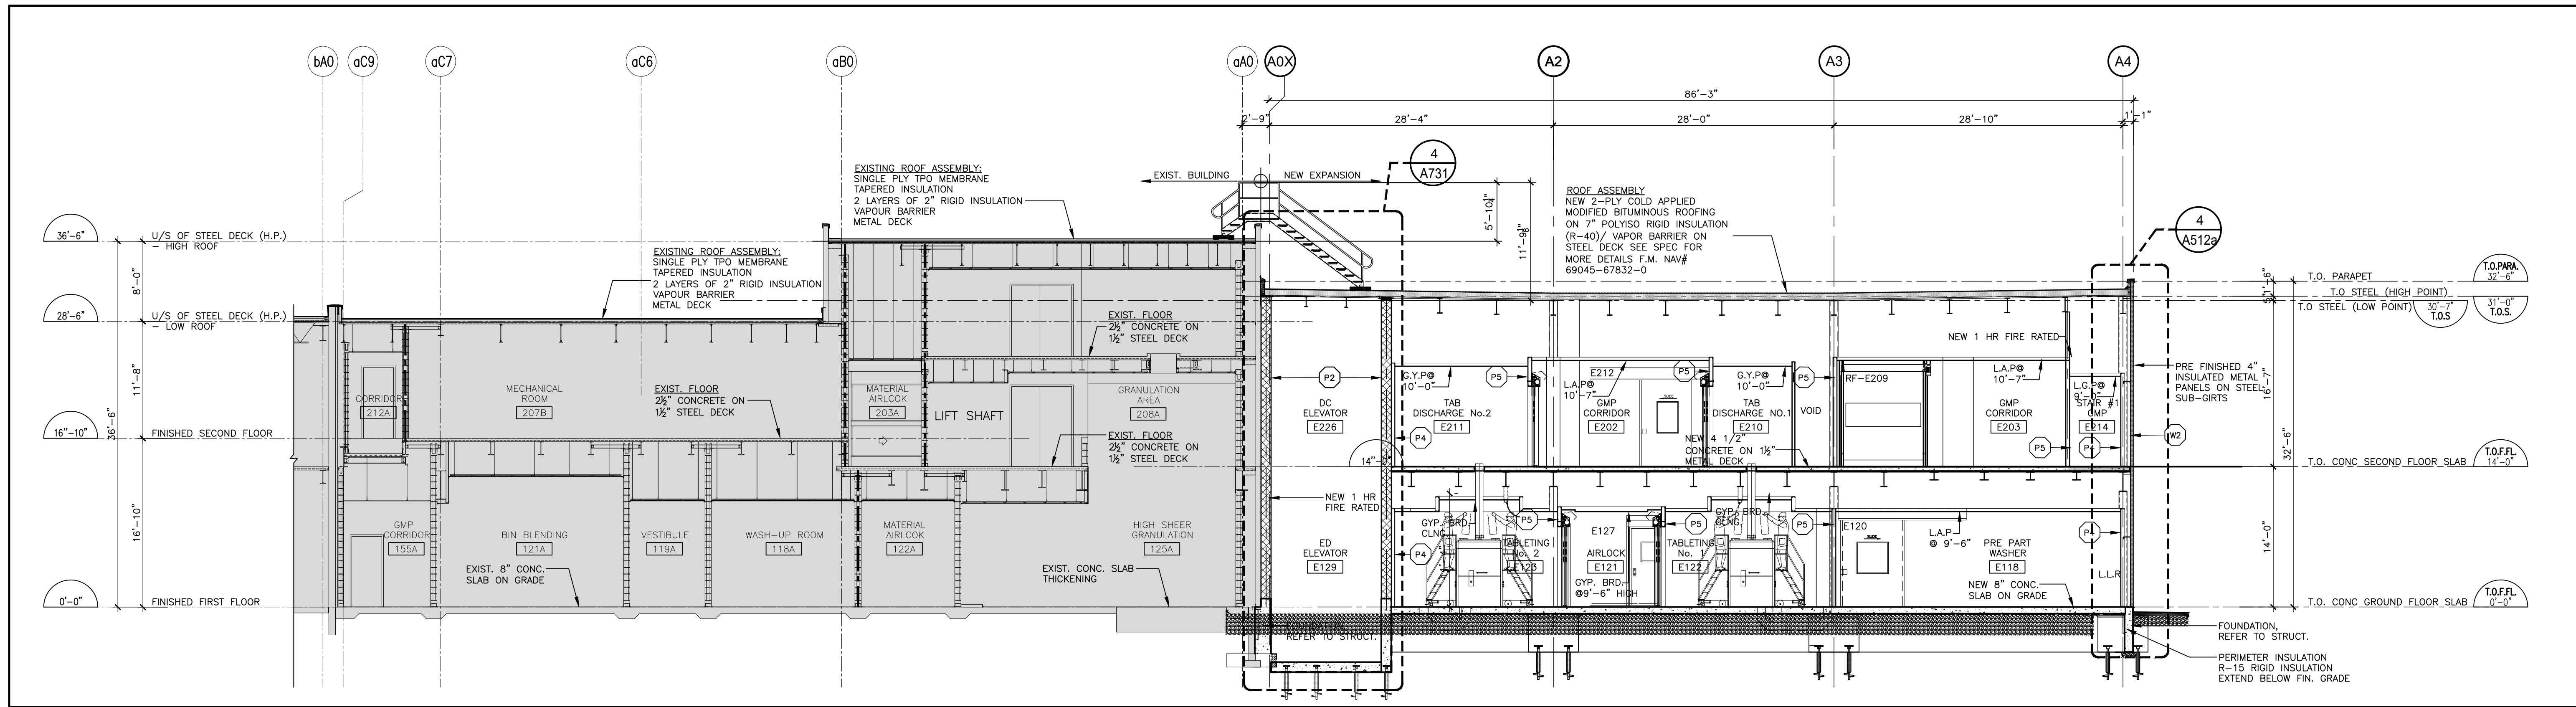

2 PARTIAL NEW BUILDING SECTION
NORTH - SOUTH

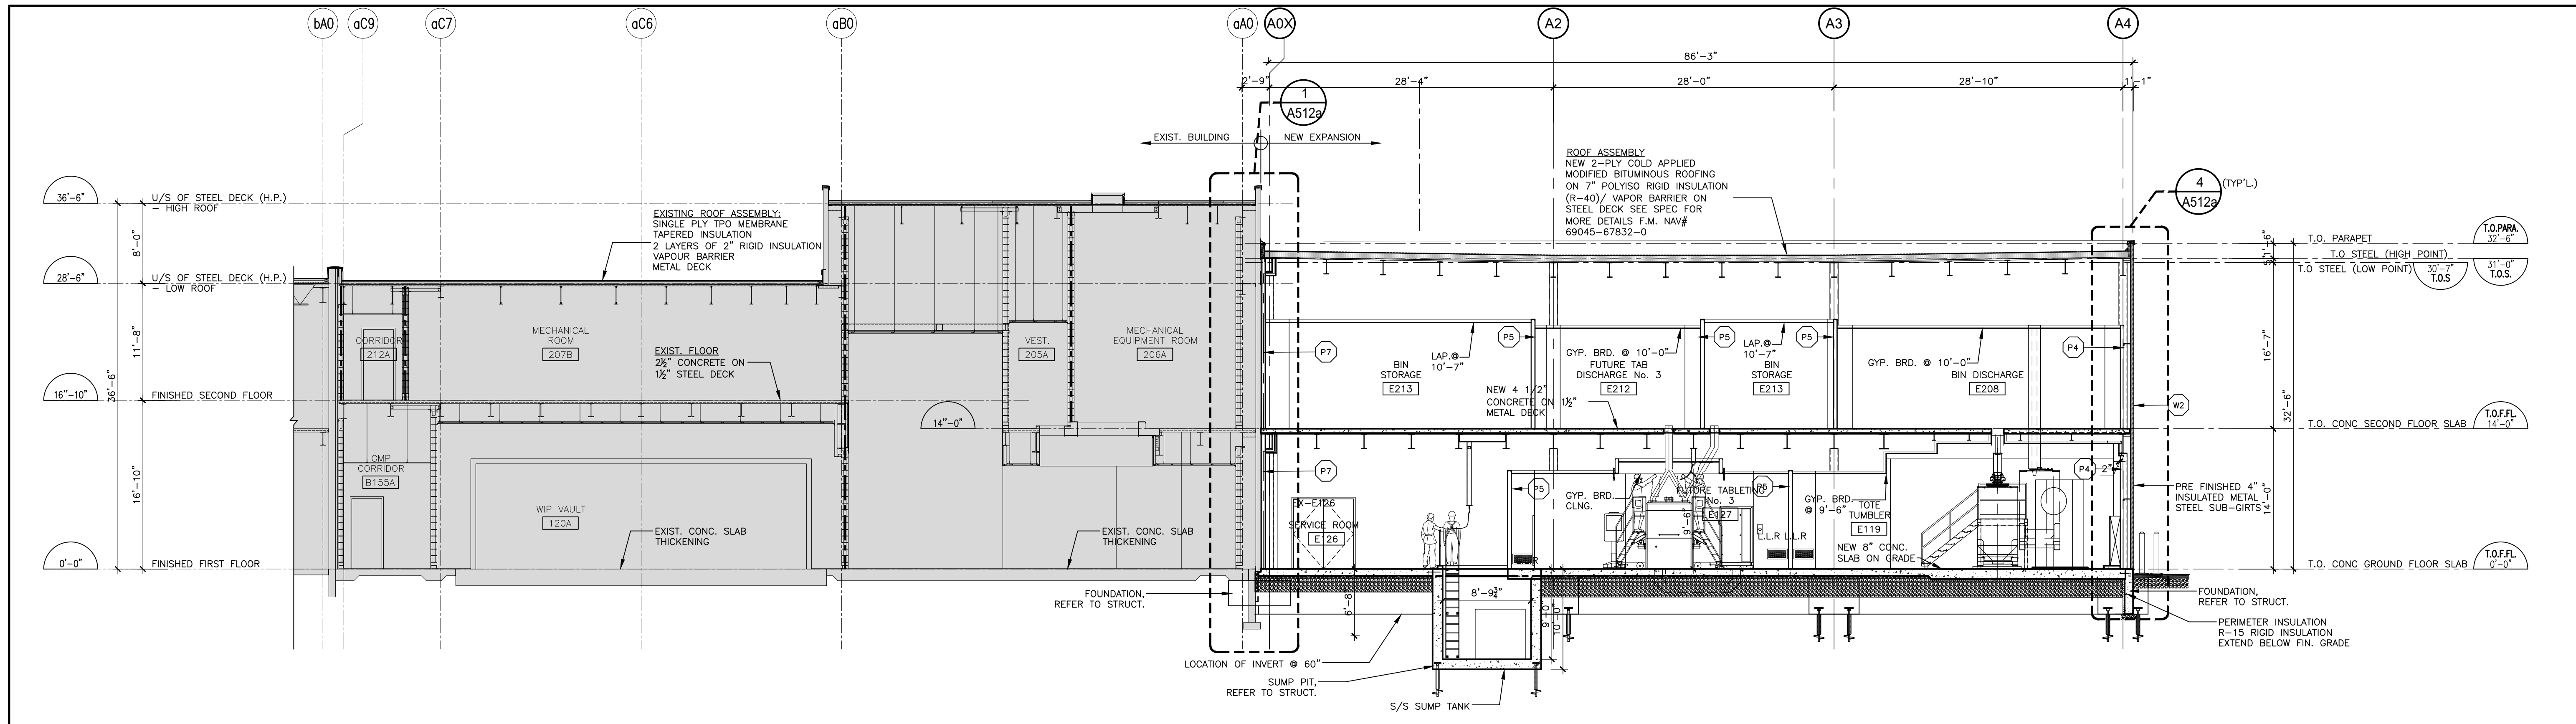

1 PARTIAL NEW BUILDING SECTION
NORTH - SOUTH

NOTES

These drawings are the property of, and shall not be used or reproduced without the consent of WBA Architects and Engineers Inc. The Contractor shall check and verify all dimensions and report all discrepancies to the Architect and/or Engineer.

PROJECT NORTH

TRUE NORTH

No.	Date	Issued	By
A	2022-02-18	ISSUED FOR BUDGET ESTIMATE	WBA
B	2022-03-14	ISSUED FOR COORDINATION	WBA
C	2022-03-23	ISSUED FOR 75% DESIGN REVIEW	WBA
D	2022-04-08	ISSUED FOR 90% DESIGN REVIEW	WBA
E	2022-04-26	ISSUED FOR TENDER	WBA
F	2023-06-20	ISSUED FOR REVISION TO PERMIT	WBA

EXIST. EXTERIOR WALL LEGEND

- EX-W1 EXIST. EXTERIOR WALL SYSTEM
6" METAL CLAD INSULATED SANDWICH PANEL ON GALVANIZED SUB-GIRTS WITH AIR SPACE OF 1'-2" SET ON 8" CONCRETE BLOCK WALL
- EX-W2 EXIST. EXTERIOR WALL SYSTEM
6" METAL CLAD INSULATED SANDWICH PANEL ON GALVANIZED SUB-GIRTS
- EX-W3 EXIST. EXTERIOR WALL SYSTEM
6" METAL CLAD INSULATED SANDWICH PANEL ON STEEL FRAMING WITH CONCRETE BLOCK BACK UP
- EX-P1 EXIST. 8" LIGHTWEIGHT CONC. BLK.
- EX-P2 EXIST. 12" CONCRETE BLOCK FIREWALL (FOUR (4) HOUR FIREWALL) 50 COURSES HIGH (MIN. 4'-0") ABOVE TOP OF STEEL DECK

TEMP. CONST. HOARDING FOR DEMOLITION AND NEW WALL/ CLING. CONSTRUCTION:
1/2" PRE-FINISHED VINYL GYPSUM BOARD ON ONE SIDE OF 3/8" METAL STUDS @ 24" O.C. (PRODUCTION SIDE) FROM FIN. FLOOR TO U/S OF EXISTING CEILING (DOUBLE SIDED TAPE TRACK TO FLOOR) PROVIDE VINYL BASE ON OCCURRED SIDE ON STEEL SUB-GIRTS

- P1 1 HR. FIRE RATED WALL
1" LIGHTWEIGHT CONC. BLOCK UP TO U/S OF STRUCTURE. FIRE STOP AND SMOKE SEAL AT TOP.
- P2 1 HR. FIRE RATED WALL
12" REINFORCED CONCRETE BLOCK WALL UP TO U/S OF STRUCTURE. FIRE STOP AND SMOKE SEAL AT TOP.
- P3 1 HR. FIRE RATED WALL
4" REINFORCED CONCRETE BLOCK WALL UP TO U/S OF STRUCTURE. FIRE STOP AND SMOKE SEAL AT TOP.
- P4 1 HR. FIRE RATED WALL
4" REINFORCED CONCRETE BLOCK WALL UP TO U/S OF STRUCTURE. FIRE STOP AND SMOKE SEAL AT TOP.
- P5 1/4" GLASS-MAT PANEL ON ONE SIDE OF 3/8" METAL STUD @ 18" O.C. UP TO MIN. 4" ABOVE FINISHED CEILING
- P6 1/4" GLASS-MAT PANEL ON BOTH SIDE OF 3/8" METAL STUD @ 18" O.C. UP TO MIN. 4" ABOVE FINISHED CEILING
- P7 1/4" GLASS-MAT PANEL ON ONE SIDE OF 3/8" METAL STUD @ 18" O.C. UP TO U/S OF FLOOR OR ROOF DECK
- P8 1/4" GLASS-MAT PANEL ON BOTH SIDE OF 3/8" METAL STUD @ 18" O.C. UP TO U/S OF FLOOR OR ROOF DECK
- C2 1/4" GLASS-MAT PANEL ON ONE SIDE ONLY OF 3/8" METAL STUD @ 18" O.C. UP TO MIN. 4" ABOVE FINISHED CEILING
- C3 1/4" GLASS-MAT PANEL ON ONE SIDE ONLY OF 3/8" METAL STUD @ 18" O.C. UP TO MIN. 4" ABOVE FINISHED CEILING

FLOOR PLAN LEGEND:

- EXISTING AREA TO REMAIN
- INTERIOR ALTERATION / NEW ADDITION
- NEW DOOR AND FRAME
- FIRE EXTINGUISHER IN RECESSED STAINLESS STEEL CABINET BY OTHER
- C.O. - STAINLESS STEEL CORNER GUARD
F.C.G. FULL HEIGHT STAINLESS STEEL CORNER GUARD SEE DET. #1/A7046
- STAINLESS STEEL WALL BUMPER GUARD. SEE DET. #1/A7046
- STAINLESS STEEL FLOOR GUARD. SEE DET. #1/A7046

FIRE RATING LEGEND

- DENOTES AND DELINEATES ZERO-HOUR (0) FIRE SEPARATION.
- DENOTES AND DELINEATES ONE-HOUR (1) FIRE SEPARATION.
- DENOTES AND DELINEATES TWO-HOUR (2) FIRE SEPARATION.
- DENOTES AND DELINEATES FOUR-HOUR (4) FIRE SEPARATION.

No.	Date	Revision	Professional Seal	By
3	2024-04-11	ISSUED FOR AS-BUILT	WBA	
2	2022-11-30	ISSUED FOR CONJ05-R2	WBA	
1	2022-11-10	SUMP PIT ADDED	WBA	
0	2022-07-13	ISSUED FOR CONSTRUCTION	WBA	

Consultant:
wba
architects and engineers Inc.
3, 530 Rowntree Dairy Road
Vaughan, Ontario L4L 8H2
Tel: 905.851.0418
Fax: 905.851.7148
Email: info@wba.com

Client:
Johnson & Johnson
890 WOODLAWN ROAD WEST
GUELPH, ON


Project Title:
PROJECT NASH

Drawing Title:
NEW BUILDING SECTIONS
PROCESS


CADD System :	Plot Scale:	Sheet Size:
AUTOCAD 2016	1:1	30" x 42"
Drawn By:	Date:	Drawing Scale:
R.R.	OCT/2021	AS NOTED
Checked By:	Date:	Rev:
G.S.S	OCT/2021	3
Project No:	Dwg. No.:	
2210711	A502a	

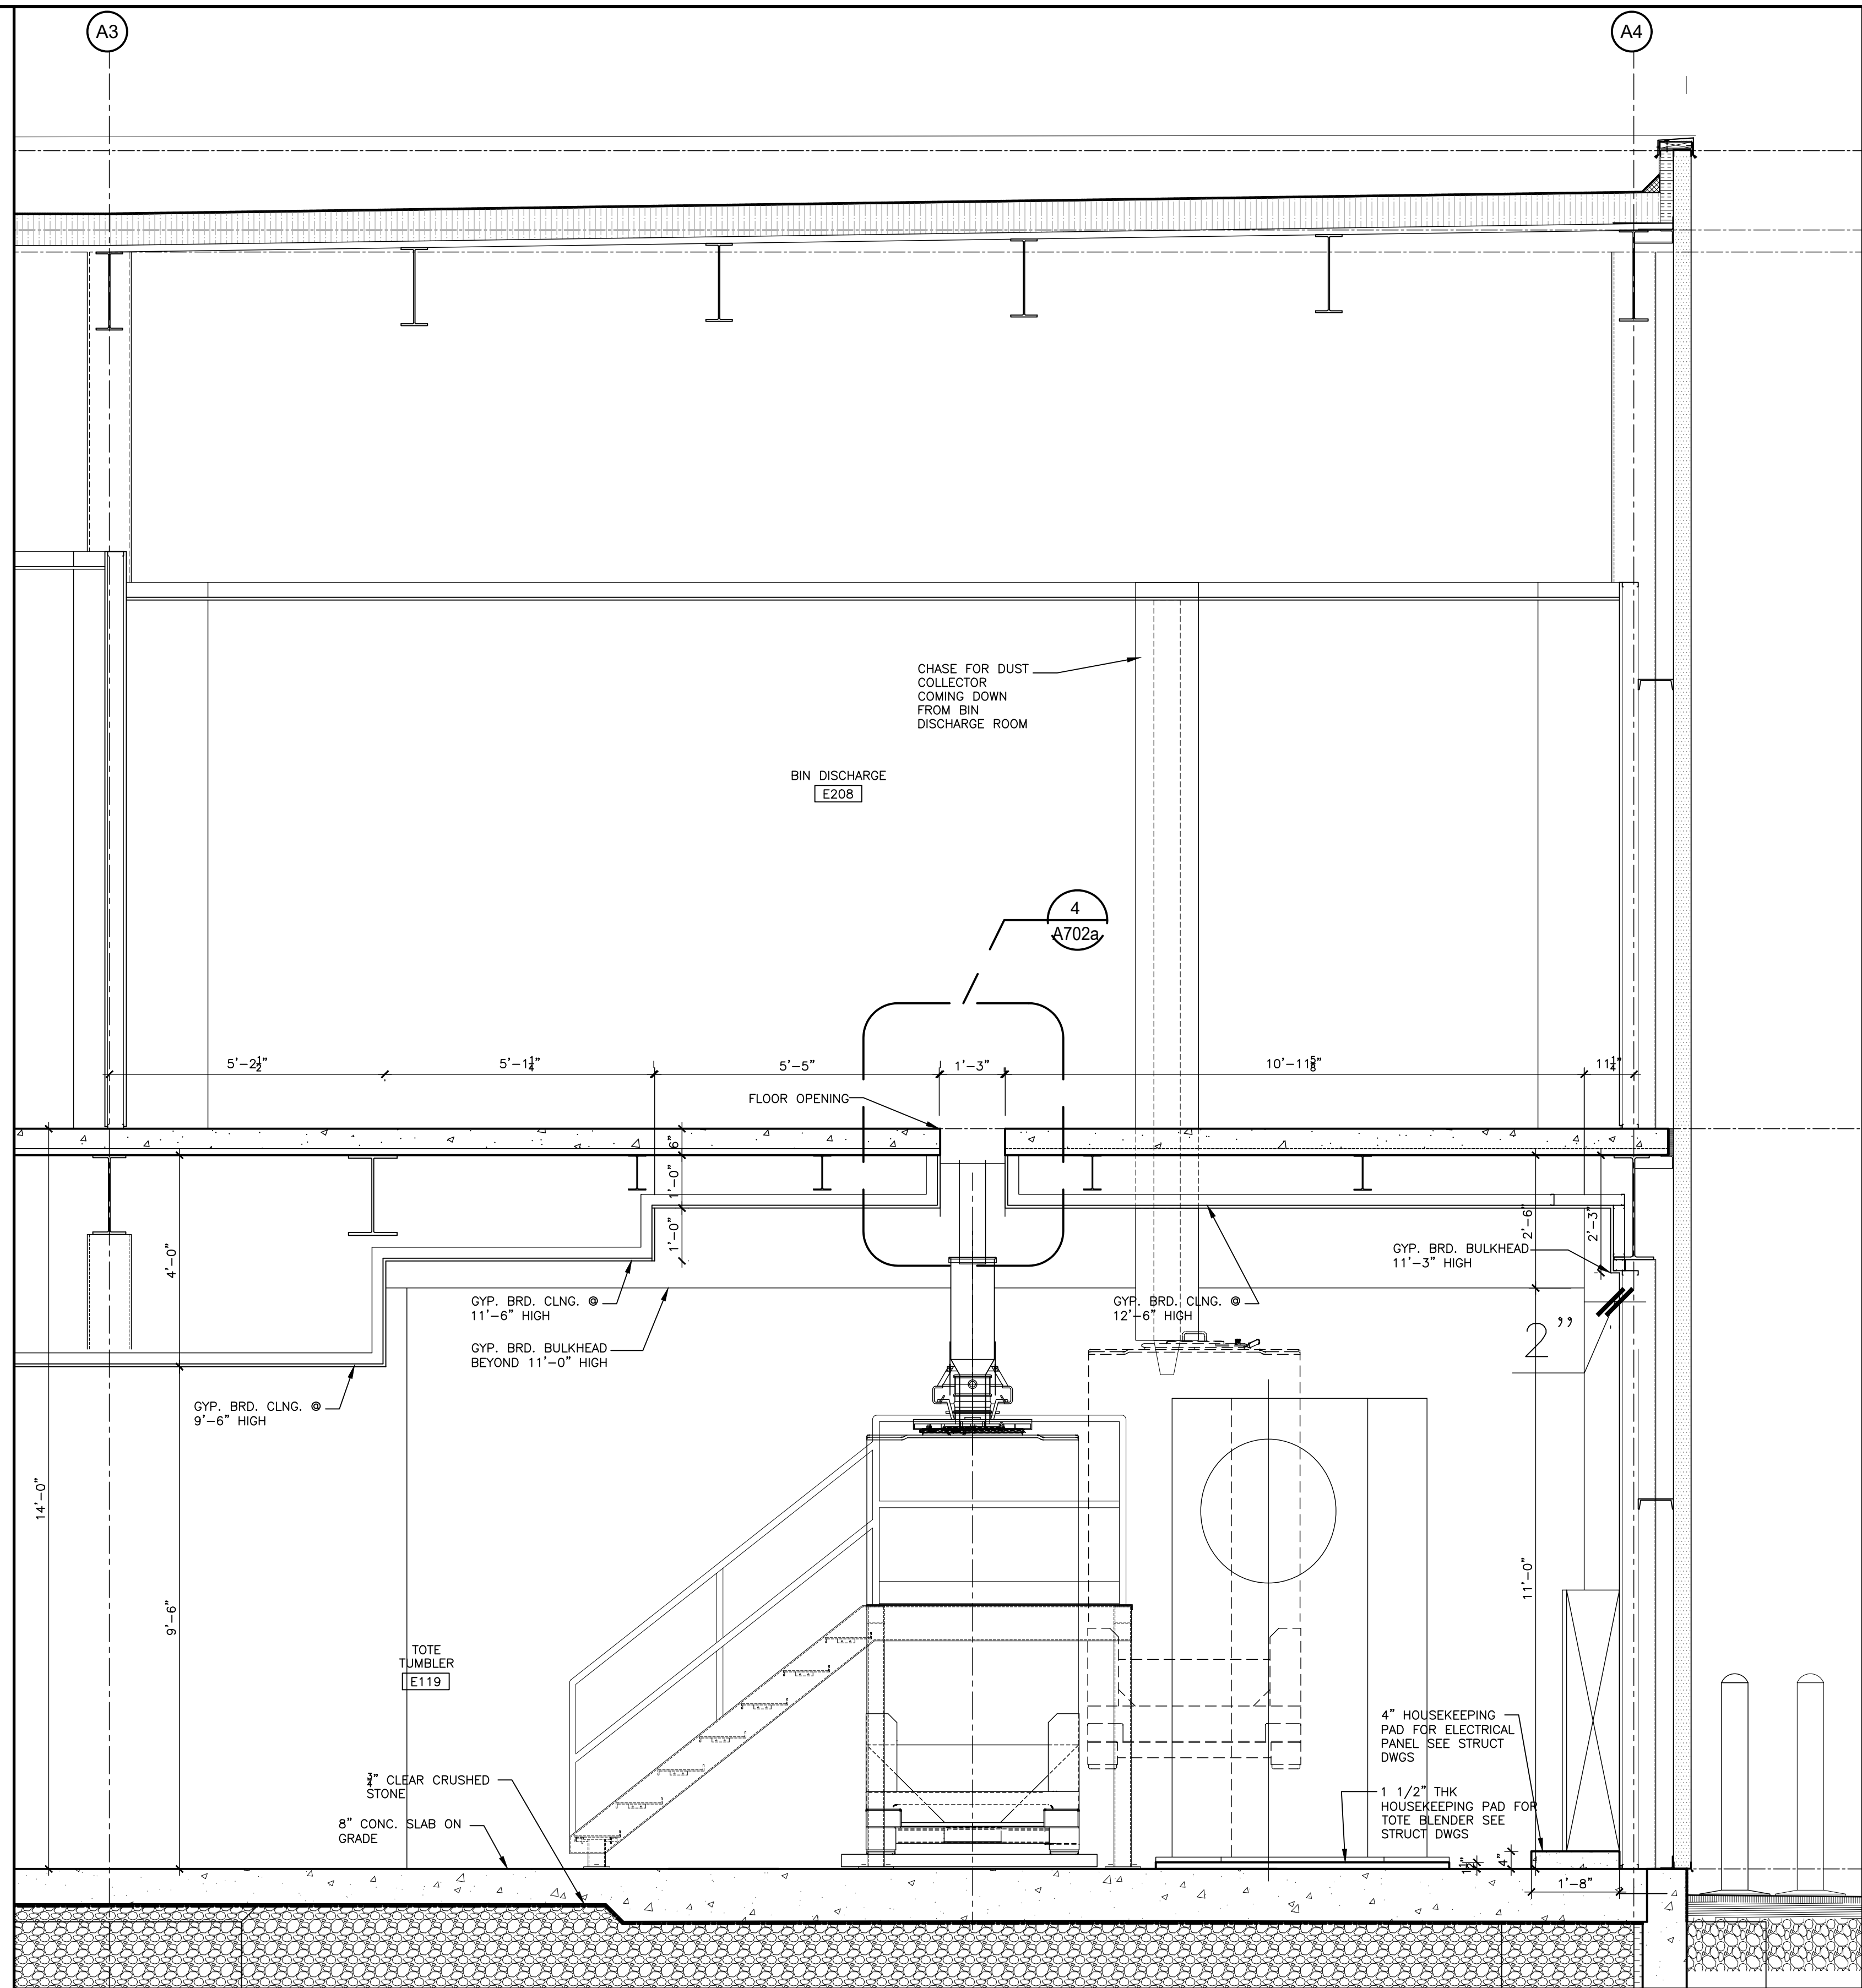


3 PARTIAL NEW BUILDING SECTION
@ TOTE TUMBLER (N-S)

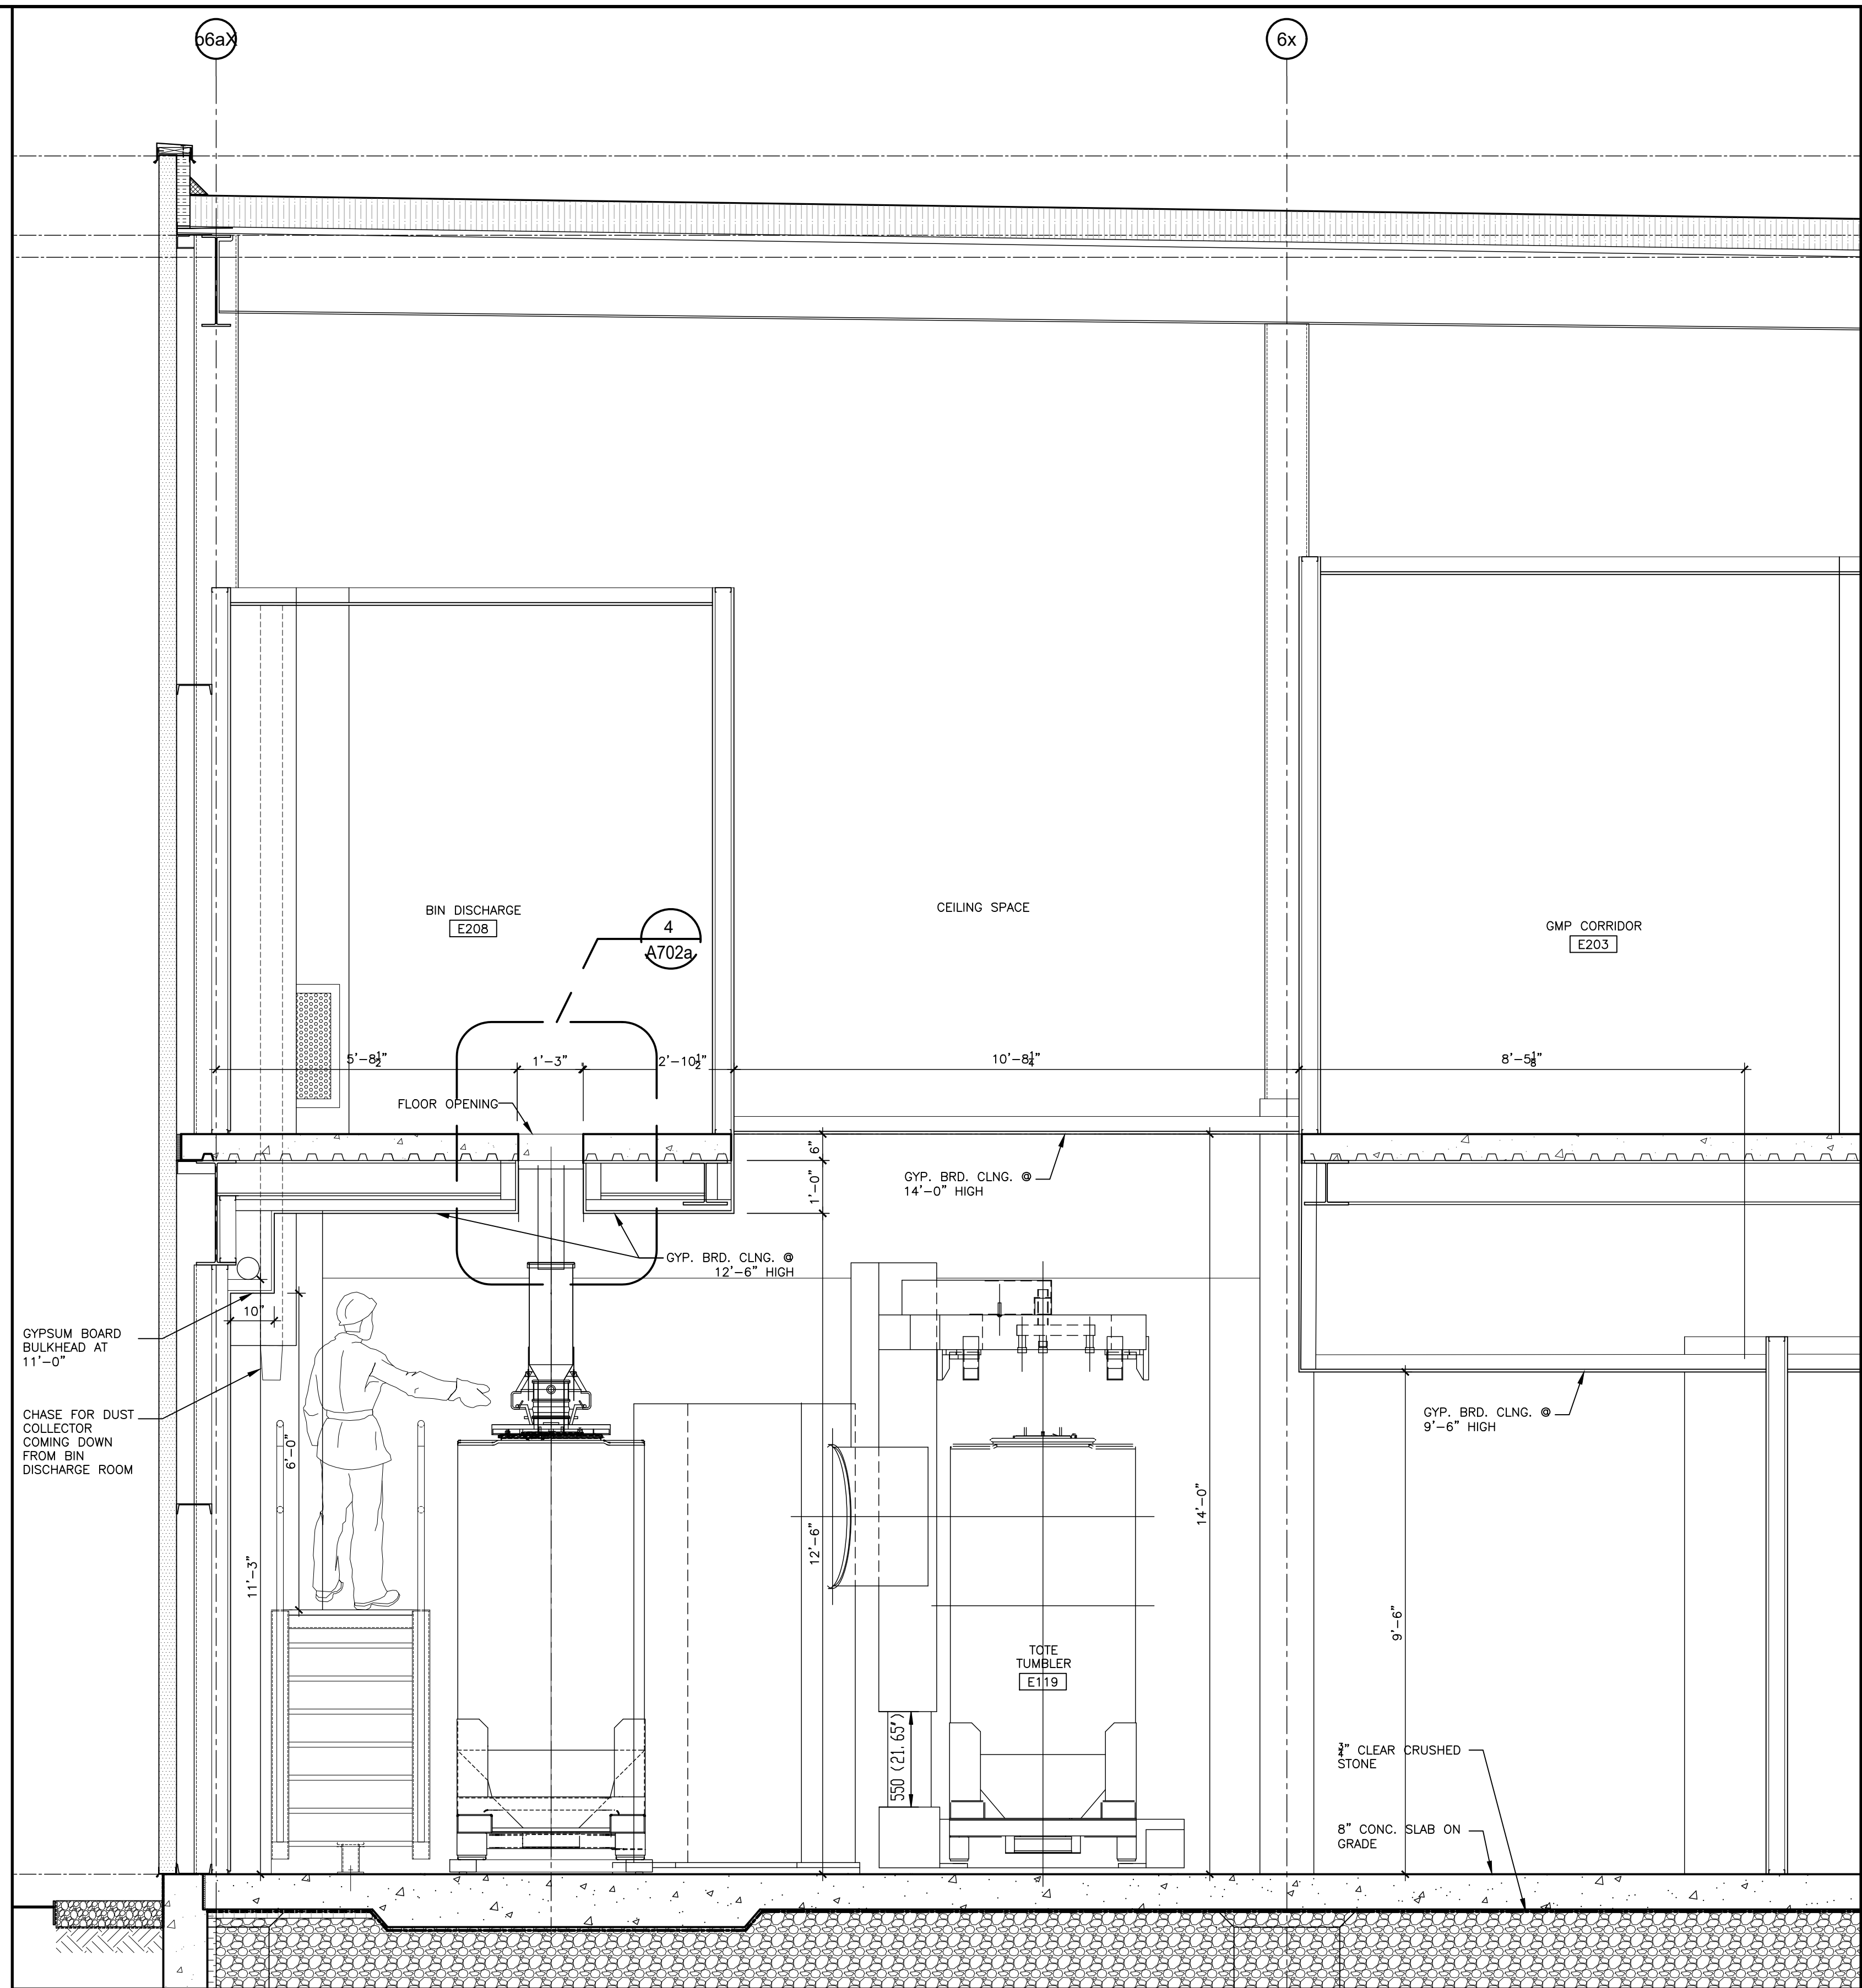

2 PARTIAL NEW BUILDING SECTION
@ TOTE TUMBLER (E-W)

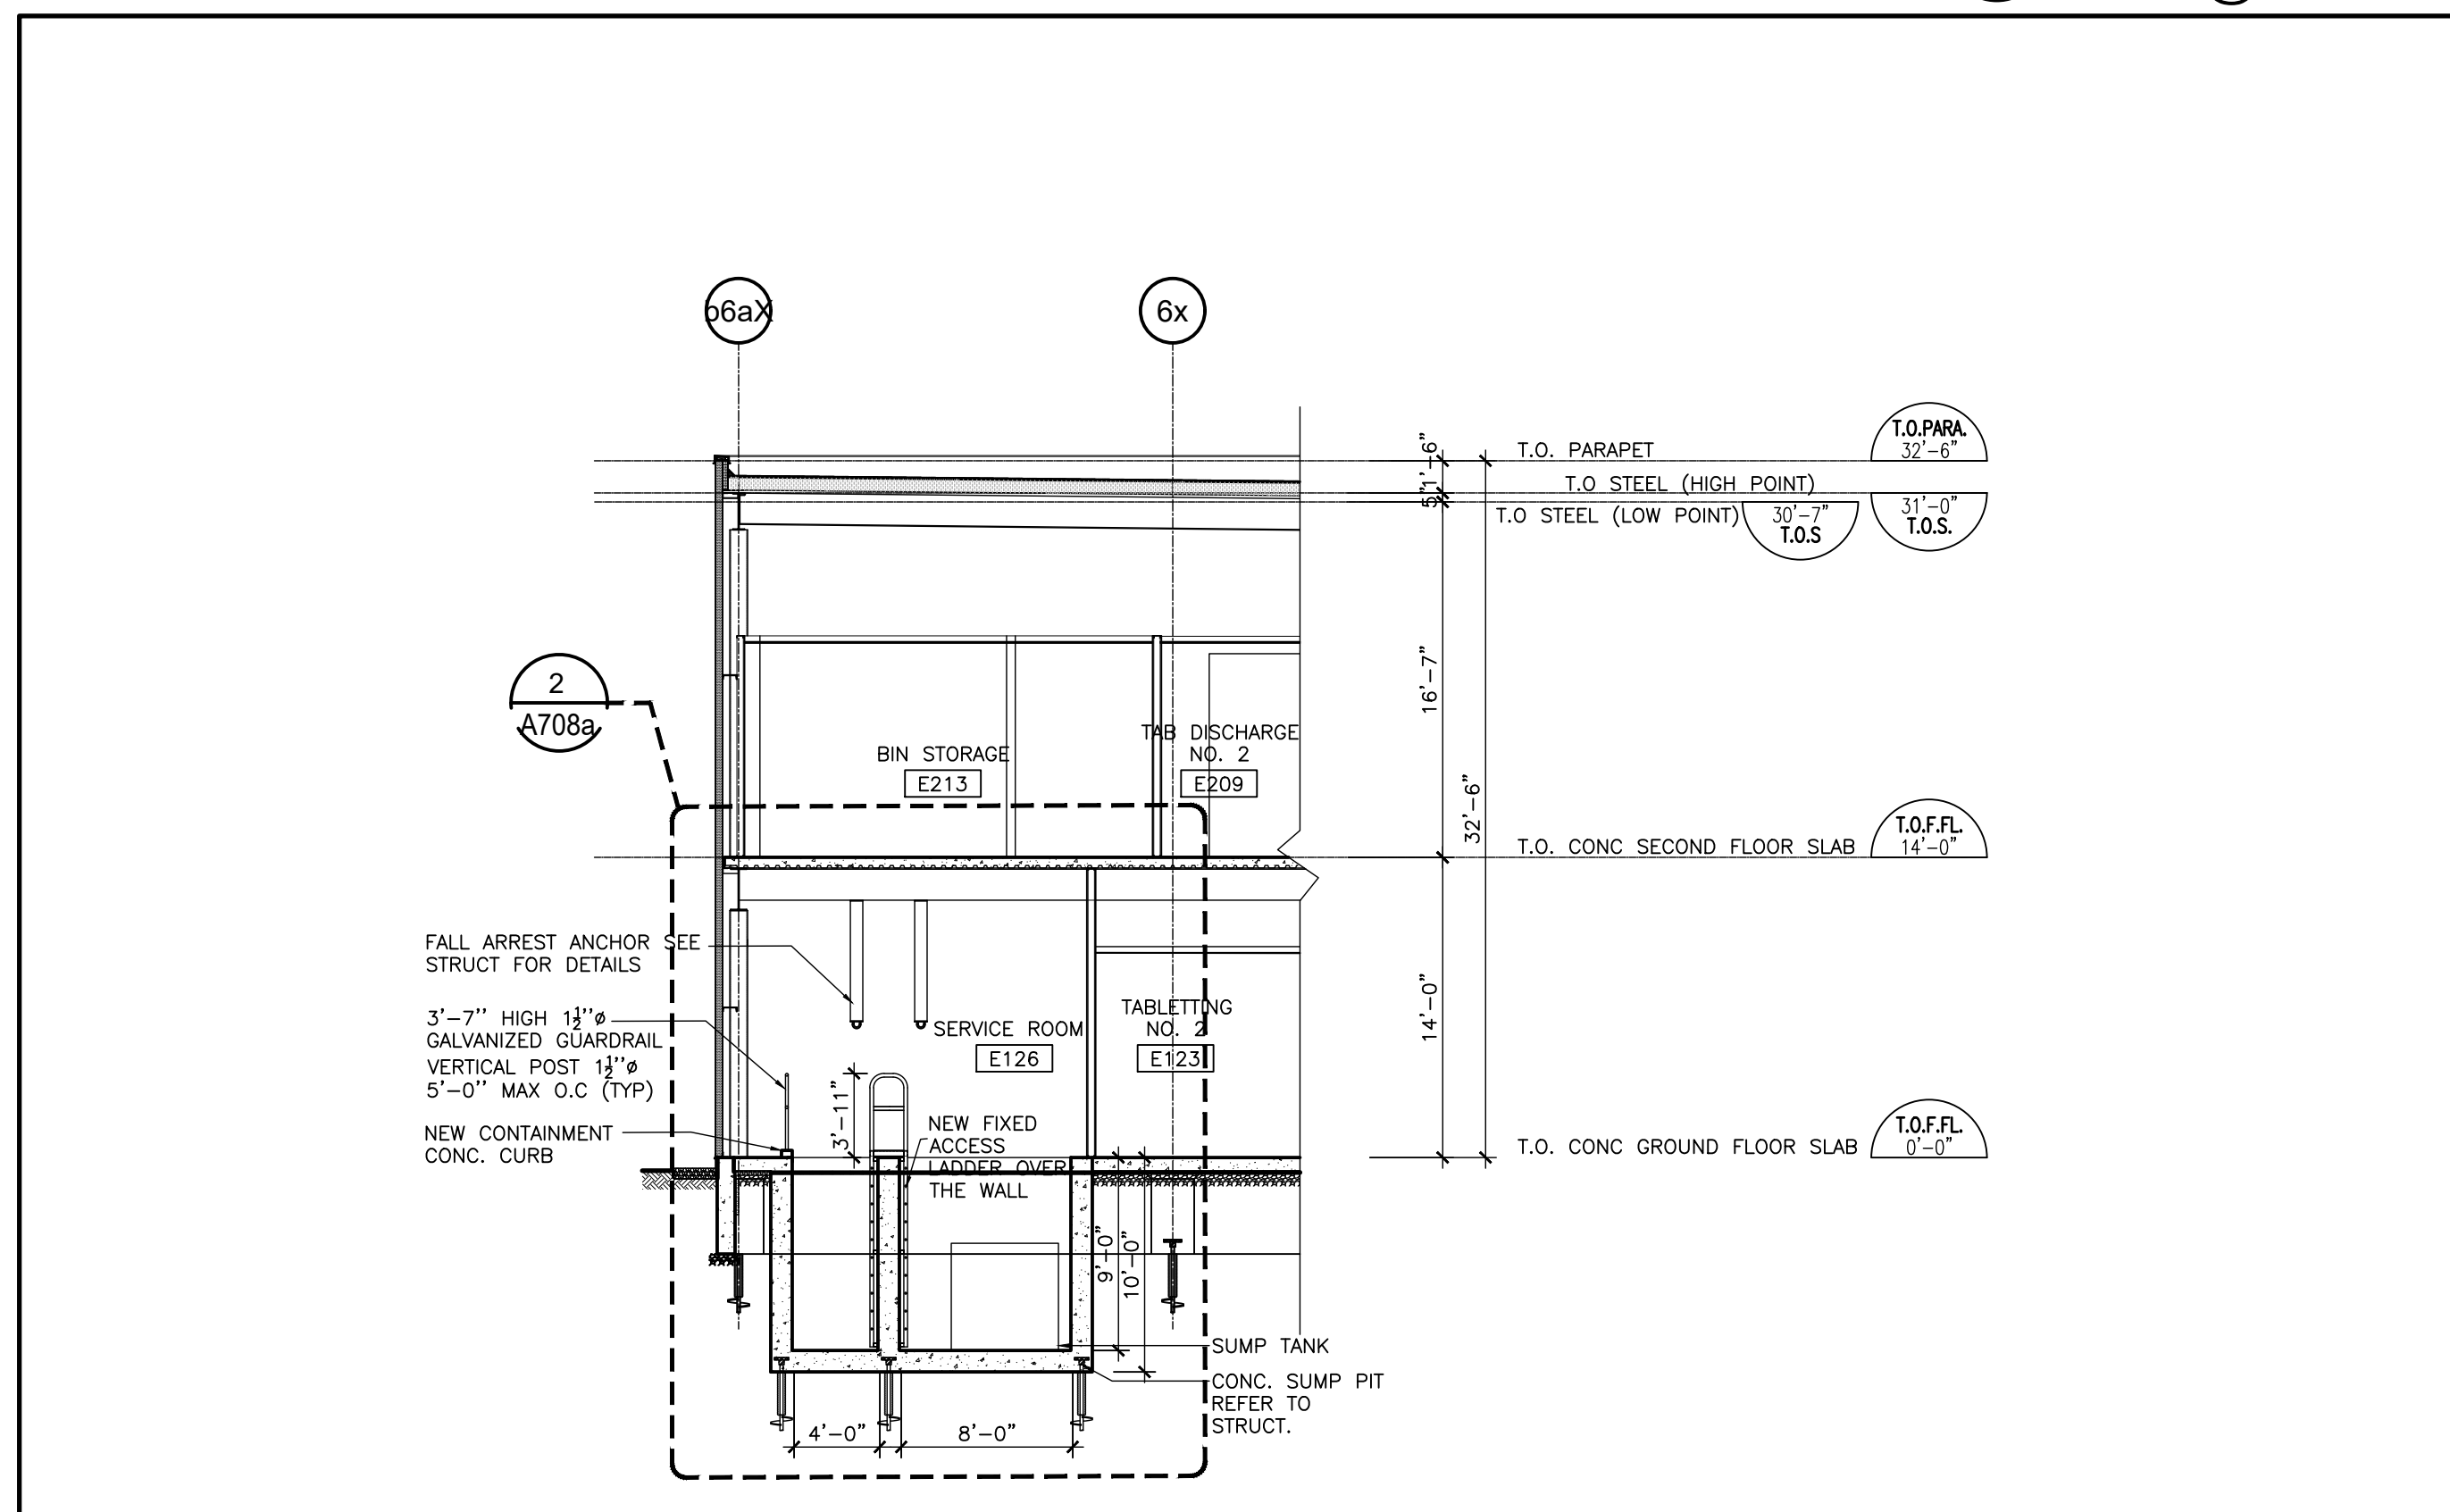

4 PARTIAL NEW BUILDING SECTION
EAST - WEST

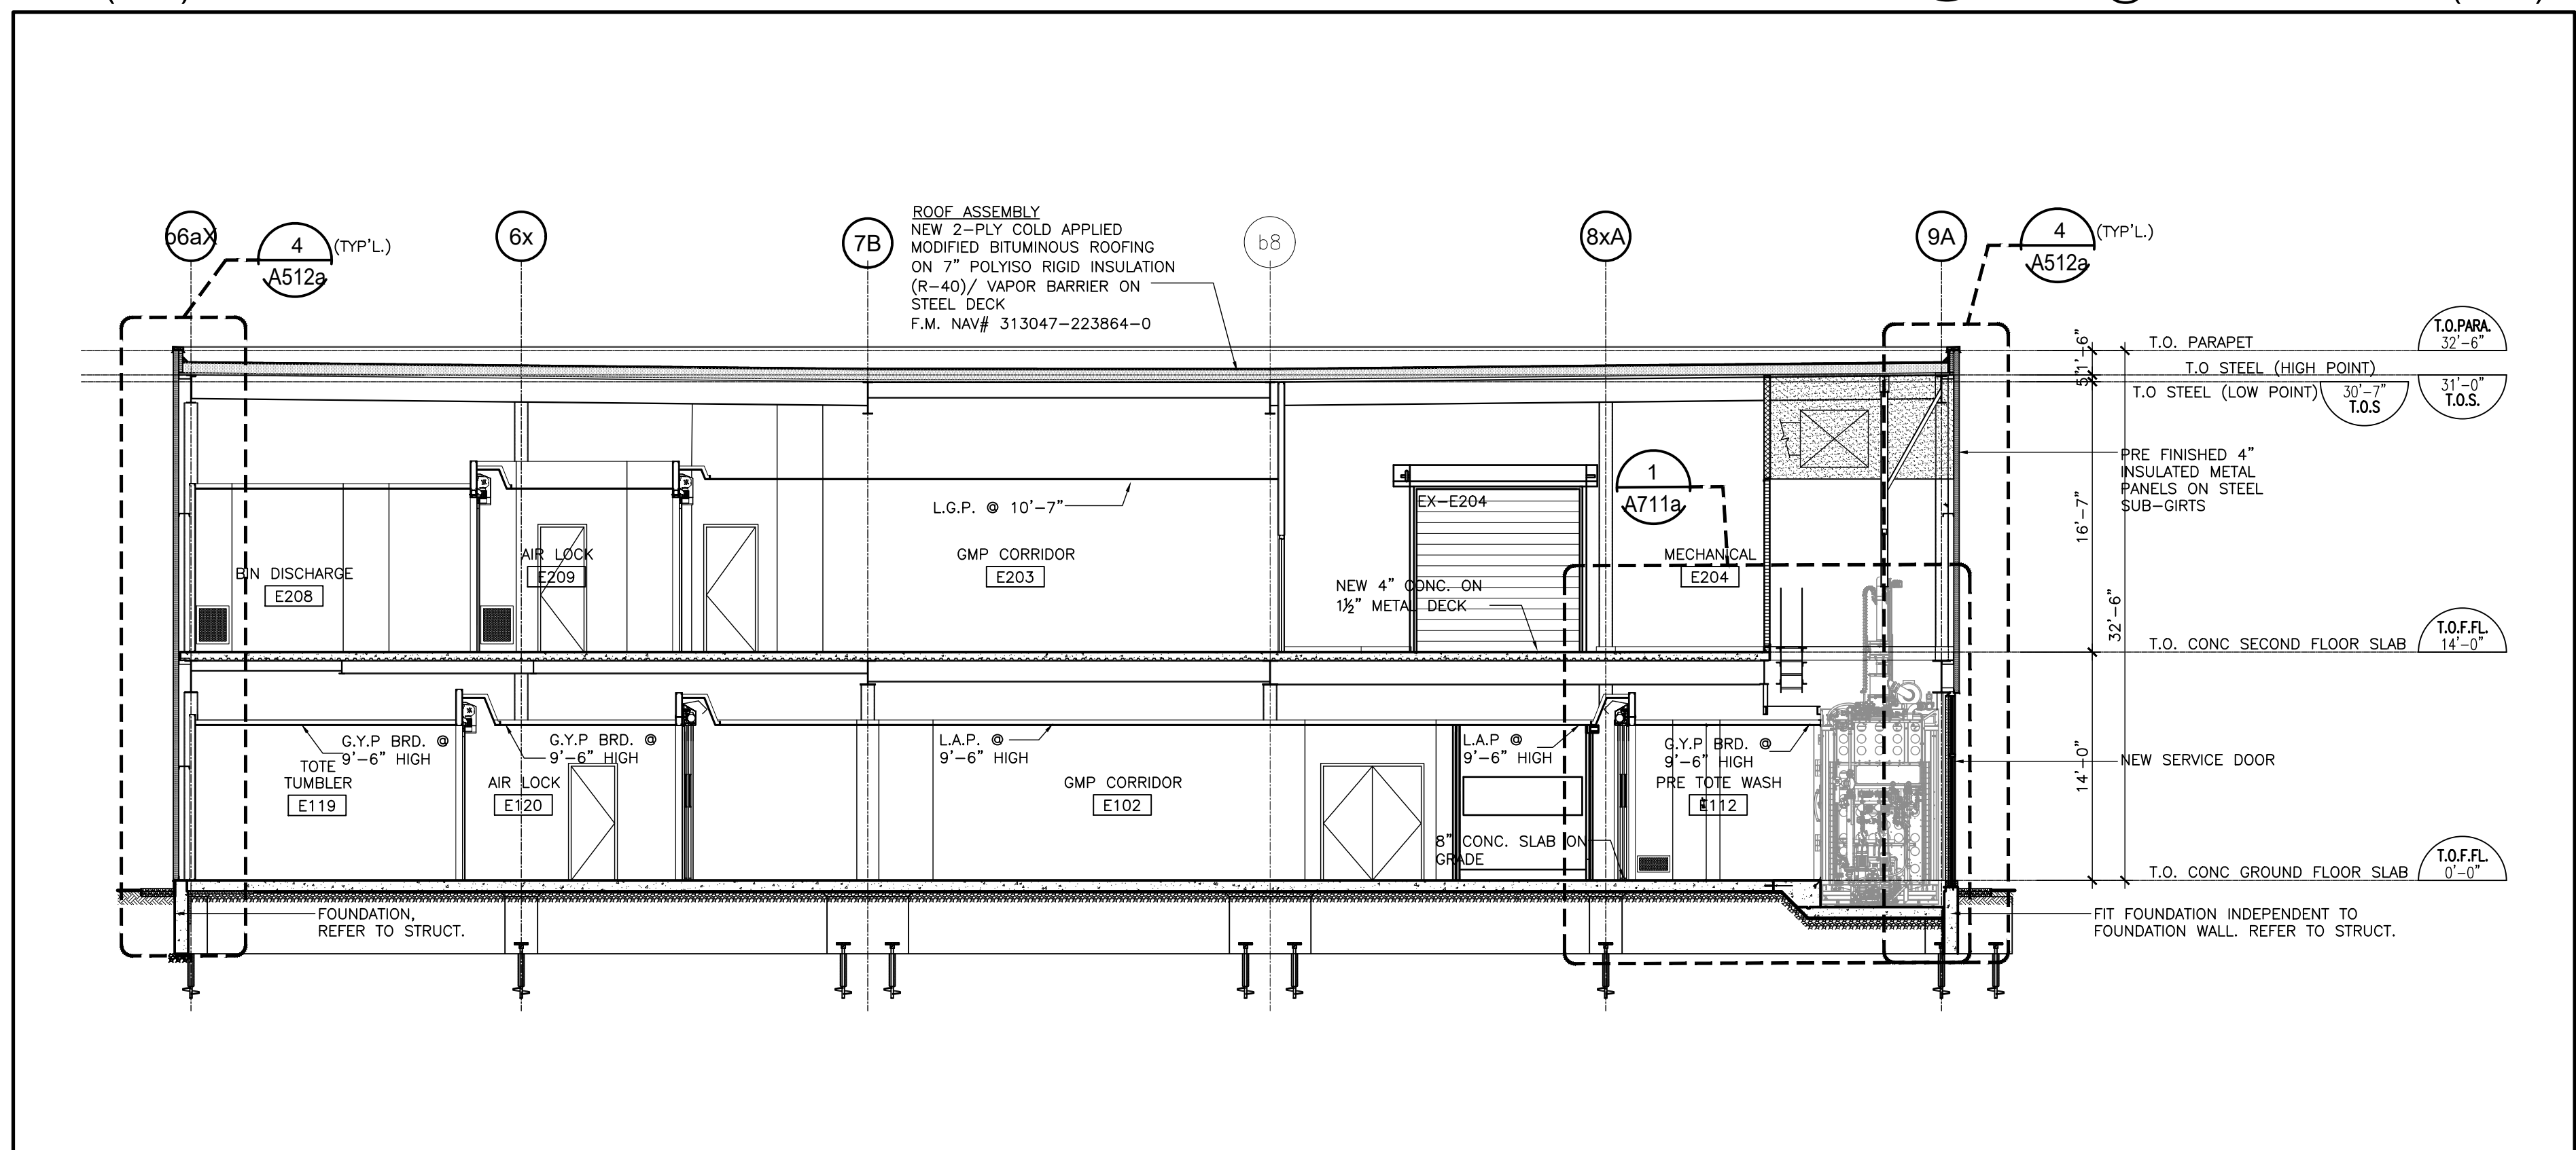

1 PARTIAL NEW BUILDING SECTION
EAST - WEST

NOTES


These drawings are the property of, and shall not be used or reproduced without the consent of WBA Architects and Engineers Inc. The Contractor shall check and verify all dimensions and report all discrepancies to the Architect and/or Engineer.

PROJECT NORTH

TRUE NORTH





No.	Date	Issued	By
A	2022-02-18	ISSUED FOR BUDGET ESTIMATE	WBA
B	2022-03-14	ISSUED FOR COORDINATION	WBA
C	2022-03-23	ISSUED FOR 75% DESIGN REVIEW	WBA
D	2022-04-06	ISSUED FOR 90% DESIGN REVIEW	WBA
E	2022-04-25	ISSUED FOR TENDER	WBA















No.	Date	Revision	By
6	2024-04-11	ISSUED FOR AS-BUILT	WBA
5	2023-08-23	ISSUED FOR CON #37	WBA
4.1	2023-03-16	ISSUED FOR CON #20 R1	WBA
4	2023-03-13	ISSUED FOR CON #20	WBA
3	2022-11-30	ISSUED FOR CON#05-R2	WBA
2	2022-11-10	SUMP PIT ADDED	WBA
1	2022-10-24	ISSUED FOR CON #4	WBA
7	2024-04-11	ISSUED FOR AS-BUILT	WBA

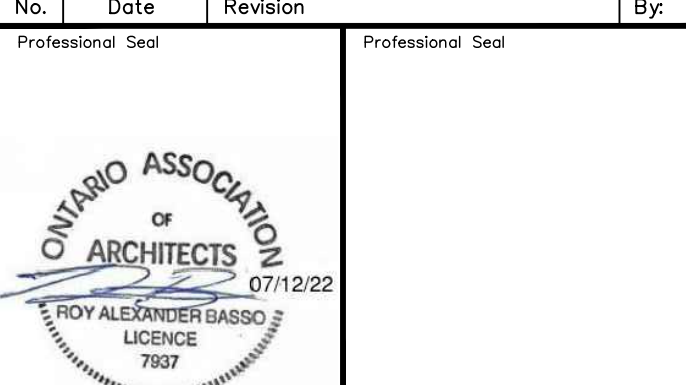

Consultant:
wba
architects and engineers Inc.
Client:
Johnson & Johnson
890 WOODLAWN ROAD WEST
GUELPH, ON

Project Title	PROJECT NASH
Drawing Title	NEW BUILDING SECTIONS PROCESS
CADD System	AUTOCAD 2016
Drawn By	R.R.
Checked By	G.S.S.
Project No.	2210711
Plot Scale	1:1
Date	OCT/2021
Drawing Scale	AS NOTED
Rev.	7
Sheet Size	30" x 42"
Rev.	7
Project No.	2210711
Rev.	7
Project No.	2210711
Rev.	7

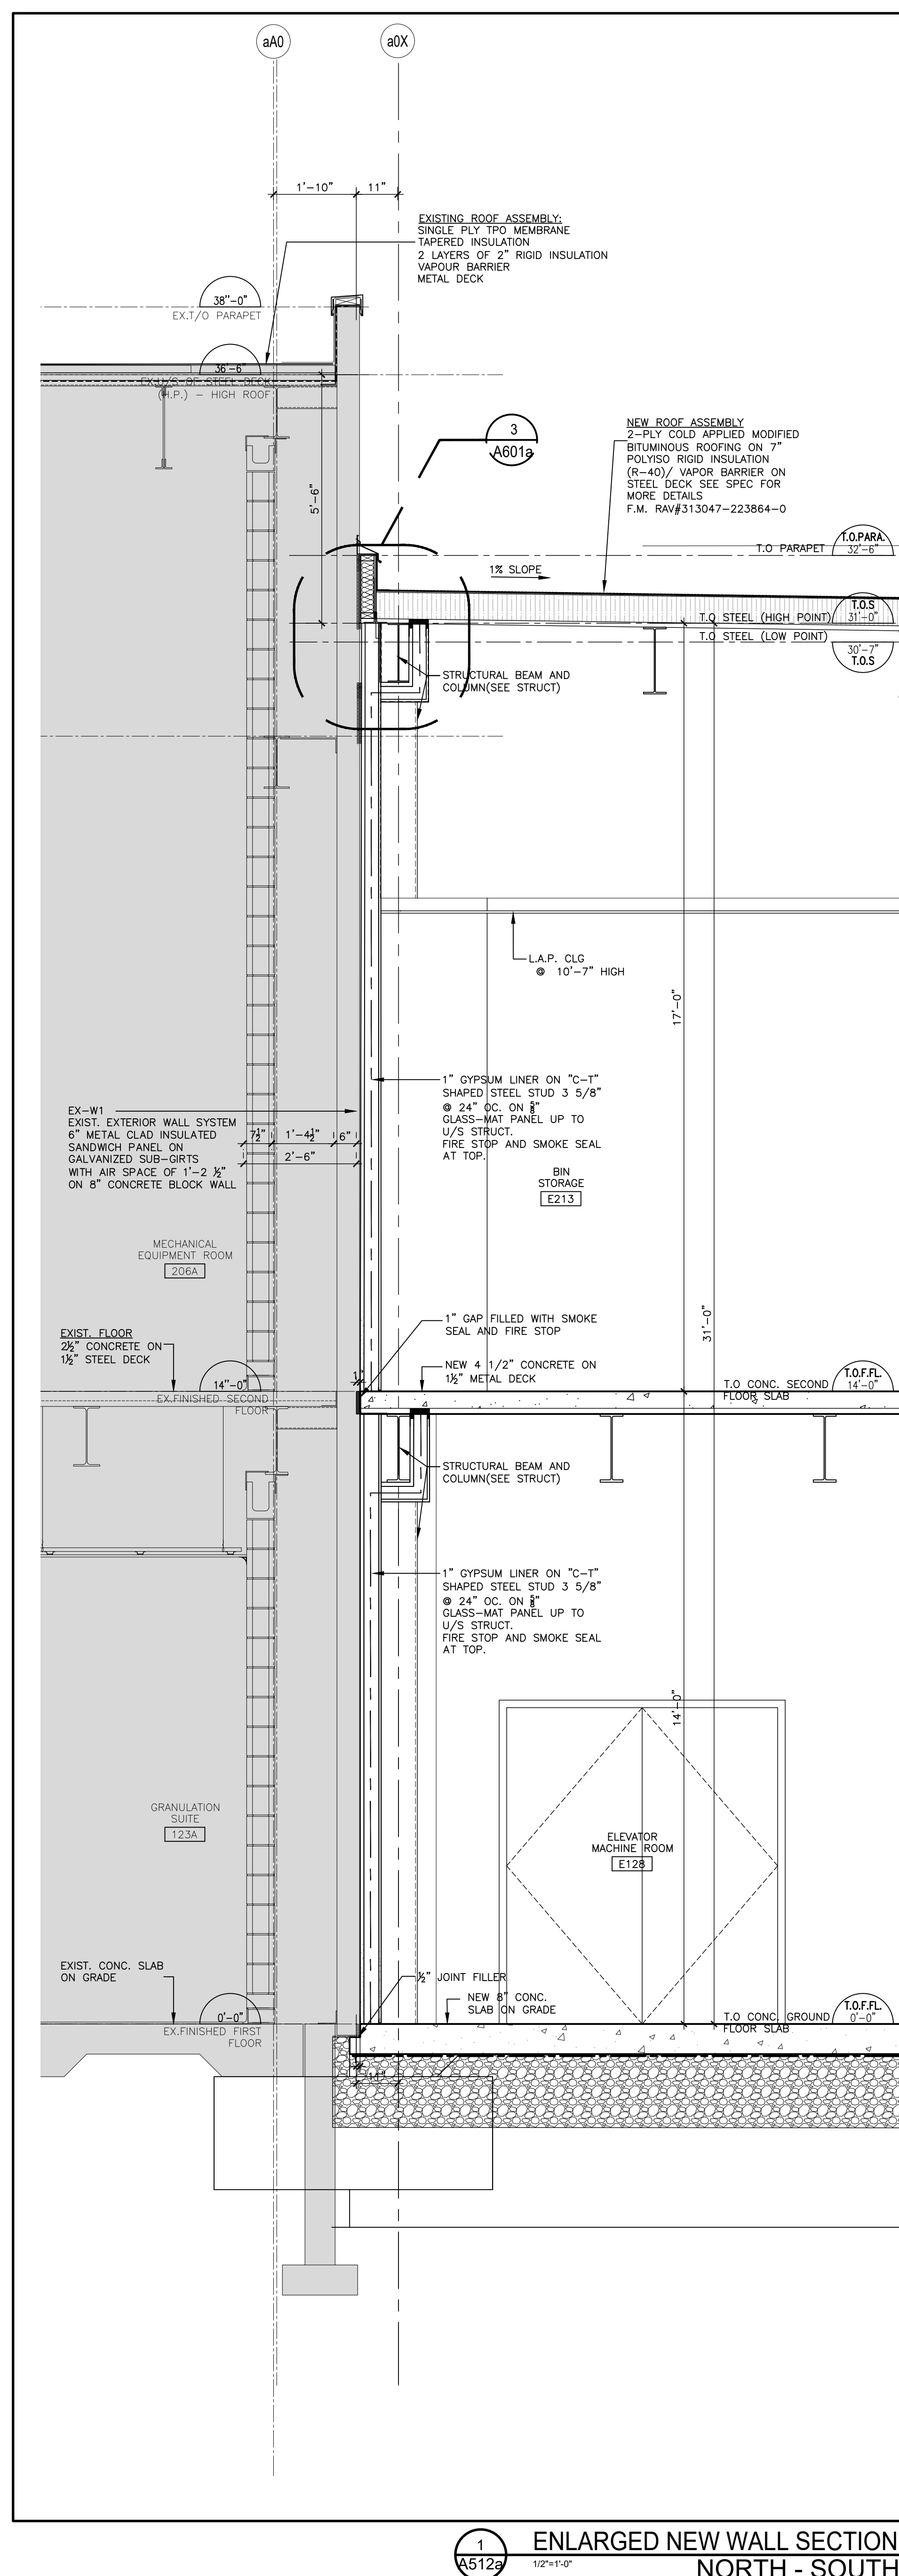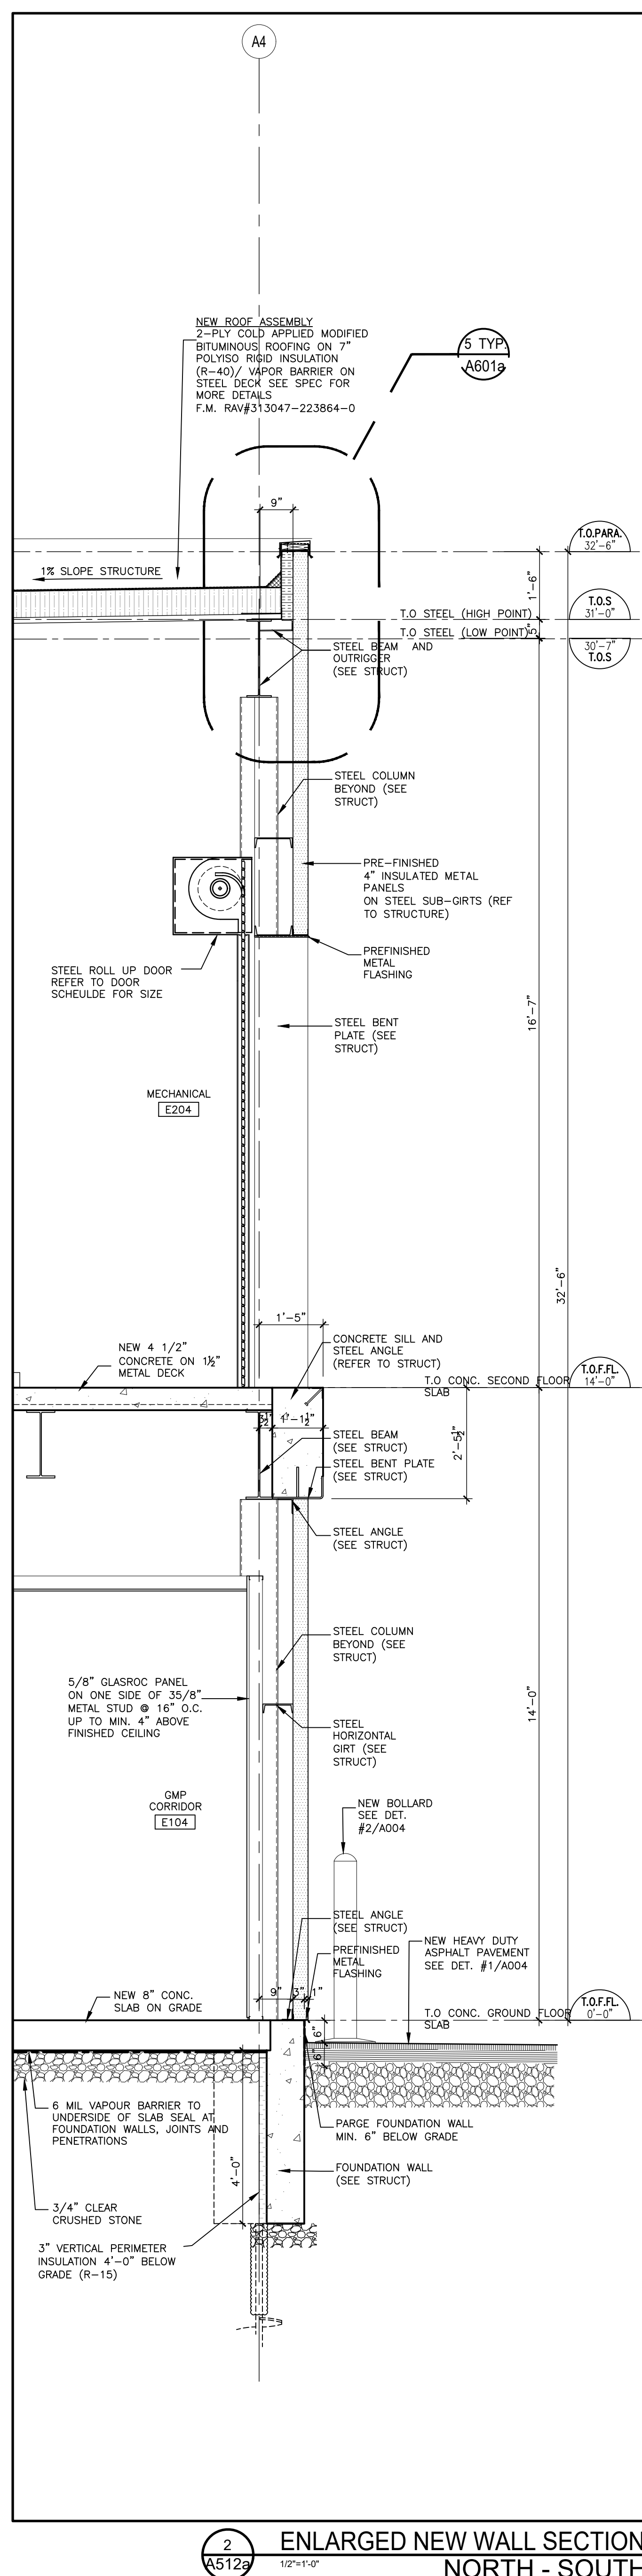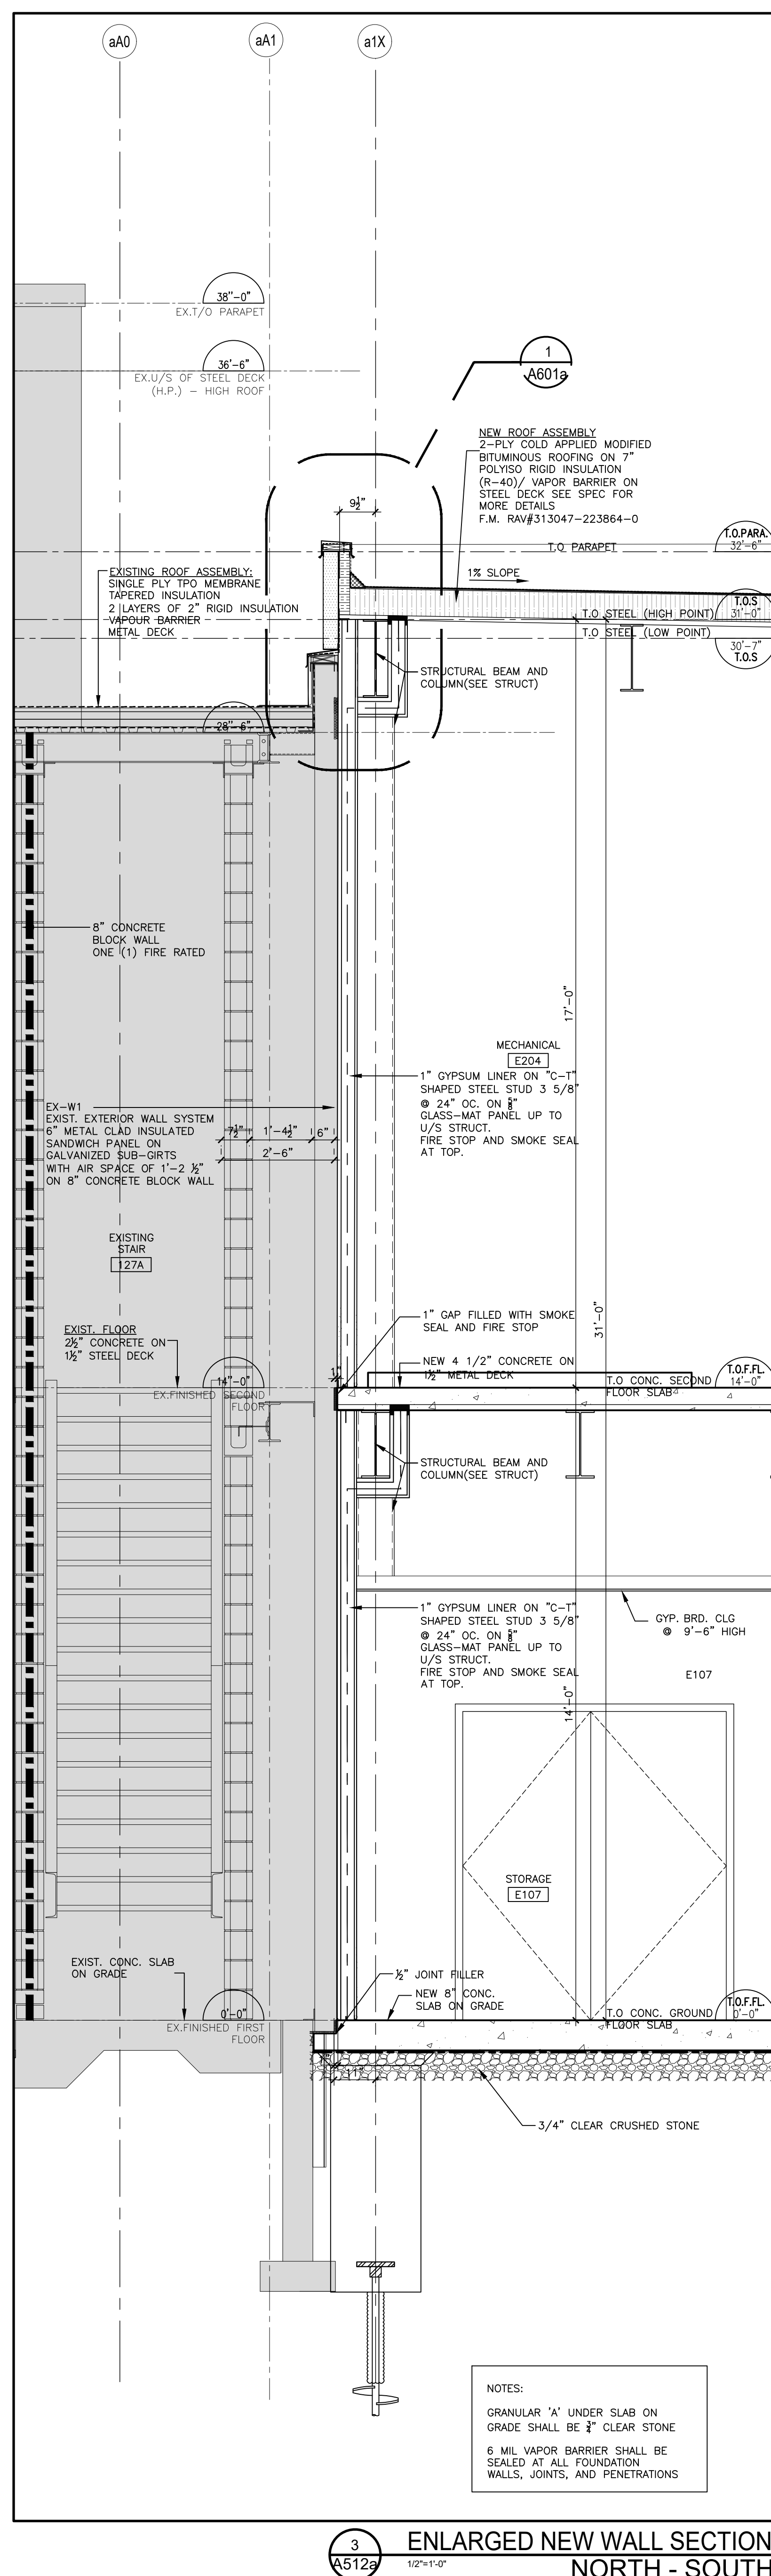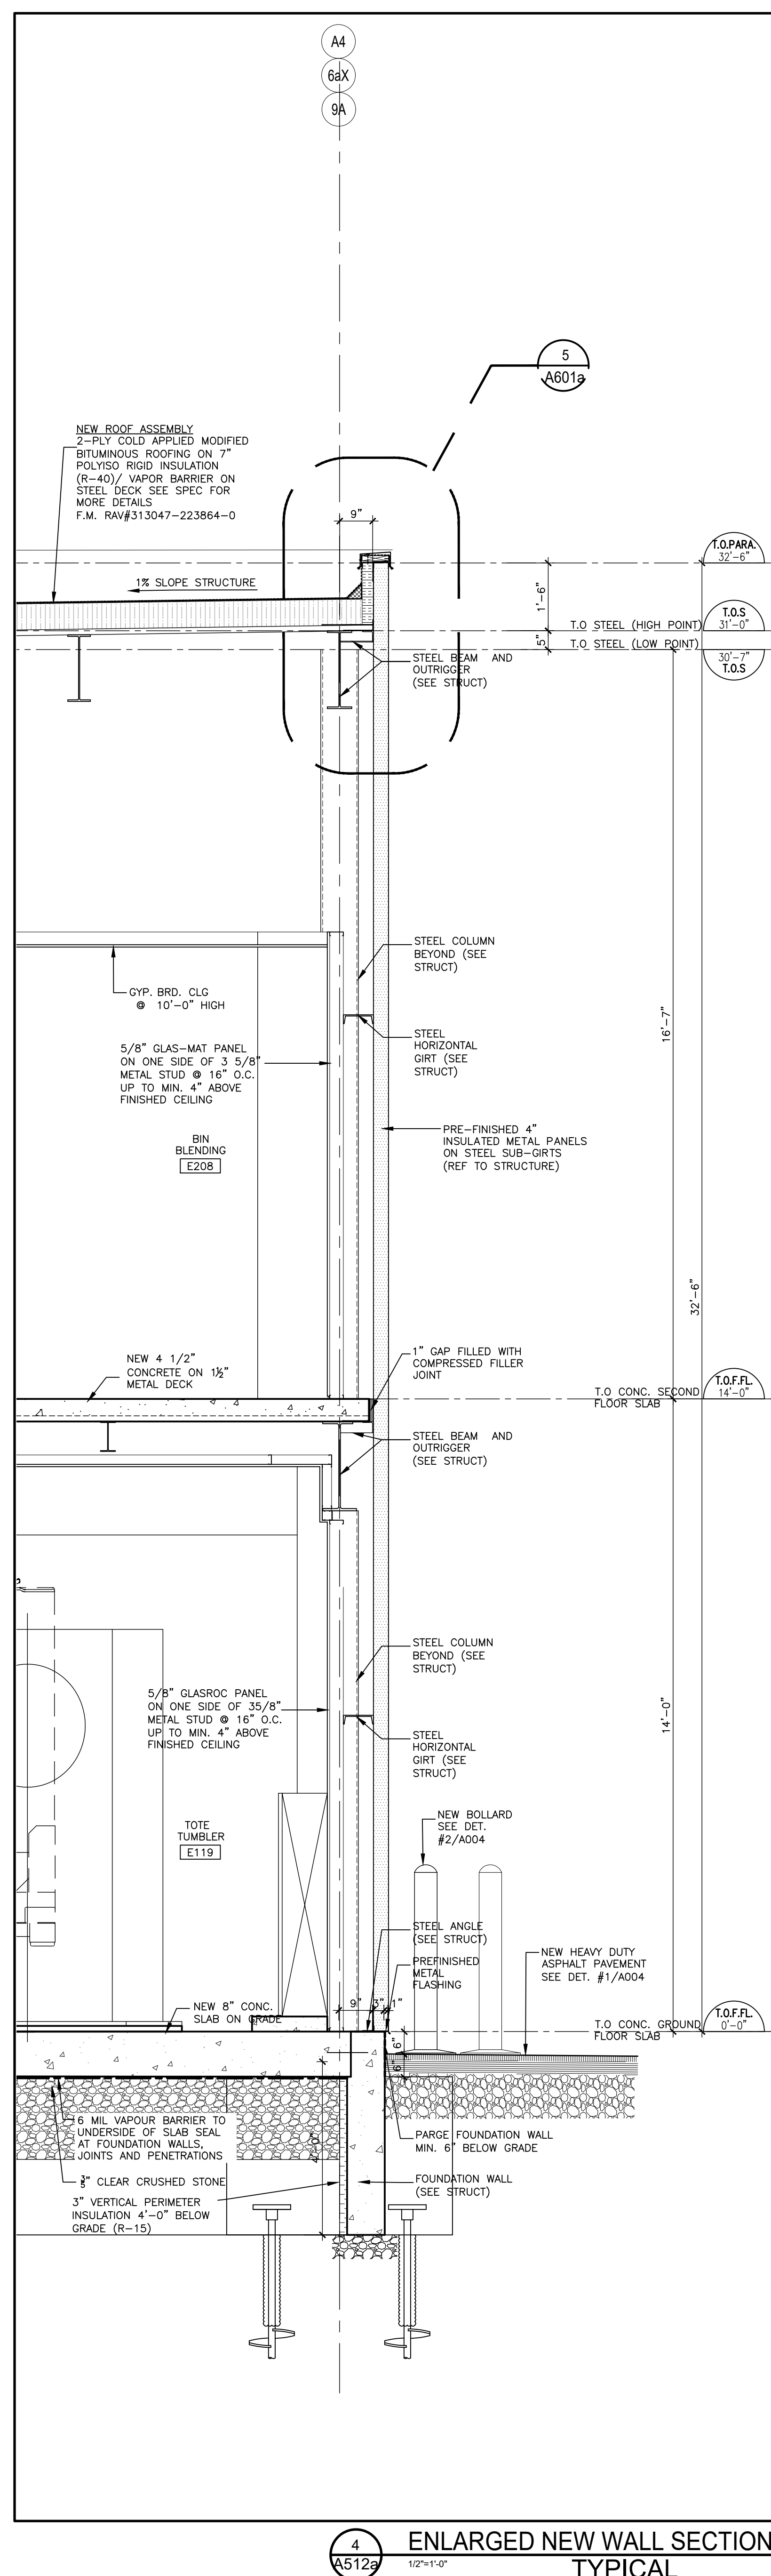[illegible]

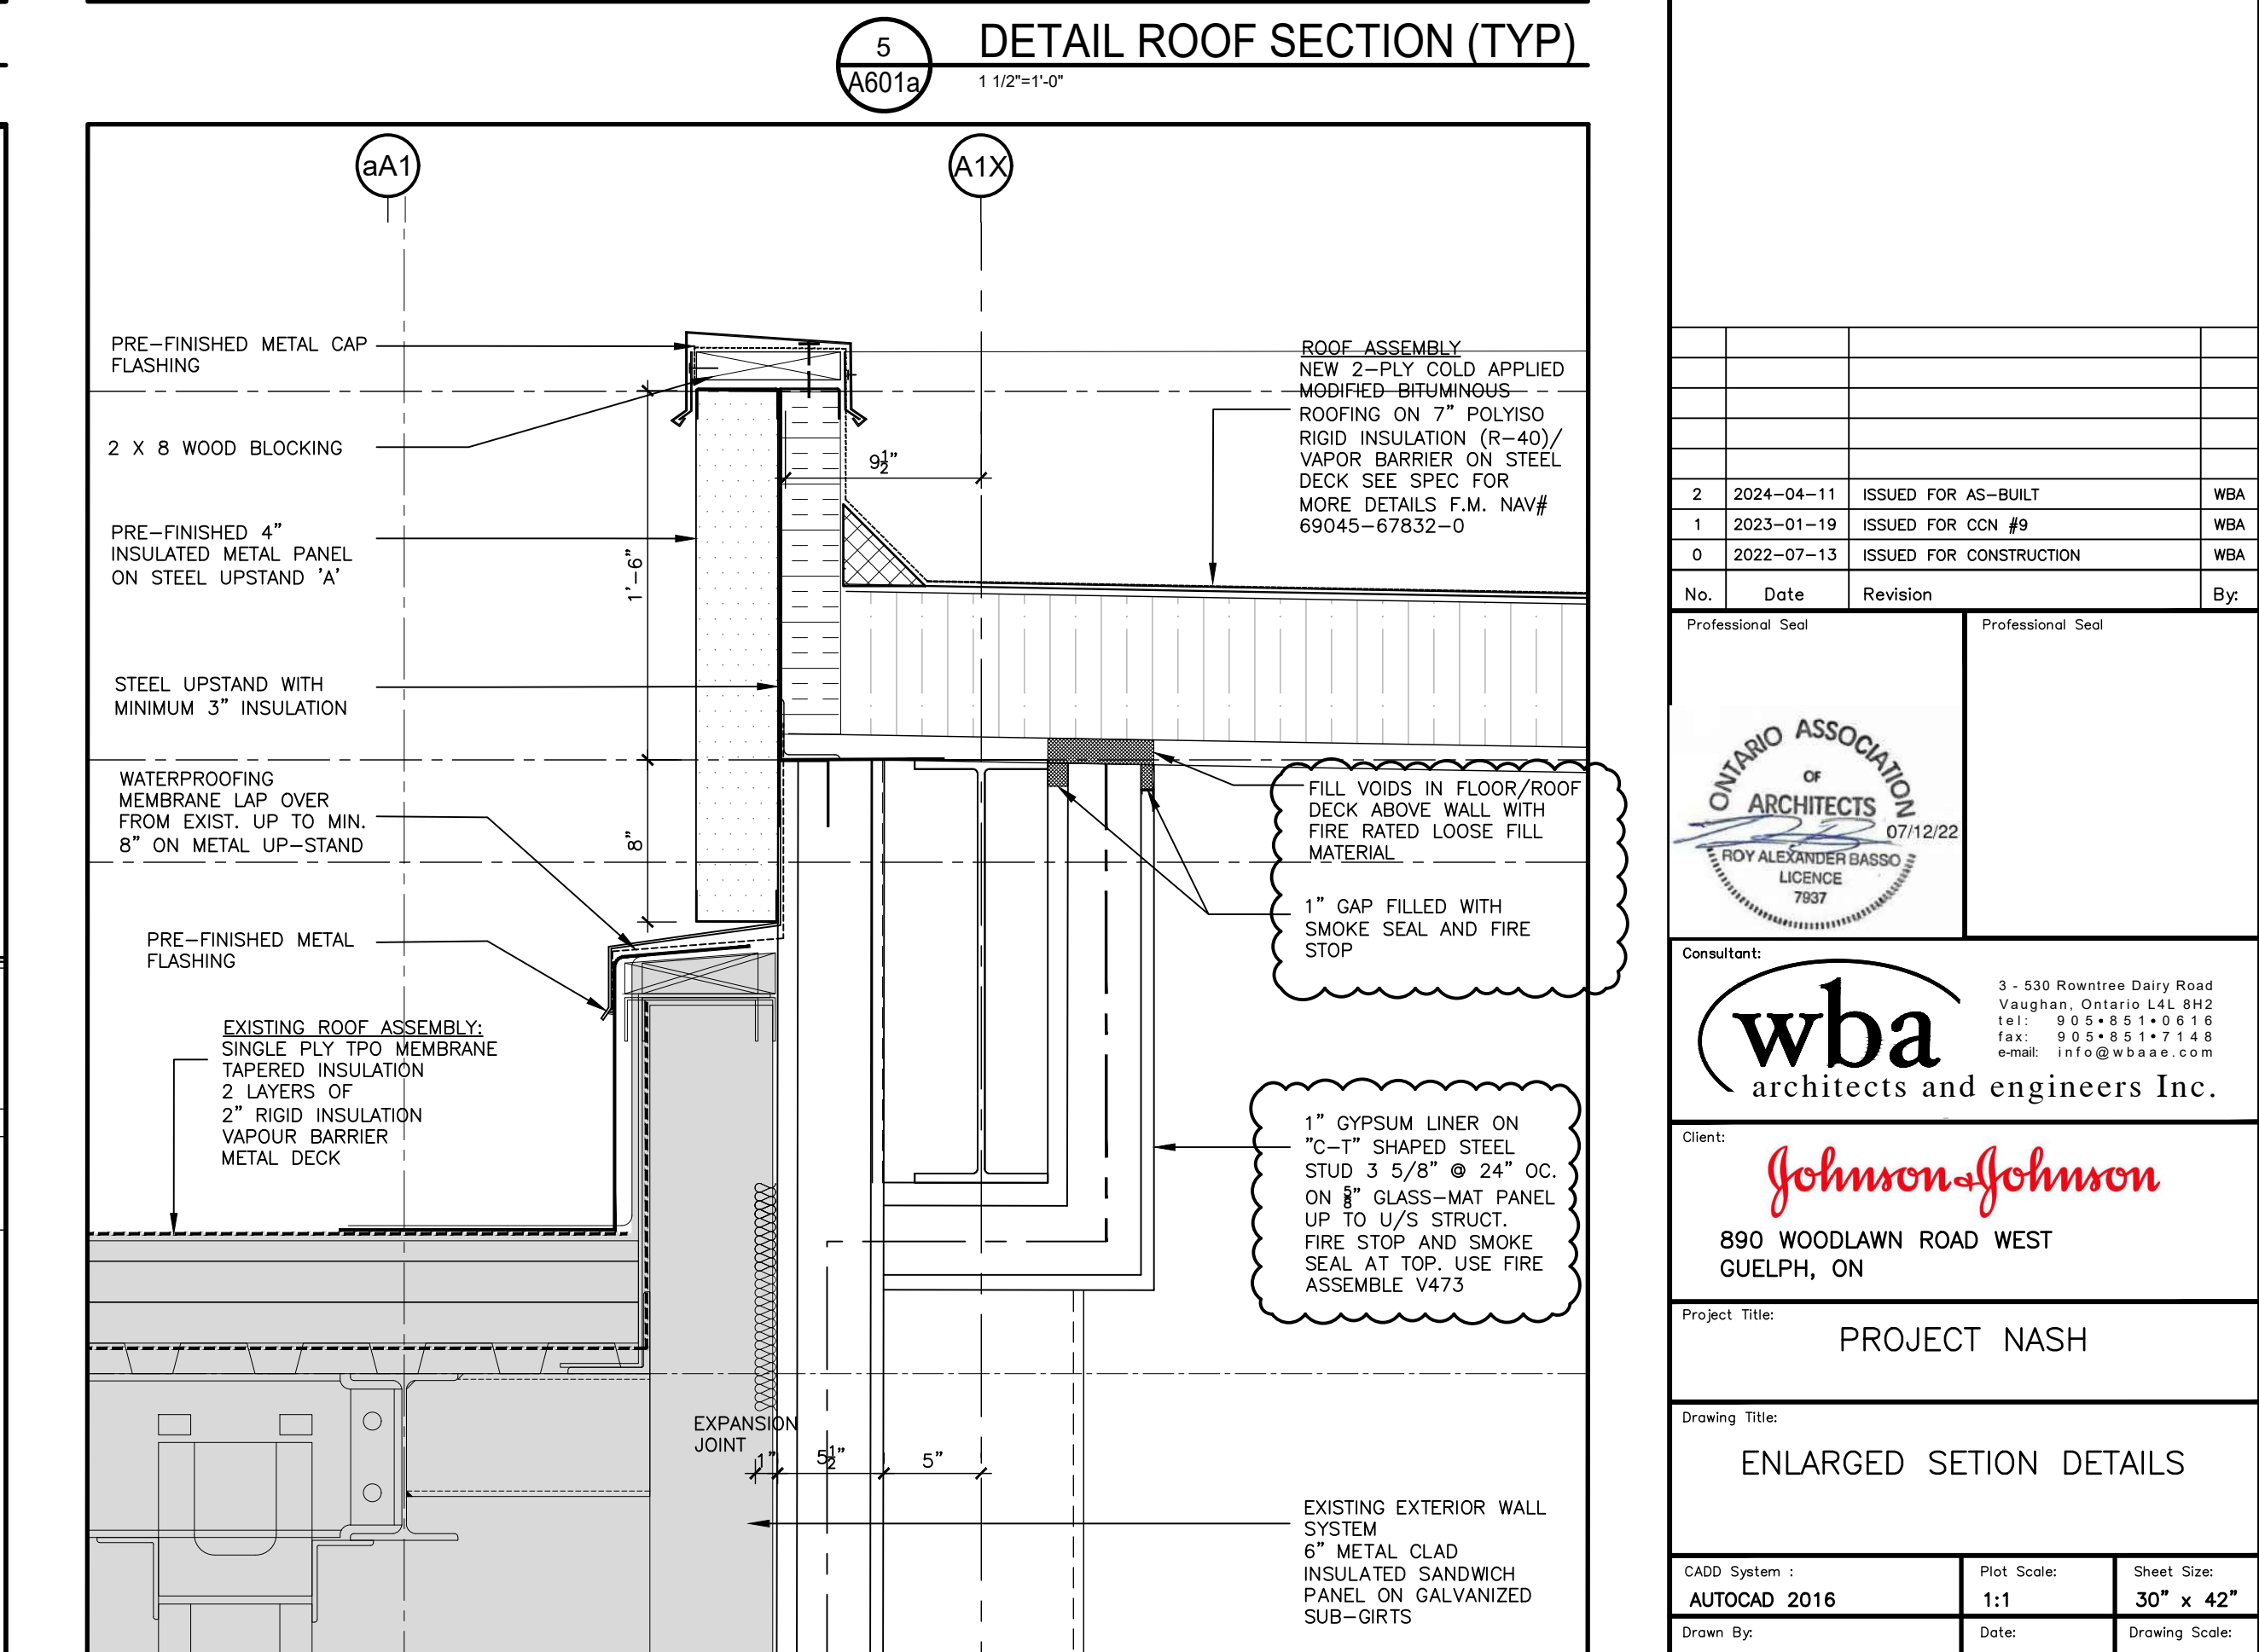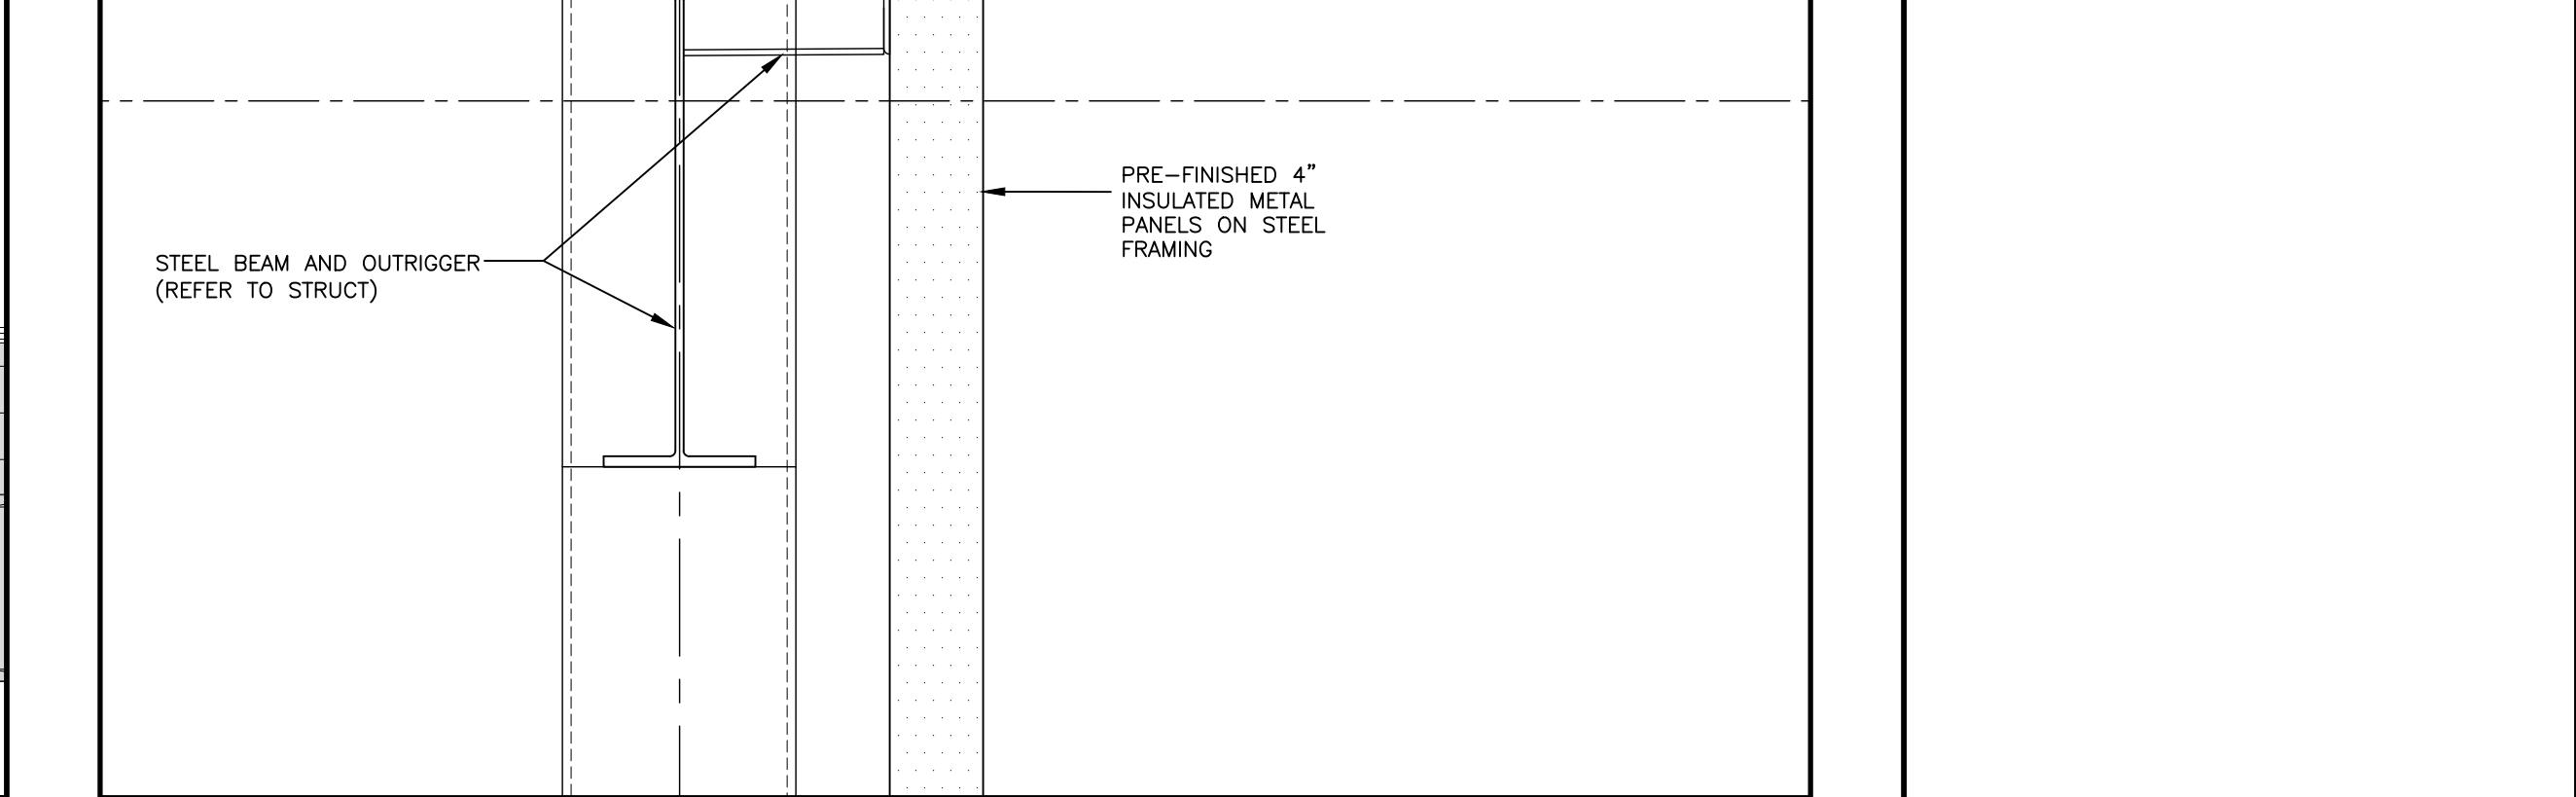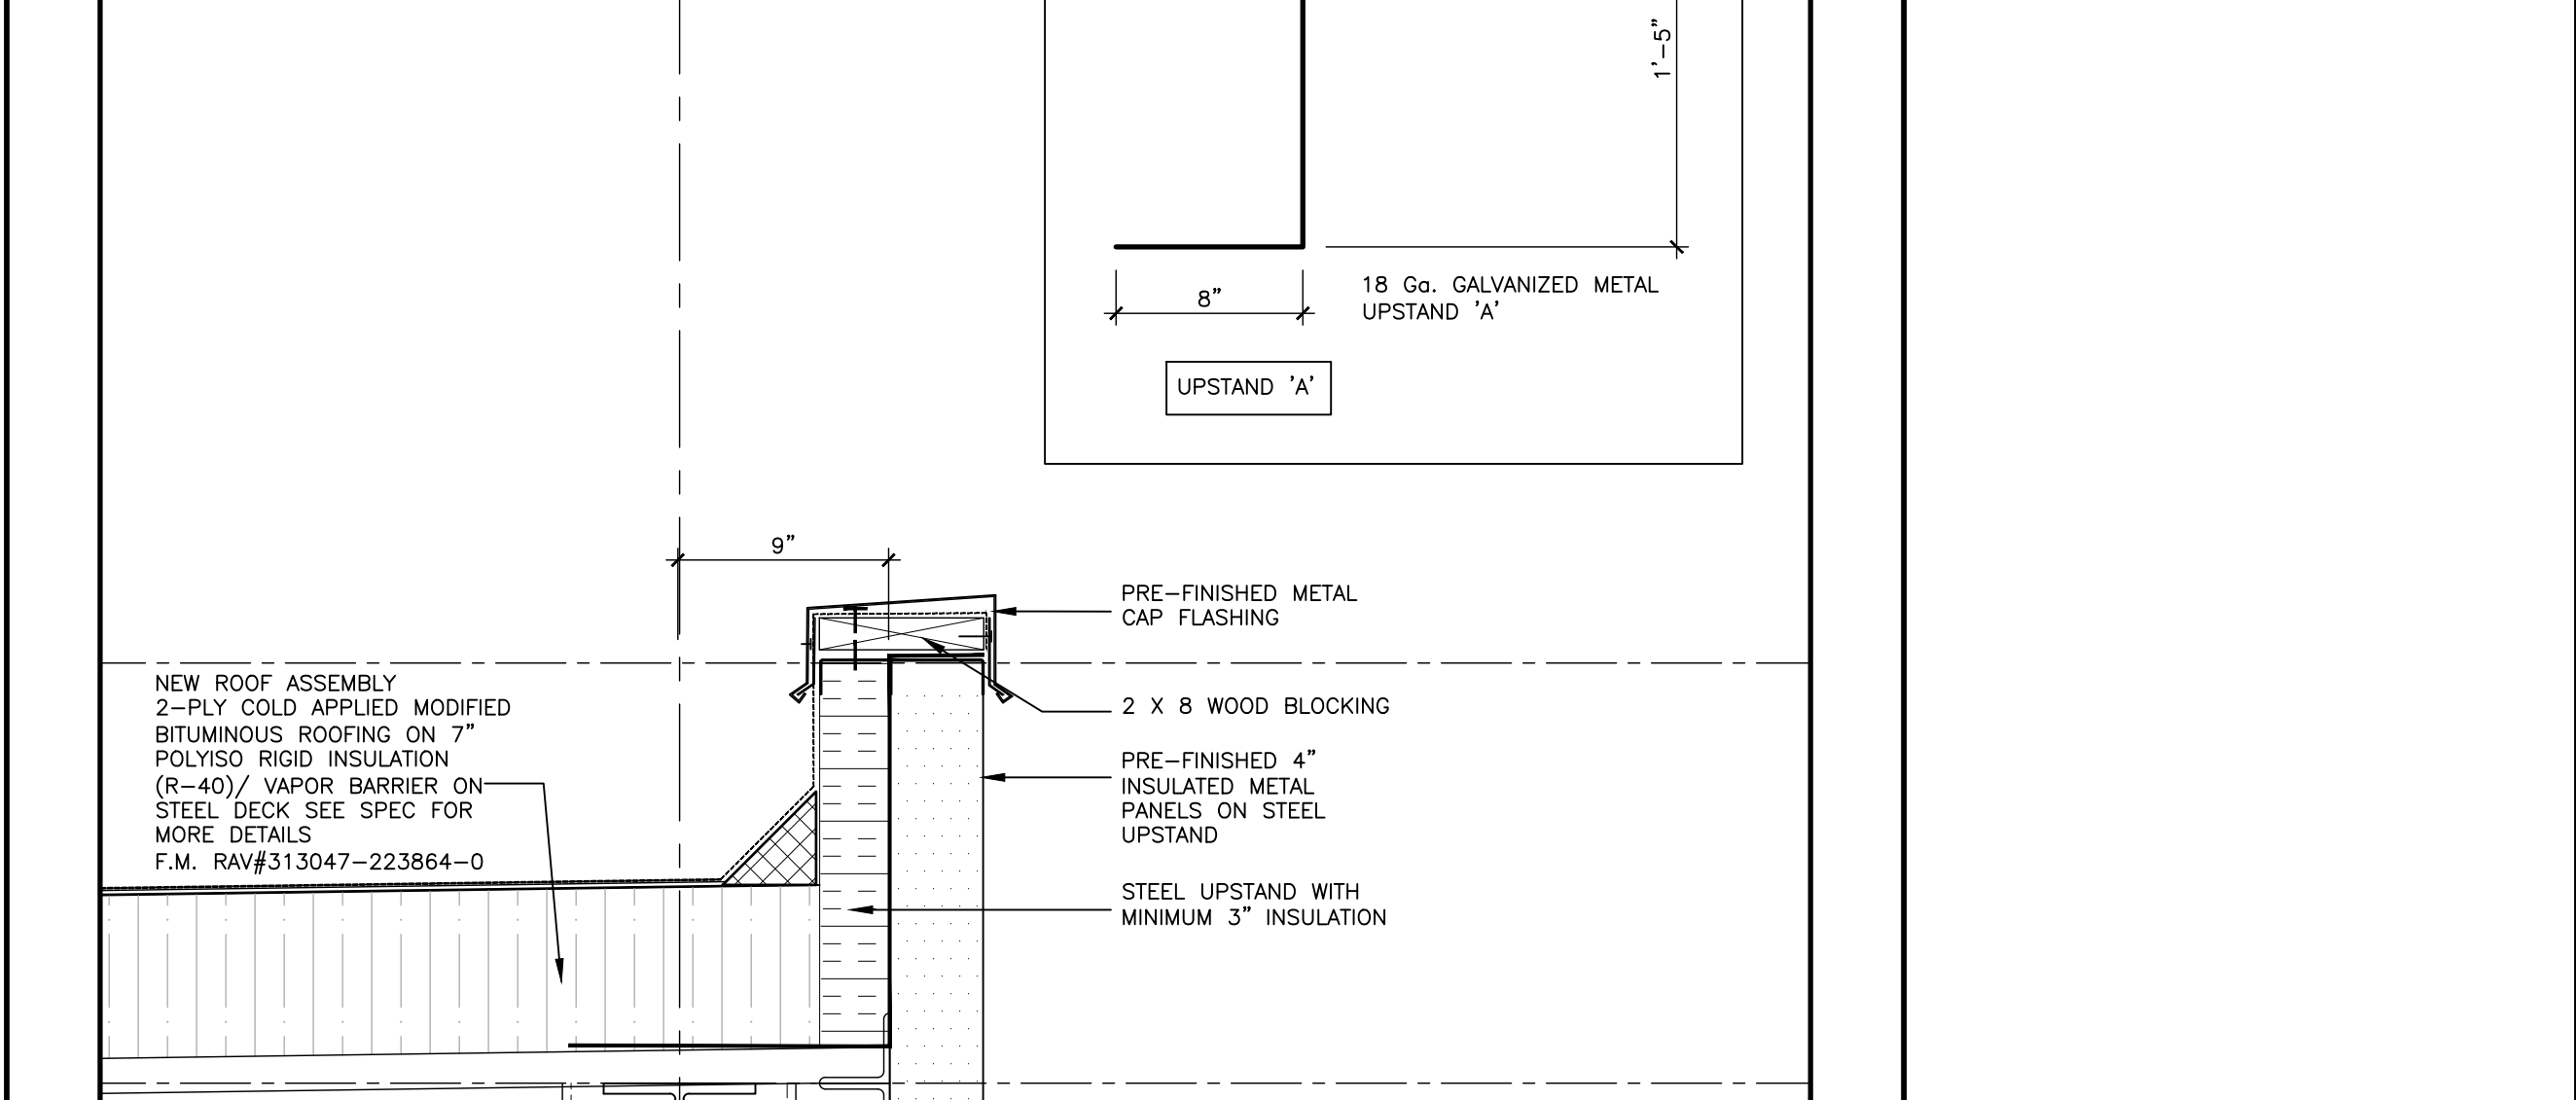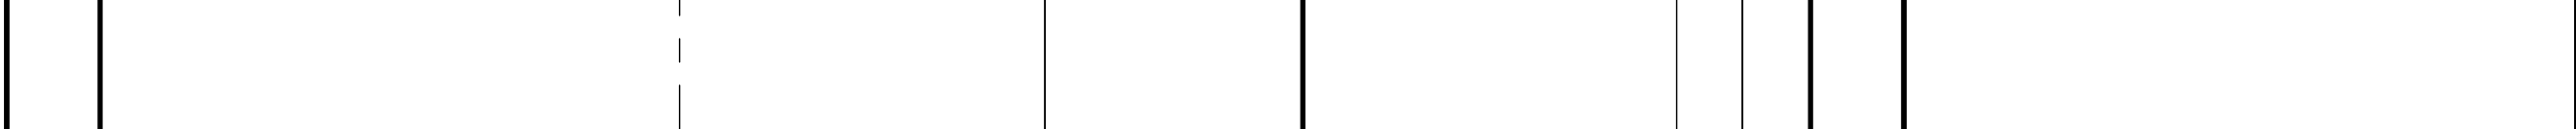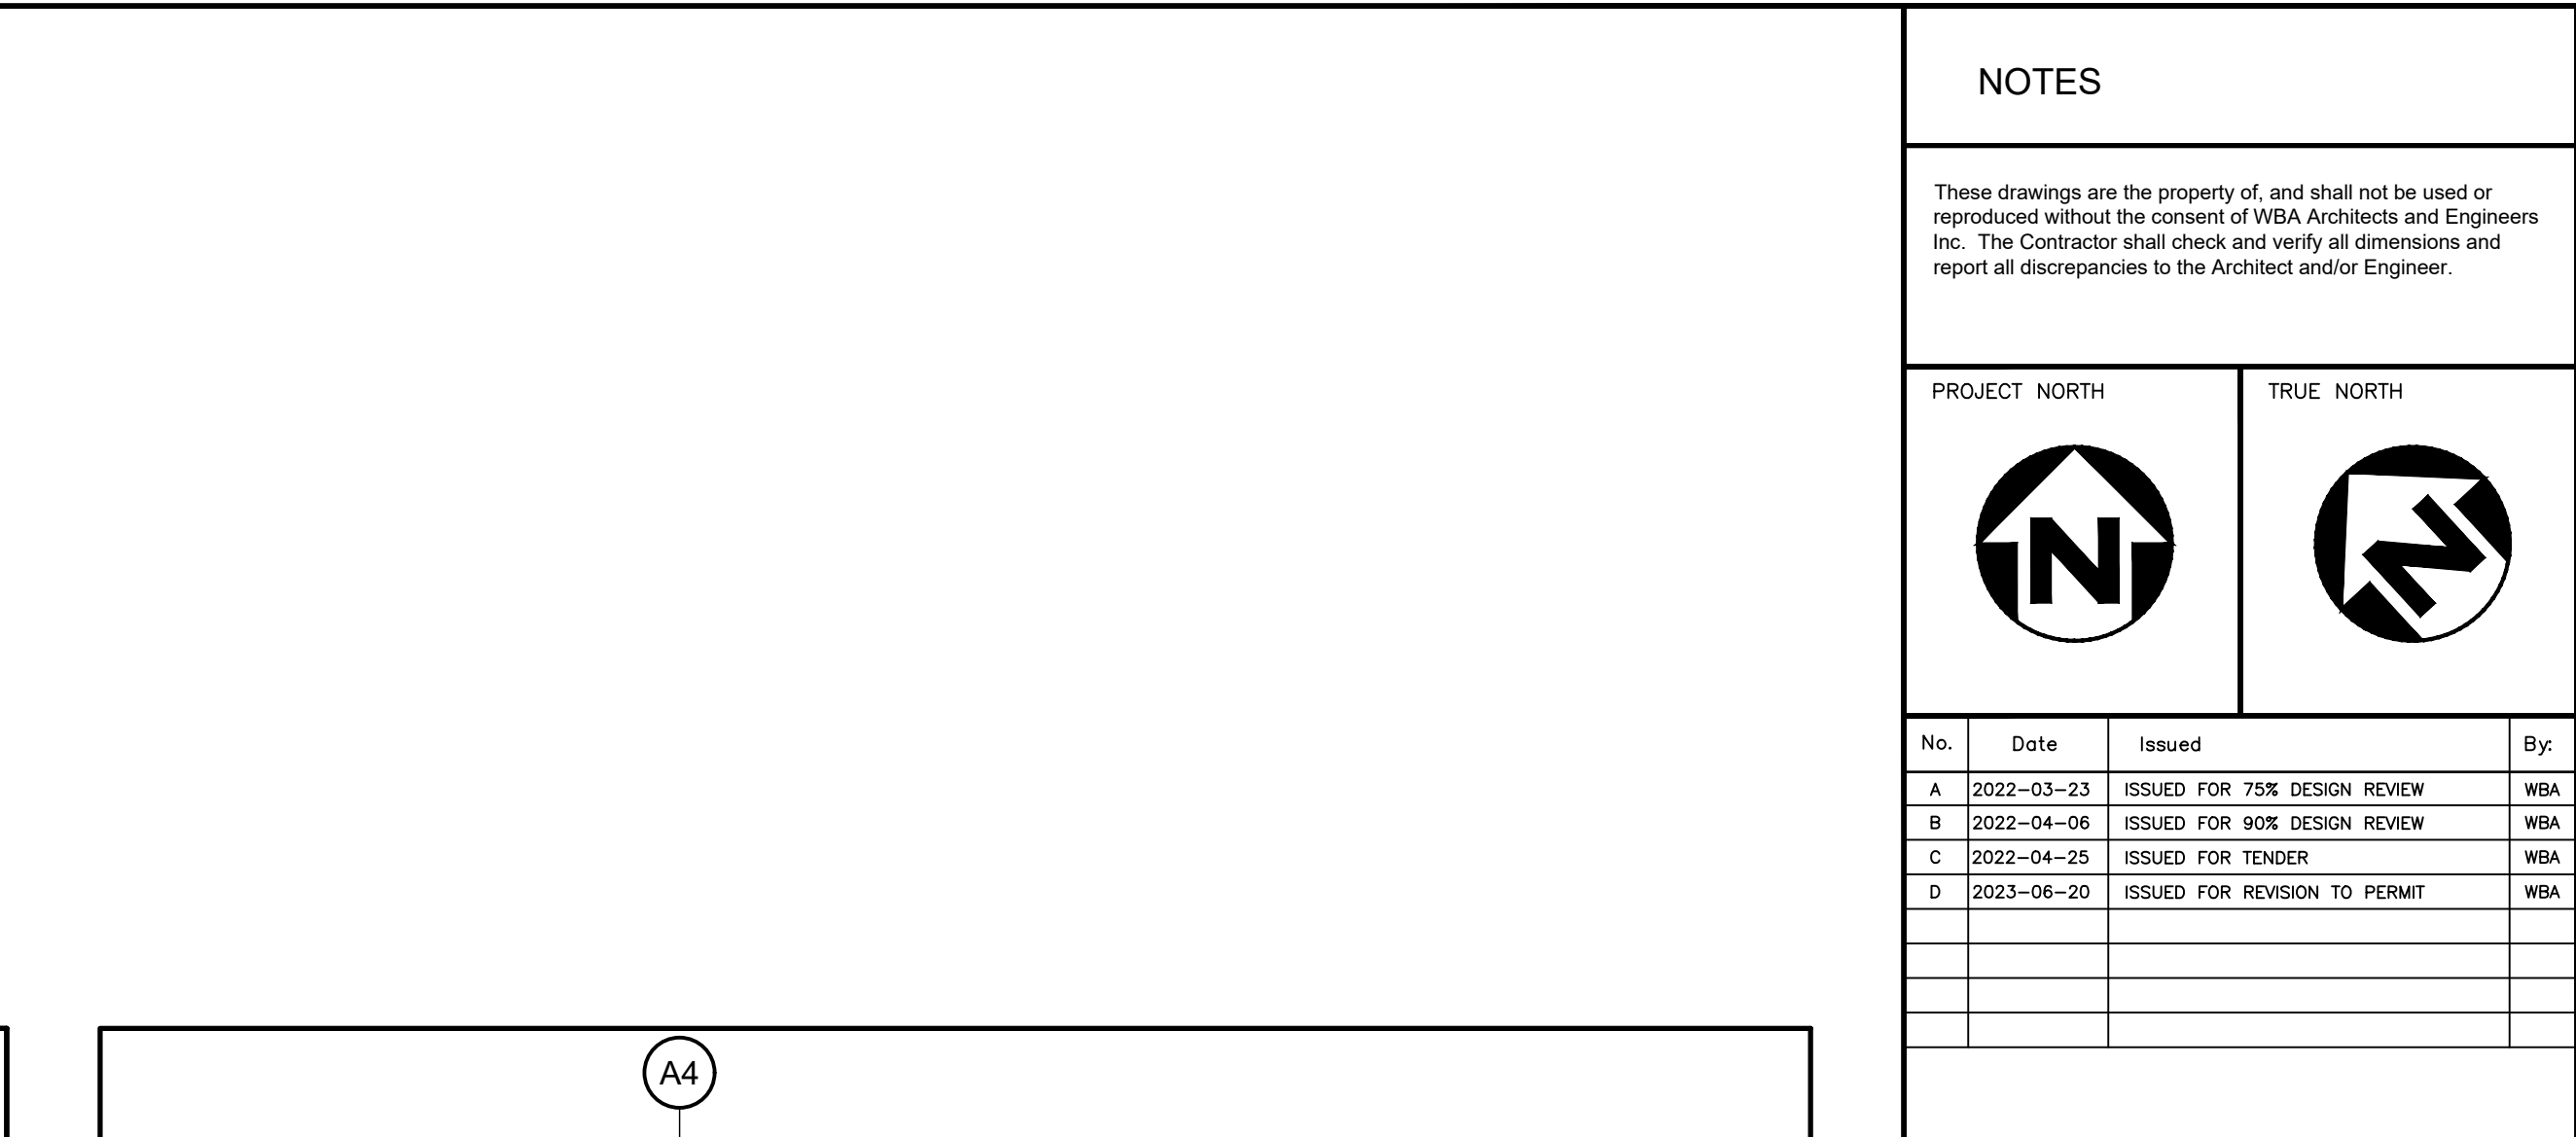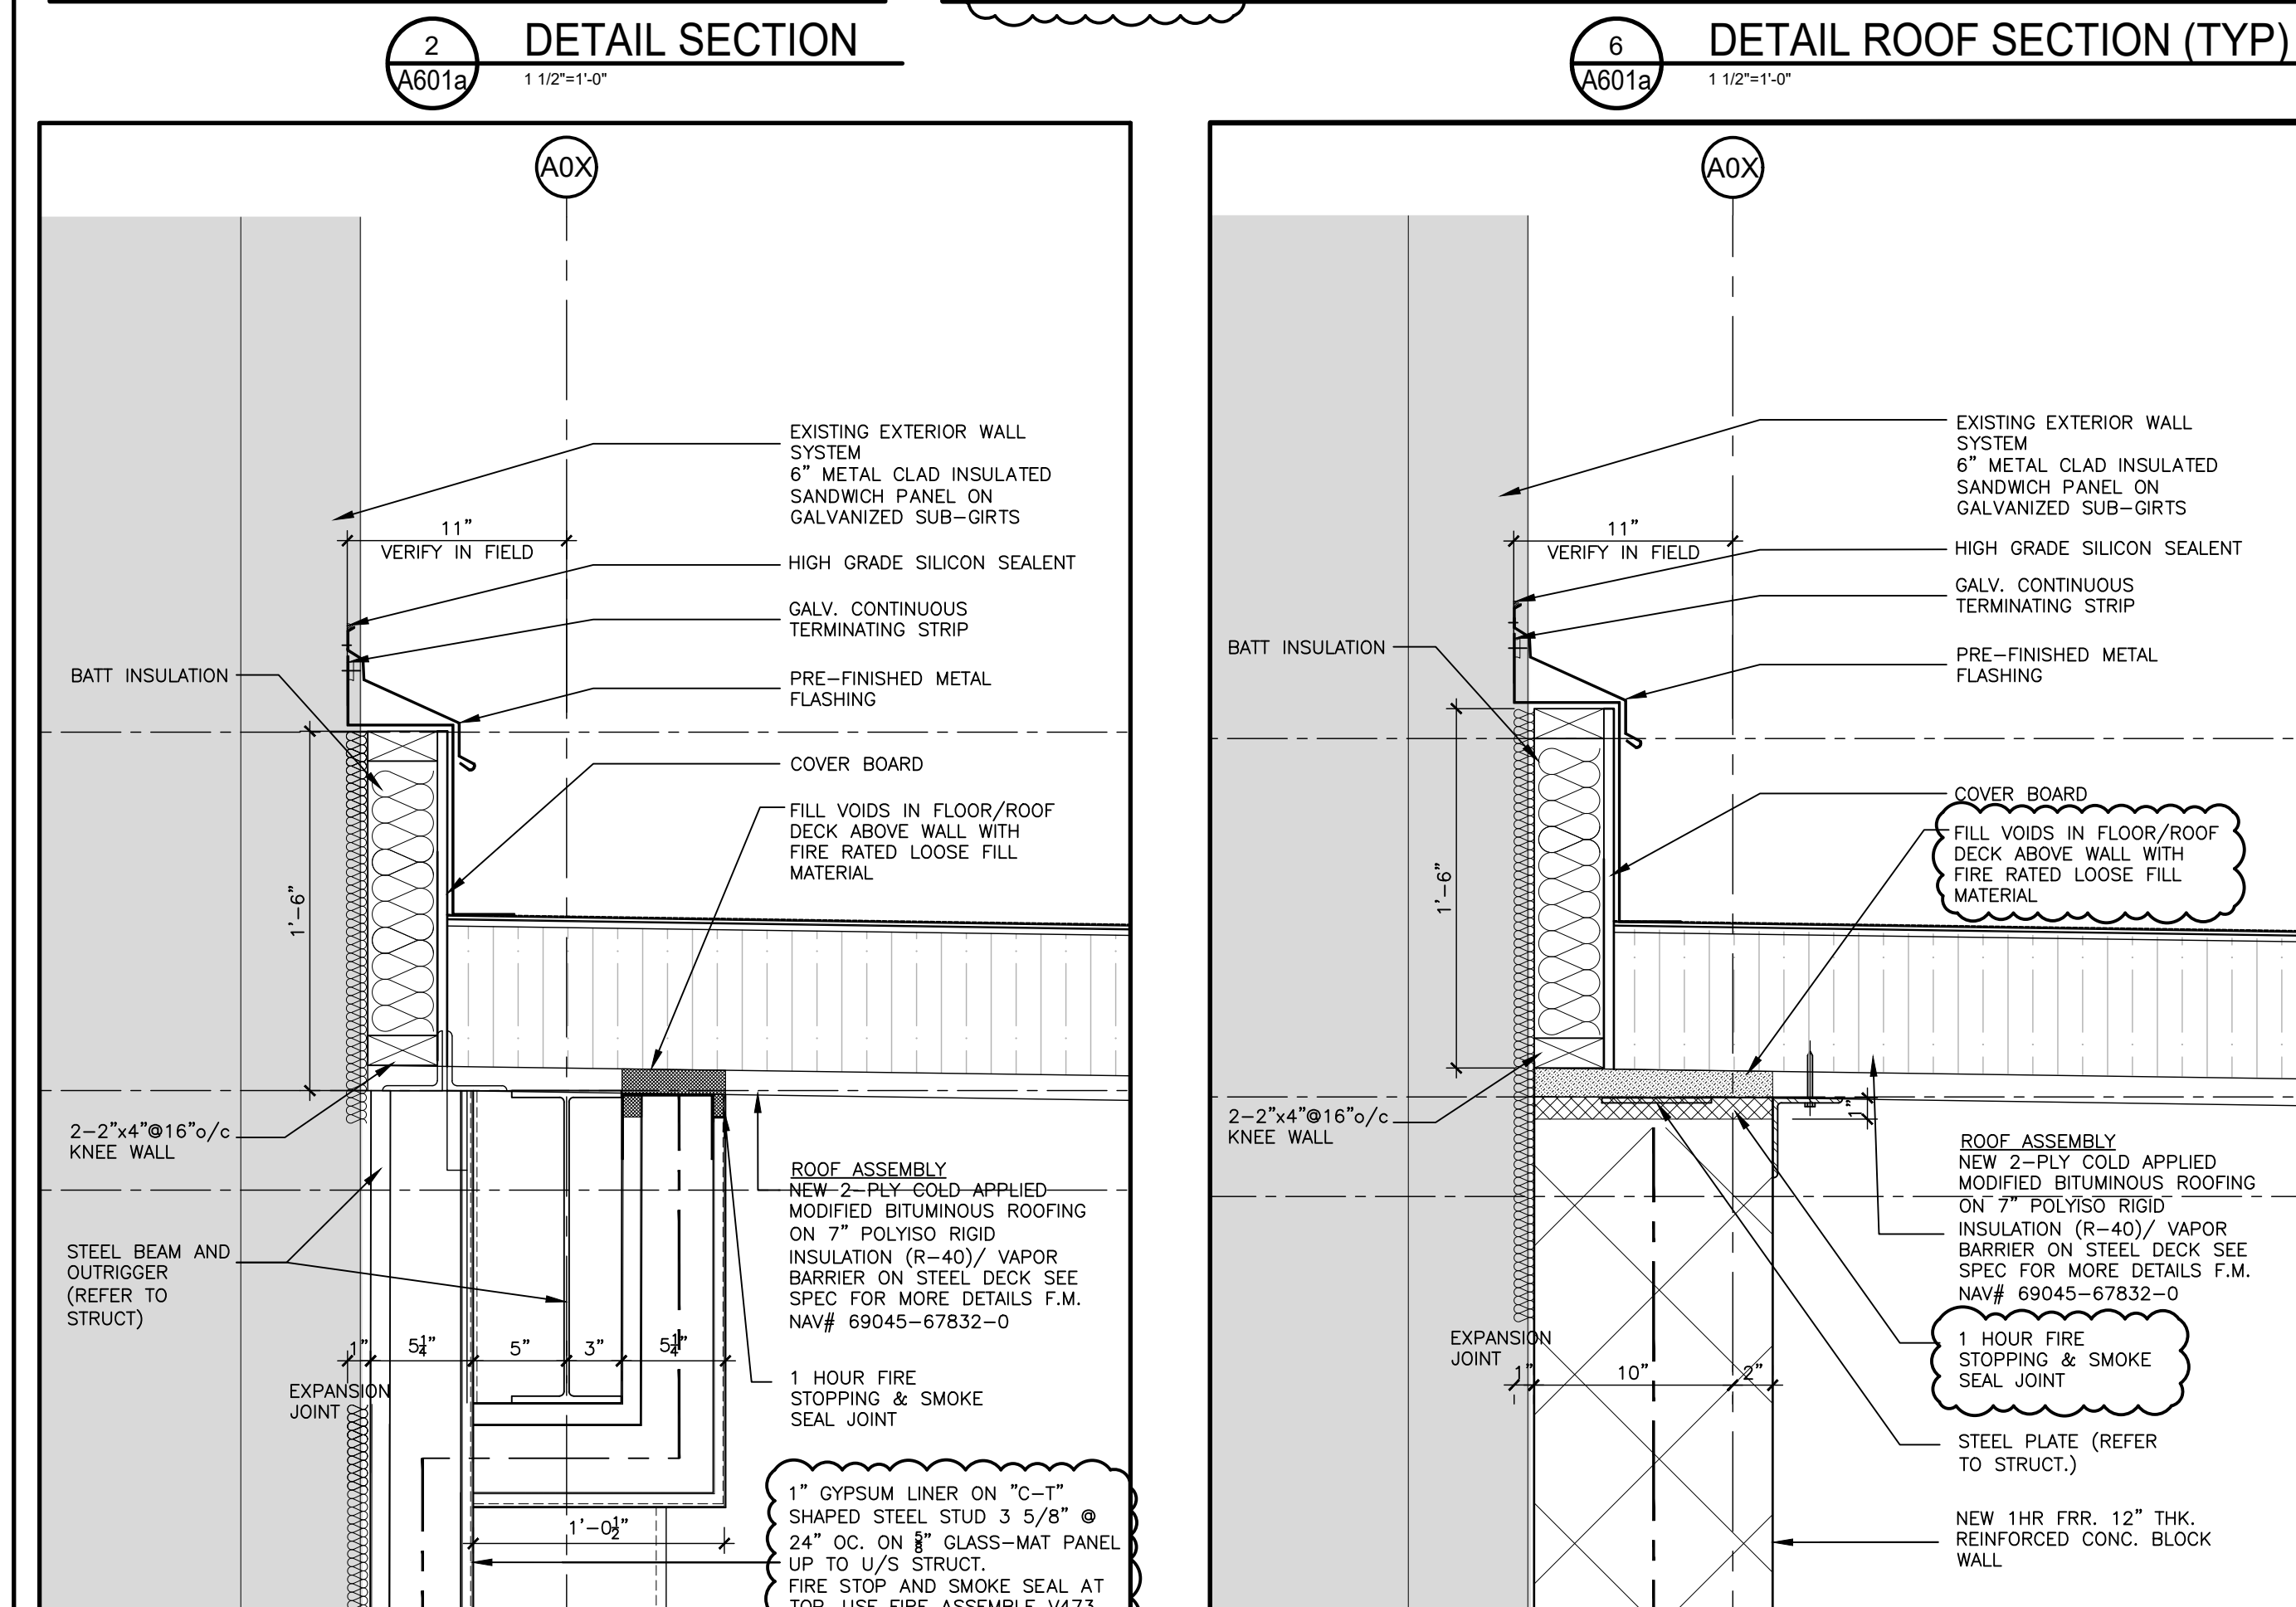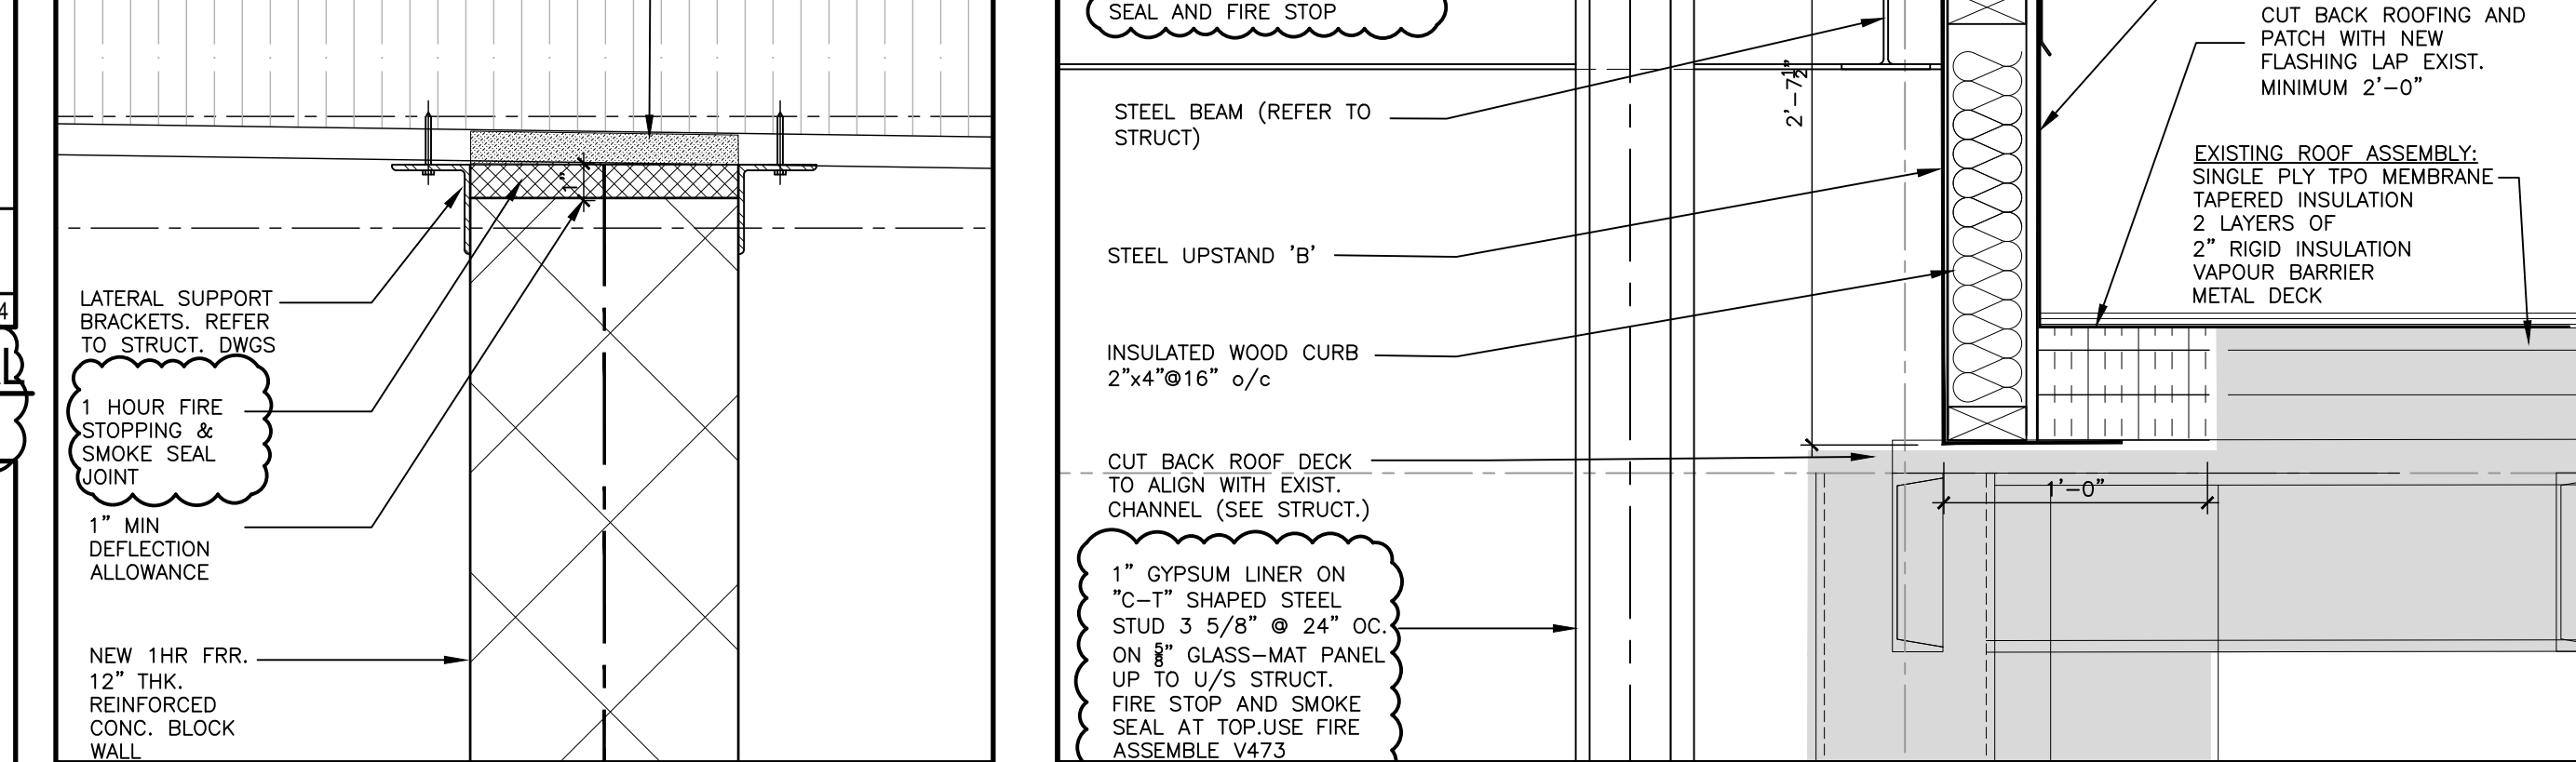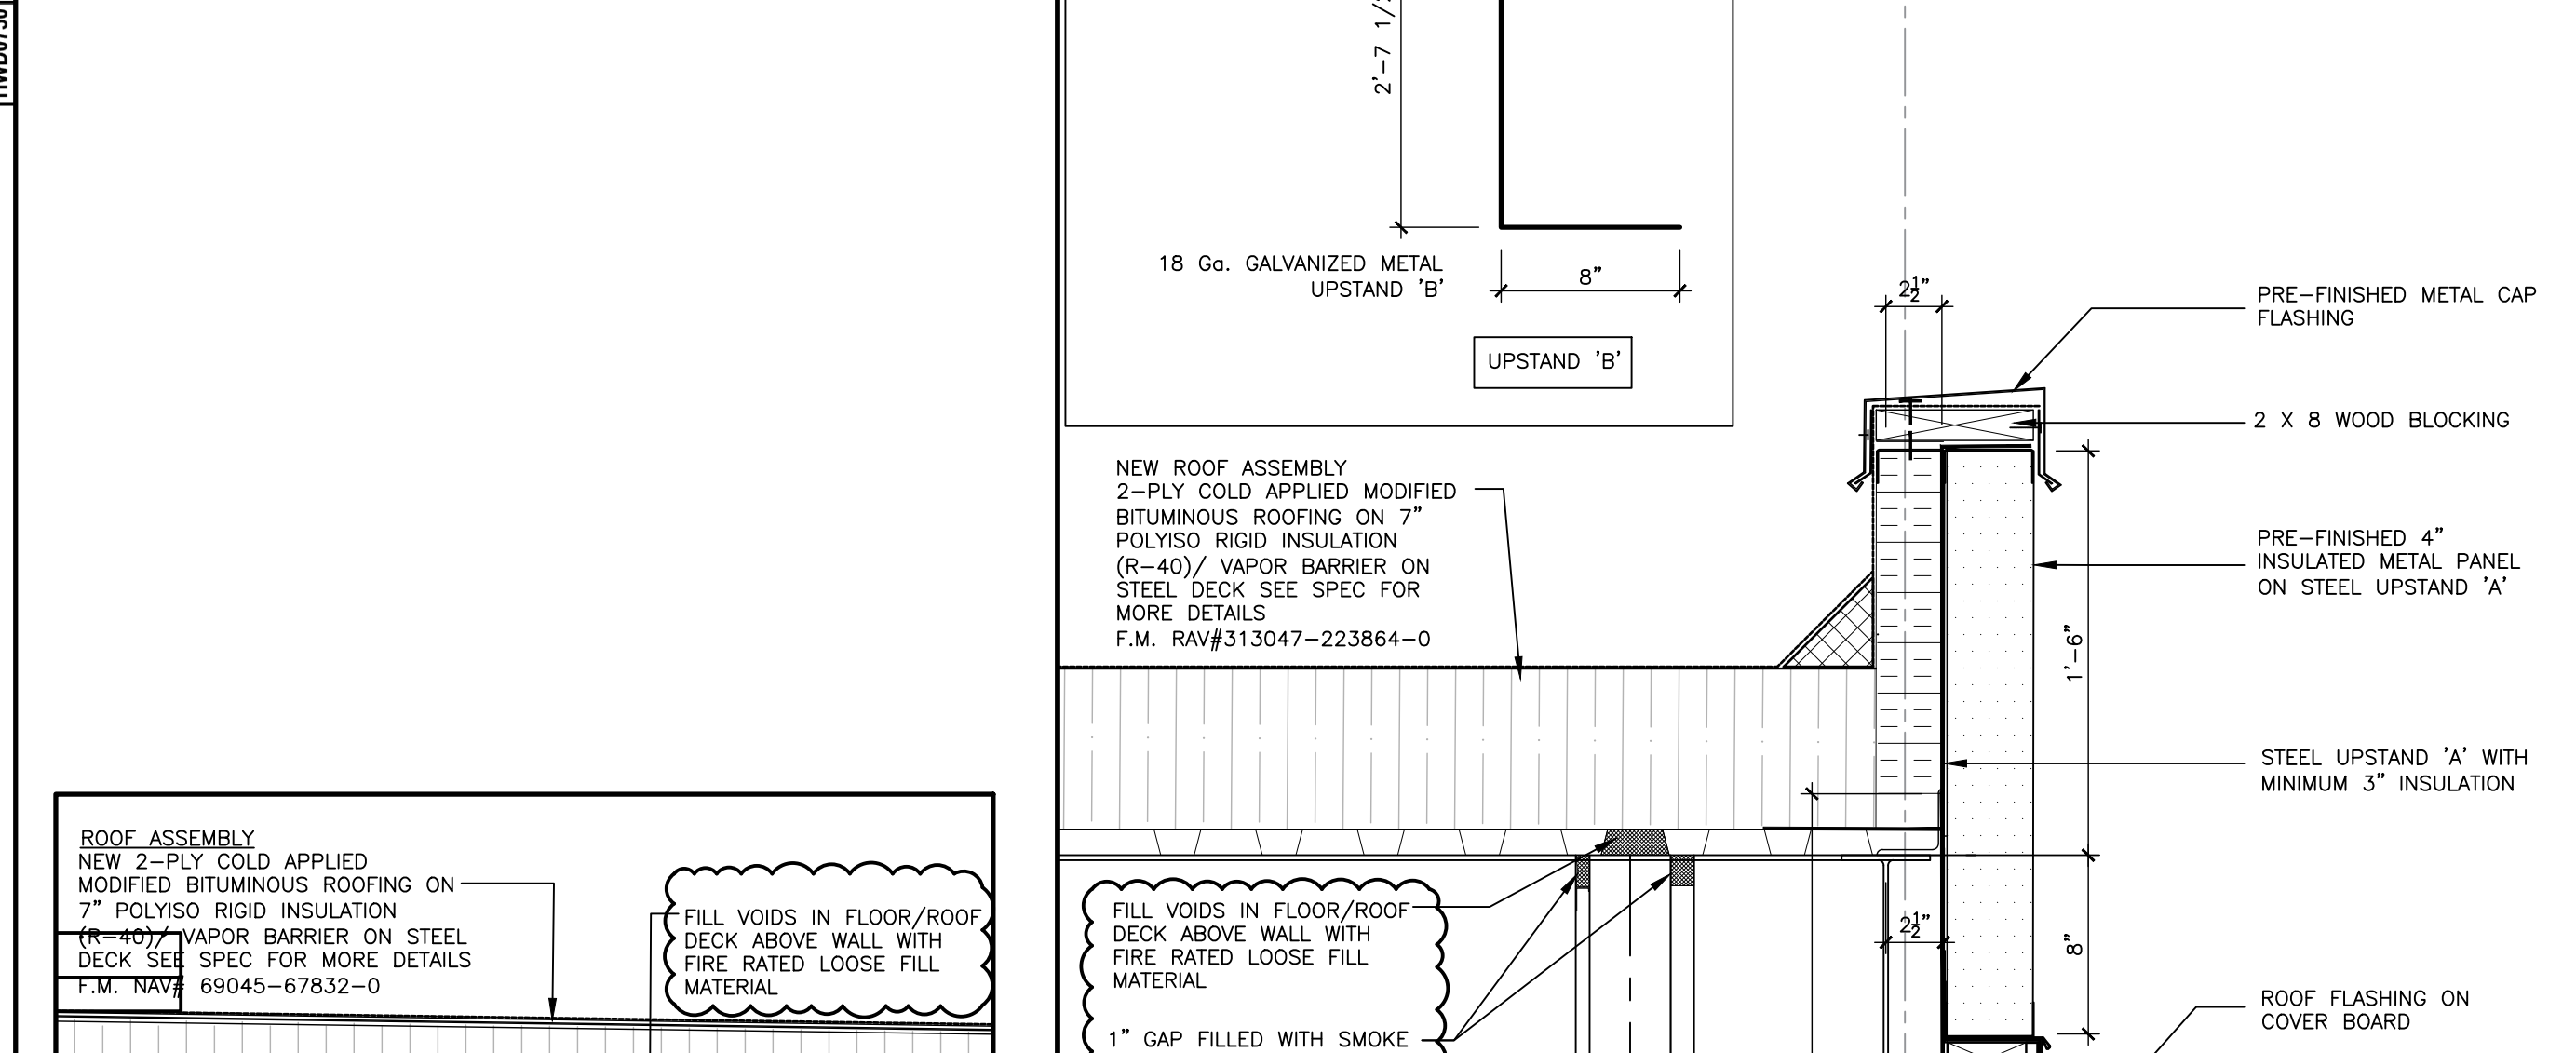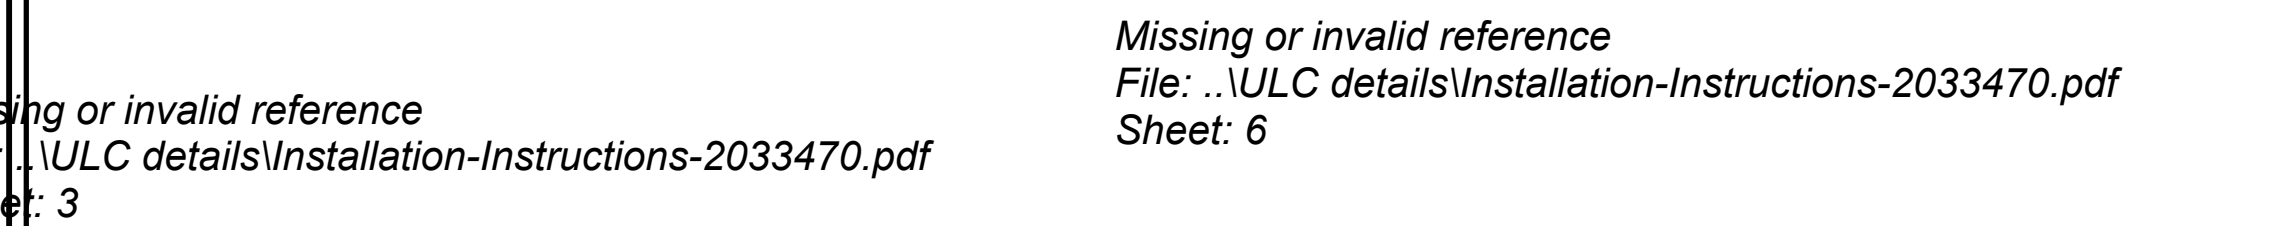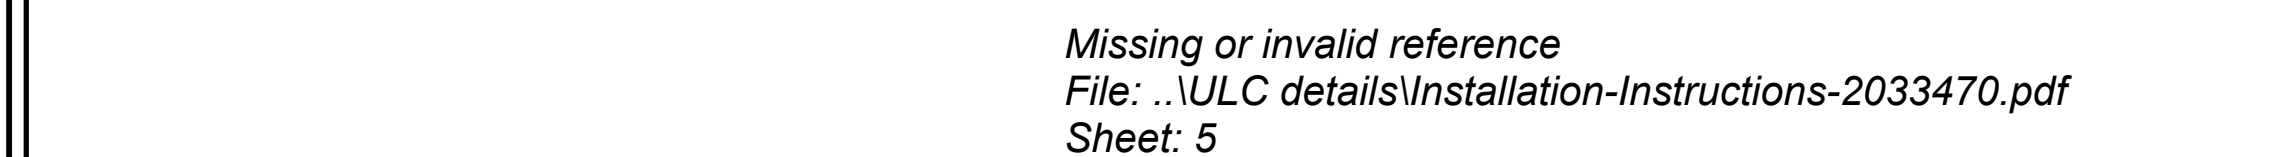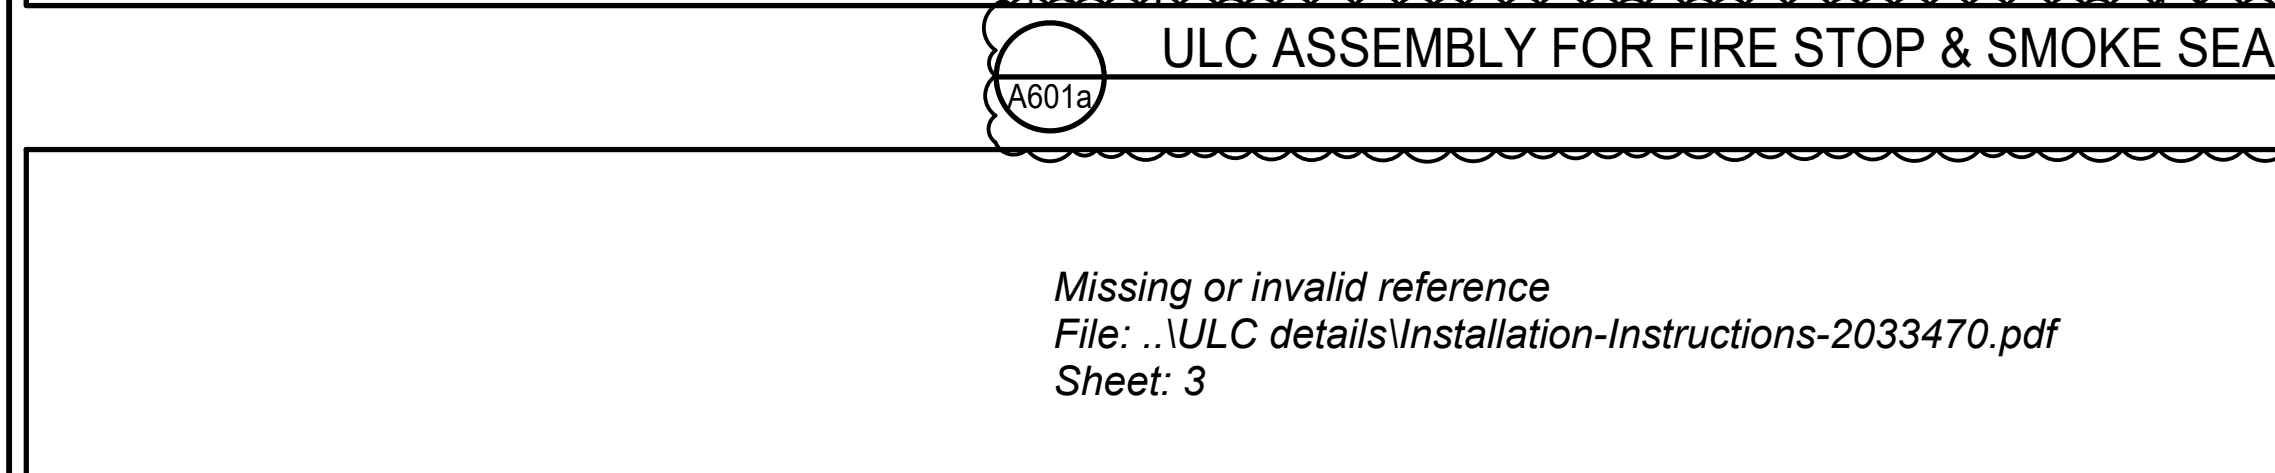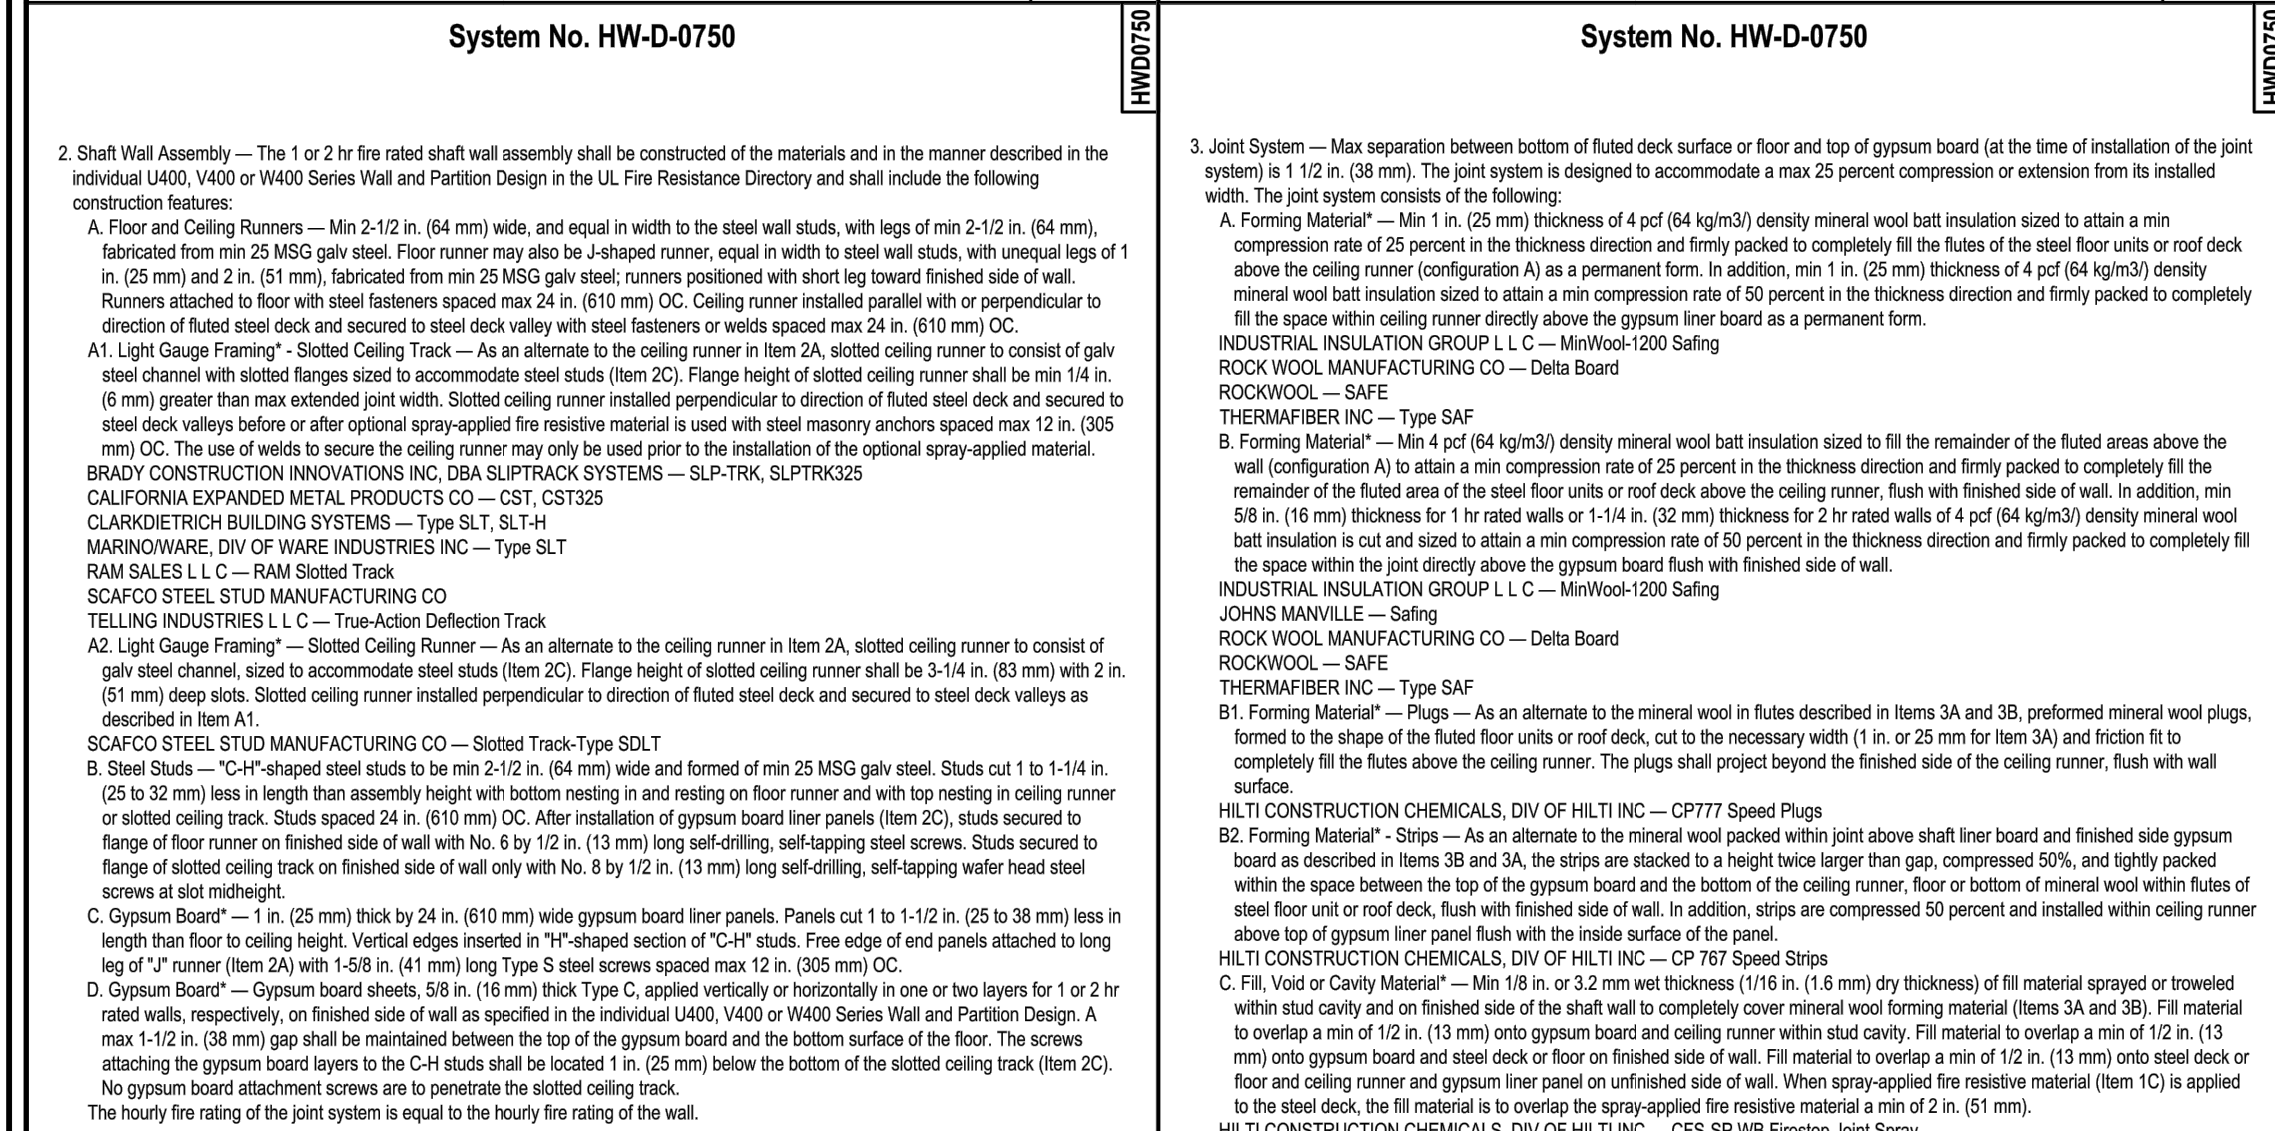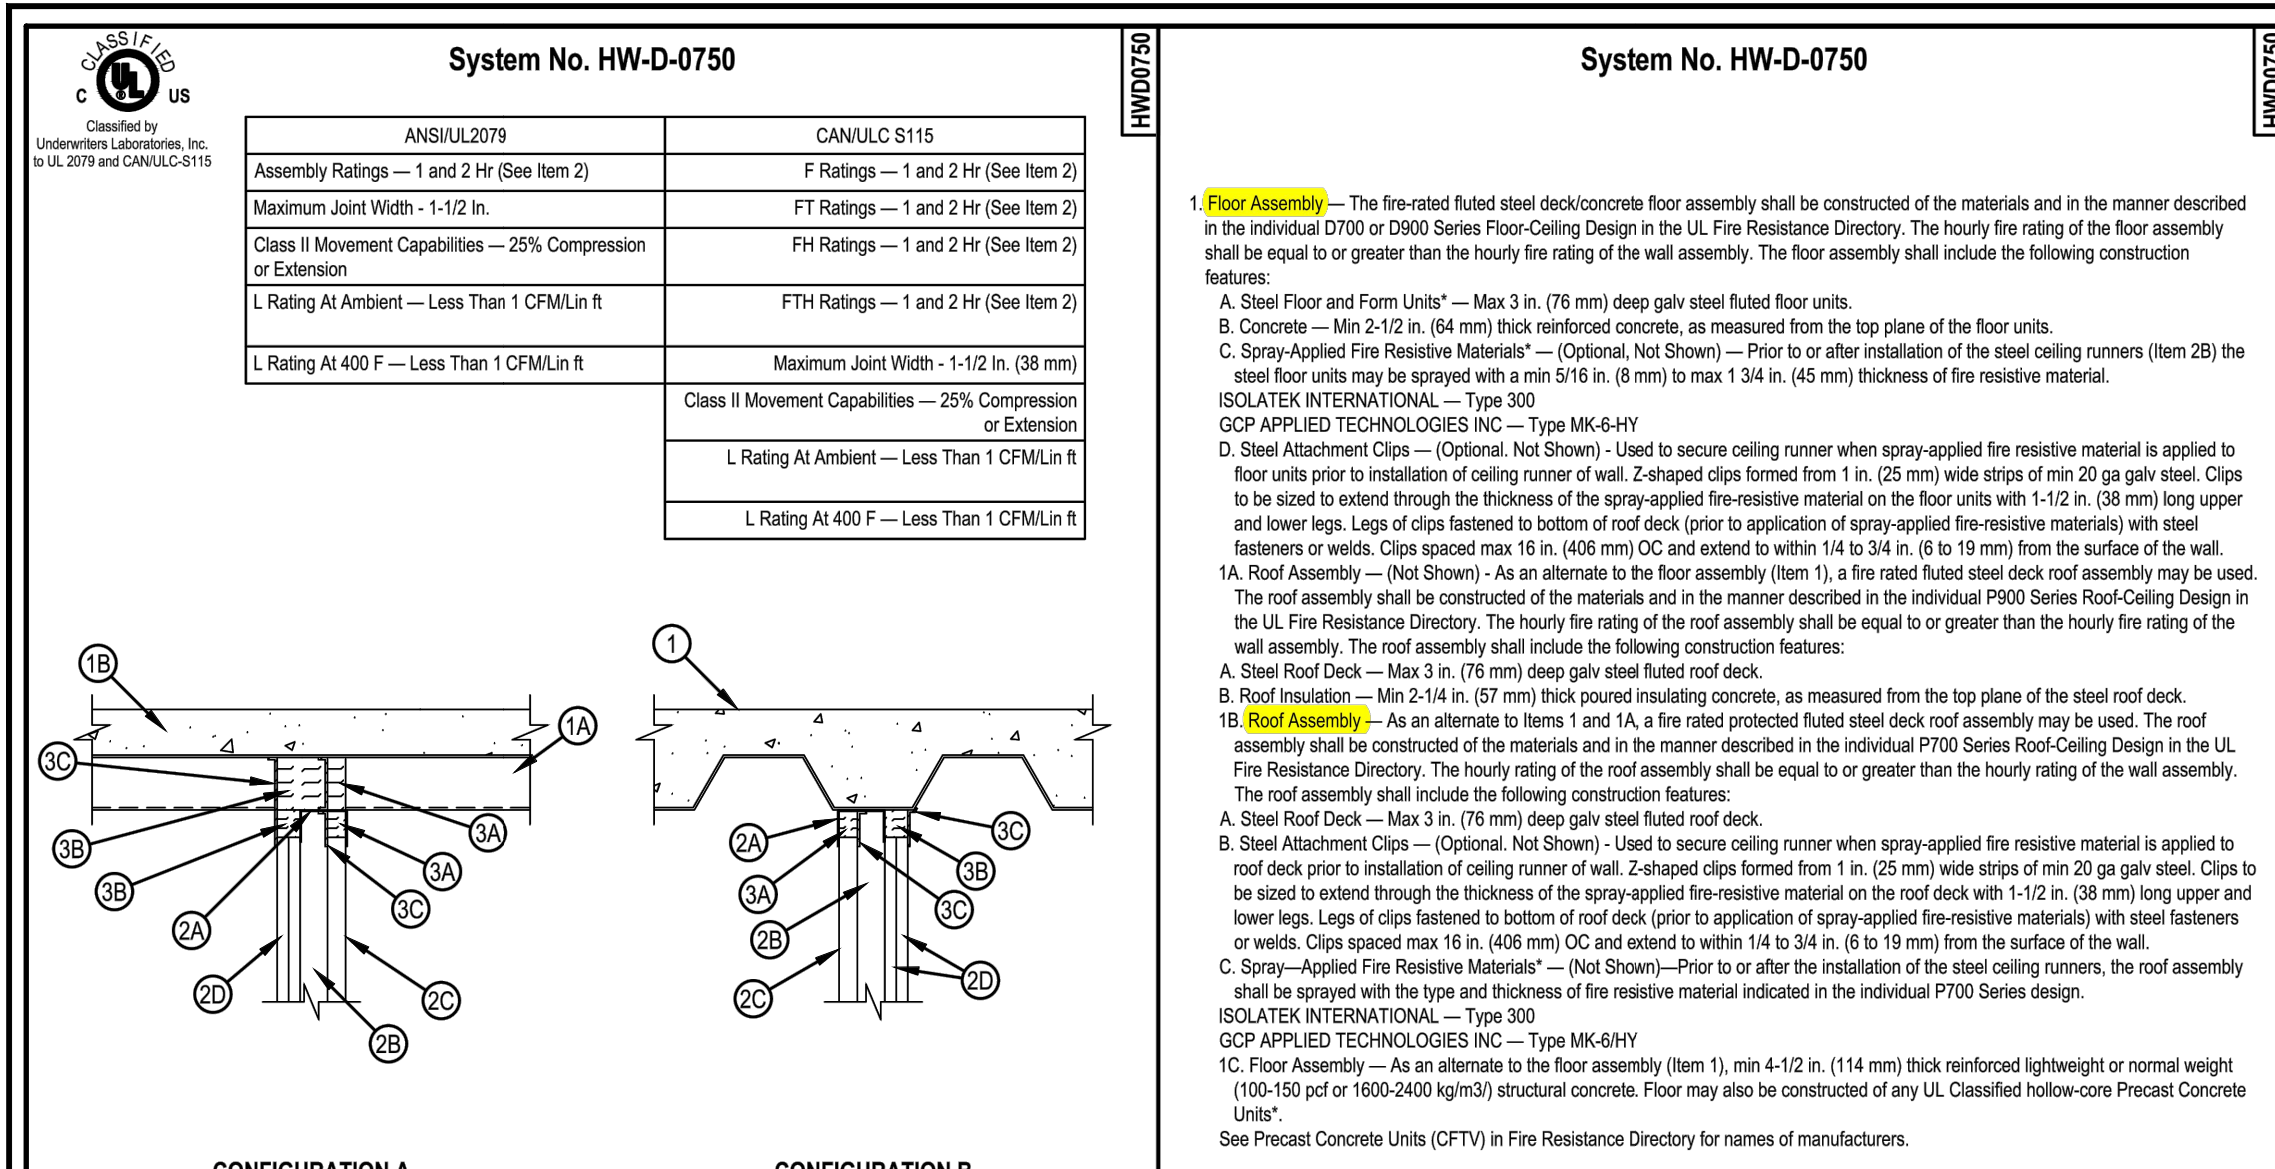 

NOTES

These drawings are the property of, and shall not be used or reproduced without the consent of WBA Architects and Engineers Inc. The Contractor shall check and verify all dimensions and report all discrepancies to the Architect and/or Engineer.

PROJECT NORTH **TRUE NORTH**

No. Date Issued By:

A	2022-03-23	ISSUED FOR 75% DESIGN REVIEW	WBA
B	2022-04-06	ISSUED FOR 80% DESIGN REVIEW	WBA
C	2022-04-25	ISSUED FOR TENDER	WBA
D	2023-08-20	ISSUED FOR REVISION TO PERMIT	WBA

Professional Seal: [Signature]

Professional Seal: [Signature]

Consultant: [Signature]

Client: [Signature]

Project Title: PROJECT NASH


Drawing Title: ENLARGED SETION DETAILS

CADD System: AUTOCAD 2016 Plot Scale: 1:1 Sheet Size: 30" x 42"


Drawn By: M.K. Date: JAN. 2022 Drawing Scale: AS NOTED

Checked By: G.S.S. Date: JAN. 2022 Rev: 2

Project No.: 2210711 Dwg. No.: A601a

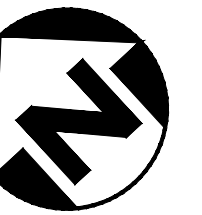


No.	Date	Issued	By:
A	2022-03-23	ISSUED FOR 75% DESIGN REVIEW	WBA
B	2022-04-06	ISSUED FOR 90% DESIGN REVIEW	WBA
C	2022-04-25	ISSUED FOR TENDER	WBA
D	2023-02-24	ISSUED FOR COORDINATION	WBA
E	2023-06-20	ISSUED FOR REVISION TO PERMIT	WBA
F	2023-06-29	ISSUED FOR REVIEW	WBA

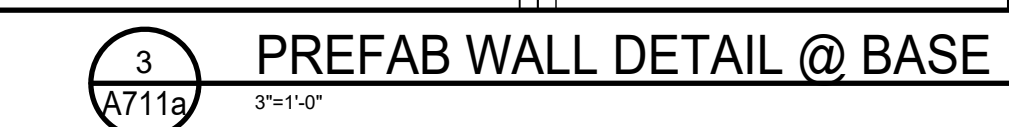

5	2024-04-11	ISSUED FOR AS-BUILT	WBA
4	2023-07-17	ISSUED FOR CCN #33	WBA
3	2023-06-19	ISSUED FOR CCN #29	WBA
2	2023-04-25	ISSUED FOR CCN#21R1	WBA
1	2023-03-13	ISSUED FOR CCN#20	WBA
0	2022-07-13	ISSUED FOR CONSTRUCTION	WBA

No.	Date	Revision	By:
Professional Seal		Professional Seal	

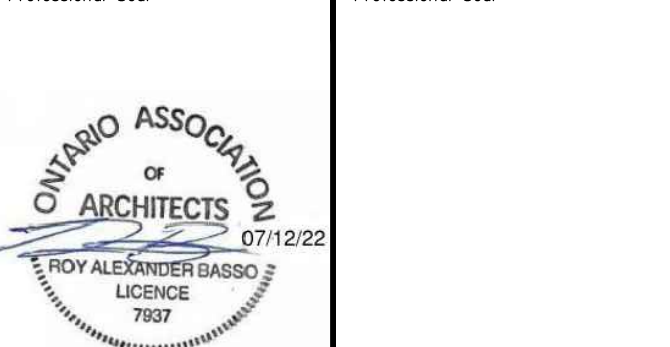

Consultant:



Client: **Johnson & Johnson**
890 WOODLAWN ROAD WEST
GUELPH, ON



Project Title: PROJECT NASH

Drawing Title:

WASHER DETAILS


PROCESS

CADD System : AUTOCAD 2016	Plot Scale: 1:1	Sheet Size: 30" x 42"
Drawn By: M.K	Date: JAN. 2022	Drawing Scale: AS NOTED
Checked By: G.S.S	Date: JAN. 2022	Rev.: 5
Project No: 2210711		
A711a		

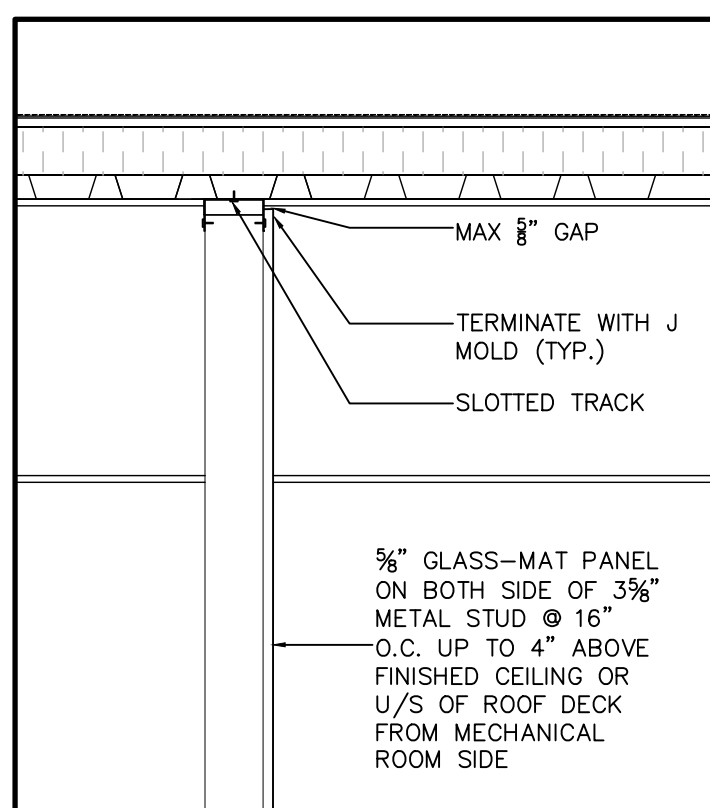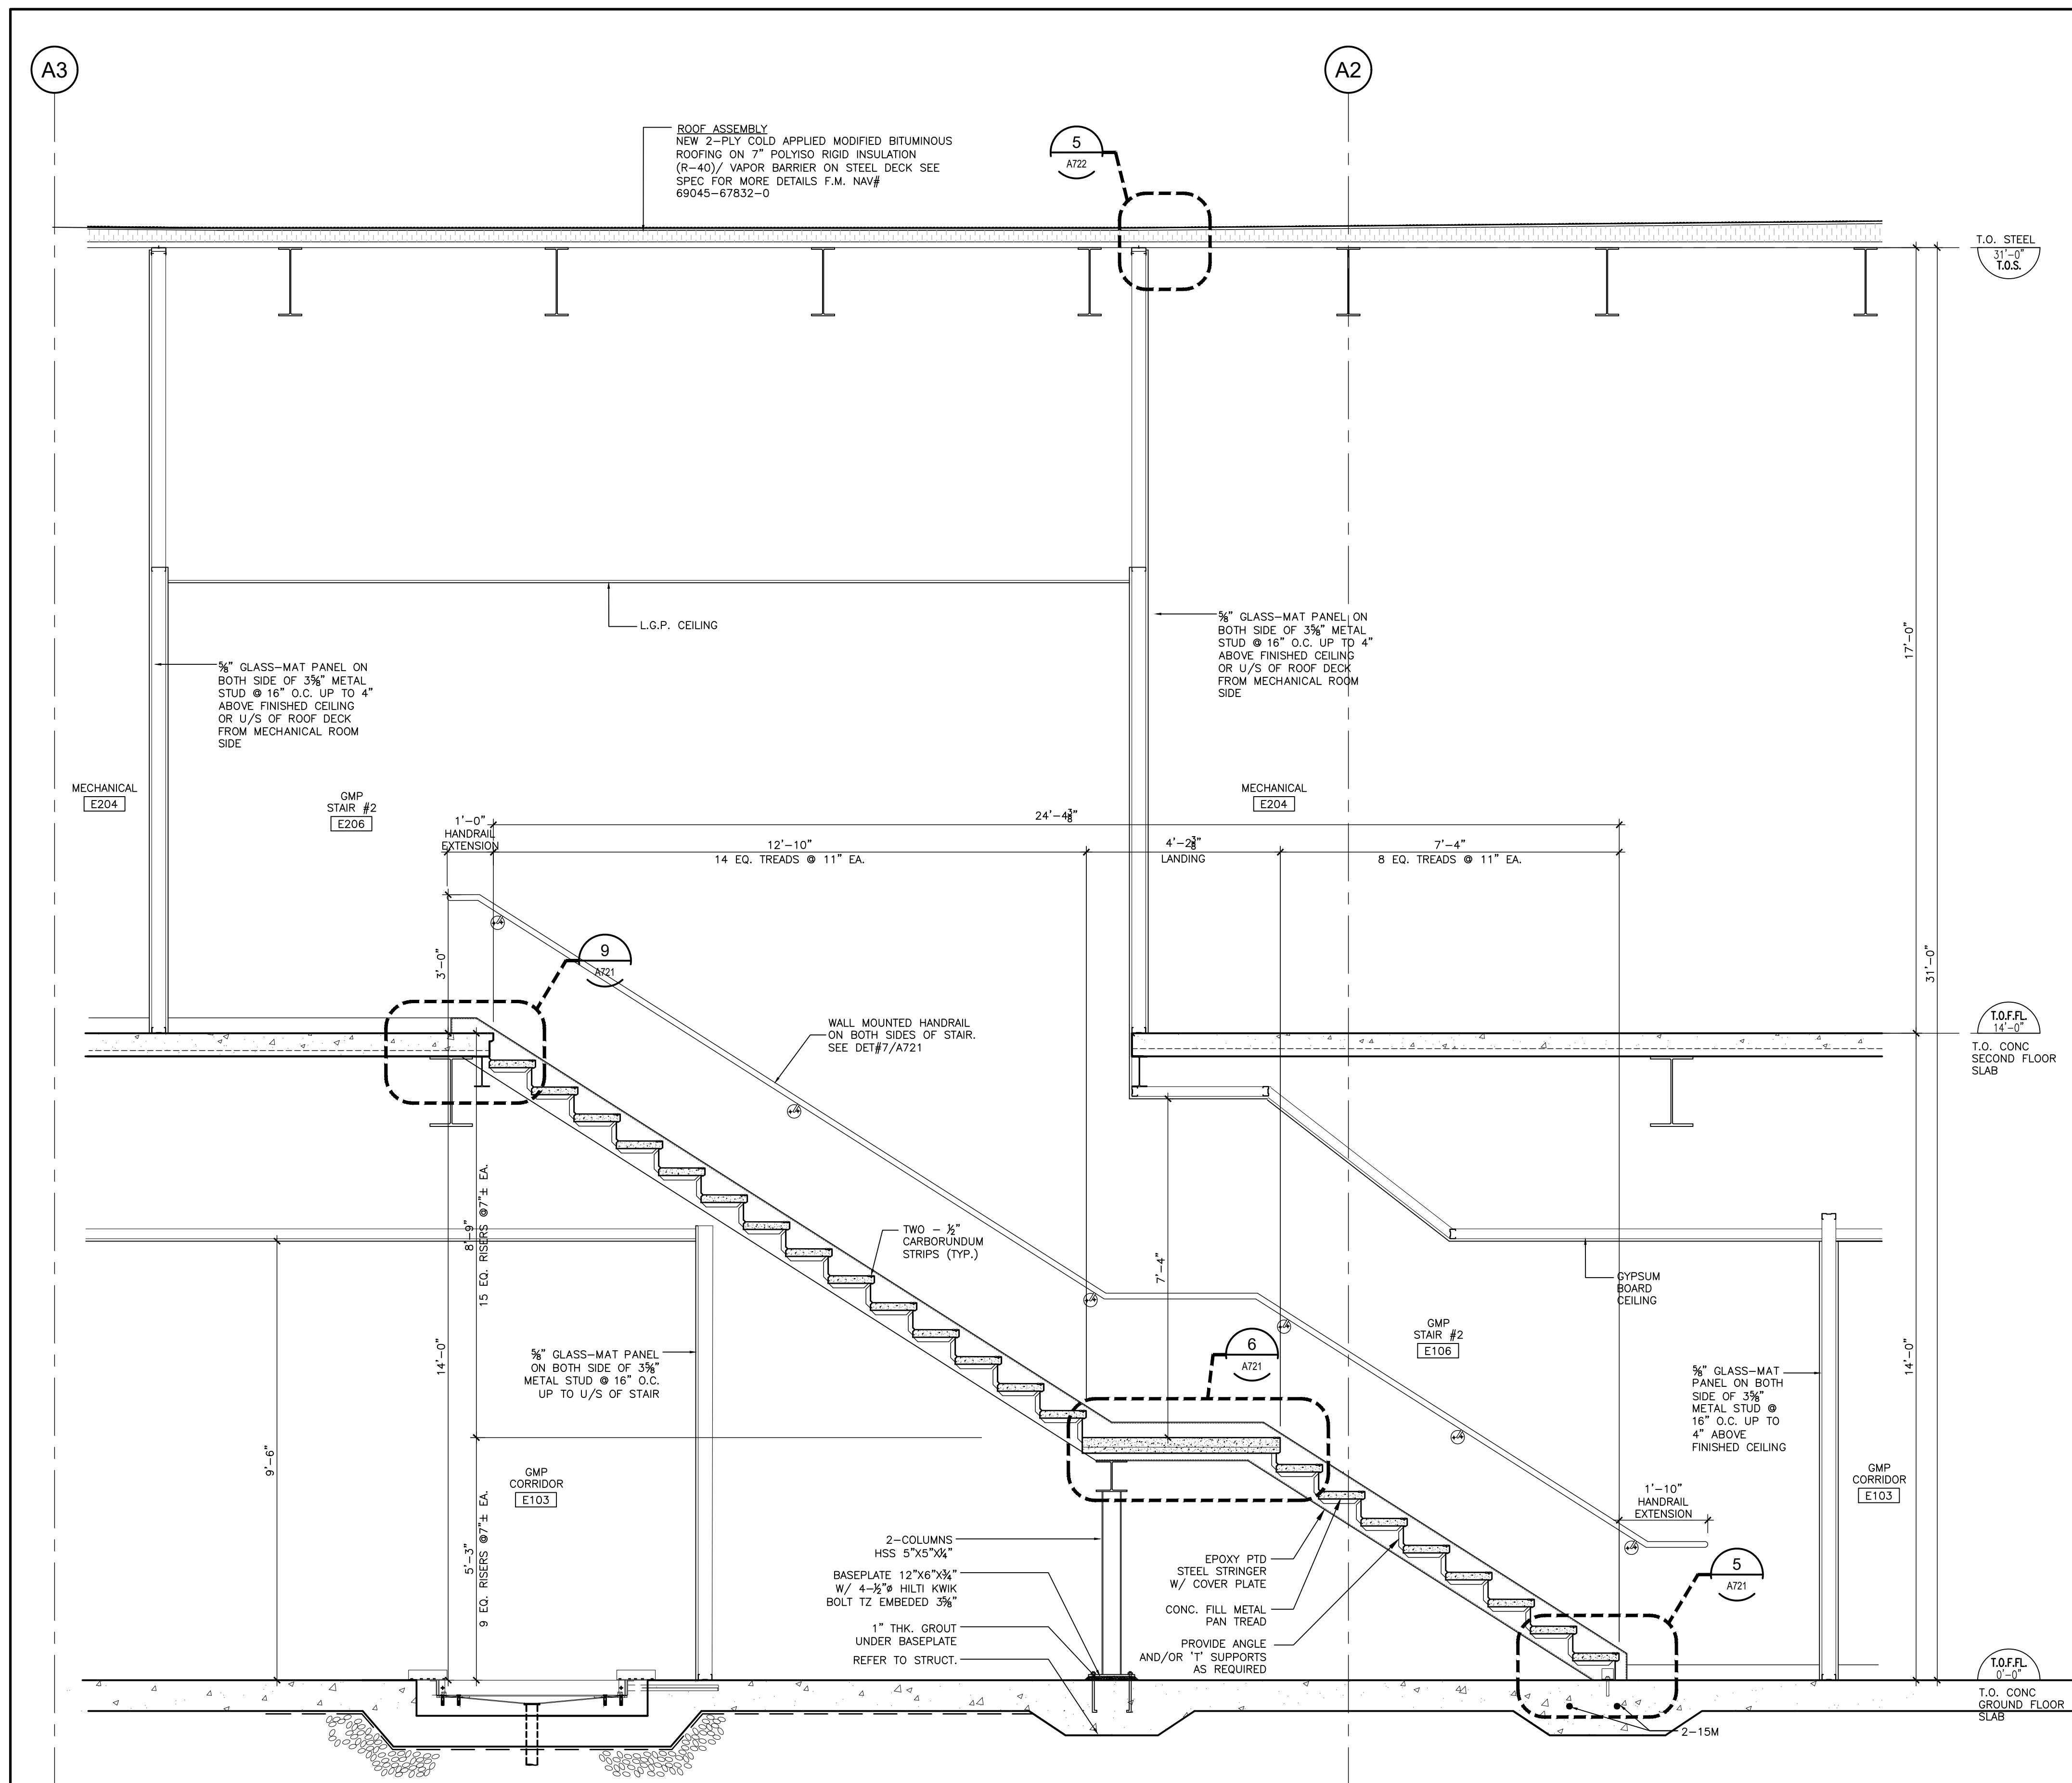


5
A722
1'-1'-0"


4
A722
1/2"=1'-0"

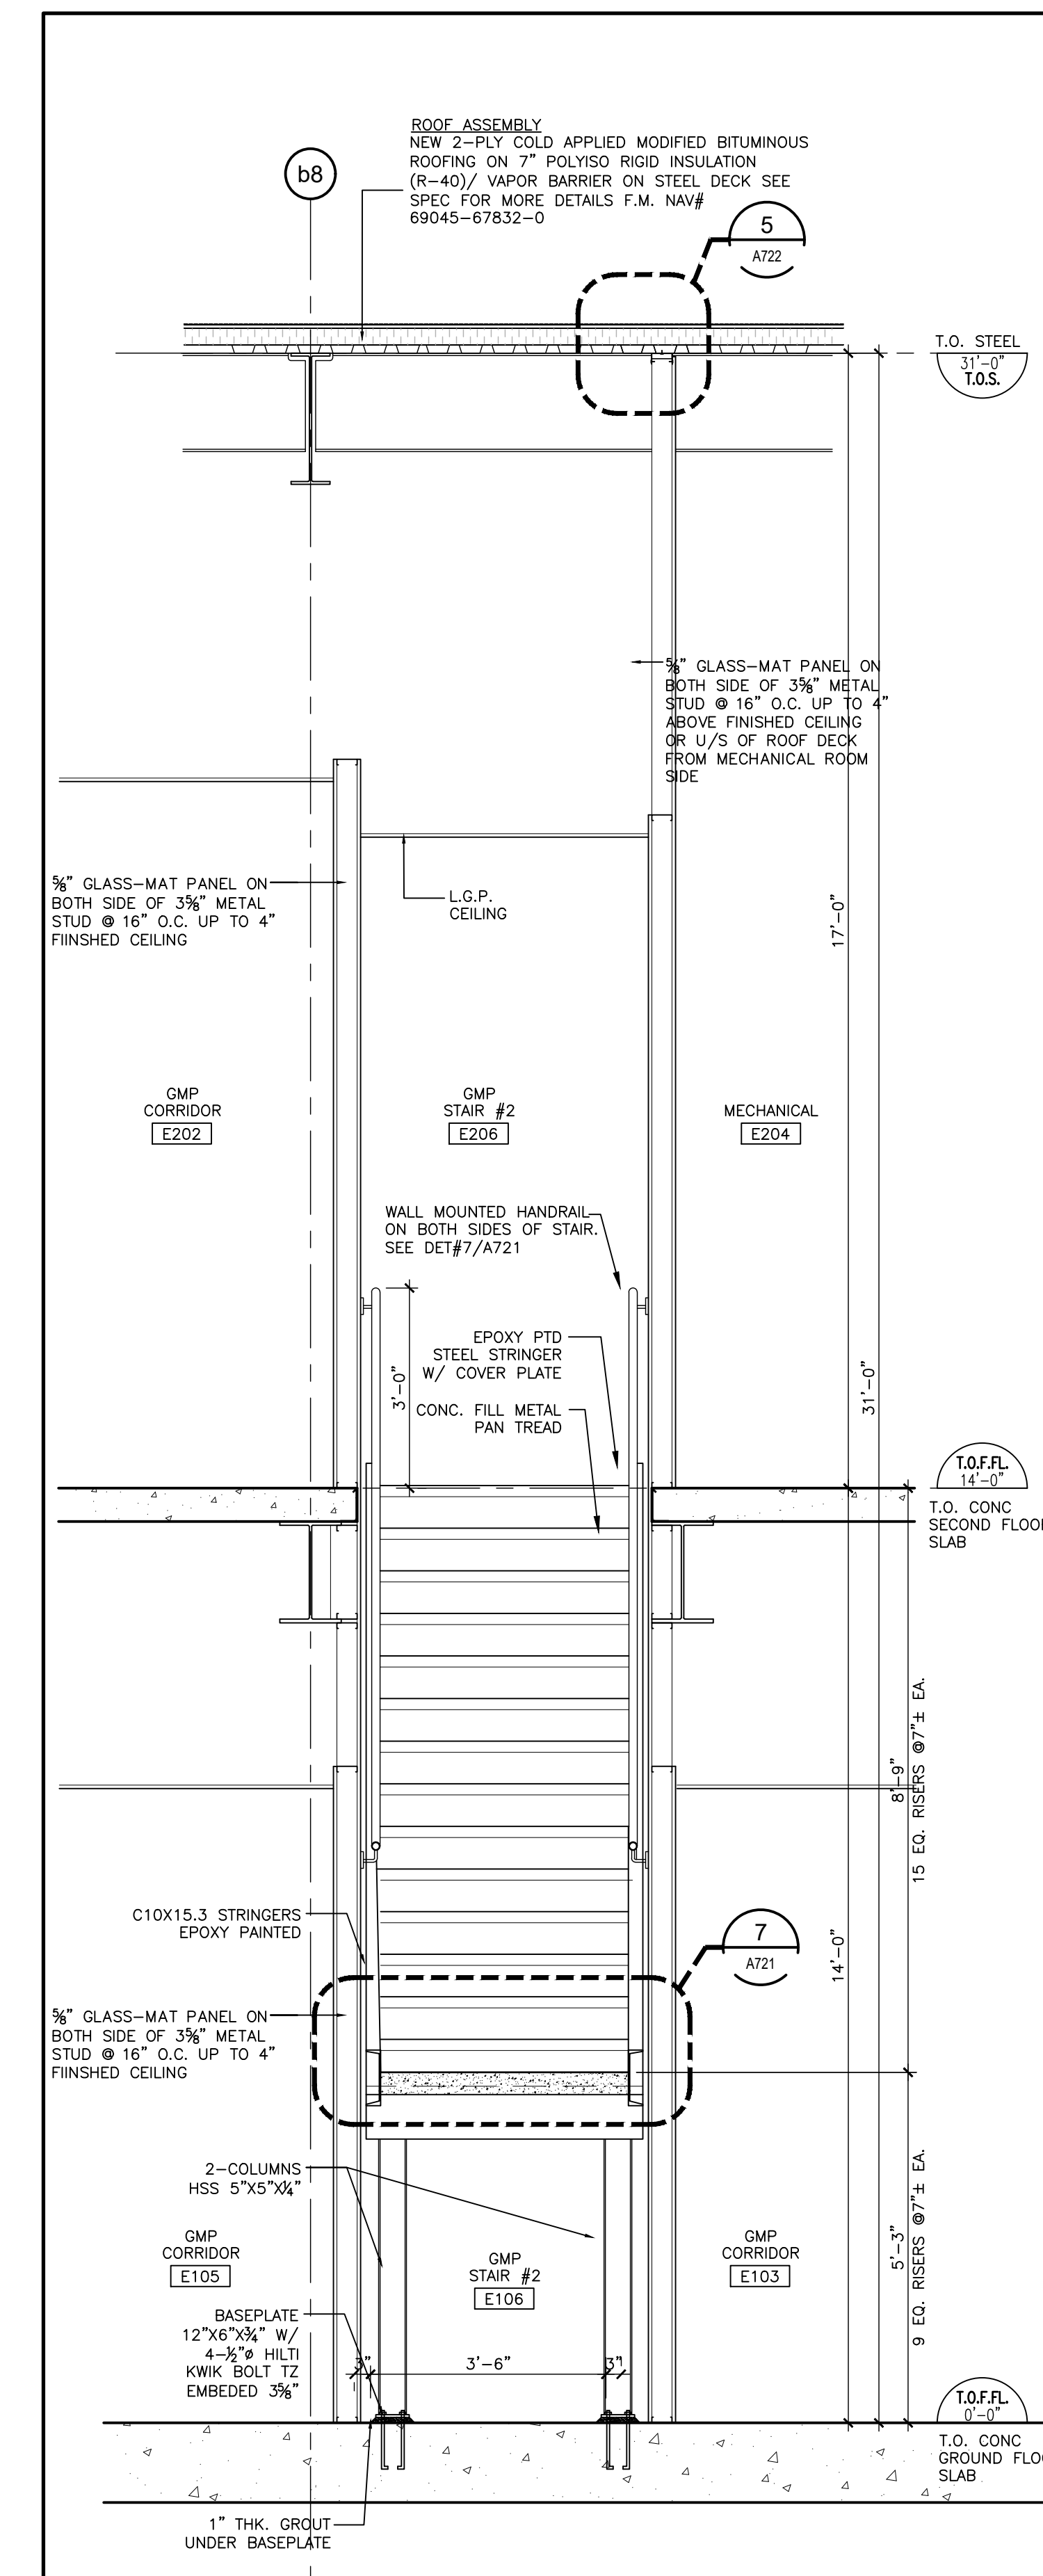

3
A722
1/2"=1'-0"

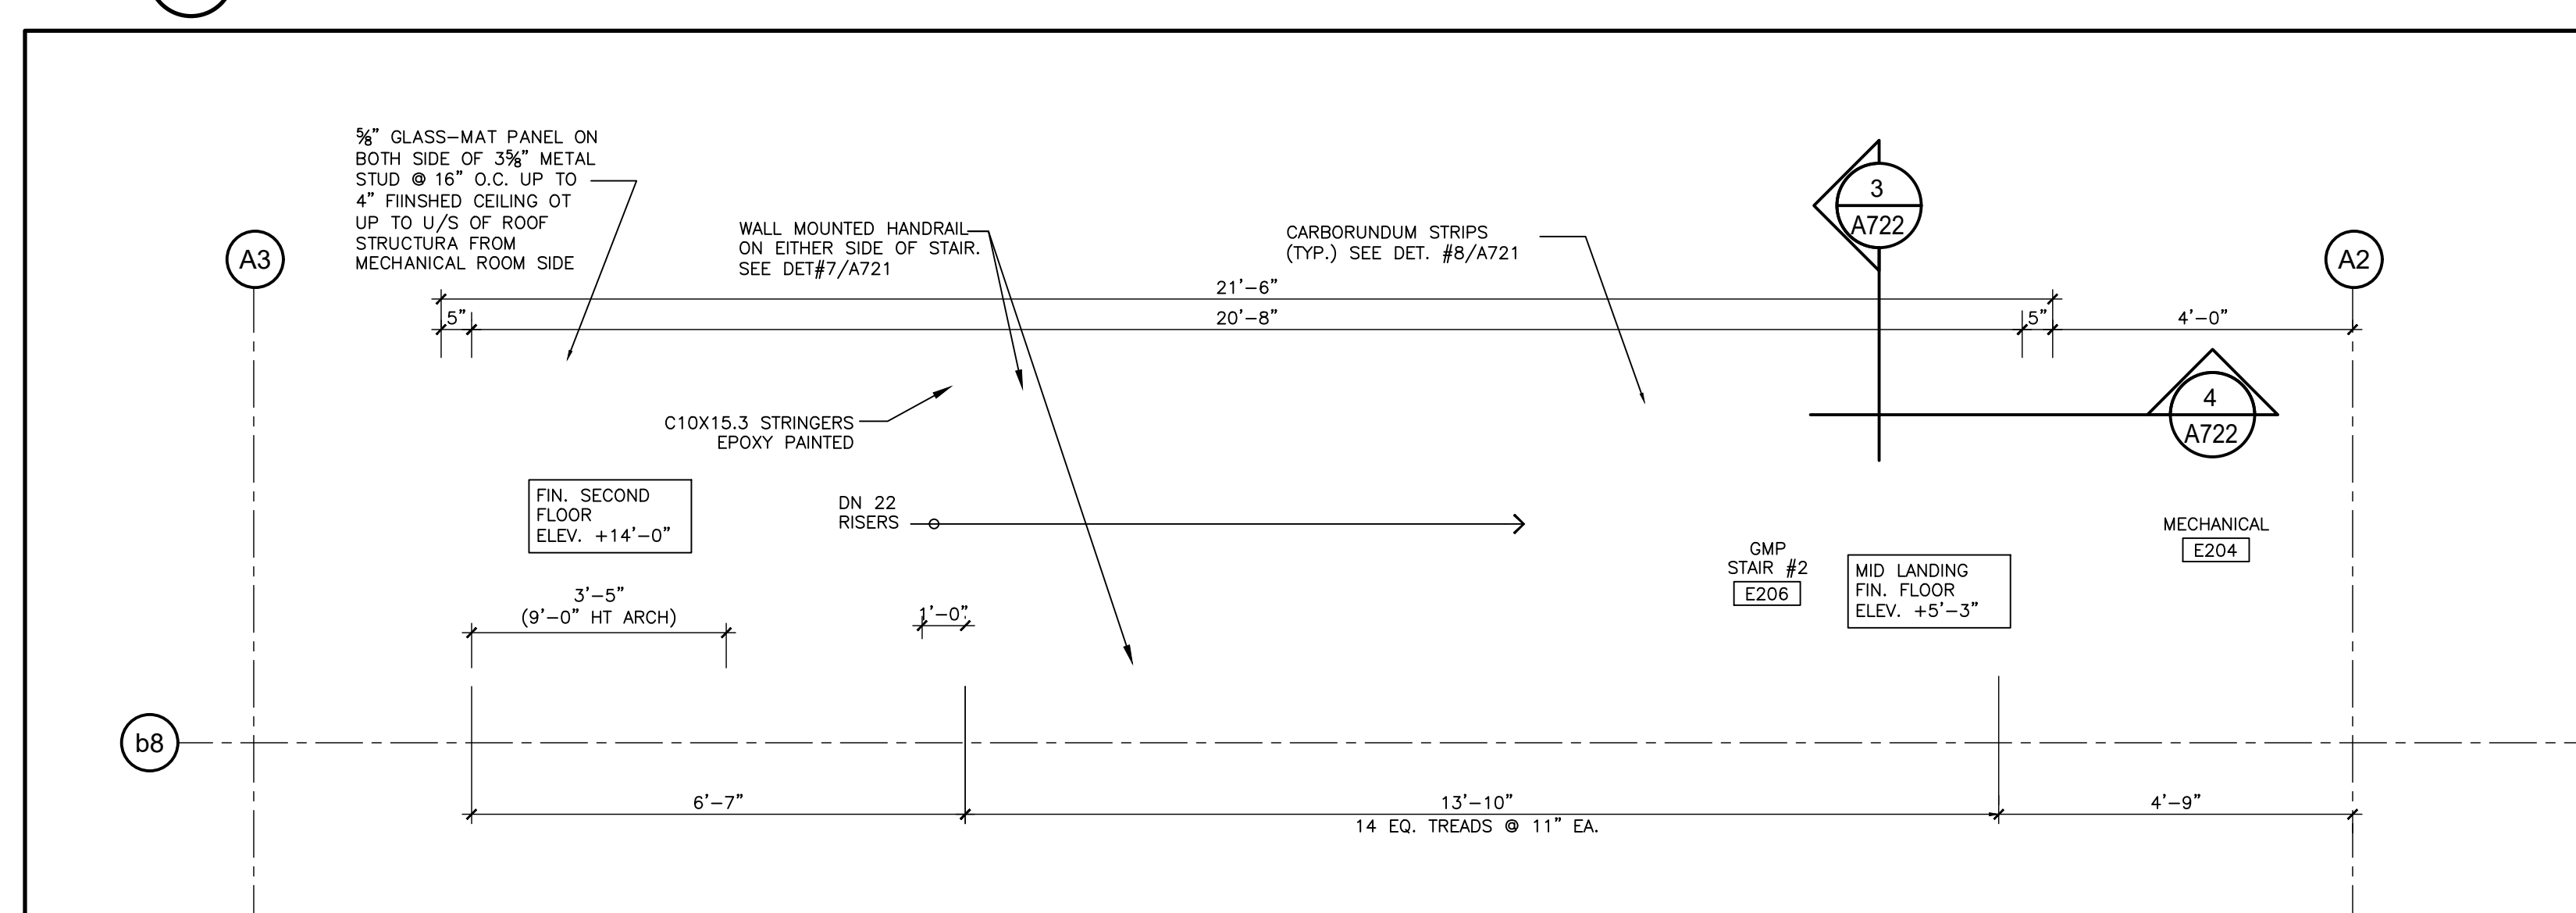

2
A722
1/2"=1'-0"

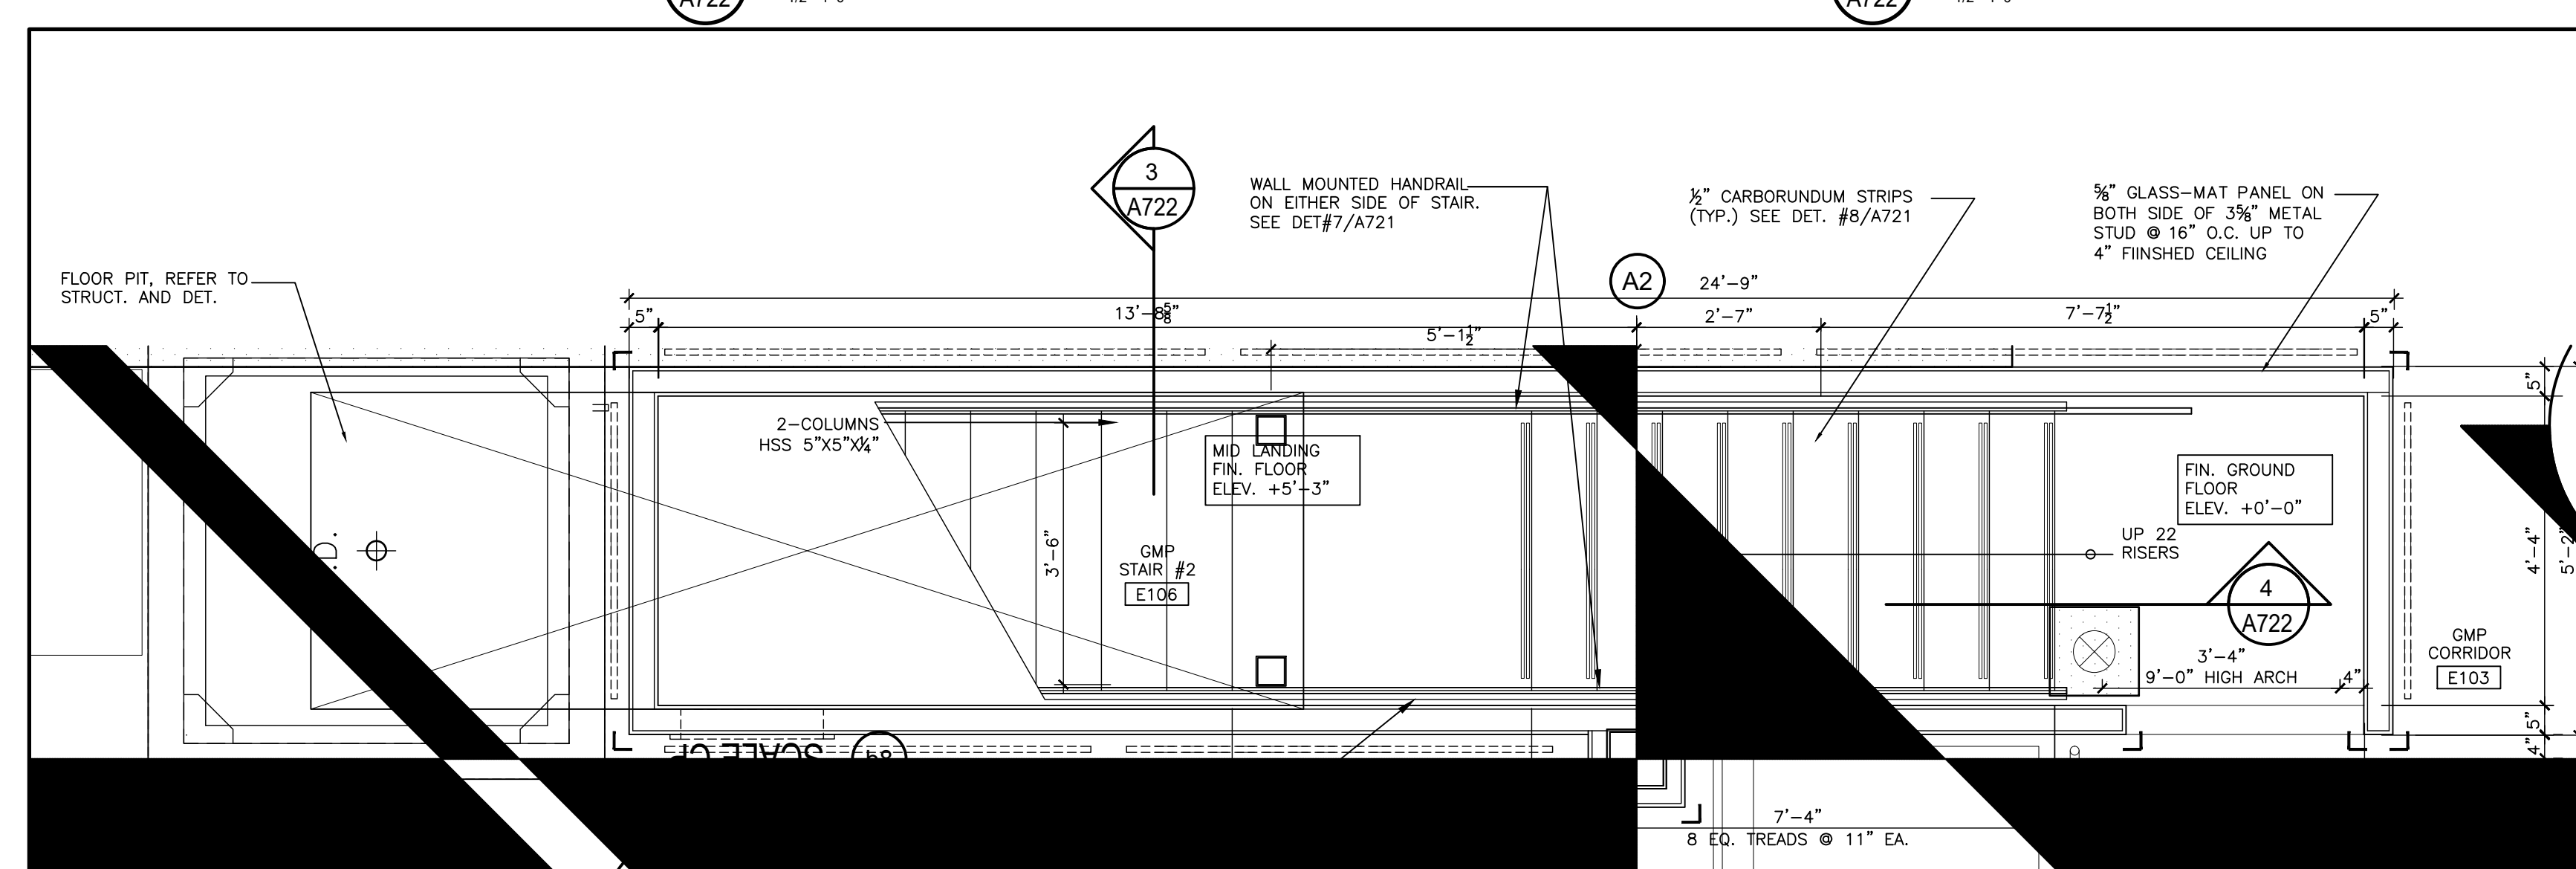



1
A722
1/2"=1'-0"

NOTES

These drawings are the property of, and shall not be used or reproduced without the consent of WBA Architects and Engineers Inc. The Contractor shall check and verify all dimensions and report all discrepancies to the Architect and/or Engineer.

PROJECT NORTH

TRUE NORTH

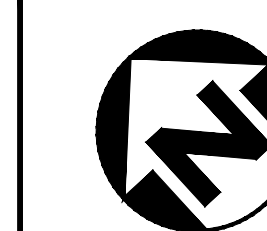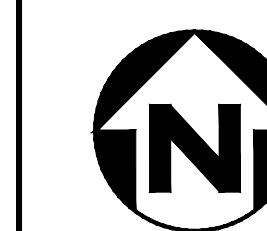

No.	Date	Issued	By:
A	2022-03-23	ISSUED FOR 75% DESIGN REVIEW	WBA
B	2022-04-06	ISSUED FOR 90% DESIGN REVIEW	WBA
C	2022-04-25	ISSUED FOR TENDER	WBA
D	2022-08-21	ISSUED FOR POST TENDER ADDENDUM#1	WBA

No.	Date	Revision	By:
1	2024-04-11	ISSUED FOR AS-BUILT	WBA
2	2022-07-13	ISSUED FOR CONSTRUCTION	WBA

No.	Date	Revision	By:
-----	------	----------	-----

No.	Date	Revision	By:
-----	------	----------	-----

ROOM SCHEDULE																												
		FLOOR	BASE			NORTH WALL			EAST WALL			SOUTH WALL			WEST WALL			WALL TO WALL COVE 1" RADIUS PLASTER	WALL TO WALL 3/4" LATEX COVE	WALL TO WALL 1/2" VINYL COVE	WALL TO WALL 1" POLY URETHANE COVE	CEILING						NOTES
ROOM NO.	ROOM NAME	MAT'L	MAT'L	4" EPOXY COVE 1" RADIUS	MATERIAL	FINISH	FIRE RATING	MATERIAL	FINISH	FIRE RATING	MATERIAL	FINISH	FIRE RATING	MATERIAL	FINISH	FIRE RATING	MATERIAL					FINISH	FIRE RATING	HEIGHT	WALL TO CEILING 3/4" LATEX COVE	WALL TO CEILING 1" POLY URETHANE COVE	PATCH AND MAKE GOOD EXISTING WHERE DAMAGED OR DISTURBED BY NEW CONTRUCTION	
MAIN LEVEL																												
E102	GMP CORRIDOR	TERR. 'B'	TERR. 'B'	YES	GYP. BRD.	W-1	—	GYP. BRD.	W-1	—	GYP. BRD.	W-1	—	GYP. BRD.	W-1	—	—	—	—	—	L.A.P.	—	—	9'-6 9'-8"	—	—		
E103	GMP CORRIDOR	TERR. 'B'	TERR. 'B'	YES	GYP. BRD.	W-1	—	GYP. BRD.	W-1	—	GYP. BRD.	W-1	—	GYP. BRD.	W-1	—	—	—	—	—	L.A.P.	—	—	9'-6"	—	—		
E104	GMP CORRIDOR	TERR. 'B'	TERR. 'B'	YES	GYP. BRD.	W-1	—	GYP. BRD.	W-1	—	GYP. BRD.	W-1	—	GYP. BRD.	W-1	—	—	—	—	—	L.A.P.	—	—	9'-6"	—	—		
E105	GMP CORRIDOR	TERR. 'B'	TERR. 'B'	YES	GYP. BRD.	W-1	—	GYP. BRD.	W-1	—	GYP. BRD.	W-1	—	GYP. BRD.	W-1	—	—	—	—	—	L.A.P.	—	—	9'-6 9'-10"	—	—		
E106	GMP STAIR #2	TERR. 'B'	TERR. 'B'	YES	GYP. BRD.	W-1	—	GYP. BRD.	W-1	—	GYP. BRD.	W-1	—	GYP. BRD.	W-1	—	—	—	—	—	GYP. BRD.	C-1	—	VARIES	YES	—	CARBORANDUM TREAD NOSING. SEE DETAIL #XX/XXX EPOXY PAINT WALL, RAILS, STRINGERS, AND RISERS.	
E107	STORAGE	TERR. 'B'	TERR. 'B'	YES	GYP. BRD.	W-2	—	GYP. BRD.	W-2	—	GYP. BRD.	W-1	1HR	GYP. BRD.	W-2	—	—	—	YES	—	L.A.P.	—	—	9'-6"	—	—		
E108	DIRTY PARTS	TERR. 'A'	TERR. 'A'	YES	GYP. BRD.	W-2	—	GYP. BRD.	W-2	—	GYP. BRD.	W-2	—	GYP. BRD.	W-2	—	—	—	YES	—	GYP. BRD.	C-1	—	9'-6"	—	—		
E109	WASH-UP ROOM	TERR. 'A'	TERR. 'A'	YES	GYP. BRD.	W-2	—	GYP. BRD.	W-2	—	GYP. BRD.	W-2	—	GYP. BRD.	W-2	—	—	—	YES	—	GYP. BRD.	C-1	—	9'-6"	—	—		
E110	DRYING PARTS	TERR. 'A'	TERR. 'A'	YES	GYP. BRD.	W-2	—	GYP. BRD.	W-2	—	GYP. BRD.	W-2	—	GYP. BRD.	W-2	—	—	—	YES	—	GYP. BRD.	C-1	—	9'-6"	—	—		
E111	MECH.	TERR. 'A'	TERR. 'A'	YES	GYP. BRD.	W-2	—	GYP. BRD.	W-2	—	GYP. BRD.	W-2	—	GYP. BRD.	W-2	—	—	—	YES	—	GYP. BRD.	C-1	—	9'-6"	—	—	WASHER PIT FLOOR AND WALLS TO BE EPOXY 'B'	
E112	PRE TOTE WASH	TERR. 'A'	TERR. 'A'	YES	GYP. BRD.	W-2	—	GYP. BRD.	W-2	—	GYP. BRD.	W-2	—	GYP. BRD.	W-2	—	—	—	YES	—	GYP. BRD.	C-1	—	9'-6"	—	—		
E113	POST TOTE WASH	TERR. 'A'	TERR. 'A'	YES	GYP. BRD.	W-2	—	GYP. BRD.	W-2	—	GYP. BRD.	W-2	—	GYP. BRD.	W-2	—	—	—	YES	—	GYP. BRD.	C-1	—	9'-6"	—	—		
E114	GMP STAIR #1	TERR. 'B'	TERR. 'B'	YES	GYP. BRD.	W-1	1HR	GYP. BRD.	W-1	1HR	GYP. BRD.	W-1	1HR	GYP. BRD.	W-1	1HR	—	—	—	YES	—	GYP. BRD.	C-1	—	VARIES	YES	CARBORANDUM TREAD NOSING. SEE DETAIL #XX/XXX EPOXY PAINT WALL, RAILS, STRINGERS, AND RISERS.	
E115	VESTIBULE	TERR. 'B'	TERR. 'B'	YES	GYP. BRD.	W-1	1HR	GYP. BRD.	W-1	1HR	GYP. BRD.	W-1	1HR	GYP. BRD.	W-1	1HR	—	—	—	YES	—	GYP. BRD.	C-1	—	9'-6"	YES		
E116	POST PART WASHER	TERR. 'A'	TERR. 'A'	YES	YWC	—	—	FRP	—	—	FRP	—	—	FRP	—	—	—	—	YES	YES	GYP. BRD.	C-1	—	9'-6"	—	YES	BLACK/BROWN COLOUR TERR. FLOORING-SEE SPEC. OMIT	
E117	MECH	EPOXY 'A'	EPOXY 'A'	YES	YWC	—	—	FRP	—	—	FRP	—	—	FRP	—	—	—	—	YES	YES	GYP. BRD.	C-1	—	9'-6"	—	YES	WASHER PIT TO RECEIVE EPOXY 'A' OMIT	
E118	PRE PART WASHER	TERR. 'A'	TERR. 'A'	YES	YWC	—	—	FRP	—	—	FRP	—	—	FRP	—	—	—	—	YES	YES	GYP. BRD.	C-1	—	9'-6"	—	YES	BLACK/BROWN TERR. FLOORING COLOUR-SEE SPEC. OMIT	
E119	TOTE TUMBLER	TERR. 'A'	TERR. 'A'	YES	GYP. BRD.	W-2	—	GYP. BRD.	W-2	—	GYP. BRD.	W-2	—	GYP. BRD.	W-2	—	—	—	YES	—	GYP. BRD.	C-1	—	9'-6"	—	—		
E120	AIRLOCK	TERR. 'A'	TERR. 'A'	YES	GYP. BRD.	W-2	—	GYP. BRD.	W-2	—	GYP. BRD.	W-2	—	GYP. BRD.	W-2	—	—	—	YES	—	GYP. BRD.	C-1	—	9'-8"	—	—		
E121	AIRLOCK	TERR. 'B'	TERR. 'B'	YES	GYP. BRD.	W-2	—	GYP. BRD.	W-2	—	GYP. BRD.	W-2	—	GYP. BRD.	W-2	—	—	—	YES	—	GYP. BRD.	C-1	—	9'-6"	—	—	GREY COLOUR TERR. FLOORING. SEE SPEC.	
E122	TABLETING No.1	TERR. 'B'	TERR. 'B'	YES	GYP. BRD.	W-2	—	GYP. BRD.	W-2	—	GYP. BRD.	W-2	—	GYP. BRD.	W-2	—	—	—	YES	—	GYP. BRD.	C-1	—	10'-6 11'-4"	—	—		
E123	TABLETING No.2	TERR. 'B'	TERR. 'B'	YES	GYP. BRD.	W-2	—	GYP. BRD.	W-2	—	GYP. BRD.	W-2	—	GYP. BRD.	W-2	—	—	—	YES	—	GYP. BRD.	C-1	—	10'-6 11'-4"	—	—	GREY COLOUR TERR. FLOORING. SEE SPEC.	
E124	WORK ROOM	TERR. 'B'	TERR. 'B'	YES	GYP. BRD.	W-2	—	GYP. BRD.	W-2	—	GYP. BRD.	W-2	—	GYP. BRD.	W-2	—	—	—	YES	—	GYP. BRD.	C-1	—	9'-6"	—	—		
E129	SERVICE ROOM	EPOXY 'B'	EPOXY 'B'	YES	GYP. BRD.	PT	—	CONC. BLK.	PT	1 HR	CONC. BLK.	PT	1 HR	EXPOSED STRUCTURE	PT STRUCT.	—	—	—	—	—	EXPOSED STRUCTURE	PT STRUCT.	—	14'-0"	—	—	PAINT SECOND FLOOR STEEL, FLOOR DECK AND EXPOSED STEEL STRUCTURE FLOOR AND WALLS OF PITS EPOXY 'B'	
E127	FUTURE TABLETING No.3	TERR. 'B'	TERR. 'B'	YES	GYP. BRD.	W-2	—	GYP. BRD.	W-2	—	GYP. BRD.	W-2	—	GYP. BRD.	W-2	—	—	—	YES	—	GYP. BRD.	C-1	—	10'-6 11'-4"	—	—		
E128	ELEVATOR MACHINE	EPOXY 'B'	EPOXY 'B'	YES	CONC. BLK.	PT	1 HR	CONC. BLK.	PT	1 HR	CONC. BLK.	PT	1 HR	CONC. BLK.	PT	1 HR	—	—	—	—	—	EXPOSED STRUCTURE	PT STRUCT.	—	14'-0"	—	PAINT SECOND FLOOR STEEL, FLOOR DECK AND EXPOSED STEEL STRUCTURE	
E126	ELEVATOR SHAFT	EPOXY 'A' (PIT)	—	—	PLST. FLT.	PT	1 HR	PLST. FLT.	PT	1 HR	PLST. FLT.	PT	1 HR	PLST. FLT.	PT	1 HR	—	—	—	—	—	—	—	14'-0"	—	—	SEE SPECIFICATIONS FOR PLASTER FLOAT FINISH TO WALLS. EPOXY PAINT WALL, RAILS, STRINGERS, AND RISERS. BLACK/BROWN COLOUR EPOXY ON PIT	
127A	EXISTING STAIR	EPOXY 'C'	EPOXY 'C'	YES	GYP. BRD.	W-1	—	GYP. BRD.	W-1	—	GYP. BRD.	W-1	—	GYP. BRD.	W-1	—	—	—	YES	—	GYP. BRD.	C-1	—	9'-6"	YES	—		
B155	EXIST. GMP CORRIDOR	PATCH TERR.	PATCH TERR.	YES	GYP. BRD.	W-1	1 HR	PATCH GYP. BRD.	W-1	—	—	—	—	PATCH GYP. BRD.	—	—	—	—	—	L.A.P.	—	—	MATCH EXIST.	—	—	MATCH EXISTING CEILING GRID.		
SECOND LEVEL																												
E202	GMP CORRIDOR	TERR. 'B'	TERR. 'B'	YES	GYP. BRD.	W-1	—	GYP. BRD.	W-1	—	GYP. BRD.	W-1	1 HR	GYP. BRD.	W-1	—	—	—	—	—	L.A.P.	—	—	10'-5"	—	—		
E203	GMP CORRIDOR	TERR. 'B'	TERR. 'B'	YES	GYP. BRD.	W-1	—	GYP. BRD.	W-1	—	GYP. BRD.	W-1	—	GYP. BRD.	W-1	—	—	—	—	—	L.A.P.	—	—	10'-5"	—	—		
E204	MECHANICAL	EPOXY 'B'	EPOXY 'B'	YES	EXPOSED STRUCTURE	PT	—	EXPOSED STRUCTURE	PT	—	GYP. BRD.	PT	1 HR	GYP. BRD.	PT	—	—	—	—	—	EXPOSED STRUCTURE	PT	—	16'-7"	—	—	EPOXY FLOOR OVER HOUSE KEEPING PADS. PAINT ALL EXPOSED STEEL AND ROOF DECK.	
E206	GMP STAIR #2	TERR. 'B'	TERR. 'B'	YES	GYP. BRD.	W-1	—	GYP. BRD.	W-1	—	GYP. BRD.	W-1	—	GYP. BRD.	W-1	—	—	—	—	—	L.A.P.	—	—	9'-0"	—	—	CARBORANDUM TREAD NOSING. SEE DETAIL #XXXXXX EPOXY PAINT WALL, RAILS, STRINGERS, AND RISERS.	
E208	BIN DISCHARGE	TERRA 'A'	TERRA 'A'	YES	GYP. BRD.	W-2	—	GYP. BRD.	W-2	—	GYP. BRD.	W-2	—	GYP. BRD.	W-2	—	—	—	YES	—	GYP. BRD.	C-1	—	10'-0	—	—		
E209	AIRLOCK	TERRA 'A'	TERRA 'A'	YES	GYP. BRD.	W-2	—	GYP. BRD.	W-2	—	GYP. BRD.	W-2	—	GYP. BRD.	W-2	—	—	—	YES	—	GYP. BRD.	C-1	—	10'-0	—	—		
E210	TAB DISCHARGE No.1	TERR. 'B'	TERR. 'B'	YES	GYP. BRD.	W-2	—	GYP. BRD.	W-2	—	GYP. BRD.	W-2	—	GYP. BRD.	W-2	—	—	—	YES	—	GYP. BRD.	C-1	—	10'-0	—	—		
E211	TAB DISCHARGE No.2	TERR. 'B'	TERR. 'B'	YES	GYP. BRD.	W-2	—	GYP. BRD.	W-2	—	GYP. BRD.	W-2	—	GYP. BRD.	W-2	—	—	—	YES	—	GYP. BRD.	C-1	—	10'-0	—	—		
E212	FUTURE TAB DISCHARGE No.3	TERR. 'B'	TERR. 'B'	YES	GYP. BRD.	W-2	—	GYP. BRD.	W-2	—	GYP. BRD.	W-2	—	GYP. BRD.	W-2	—	—	—	YES	—	GYP. BRD.	C-1	—	10'-0	—	—		
E213	GMP CORRIDOR	TERR. 'B'	TERR. 'B'	YES	GYP. BRD.	W-1	—	GYP. BRD.	W-1	—	GYP. BRD.	W-1	—	GYP. BRD.	W-1	1HR	—	—	—	—	L.A.P.	—	—	10'-5"	—	—		
E214	GMP STAIR #1	TERR. 'B'	TERR. 'B'	YES	GYP. BRD.	W-1	1HR	GYP. BRD.	W-1	1HR	GYP. BRD.	W-1	1HR	GYP. BRD.	W-1	1HR	—	—	—	—	L.A.P.	—	—	9'-0"	—	—	CARBORANDUM TREAD NOSING. SEE DETAIL #XX/XXX EPOXY PAINT WALL, RAILS, STRINGERS, AND RISERS.	
E226	ELEVATOR SHAFT	—	—	—	PLST. FLT.	PT	1 HR	PLST. FLT.	PT	1 HR	PLST. FLT.	PT	1 HR	PLST. FLT.	PT	1 HR	—	—	—	—	—	EXPOSED STRUCTURE	PT	—	16'-7"	—	PAINT ROOF STEEL AND DECK. SEE SPECIFICATIONS FOR PLASTER FLOAT FINISH TO WALLS.	
202A	CORRIDOR	PATCH EPOXY 'C'	PATCH EPOXY 'C'	YES	PATCH GYP. BRD.	W-1	1HR	PATCH GYP. BRD.	W-1	—	—	—	—	PATCH GYP. BRD.	W-1	—	—	—	—	—	L.A.P. TO MATCH	—	—	TO MATCH	—	—	PATCH AND MAKE GOOD TO MATCH EXISTING CONSTRUCTION AND FINISHES.	
227A	STAIR	EPOXY 'A' DOOR OPNG	—	—	NEW DOOR OPENING	PT	1 HR.	EXIST.	—	1 HR.	EXIST.	—	1 HR.	EXIST.	—	1 HR.	—	—	—	—	EXPOSED STRUCTURE	—	—	—	—	—	PATCH AND MAKE GOOD AT NEW DOOR OPENING TO MATCH EXISTING CONSTRUCTION AND FINISHES * RE-COAT TREAD RISERS AND INTERMEDIATE LANDING AS PER TOP AND BOTTOM LANDING	
228A	VESTIBULE	EXIST.	VINYL TO NEW	—	EXIST.	—	1 HR.	EXIST.	W-1	—	EXIST.	W-1	—	GYP. BRD.	PT	—	—	—	—	—	L.A.P.	—	—	9'-0"	—	—		
E215	TOTE WASHER PLATFORM	S/S	—	—	PRE-FIN	—	—	PRE-FIN	—	—	PRE-FIN	—	—	PRE-FIN	—	—	—	—	—	—	EXPOSED STRUCTURE	—	—	16'-7"	—	—	GYP. BOARD FINISH 2ND FLR. TO CLG. BELOW AND PERIMETER BULKHEAD PAINT FINISH	

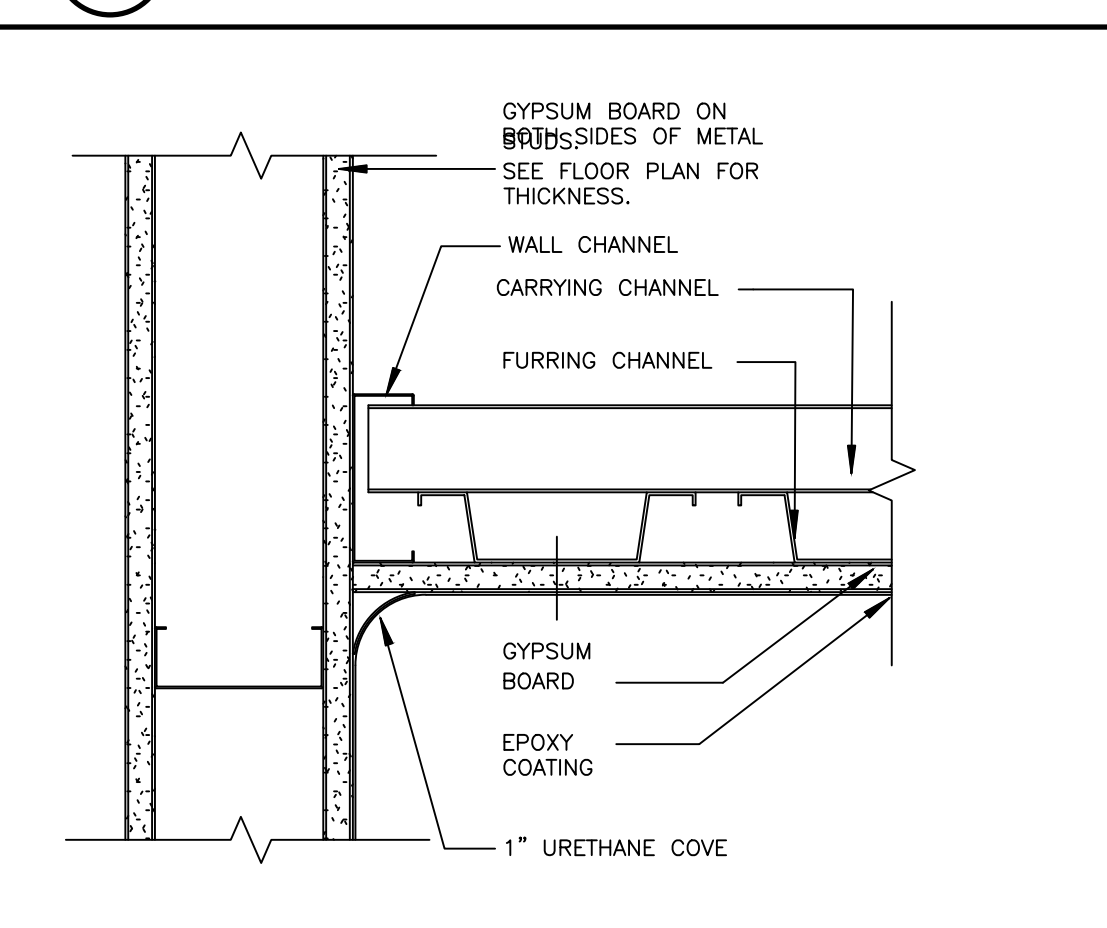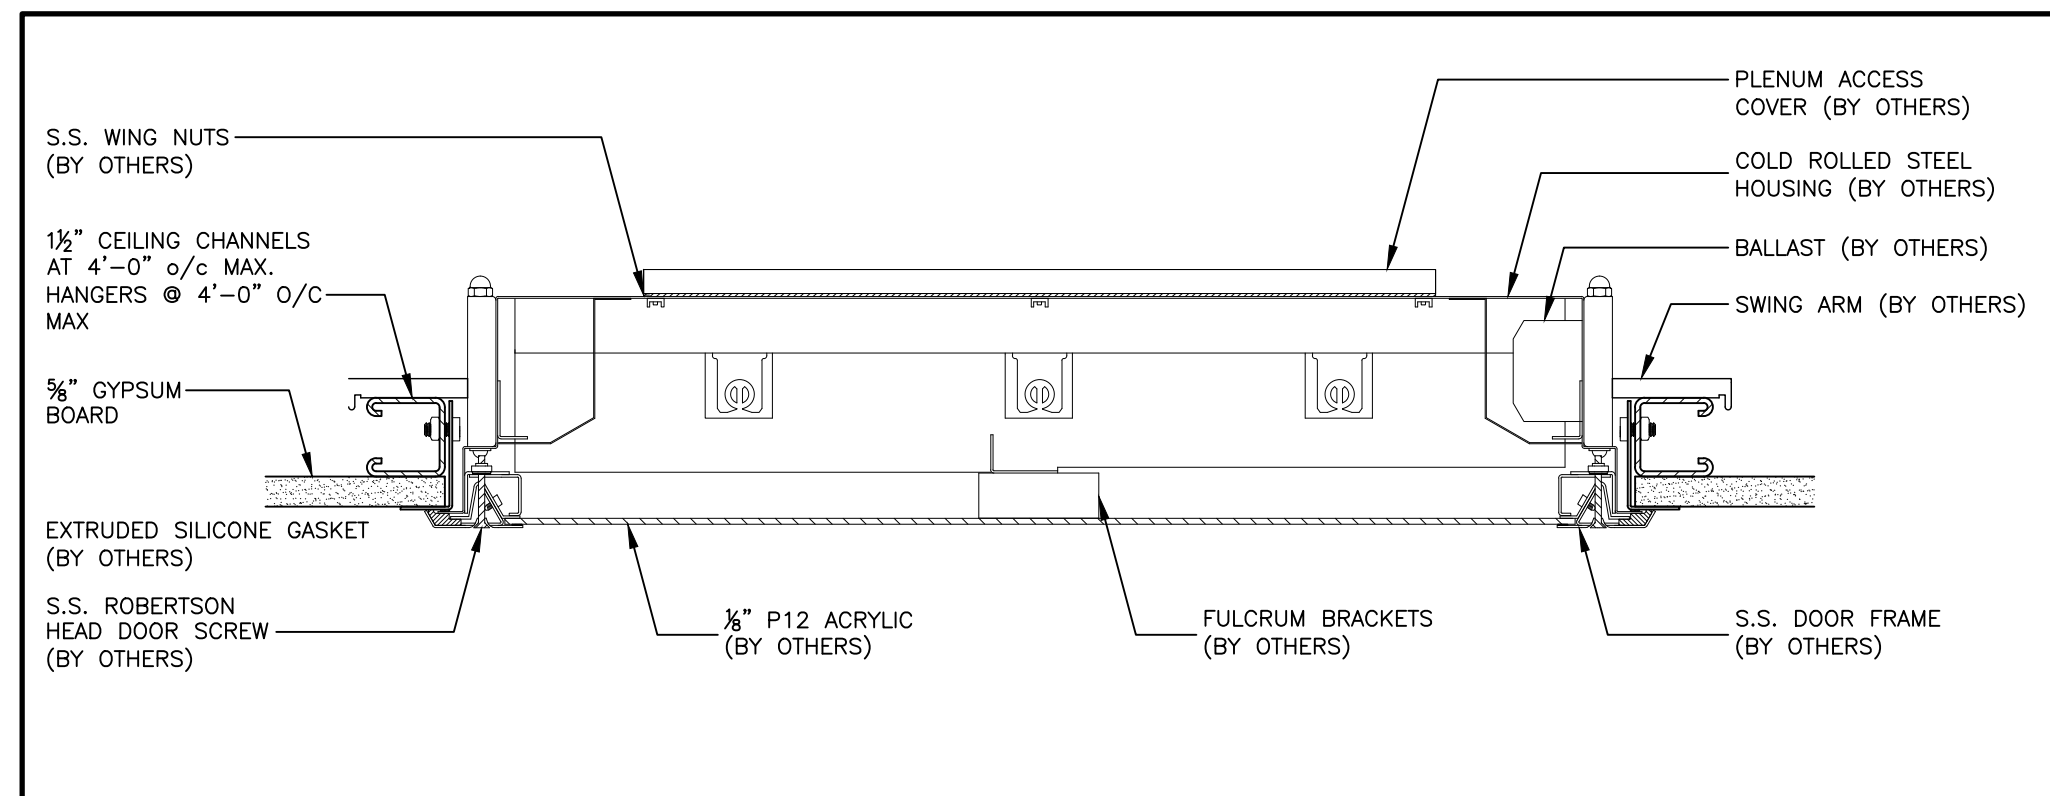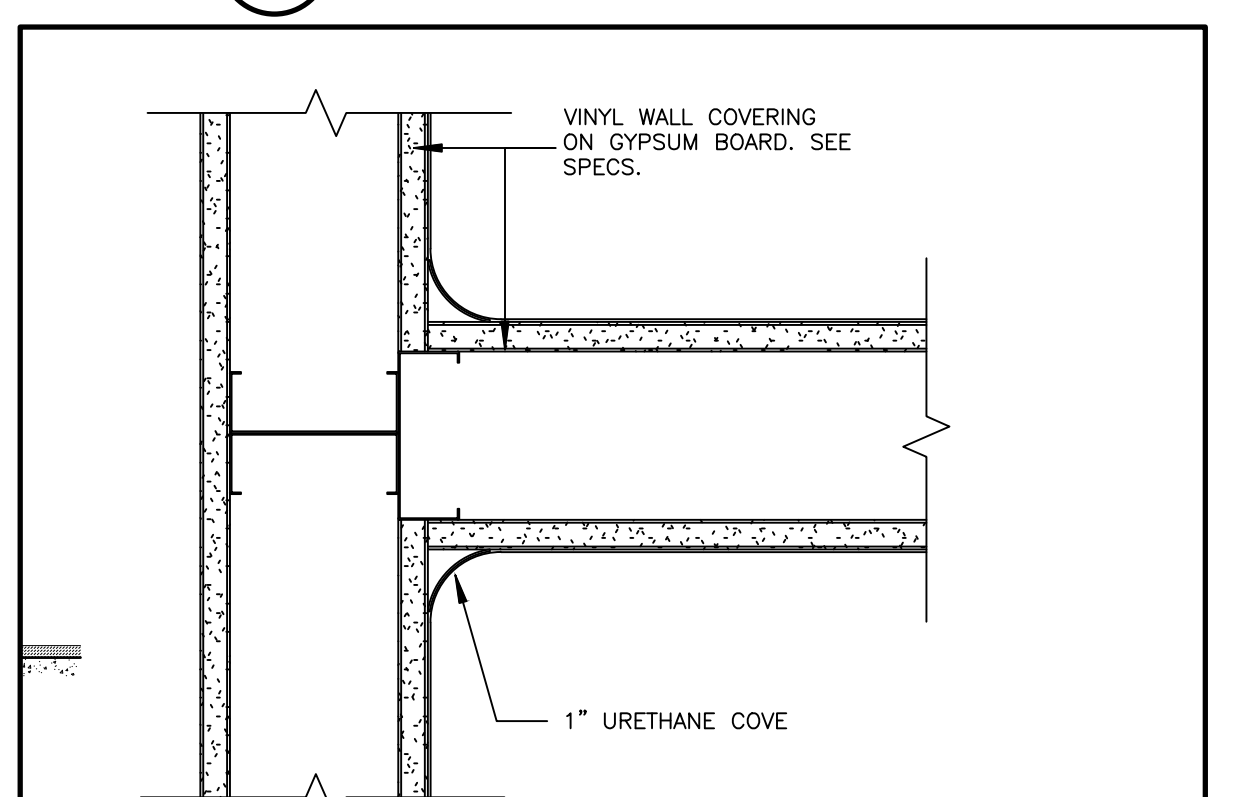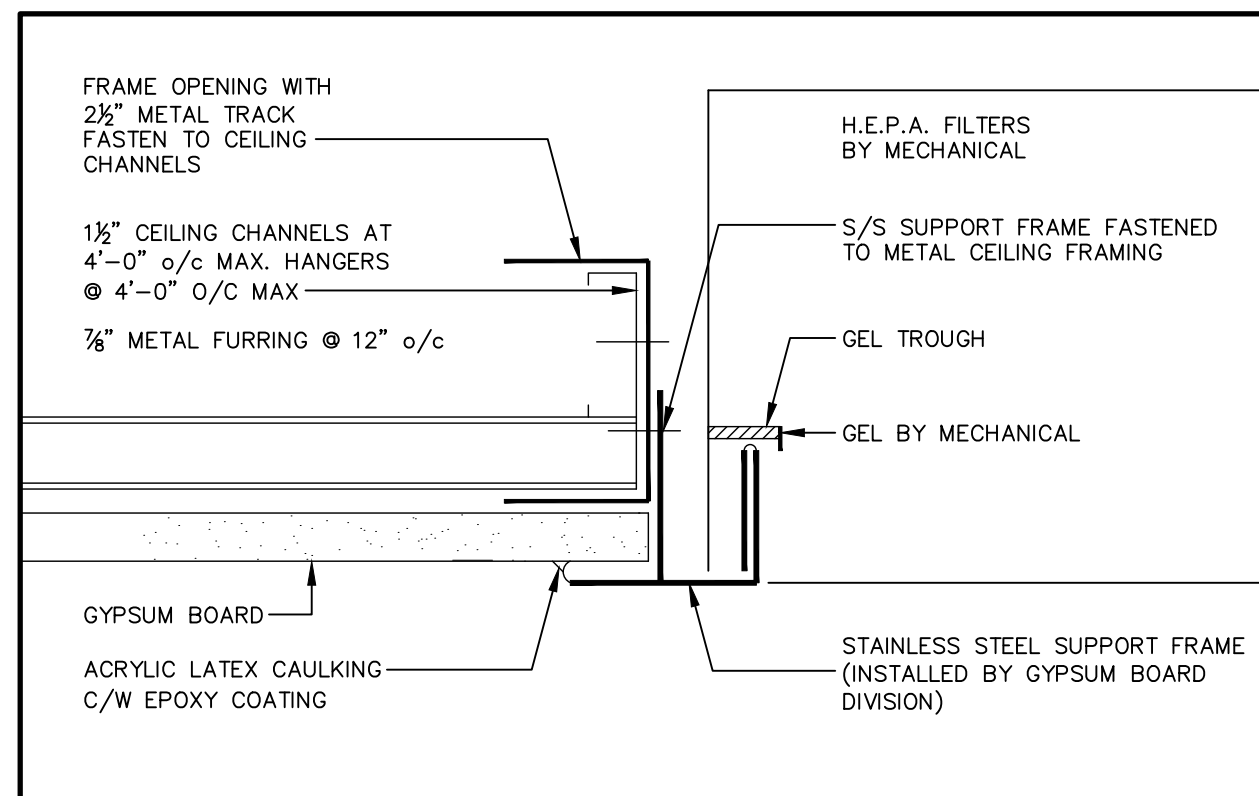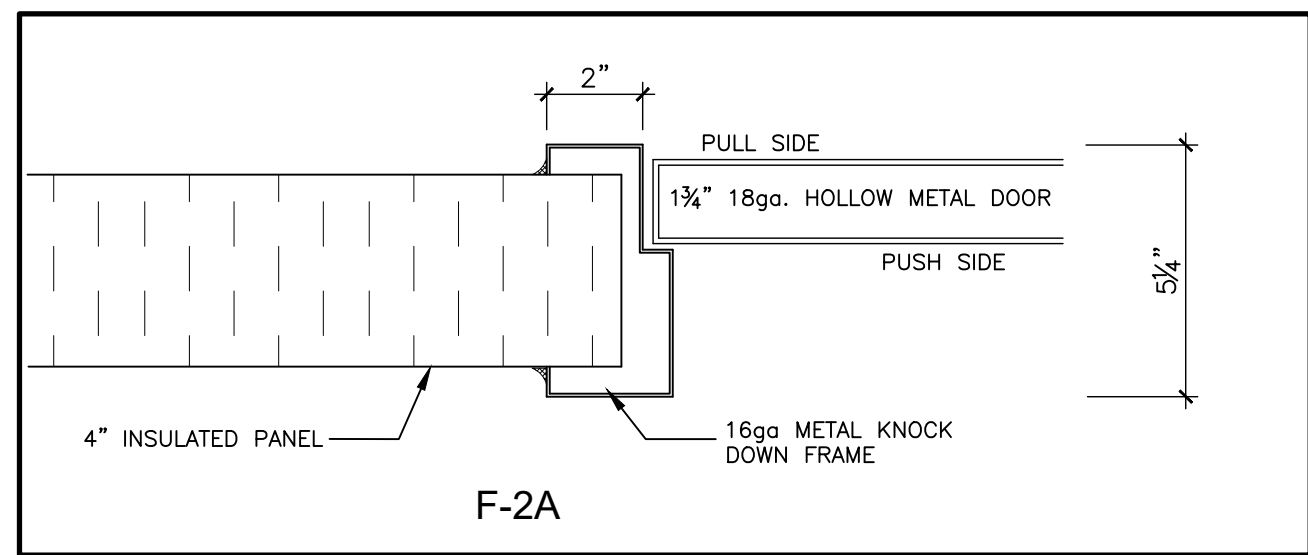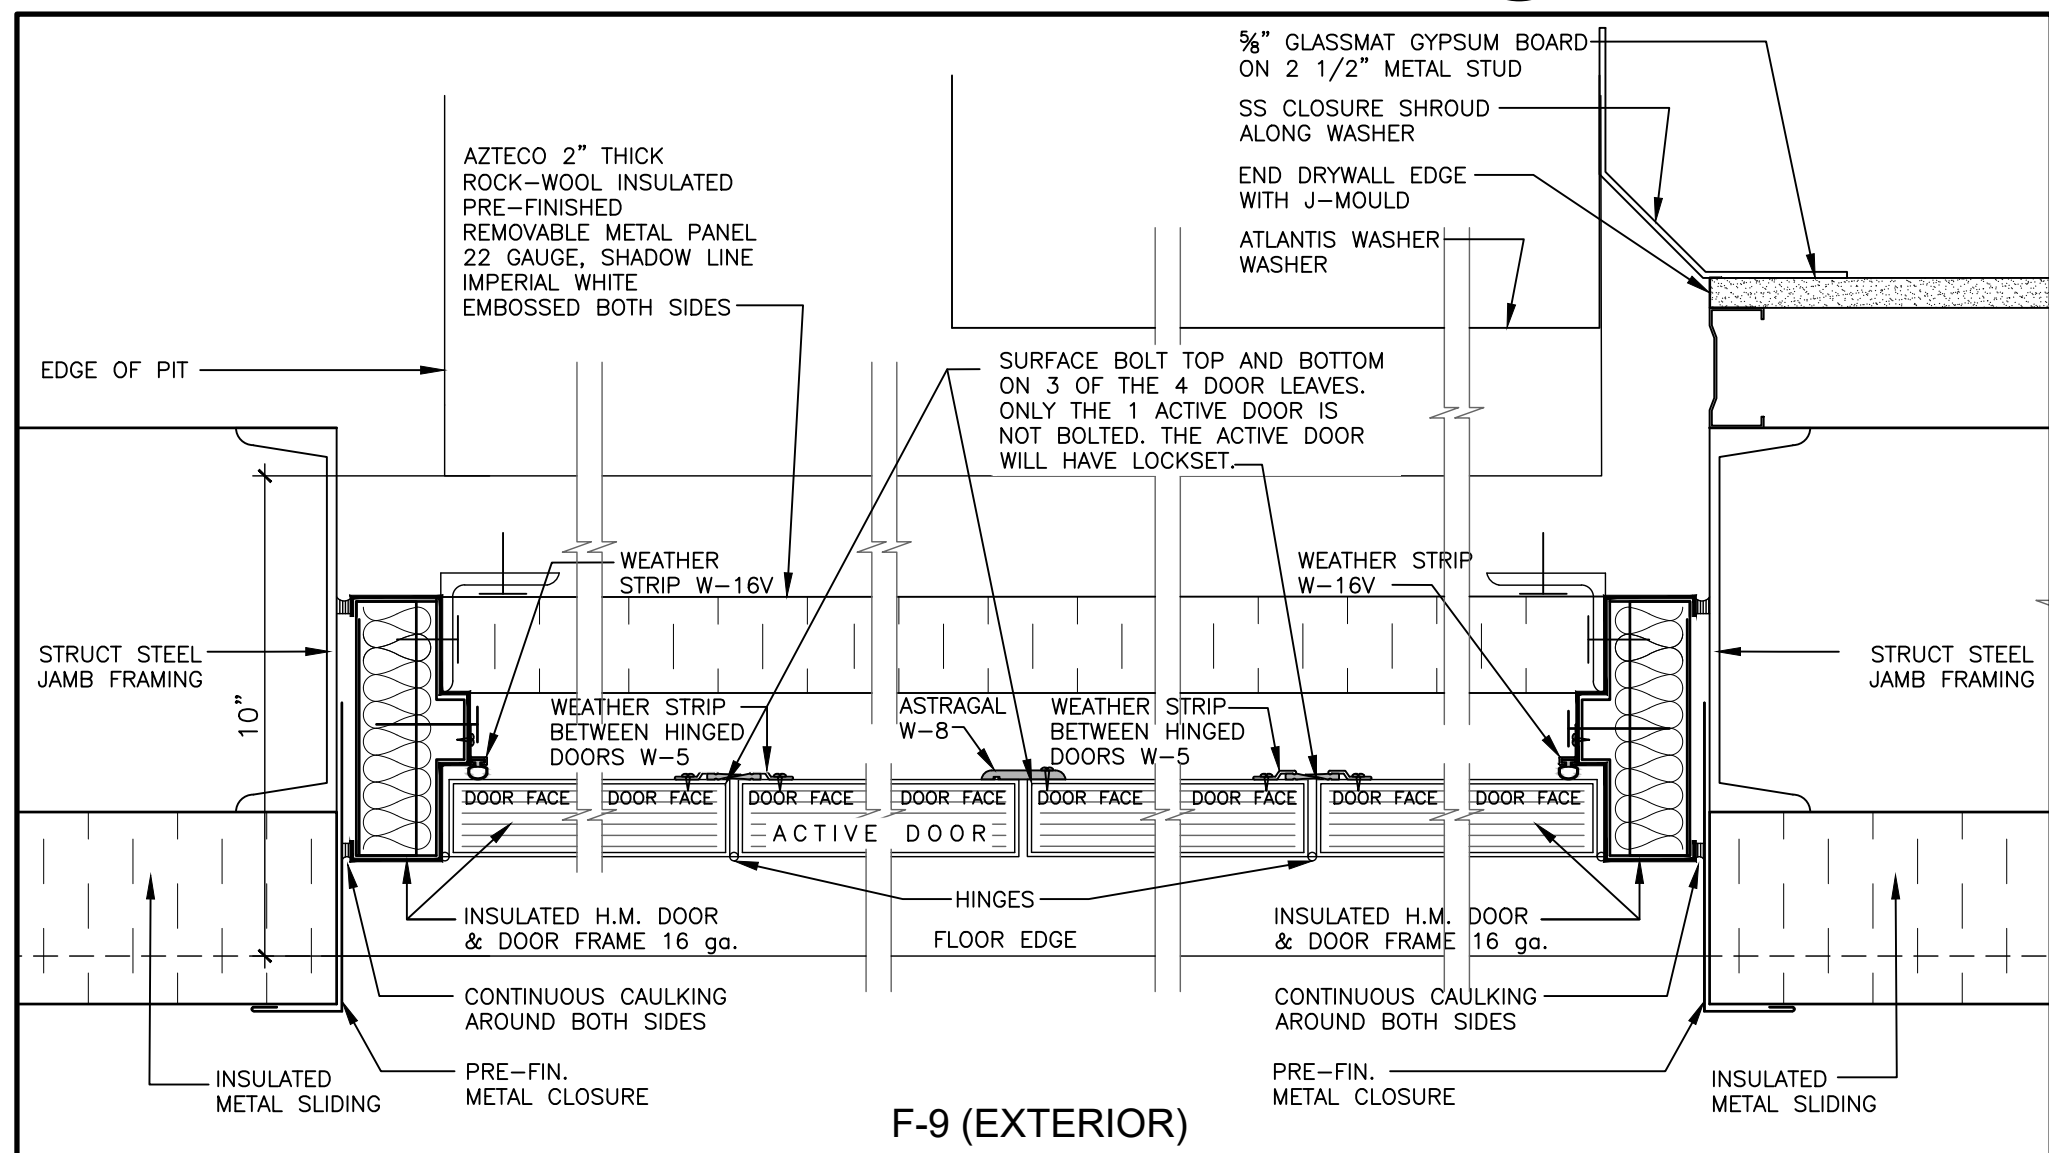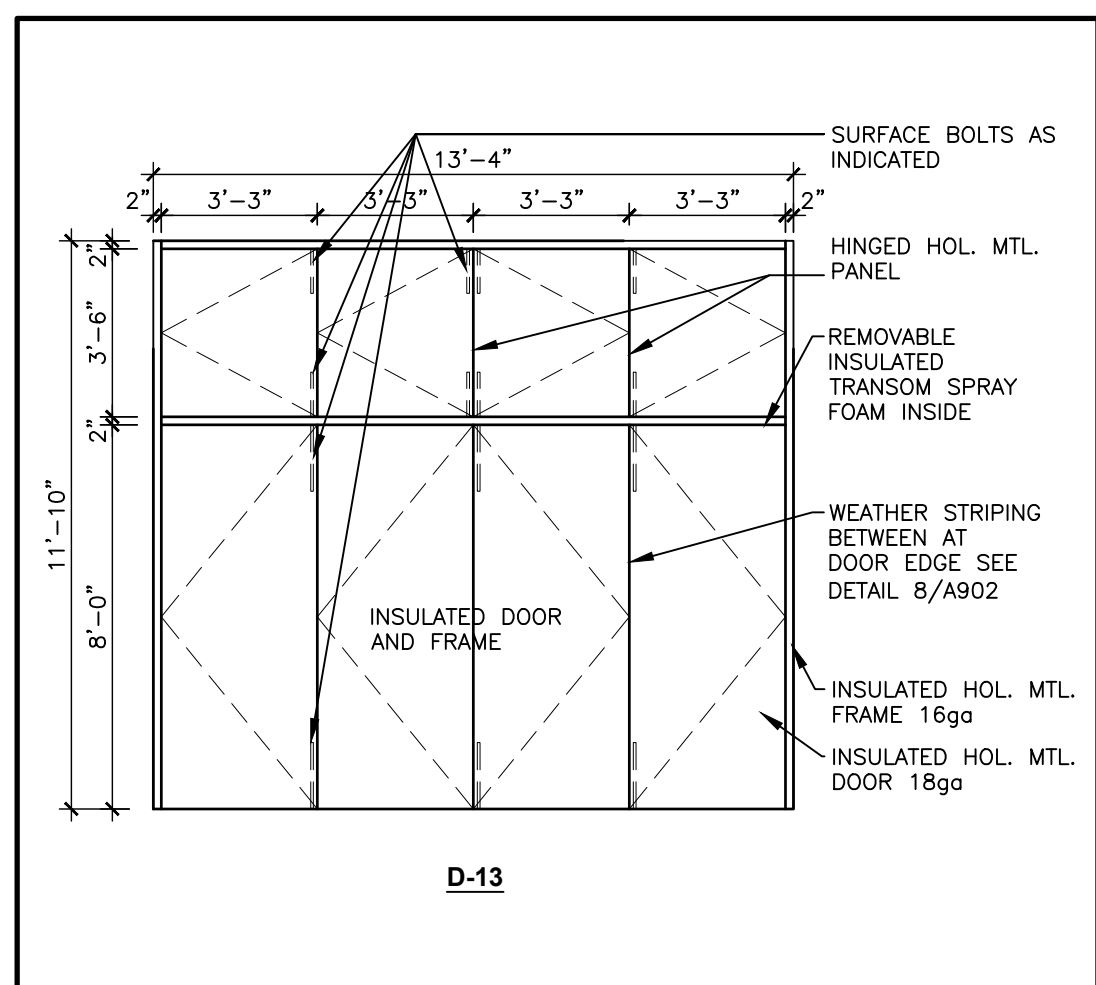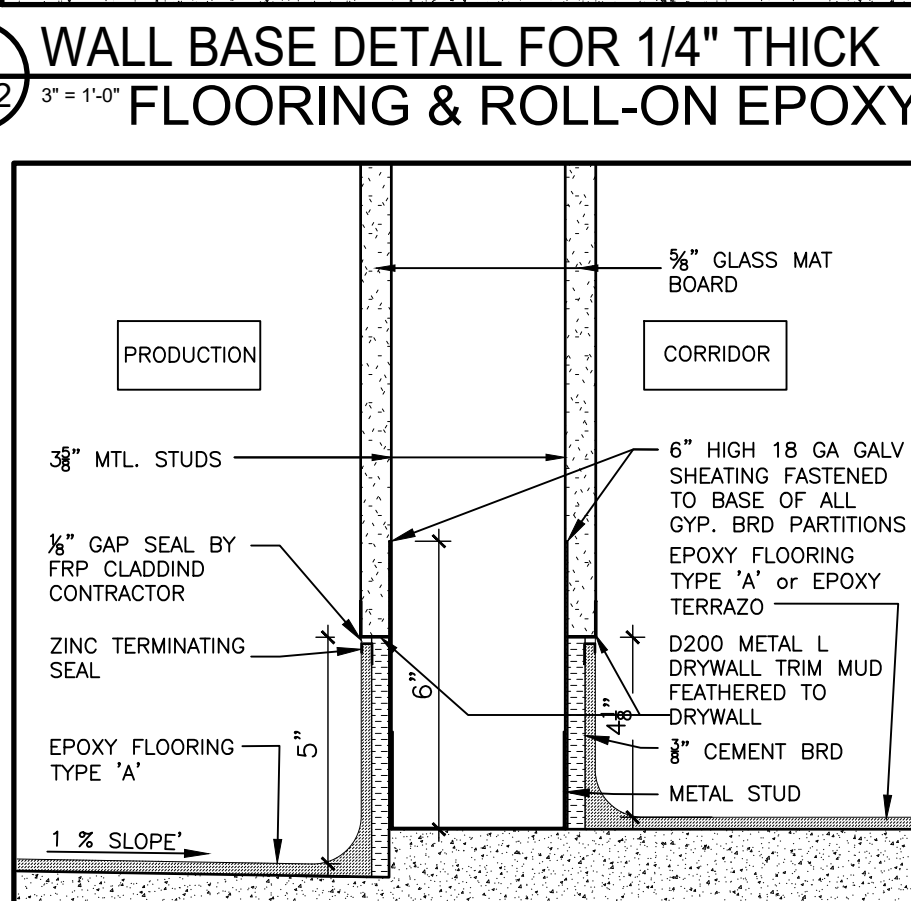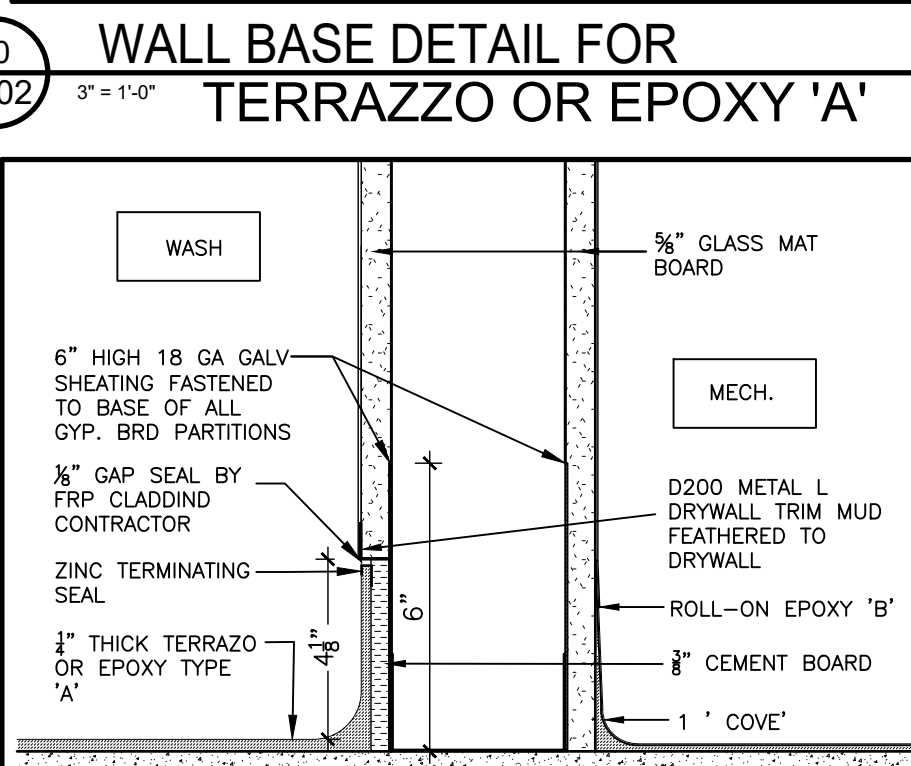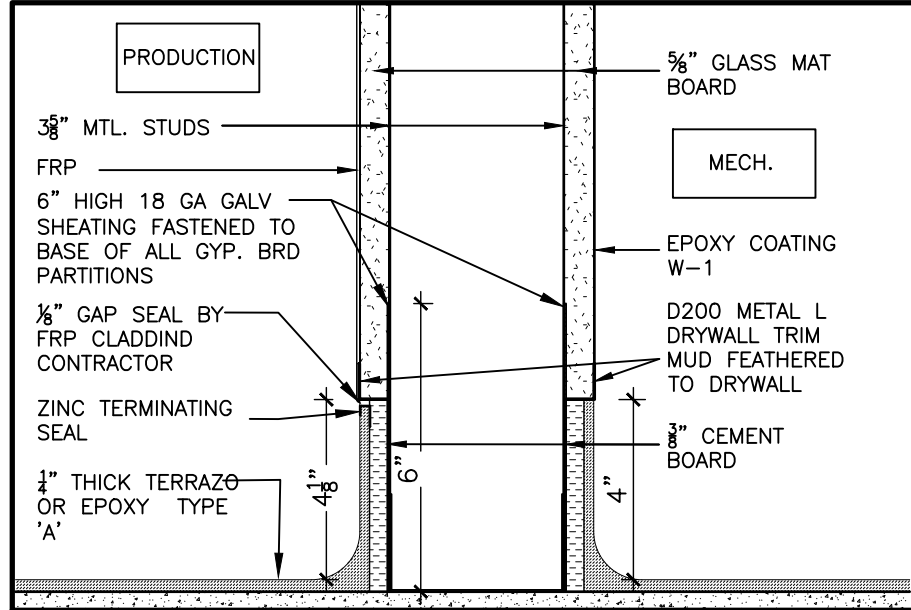

NOTES

These drawings are the property of, and shall not be used or reproduced without the consent of WBA Architects and Engineers Inc. The Contractor shall check and verify all dimensions and report all discrepancies to the Architect and/or Engineer.

No.	Date	Issued	By
A	2022-03-14	ISSUED FOR COORDINATION	WBA
B	2022-03-23	ISSUED FOR 75% DESIGN REVIEW	WBA
C	2022-04-08	ISSUED FOR 90% DESIGN REVIEW	WBA
D	2022-04-29	ISSUED FOR TENDER	WBA
E	2022-04-21	ISSUED FOR POST TENDER ADDENDUM #1	WBA
F	2023-02-27	ISSUED FOR COORDINATION	WBA

ABBREVIATIONS

ACST. - ACUSTIC
A.F.S. - ASHFORD FORMULA SEALER
ALUM. - ALUMINUM
AQU. T. - AQUATOUGH
BLK. - BLOCK
BLDG. - BUILDING
CARP. - CARPET
CARP.T. - CARPET TILE
CLG. - CEILING
CEM. BRD. - CEMENT BOARD
CER/T. - CERAMIC TILE
CLR. - CLEAR
COL. - COLUMN
CONC. - CONCRETE
CONC. BLK. - CONCRETE BLOCK
F.A.T.P. - FIBEROCK AQUA TOUGH PANELS
FIN. - FINISH
FLR. - FLOOR