

1755 STEELS AVENUE WEST. TORONTO, ONTARIO
ARCHITECTURAL – ISSUED FOR CONSTRUCTION

CLEAN UTILITIES/PROCESS
CHEME ENGINEERING INC.
35 CRAWFORD AVE.
CAMPBELLVILLE, ON L0P 1B0
P: 905-854-9990

WBA ARCHITECTS AND ENGINEERS
3-530 ROWNTREE DAIRY ROAD
VAUGHAN, ON L4L 8H2
P: 905-851-0616

WBA ARCHITECTS AND ENGINEERS
3-530 ROWNTREE DAIRY ROAD
VAUGHAN, ON L4L 8H2
P: 905-851-0616

WALTER FEDY
675 QUEEN STREET SOUTH, SUITE 111
KITCHENER, ON N2M 1A1
P: 519-576-2150

CROSSEY ENGINEERING
2255 SHEPPARD AVE E
NORTH YORK, ON M2J 4Y1
P: 416-497-3111

SHEET NUMBER	SHEET NAME
53P-2021-015- A000	B53 FFIP DRAWING LIST
53P-2021-015- A101	KEY SITE PLAN & BUILDING MATRIX
53P-2021-015- A102	ENLARGED SITE PLAN
53P-2021-015- A102A	SITE DETAILS
53P-2021-015- A104	MAIN FLOOR- LIFE SAFETY PLAN
53P-2021-015- A105	PENTHOUSE FLOOR- LIFE SAFETY PLAN
53P-2021-015- A200	DEMOLITION BASEMENT FLOOR PLAN
53P-2021-015- A201	DEMOLITION GROUND FLOOR PLAN
53P-2021-015- A202	DEMOLITION PENTHOUSE LEVEL PLAN
53P-2021-015- A202A	DEMOLITION PENTHOUSE LEVEL PLAN - OPENINGS AND HOUSE KEEPING PADS
53P-2021-015- A203	DEMOLITION ROOF PLAN
53P-2021-015- A211	DEMOLITION REFLECTED CEILING PLAN -MAIN LEVEL
53P-2021-015- A212	DEMOLITION BUILDING ELEVATIONS
53P-2021-015- A300	NEW BASEMENT LEVEL
53P-2021-015- A301	NEW GROUND FLOOR PLAN
53P-2021-015- A301A	NEW DIMENSIONAL GROUND FLOOR PLAN
53P-2021-015- A302	NEW PENTHOUSE LEVEL PLAN
53P-2021-015- A302A	NEW DIMENSIONAL PENTHOUSE LEVEL PLAN
53P-2021-015- A303	NEW ROOF PLAN
53P-2021-015- A304	NEW ROOF ENCLOSURE ROOF
53P-2021-015- A305	EQUIPMENT MOVE - IN PLAN
53P-2021-015- A311	NEW REFLECTED CEILING PLAN -MAIN LEVEL
53P-2021-015- A401	NEW BUILDING ELEVATIONS
53P-2021-015- A501	NEW BUILDING SECTIONS
53P-2021-015- A502	NEW BUILDING SECTIONS
53P-2021-015- A503	DEMO AND NEW WALL SECTION AT EAST INFILL
53P-2021-015- A504	DEMO AND NEW WALL SECTION AT WEST INFILL
53P-2021-015- A505	WALL SECTIONS
53P-2021-015- A601	EXTERIOR STAIR AND PLATFORM PLANS, SECTIONS, ELEVATIONS AND DETAILS
53P-2021-015- A602	NEW SHIPPING AREA - PLANS, ELEVATIONS, SECTIONS AND DETAILS
53P-2021-015- A603	REFRIGERATOR 713 AND 820 PLANS, SECTIONS AND DETAILS
53P-2021-015- A604	FILLER ROOM PLANS AND SECTIONS
53P-2021-015- A607	PENTHOUSE LEVEL PLATFORM
53P-2021-015- A608	PENTHOUSE LEVEL OPENING AND NEW ROOF ENCLOSURE PLANS
53P-2021-015- A608A	PENTHOUSE LEVEL OPENING AND NEW ROOF ENCLOSURE DETAILS
53P-2021-015- A609	PENTHOUSE LEVEL AND NEW ROOF ENCLOSURE WALL SECTIONS
53P-2021-015- A610	SECTION DETAILS
53P-2021-015- A611	SECTION DETAILS
53P-2021-015- A701	PLAN DETAILS
53P-2021-015- A702	PLAN DETAILS
53P-2021-015- A703	ROOF DETAILS
53P-2021-015- A704	STAINLESS STEEL DETAILS
53P-2021-015- A704A	STAINLESS STEEL DETAILS
53P-2021-015- A801	LOCKERS- ENLARGED PLAN, ELEVATIONS AND DETAILS
53P-2021-015- A802	MAINTENANCE SHOP - ENLARGED PLANS, ELEVATION AND DETAILS
53P-2021-015- A803	FORMULATION SUITE - ENLARGED PLANS, ELEVATIONS AND DETAILS
53P-2021-015- A804	EQUIPMENT/COMPONENT STORAGE, SHIFT HUDDLE & CORR. 815 - INTERIOR ELEVATIONS
53P-2021-015- A805	FORM/FILL SUPPORT #824 AND AIRLOCKS INTERIOR ELEVATIONS
53P-2021-015- A806	AIRLOCK INTERIOR ELEVATIONS
53P-2021-015- A807	FILLER ROOM INTERIOR ELEVATIONS
53P-2021-015- A808	PALLETIZER ROOM INTERIOR ELEVATIONS
53P-2021-015- A901	DOOR SCHEDULE
53P-2021-015- A902	DOOR DETAILS
53P-2021-015- A903	ROOM SCHEDULE AND DETAILS
53P-2021-015- CL001	CLASSIFICATION PLAN
53P-2021-015- CL002	PERSONNEL FLOW PLAN
53P-2021-015- CL003	RAW MATERIAL FLOW PLAN
53P-2021-015- CL004	PRODUCT FLOW PLAN
53P-2021-015- CL005	WASTE AND SOILED EQUIPMENT FLOW PLAN
53P-2021-015- CL006	PW/WFI FLOW PLAN

SHEET NUMBER	SHEET NAME
53P-2021-015-- S100	GENERAL NOTES
53P-2021-015-- S101	TYPICAL DETAILS 1
53P-2021-015-- S111	SCHEDULES
53P-2021-015-- S200	FOUNDATION PLAN
53P-2021-015-- S201	GROUND FLOOR FRAMING PLAN
53P-2021-015-- S202	PENTHOUSE FLOOR LEVEL FRAMING PLAN
53P-2021-015-- S203	ROOF FRAMING PLAN
53P-2021-015-- S204	RAISED PENTHOUSE FLOOR AND HIGH ROOF FRAMING
53P-2021-015-- S301	GROUND FLOOR CONC. SLAB AND LINTEL PLAN
53P-2021-015-- S302	PENTHOUSE LEVEL FLOOR OPENINGS AND CONCRETE PAD PLAN
53P-2021-015-- S303	HK PADS ON PENTHOUSE FLOOR
53P-2021-015-- S400	FOUNDATIONS AND SOG SECTIONS
53P-2021-015-- S401	PENTHOUSE LEVEL SECTIONS
53P-2021-015-- S402	PENTHOUSE ROOF SECTIONS
53P-2021-015-- S403	SECTIONS & DETAILS
53P-2021-015-- S500	STRUCTURAL ELEVATIONS
53P-2021-015-- S600A	GROUND FLOOR JOISTS REINFORCEMENT DETAILS-1
53P-2021-015-- S600B	GROUND FLOOR JOISTS REINFORCEMENT DETAILS-2
53P-2021-015-- S601A	PENTHOUSE FLOOR AND ROOF JOISTS REINFORCEMENT DETAILS
53P-2021-015-- S601B	PENTHOUSE FLOOR AND ROOF JOISTS REINFORCEMENT DETAILS
53P-2021-015-- S601C	PENTHOUSE FLOOR AND ROOF JOISTS REINFORCEMENT DETAILS
53P-2021-015-- S601D	PENTHOUSE FLOOR AND ROOF JOISTS REINFORCEMENT DETAILS
53P-2021-015-- S601E	PENTHOUSE FLOOR AND ROOF JOISTS REINFORCEMENT DETAILS
53P-2021-015-- S601F	PENTHOUSE FLOOR JOISTS REINFRCEMENT DETAILS
53P-2021-015-- S602A	PENTHOUSE ROOF JOISTS REINFORCEMENT DETAILS-1
53P-2021-015-- S602B	PENTHOUSE JOIST REINFORCEMENT DETAILS
53P-2021-015-- S700	REINFORCED BEAM DETAILS
53P-2021-015-- S701	ROOF BEAM REINFORCEMENT
53P-2021-015-- S800	EXTERIOR PENTHOUSE STAIRS

[illegible][illegible][illegible]

CONFIDENTIAL - PROPRIETARY INFORMATION
 *DRAWINGS, SPECIFICATIONS AND RELATED DOCUMENTS ARE INTENDED SOLELY FOR THE
 USE OF Sanofi Pasteur Limited and MAY CONTAIN INFORMATION WHICH IS PRIVILEGED,
 CONFIDENTIAL, EXEMPT FROM DISCLOSURE UNDER APPLICABLE LAW OR SUBJECT TO
 COPYRIGHT. ANY UNAUTHORIZED USE, DISCLOSURE, DISTRIBUTION, REPRODUCTION,
 REVIEW OR COPYING IS PROHIBITED AND MAY BE UNLAWFUL. THIS IS HIGHLY
 CONFIDENTIAL, COMMERCIAL AND PROPRIETARY INFORMATION WHICH CONSTITUTES
 TRADE SECRETS OF Sanofi Pasteur Limited™
 VERIFY DIMENSIONS BEFORE USE



Current Designer:	
Version Description:	
Version Date:	
Approval Date:	
Change Control Numbers:	

DOCUMENT PERMISSIONS	
Approval Date:	
Approval Date:	
Approval Date:	

PROJECT
sanofi pasteur
**SANOPI - B53 FORMULATION,
FILLING, INSPECTION &
PACKAGING (FFIP)**
1755 STEELES AVE W. NORTH YORK, ONTARIO M2R3T4
2210501

PRIME CONSULTANT

 **Cheme**

35 Crawford Cres., Unit 1
P.O. BOX 595
Campbellville, ON, L0P 1B0
T: (905) 854-9990 F: (905) 854-6115

CONSULTANT

 **wba**
architects and engineers Inc.



3 - 530 Rowntree Dairy Road
Vaughan, Ontario L4L 8H2
tel: 905-851-0616
fax: 905-851-7148
email: info@wbaee.com

CONSULTANT

WALTERFEDY

KITCHENER OFFICE
675 Queen Street South, Suite 111, Kitchener, Ontario, N2M 1A1
T 519.576.2150 F 519.576.5499 walterfedy.com

COPYRIGHT © 2021 WalterFedy Inc.

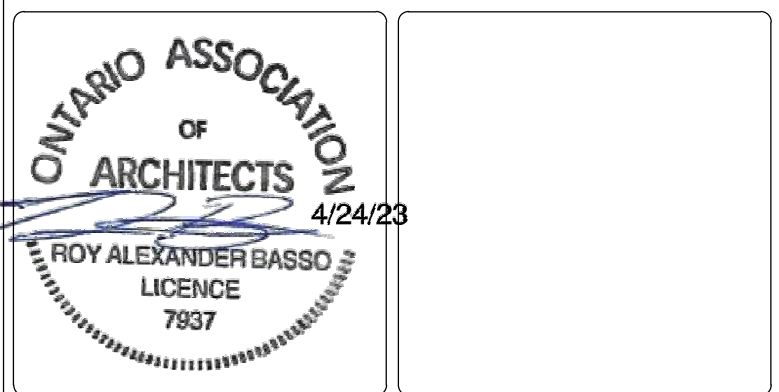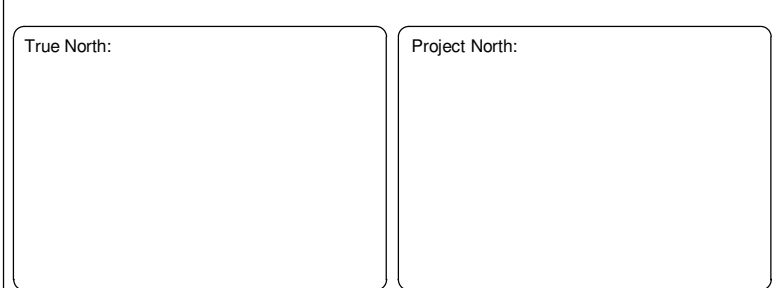

3	ISSUED FOR ASBUILT	WBA	27MAR2026
2	ISSUED FOR CN #161	WBA	27MAR2026
1	ISSUED FOR SJ #A 019	WBA	13MAR2025
0	ISSUED FOR CONSTRUCTION	WBA	29SEP2023
K	ISSUED FOR POST CONTRACT ADDENDUM	WBA	11SEP2023
J	ISSUED FOR ADDENDUM #03	WBA	30MAY2023
I	ISSUED FOR TENDER ADDENDUM #02	WBA	15MAR2023
H	ISSUED FOR PERMIT AND TENDER	WBA	21APR2023
G	ISSUED FOR 80% DESIGN REVIEW	WBA	17FEB2023
F	ISSUED FOR 80% INTERM REVIEW	WBA	16NOV2022
E	ISSUED FOR PERMIT	WBA	31MAY2022
REVISION	DESCRIPTION	BY	DATE


CURRENT DRAWING		
Current Drawer:	INSIYA KAPASI	Init: I.K.
Current Designer:	ROY BASSO	Init: R.B.
Current Design Verifier:	ROY BASSO	Init: R.B.

ORIGINAL DRAWING	
Drawing Creation Date:	
Original Drawer:	Init:
Original Design Verifier	Init:

LOCATION	
Bldg Number:	Bldg Description:
Bldg Floor:	Area/Functional Use:

TITLE	
B53 FFIP DRAWING LIST	
Scale:	AS NOTED
Sheet Size:	ANSI E
Drawing & File Name:	
53P-2021-015-A000	
Layout Name:	
A000	
Old Elec. File:	Old Sheet Name:

Old Elec. File:	Old Sheet Name:
-----------------	-----------------

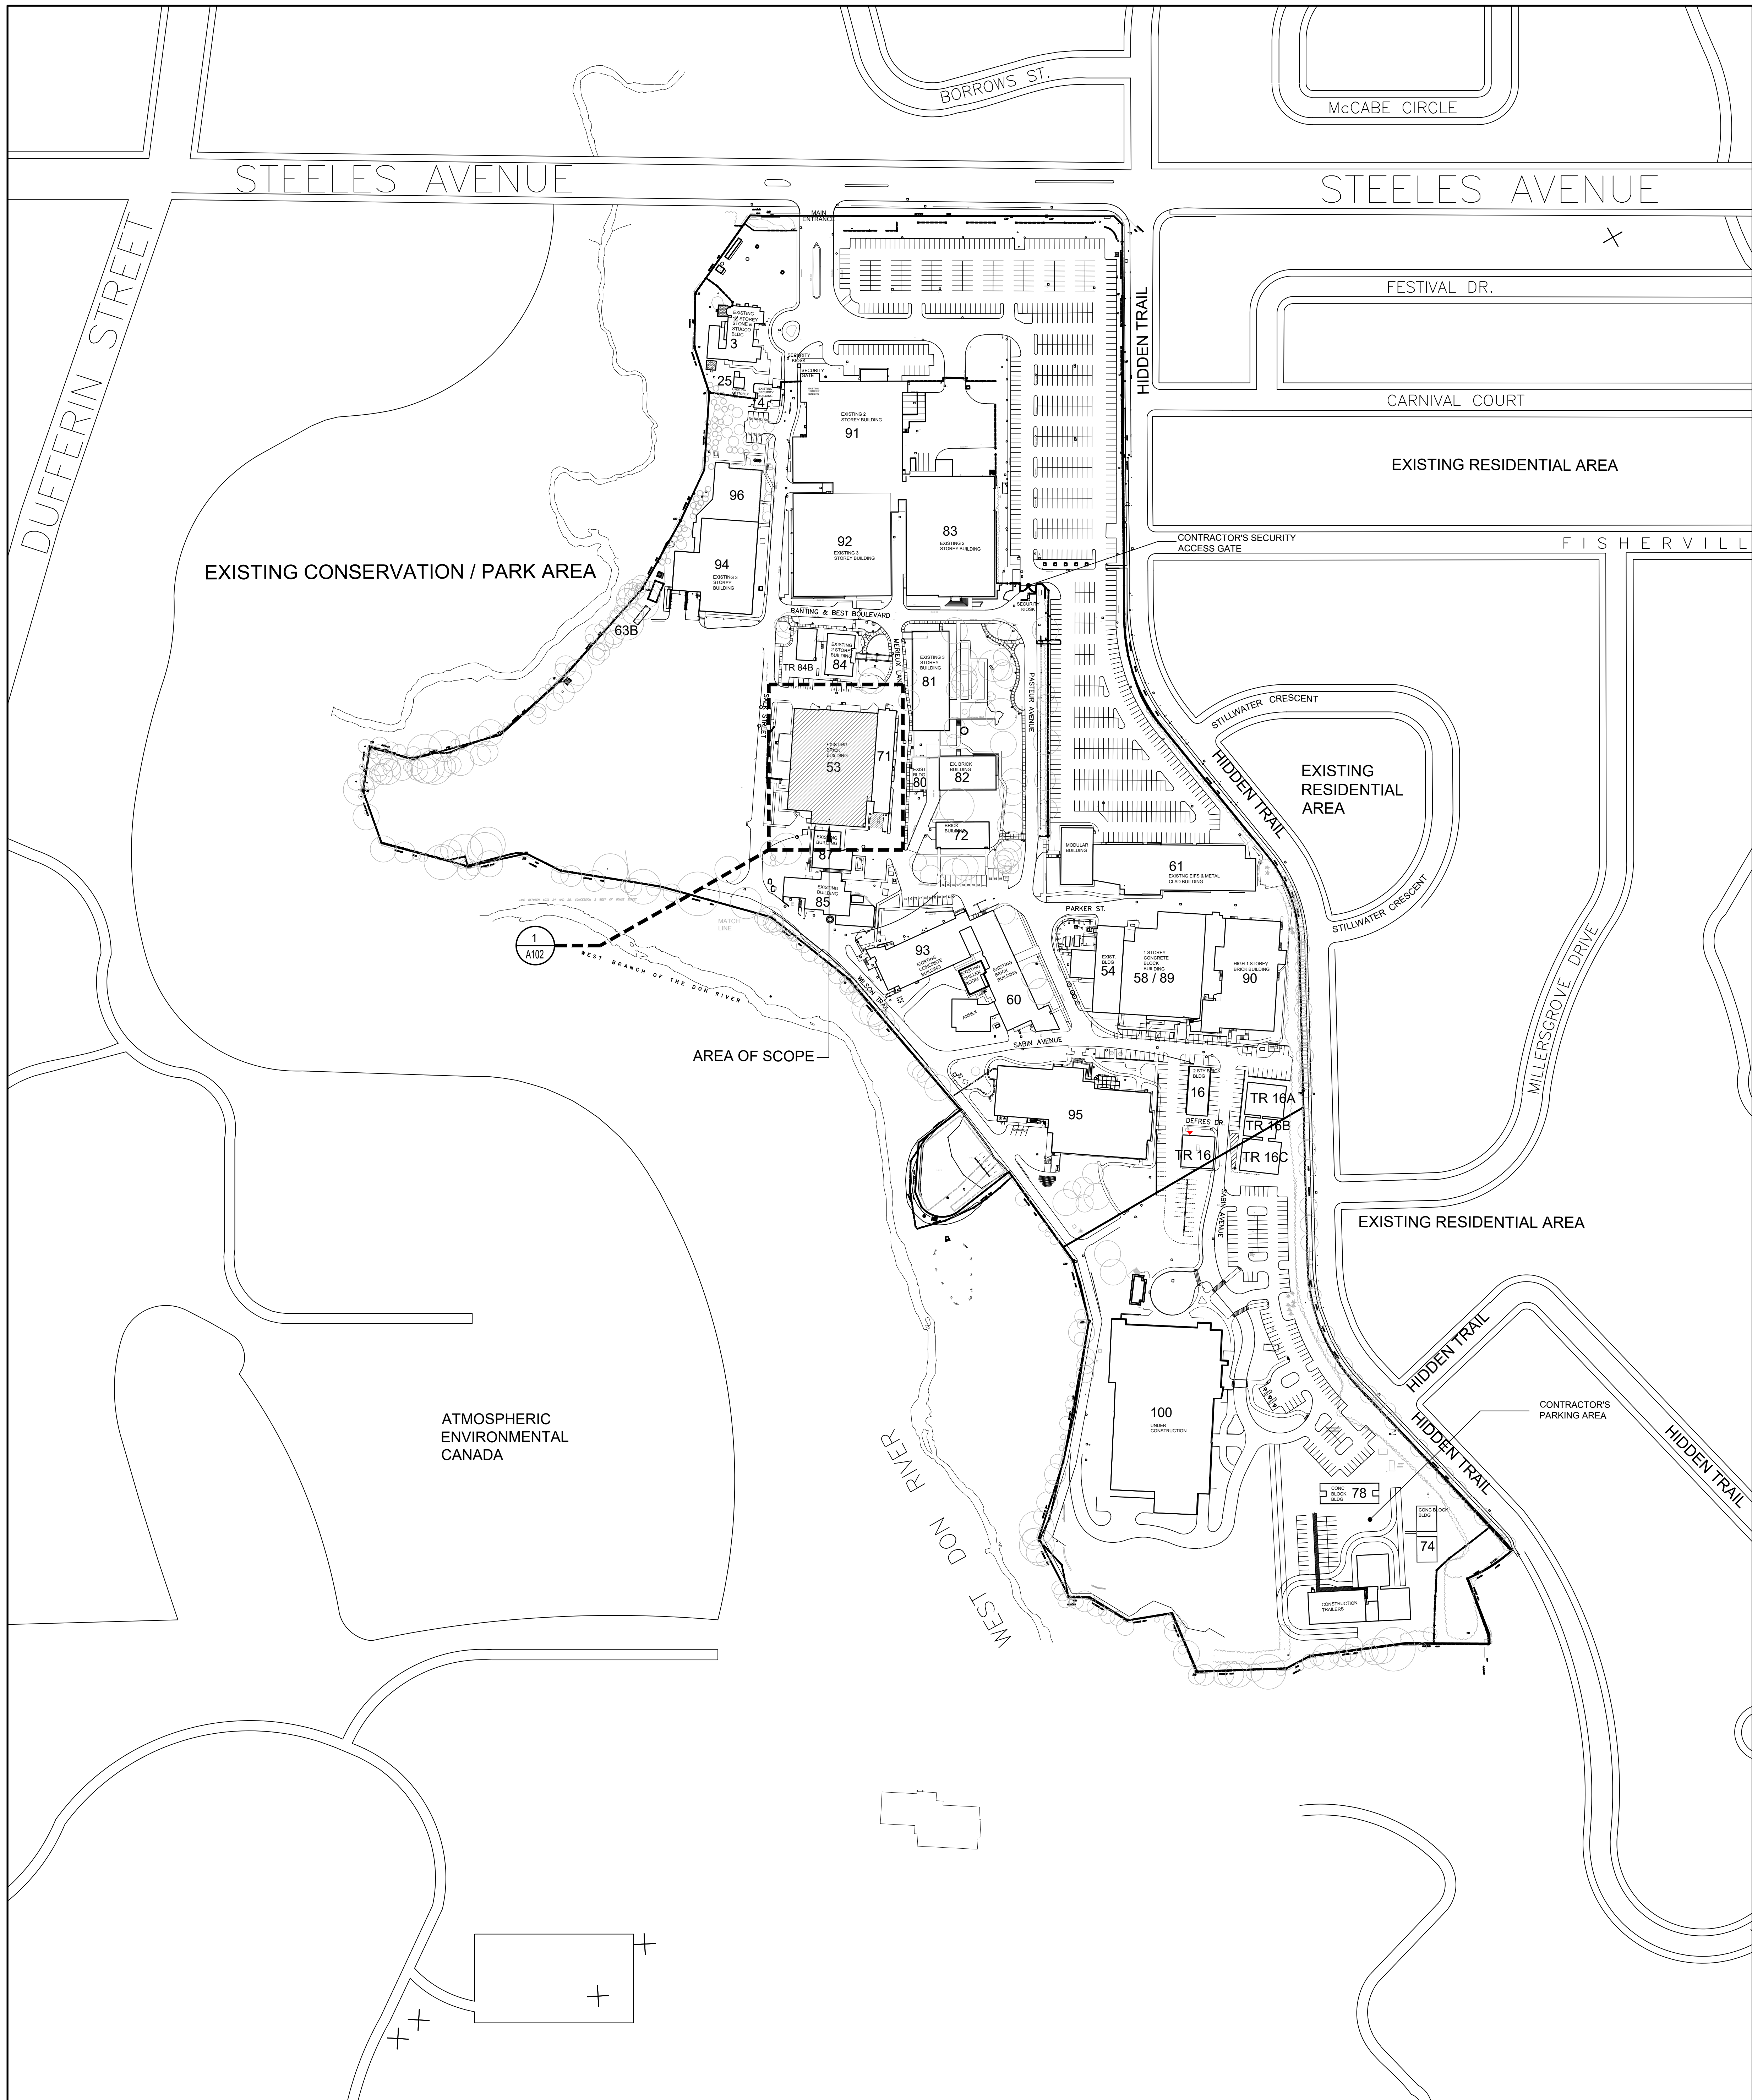

1
A101
KEY SITE PLAN

Item	Ontario's 2012 Building Code Data Matrix Part 3				OBC Reference						
1	Project Description: SANOFI PASTEUR BUILDING –B53 FORMULATION, FILLING, INSPECTION & PACKAGING (FFIP) 1755 Steeles Ave. W. Toronto, Ontario M2R 3T4				☒ Part 3						
	☐ New ☐ Addition ☒ Alteration ☐ Change of Use				1.1.2.						
2	Major Occupancy(s): GROUP 'F2'				3.1.2.1.(1)						
3	Building Area (m2) EXISTING BUILDING AREA = 3,876.66 NEW SHIPPING AREA = 40.8 INTERIOR ALTERATION AREA (MAIN LEVEL) = 1,787 INTERIOR ALTERATION BASEMENT AREA = 162 INTERIOR ALTERATION PENTHOUSE AREA = 565.28 PENTHOUSE EXPANSION AREA = 467 TOTAL NEW BUILDING AREA = 4,394.46				1.4.1.2.						
4	Gross Floor Area (GFA) (m2) EXISTING GROUND FLOOR AREA = 3,876.66 EXISTING LOWER LEVEL FLOOR AREA = 1,580.63 EXISTING MECHANICAL PENTHOUSE AREA = 1,152.27 NEW SHIPPING AREA = 40.8 NEW MECHANICAL PENTHOUSE AREA = 467 TOTAL GROSS FLOOR AREA = 7,116.73				1.4.1.2.						
5	Number of Storeys		Above grade ONE Below grade ONE		1.4.1.2. & 3.2.1.1.						
6	Number of Streets/Fire Fighter Access – TWO				3.2.2.10. & 3.2.5.						
7	Building Classification: 3.2.2.70 GROUP F, UP TO 4 STOREYS				3.2.2.70						
8	Sprinkler System Proposed				☒ Entire building ☐ Selected compartments ☐ Selected floor areas ☐ Basement ☐ In lieu of roof rating ☐ Not required						
9	Standpipe required				☐ Yes ☒ No						
10	Fire Alarm required				☐ Yes ☒ No ☒ PROVIDED						
11	Water Service/Supply is Adequate				☒ Yes ☐ No						
12	High Building				☐ Yes ☒ No						
13	Construction Restrictions ☒ Combustible permitted ☐ Non-combustible required				☒ Both						
	Actual Construction ☐ Combustible ☒ Non-combustible				☐ Both						
14	Mezzanine(s) Area m2: N/A				3.2.1.1.(3)–(8)						
15	Occupant load based on: ☐ m2/person ☒ Design of building (SCOPE OF WORK DOES NOT INCREASE OCCUPANT LOAD OF BUILDING) Basement: Occupancy <u>NIL</u> Load <u>N/A</u> Persons 1st Floor: Occupancy <u>58</u> Load _____ Persons 2nd Floor: Occupancy <u>NIL</u> Load _____ Persons 3rd Floor: Occupancy _____ Load _____ Persons				3.1.17 EXISTING OCCUPANCY TO REMAIN						
16	Barrier-free Design ☒ Yes ☐ No EXISTING BUILDING HAZARDOUS MANUFACTURING										
17	Hazardous Substances ☐ Yes ☒ No				3.3.1.2. & 3.3.1.19						
18	Required Fire Resistance Rating (FRR)	Horizontal Assemblies FRR (Hours)		Listed Design No. or Description		3.2.2.67 & 3.2.1.4.					
FLOORS – 2 HR		N/A									
Roof – NIL		–									
Mezzanine – N/A		N/A									
FRR of Supporting Members		Listed Design No. or Description									
FLOORS – N/A		N/A									
Roof – NIL		–									
	Mezzanine – N/A		N/A								
19	Spatial Separation –Construction of Exterior Walls– Existing Non-Combustible				3.2.3.						
	Wall	Area of EBF (m2)	L.D. (m)	L/H or H/L	Permitted Max. % of Openings	Proposed % of Openings	FRR (Hours)	Listed Design or Description	Comb. Cons.	Comb. Cons.	Cons. Non-Comb. Cons.
	North	N/A	----	----	----	----	----	----	----	----	YES
	East	N/A	----	----	----	----	----	----	----	----	YES
	West	N/A	----	----	----	----	----	----	----	----	YES
	South	N/A	----	----	----	----	----	----	----	----	YES
20	Plumbing Fixture Requirements				3.7.4						
	Male/Female Count @ 50% / 50% except as noted otherwise				Occupant Load	BC Table Number	Fixtures Required	Fixtures Provided	INTERIOR ALTERATION DOES NOT INCREASE OCCUPANT LOAD		
	Basement: Occupancy <u>N/A</u>				58	3.7.4.9	6.	6.			
	1st Floor: Occupancy <u>58</u>										
	2nd Floor: Occupancy <u>N/A</u>										

sanofi pasteur 1755 Steeles Avenue West Toronto, Ontario M2R3T4

CONFIDENTIAL - PROPRIETARY INFORMATION

THIS DRAWING, SPECIFICATIONS AND RELATED DOCUMENTS ARE INTENDED SOLELY FOR THE USE OF SANOFI PASTEUR LIMITED AND MAY CONTAIN INFORMATION WHICH IS PROPRIETARY, CONFIDENTIAL, OR BOTH. IT IS NOT TO BE DISCLOSED, REPRODUCED, COPIED, OR OTHERWISE USED FOR ANY OTHER PURPOSE WITHOUT THE WRITTEN PERMISSION OF SANOFI PASTEUR LIMITED. ANY UNAUTHORIZED USE, DISCLOSURE, DISTRIBUTION, REPRODUCTION, OR OTHER ACT IS PROHIBITED AND MAY BE SUBJECT TO LEGAL ACTION. THIS IS A STRICTLY CONFIDENTIAL DOCUMENT. ANY INFORMATION OR DOCUMENT WHICH CONSTITUTES TRADE SECRETS OF SANOFI PASTEUR LIMITED.

VERIFY DIMENSIONS BEFORE USE

RESERVED FOR INTERNAL USE

PROJECT

BUILDING #53 FFIP
2210501

PRIME CONSULTANT

30 Cleveland Drive, Unit 1
P.O. Box 595
Campbellville, ON L0P 1B0
T: (905) 854-6662 F: (905) 854-6115

CONSULTANT

3150 Burnhamthorpe Road
Vaughan, Ontario L4L 1B2
Tel: (905) 851-1111
Fax: (905) 851-1111
www.wbaarchitects.com

CONSULTANT

WALTERFEDY
KITCHENER OFFICE
675 Queen Street South, Suite 111, Kitchener, Ontario, N2M 1A1
519.576.2150 F 519.576.5499 www.walterfedy.com
Copyright © 2021 WalterFedy Inc.

True North

Project North

ONTARIO ASSOCIATION OF ARCHITECTS

6/30/23

PROFESSIONAL BASIC LICENCE 7937

I	ISSUED FOR AS-BUILT	WEA	27MAR2026
O	ISSUED FOR CONSTRUCTION	WEA	29SEP72023
F	ISSUED FOR TENDER ADDENDUM	WEA	19MAY2023
E	ISSUED FOR PERMIT AND TENDER	WEA	21APR2023
D	ISSUED FOR SITE DESIGN REVIEW	WEA	17FEB2023
C	ISSUED FOR FINAL BASIC DESIGN	WEA	29APR2022
B	ISSUED FOR 60% DESIGN REVIEW	WEA	01APR2022
A	ISSUED FOR 30% DESIGN REVIEW	WEA	15FEB2022

REV DESCRIPTION BY DATE

CURRENT DRAWING

Client Owner: ROY BASSO R.B.

Client Designer: GINO SAVO SARDARO G.S.S.

Client Design Verifier: GINO SAVO SARDARO G.S.S.

ORIGINAL DRAWING

Drawing Creation Date:

Original Designer: G.S.

Original Design Verifier: G.S.

LOCATION

Site Number: 53

Site Name: N/A

Site Address: N/A

TITLE



KEY SITE PLAN, BUILDING MATRIX & DRAWING LIST

Scale: AS NOTED Sheet Size: ANSI E

Drawing & File Name: **53P-2021-015-A101**

Issued Name: A101

Out Date File: Out Sheet Name:

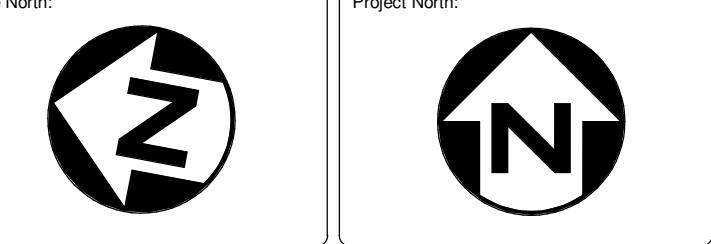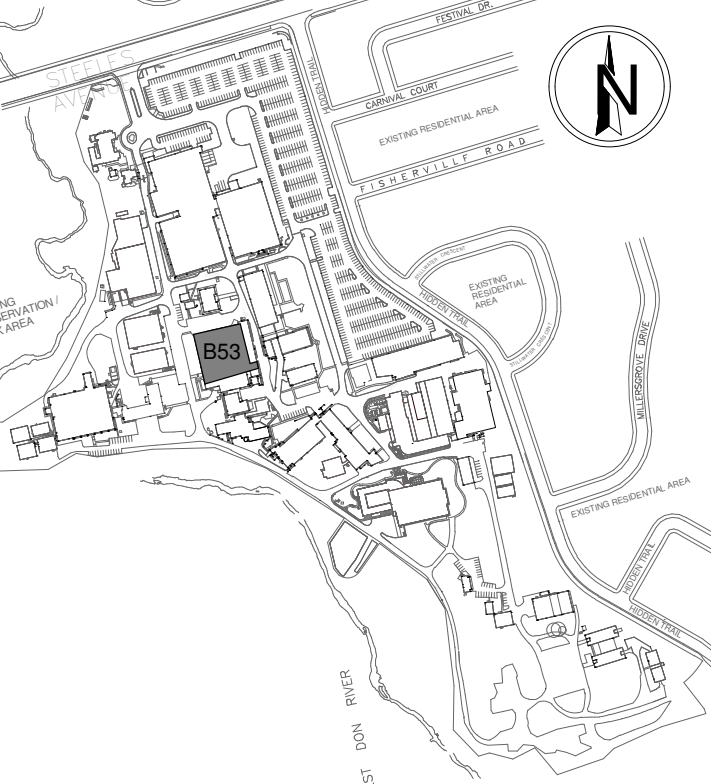

2	ISSUED FOR AS-BUILT	WBA	27MAR2023
1	ISSUED FOR CONSTRUCTION	WBA	20NOV2023
0	ISSUED FOR POST CONTRACT ADDENDUM	WBA	28SEP2023
G	ISSUED FOR POST CONTRACT ADDENDUM	WBA	11SEP2023
F	ISSUED FOR TENDER ADDENDUM #02	WBA	18MAY2023
E	ISSUED FOR PERMIT AND TENDER	WBA	21APR2023
D	ISSUED FOR 90% DESIGN REVIEW	WBA	17FEB2023
C	ISSUED FOR FINAL BASIC DESIGN	WBA	29APR2022
B	ISSUED FOR 60% DESIGN REVIEW	WBA	01APR2022
A	ISSUED FOR 30% DESIGN REVIEW	WBA	10FEB2022

REVISION	DESCRIPTION	BY	DATE
Current Designer:	INSIYA KAPASI	INC	I.K.
Current Designer:	ROY BASSO	INC	R.B.
Current Design Verifier:	ROY BASSO	INC	R.B.

ORIGINAL DRAWING	
Drawing Creation Date:	INC
Original Designer:	INC
Original Design Verifier:	INC

LOCATION	
Block Number:	Block Description:
Block Floor:	Area/Functional Use:


TITLE	
MAIN FLOOR- LIFE SAFETY PLAN	

Scale:	AS NOTED	Sheet Size:	ANSI E
--------	----------	-------------	--------

Drawing & File Name:	53P-2021-015-A104
----------------------	-------------------

Layout Name:	A104
--------------	------

Old Elec File:	Old Sheet Name:
----------------	-----------------

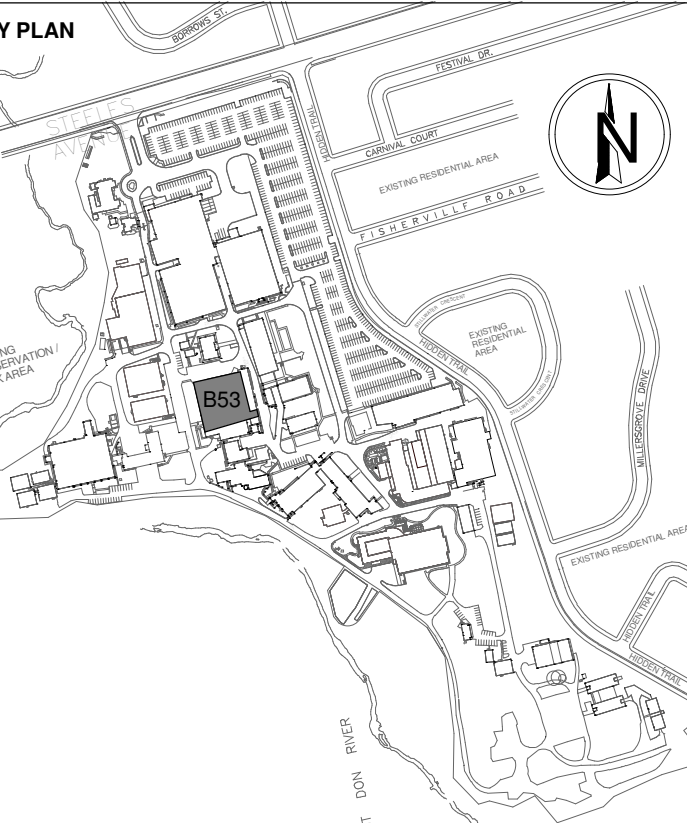

INTERNAL USE

Current Designer:

Version Description:

Version Date:

Approval Date:

Change Control Numbers:

DOCUMENT PERMISSIONS

Approval Date:

Approval Date:

PROJECT

sanofi pasteur

**SANOI - B53 FORMULATION,
FILLING, INSPECTION &
PACKAGING (FFIP)**
1755 STEELES AVE. W., NORTH YORK, ONTARIO M2R3T4
2210501

PRIME CONSULTANT



CONSULTANT



CONSULTANT




KITCHENER OFFICE
575 Queen Street South, Suite 111, Kitchener, Ontario, N2M 1A1
T 519.576.2150 F 519.576.5499 walterfedy.com

Copyright © 2021 Walterfedy Inc.

True North:

Project North:

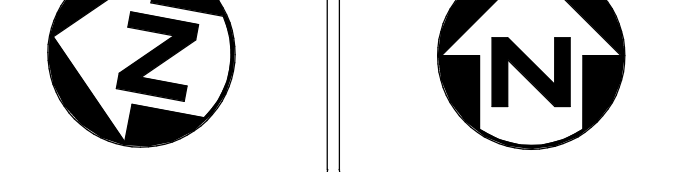

EXISTING LEGEND:

- EXISTING BSL'S BOUNDARY
- EXISTING AREA TO REMAIN
- INTERIOR ALTERATION / NEW ADDITION
- AREA OF FLOOR DEMOLITION
- AREA OF DEMOLITION OF HOUSEKEEPING PADS AND ANGLES
- EXISTING ROOFING WITH WOOD DECK BELOW TO BE DEMOLISHED
- EXISTING ROOF FELTS TO BE REMOVED, EXIST METAL DECK BELOW TO REMAIN
- EXIST WOOD DECK BELOW TO REMAIN
- EXISTING WALLS TO REMAIN
- WALLS AND PARTITIONS TO BE REMOVED
- EXISTING DOOR AND FRAME
- DOOR AND FRAME TO BE REMOVED



1	ISSUED FOR AS-BUILT	WBA	27MAR2023
0	ISSUED FOR CONSTRUCTION	WBA	28SEP2023
I	ISSUED FOR POST CONTRACT ADDENDUM	WBA	11SEP2023
H	ISSUED FOR TENDER ADDENDUM #02	WBA	15MAY2023
G	ISSUED FOR PERMIT AND TENDER	WBA	21APR2023
F	ISSUED FOR 50% DESIGN REVIEW	WBA	17FEB2023
E	ISSUED FOR 80% INTERIM REVIEW	WBA	16NOV2022
D	ISSUED FOR FINAL BASIC DESIGN	WBA	28APR2022
C	ISSUED FOR 60% DESIGN REVIEW	WBA	07APR2022
B	ISSUED FOR 30% DESIGN REVIEW	WBA	15FEB2022
A	ISSUED FOR CLIENT REVIEW	WBA	12JUL2021
REVISION	DESCRIPTION	BY	DATE

CURRENT DRAWING

Current Designer: INSPIYA KAPASI

Current Designer: ROY BASSO

Current Design Verifier: ROY BASSO

ORIGINAL DRAWING

Drawing Creation Date:

Original Designer:

Original Design Verifier:

LOCATION

Block Number:

Area/Functional Use:

TITLE

DEMOLITION BASEMENT FLOOR PLAN

Scale: AS NOTED

Sheet Size: ANSI E

Drawing & File Name: 53P-2021-015-A200

Layout Name: A200



Old Elec File: Old Sheet Name:



EXIST WALL LEGEND:


- W1 EXISTING CONCRETE BLOCK
- W1A EXISTING CONCRETE BLOCK 6\"/>
- W1B EXISTING CONCRETE BLOCK 10\"/>
- W1C EXISTING CONCRETE BLOCK 8\"/>
- W2 EXISTING GYP. BRD. ON BOTH SIDES OF METAL STUDS
- W2A EXISTING GYP. BRD. ON ONE SIDE OF METAL STUDS
- W3 EXISTING 3 COURSE LOAD BEARING BRICK MASONRY WALL WITH 1\"/>
- W4 INSULATED METAL SIDING
- W5 INSULATED METAL SIDING ON AIR SPACE ON 6\"/>
- W6 EXIST FACE BRICK ON 3\"/>
- W7 EXIST STUCCO ON RIGID INSULATION ON FACE BRICK ON 3\"/>
- W8 EXIST CONCRETE WALL
- W9 EXIST GYPSUM BOARD
- W10 EXIST INFILL EXIST BRICK ON GYPSUM INSULATED WALL PANEL

1 DEMO BASEMENT LEVEL
1/8\"/>

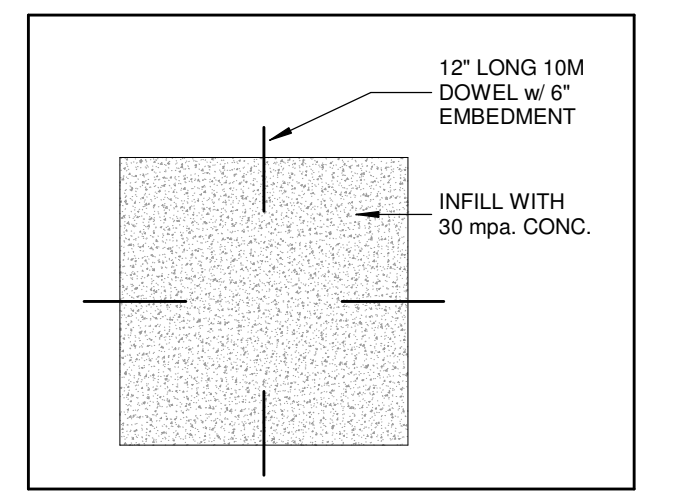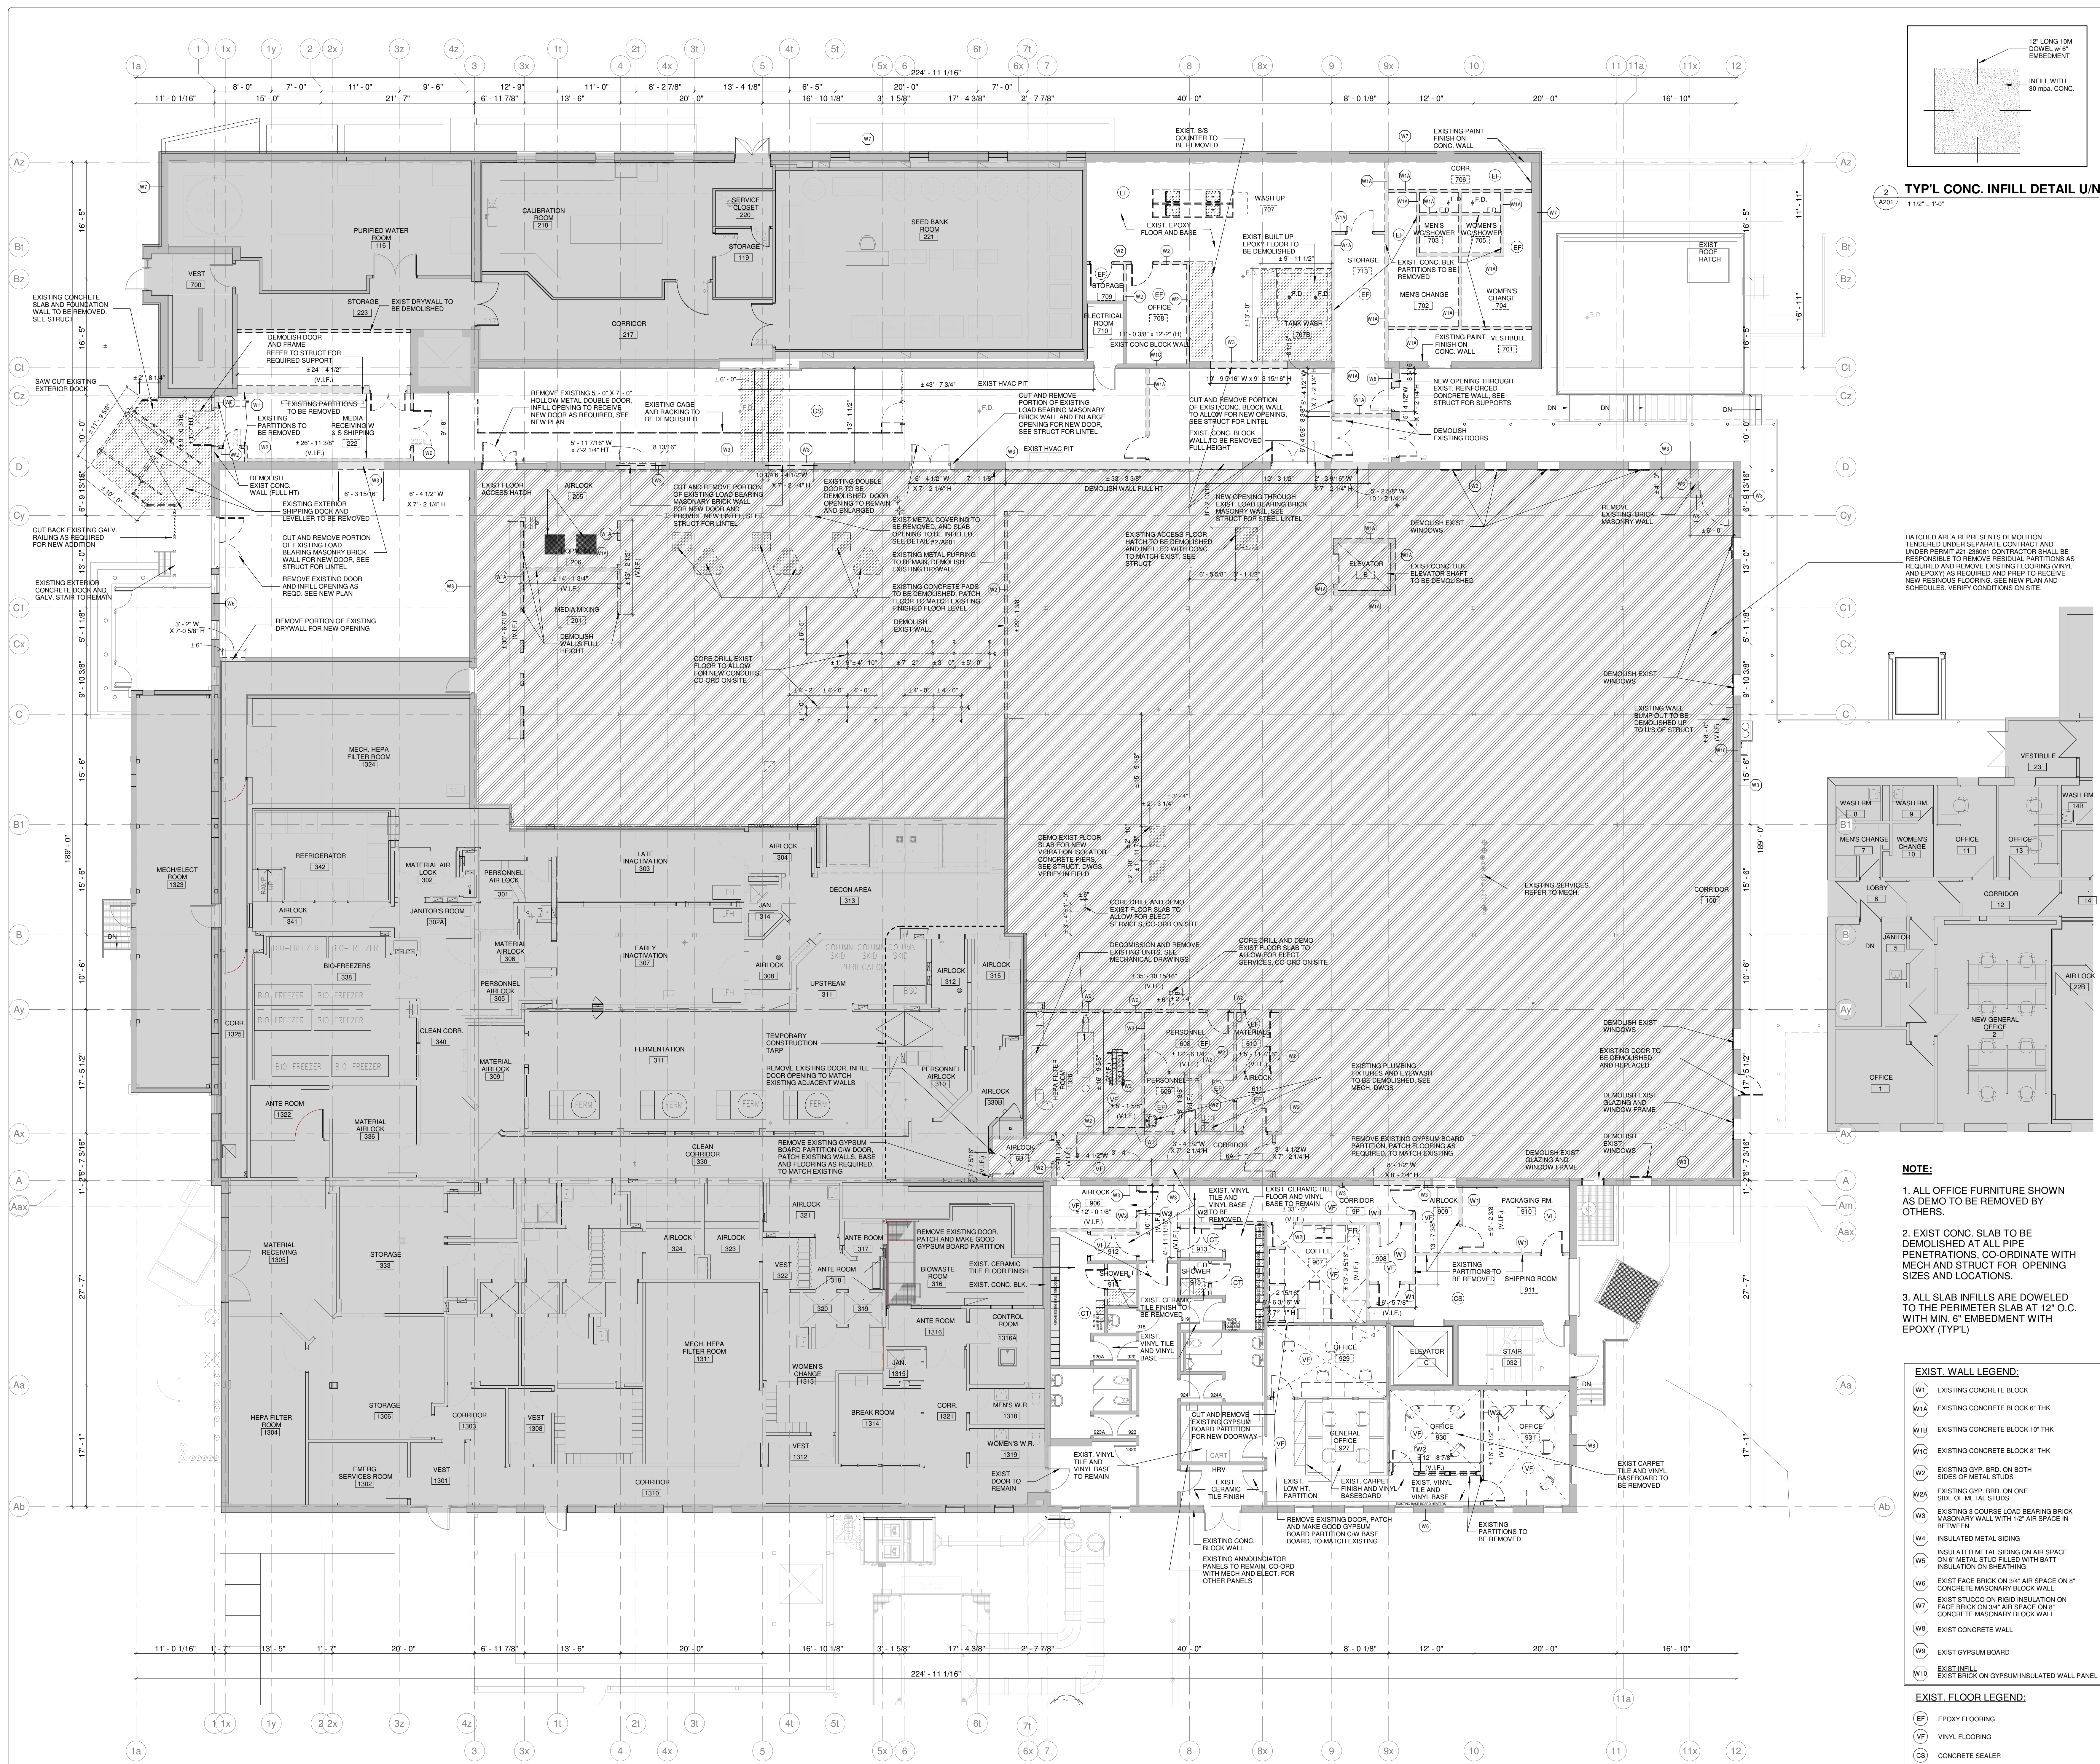

2
A201 1 1/2\"/>

HATCHED AREA REPRESENTS DEMOLITION
TENDERED UNDER SEPARATE CONTRACT AND
UNDER PERMIT #21-230001 CONTRACTOR SHALL BE
RESPONSIBLE TO REMOVE RESIDUAL PARTITIONS AS
REQUIRED AND REMOVE EXISTING FLOORING (VINYL
AND EPOXY) AS REQUIRED AND PREP TO RECEIVE
NEW RESINOUS FLOORING. SEE NEW PLAN AND
SCHEDULES. VERIFY CONDITIONS ON SITE.

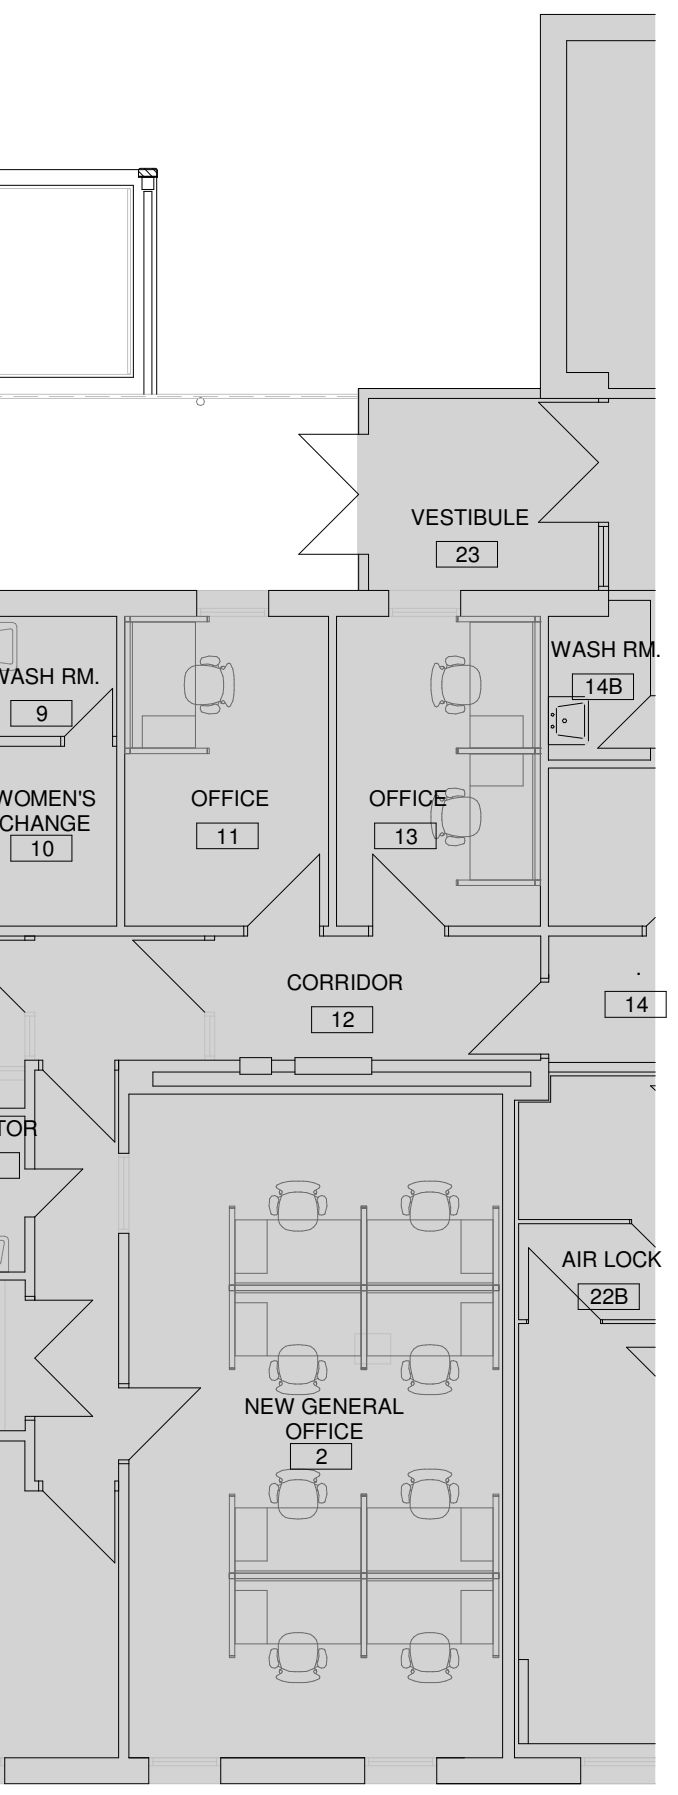

NOTE:
1. ALL OFFICE FURNITURE SHOWN
AS DEMO TO BE REMOVED BY
OTHERS.
2. EXIST CONC. SLAB TO BE
DEMOLISHED AT ALL PIPE
PENETRATIONS, CO-ORDINATE WITH
MECH AND STRUCT FOR OPENING
SIZES AND LOCATIONS.
3. ALL SLAB INFILLS ARE DOWELED
TO THE PERIMETER SLAB AT 12\"/>


EXIST. WALL LEGEND:																							
W1	EXISTING CONCRETE BLOCK	W1A	EXISTING CONCRETE BLOCK 6\"/>																				
W1B	EXISTING CONCRETE BLOCK 10\"/>	W1C	EXISTING CONCRETE BLOCK 8\"/>	W2	EXISTING GYP. BRD. ON BOTH SIDES OF METAL STUDS	W2A	EXISTING GYP. BRD. ON ONE SIDE OF METAL STUDS	W3	EXISTING 3 COURSE LOAD BEARING BRICK MASONRY WALL WITH 12\"/>	W4	INSULATED METAL SIDING	W5	INSULATED METAL SIDING ON AIR SPACE ON 6\"/>	W6	EXIST FACE BRICK ON 3/4\"/>	W7	EXIST STUCCO ON RIGID INSULATION ON FACE BRICK ON 3/4\"/>	W8	EXIST CONCRETE WALL	W9	EXIST GYPSUM BOARD	W10	EXIST INFILL EXIST BRICK ON GYPSUM INSULATED WALL PANEL
W2	EXISTING GYP. BRD. ON BOTH SIDES OF METAL STUDS	W2A	EXISTING GYP. BRD. ON ONE SIDE OF METAL STUDS	W3	EXISTING 3 COURSE LOAD BEARING BRICK MASONRY WALL WITH 12\"/>	W4	INSULATED METAL SIDING	W5	INSULATED METAL SIDING ON AIR SPACE ON 6\"/>	W6	EXIST FACE BRICK ON 3/4\"/>	W7	EXIST STUCCO ON RIGID INSULATION ON FACE BRICK ON 3/4\"/>	W8	EXIST CONCRETE WALL	W9	EXIST GYPSUM BOARD	W10	EXIST INFILL EXIST BRICK ON GYPSUM INSULATED WALL PANEL				
W3	EXISTING 3 COURSE LOAD BEARING BRICK MASONRY WALL WITH 12\"/>	W4	INSULATED METAL SIDING	W5	INSULATED METAL SIDING ON AIR SPACE ON 6\"/>	W6	EXIST FACE BRICK ON 3/4\"/>	W7	EXIST STUCCO ON RIGID INSULATION ON FACE BRICK ON 3/4\"/>	W8	EXIST CONCRETE WALL	W9	EXIST GYPSUM BOARD	W10	EXIST INFILL EXIST BRICK ON GYPSUM INSULATED WALL PANEL								
W5	INSULATED METAL SIDING ON AIR SPACE ON 6\"/>	W6	EXIST FACE BRICK ON 3/4\"/>	W7	EXIST STUCCO ON RIGID INSULATION ON FACE BRICK ON 3/4\"/>	W8	EXIST CONCRETE WALL	W9	EXIST GYPSUM BOARD	W10	EXIST INFILL EXIST BRICK ON GYPSUM INSULATED WALL PANEL												
W7	EXIST STUCCO ON RIGID INSULATION ON FACE BRICK ON 3/4\"/>	W8	EXIST CONCRETE WALL	W9	EXIST GYPSUM BOARD	W10	EXIST INFILL EXIST BRICK ON GYPSUM INSULATED WALL PANEL																
W9	EXIST GYPSUM BOARD	W10	EXIST INFILL EXIST BRICK ON GYPSUM INSULATED WALL PANEL																				

EXIST. FLOOR LEGEND:							
EF	EPOXY FLOORING	VF	VINYL FLOORING	CS	CONCRETE SEALER	CT	CERAMIC TILE
CS	CONCRETE SEALER	CT	CERAMIC TILE				

1
A201 1/8\"/>



CONFIDENTIAL - PROPRIETARY INFORMATION
DRAWINGS, SPECIFICATIONS AND RELATED DOCUMENTS ARE INTENDED SOLELY FOR THE
USE OF SANOFI PASTEUR LIMITED AND MAY CONTAIN INFORMATION WHICH IS PROPRIETARY
TO SANOFI PASTEUR LIMITED. ANY UNAUTHORIZED USE, DISCLOSURE, REPRODUCTION,
REVIEW OR COPIING IS PROHIBITED AND MAY BE ILLEGAL. THIS IS SOLELY
THE SECRECY OF SANOFI PASTEUR LIMITED.
VERIFY DIMENSIONS BEFORE USE

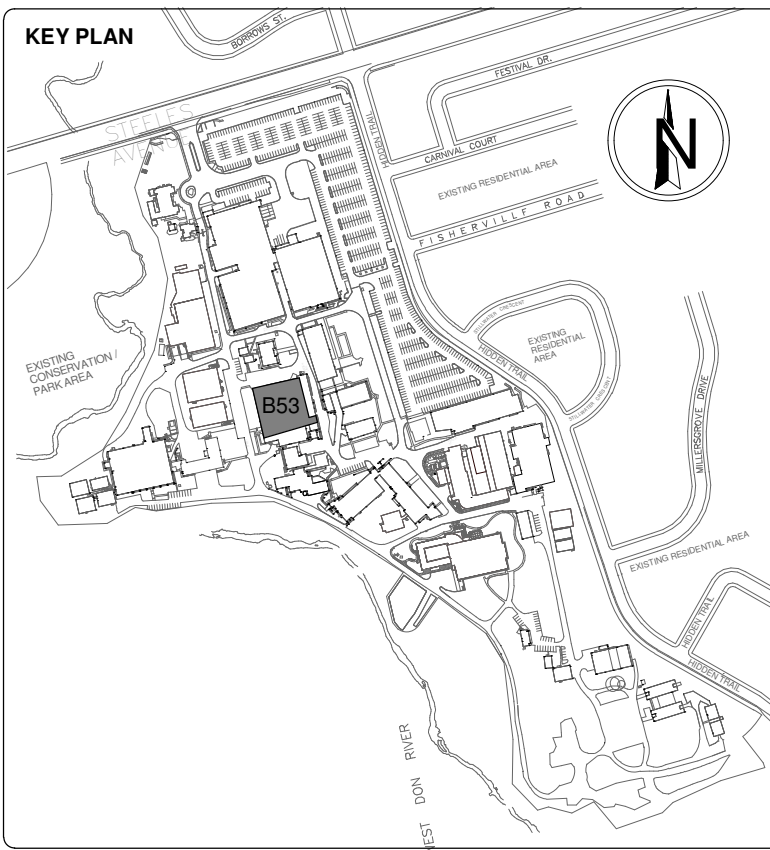

INTERNAL USE

Current Designer:
Version Description:
Version Date:
Approval Date:
Change Control Numbers:

DOCUMENT PERMISSIONS

Approval Date:
Approval Date:


PROJECT

Sanofi
**SANOFI - B53 FORMULATION,
FILLING, INSPECTION &
PACKAGING (FFIP)**
1755 STEELES AVE W, NORTH YORK, ONTARIO M2R3T4
2210501


PRIME CONSULTANT
Cheme 35 Crawford Cres., Unit 1
P.O. BOX 595
Campbellville, ON, L0P 1B0
T: (905) 490-0999 F: (905) 494-4115

CONSULTANT
wba
architects and engineers Inc.
3 - 530 Rossmore Dairy Road
Vaughan, Ontario L4L 8H2
Tel: (905) 881-7128
Fax: (905) 881-7128
Email: info@wbae.com

CONSULTANT
WALTERFEDY
KITCHENER OFFICE
575 Queen Street South, Suite 111, Kitchener, Ontario, N2M 1A1
T 519.576.2150 F 519.576.5469 walterfedy.com
Copyright © 2021 Walterfedy Inc.

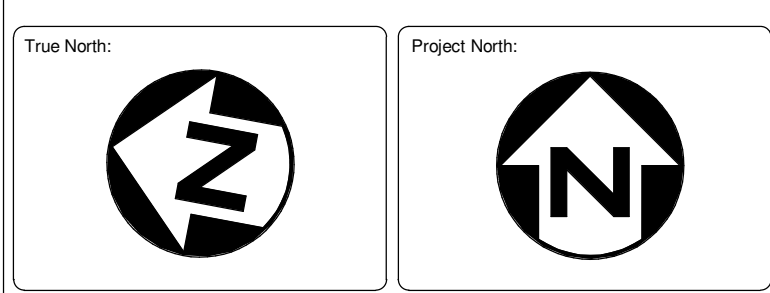

EXISTING LEGEND:			
---	EXISTING BSL BOUNDARY	---	EXISTING WALLS TO REMAIN
---	EXISTING AREA TO REMAIN	---	EXISTING DOOR AND FRAME
---	INTERIOR ALTERATION / NEW ADDITION	---	DOOR AND FRAME TO BE REMOVED
---	AREA OF FLOOR DEMOLITION	---	EXISTING DOOR TO BE REMOVED
---	AREA OF DEMOLITION OF HOUSEKEEPING PASS AND ANGLES	---	EXISTING DOOR TO BE REMOVED
---	EXISTING ROOFING WITH WOOD DECK BELOW TO BE DEMOLISHED	---	EXISTING DOOR TO BE REMOVED
---	EXISTING ROOF FELTS TO BE REMOVED, EXIST METAL DECK BELOW TO REMAIN	---	EXISTING DOOR TO BE REMOVED
---	EXIST WOOD DECK BELOW TO REMAIN	---	EXISTING DOOR TO BE REMOVED
---	EXISTING WALLS TO REMAIN	---	EXISTING DOOR AND FRAME
---	EXISTING WALLS AND PARTITIONS TO BE REMOVED	---	EXISTING DOOR AND FRAME
---	EXISTING DOOR AND FRAME	---	EXISTING DOOR AND FRAME
---	DOOR AND FRAME TO BE REMOVED	---	EXISTING DOOR AND FRAME

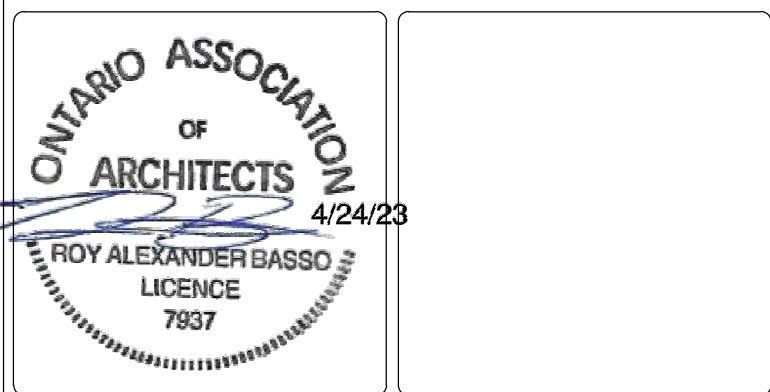

NO.	ISSUED FOR AS-BUILT	WBA	27MAR2020
10	ISSUED FOR CCN #165	WBA	11JULY2020
9	ISSUED FOR CCN #165	WBA	21MAY2020
8	ISSUED FOR CCN #165	WBA	21JAN2020
7	ISSUED FOR CCN #165	WBA	17DEC2024
6	ISSUED FOR CCN #165	WBA	17DEC2024
5	ISSUED FOR CCN #165	WBA	17DEC2024
4	ISSUED FOR CCN #165	WBA	09JUL2024
3	ISSUED FOR CCN #165	WBA	28MAY2024
2	ISSUED FOR CCN #165	WBA	08MAR2024
1	ISSUED FOR CCN #165	WBA	12JAN2024
0	ISSUED FOR CONSTRUCTION	WBA	20SEP2020

CURRENT DRAWING			
Current Designer:	INSIYA KAPASI	INC.	I.K.
Current Designer:	ROY BASSO	INC.	R.B.
Current Design Validator:	ROY BASSO	INC.	R.B.

ORIGINAL DRAWING			
Drawing Creation Date:		INC.	
Original Designer:		INC.	
Original Design Validator:		INC.	

LOCATION			
Block Number:	Block Description:		
Block Floor:	Area/Functional Use:		

TITLE


DEMOLITION GROUND FLOOR PLAN

Scale: AS NOTED Sheet Size: ANSI E

Drawing & File Name: 53P-2021-015-A201

Layout Name: A201

Old Elec File: Old Sheet Name:

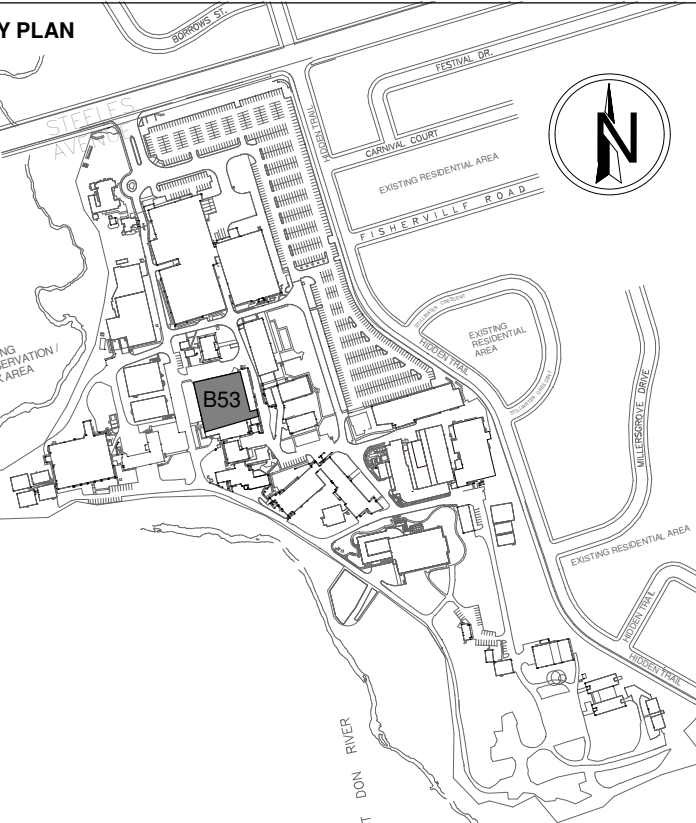

INTERNAL USE

Current Designer:
Version Description:
Version Date:
Approval Date:
Change Control Numbers:

DOCUMENT PERMISSIONS

Approval Date:
Approval Date:


PROJECT

sanofi pasteur
**SANOFI - B53 FORMULATION,
FILLING, INSPECTION &
PACKAGING (FFIP)**
1755 STEELES AVE. W., NORTH YORK, ONTARIO M2R3T4
2210501


PRIME CONSULTANT
Cheme
35 Crawford Cres., Unit 1
P.O. Box 595
Campbellville, ON, L0P 1B0
Tel: (905) 450-0999 Fax: (905) 450-4115

CONSULTANT
wba
architects and engineers Inc.
3 - 530 Riverlane Dairy Road
Vaughan, Ontario L4L 8H2
Tel: (905) 881-7918
Fax: (905) 881-7918
Email: info@wbae.com

CONSULTANT
WALTERFEDY
KITCHENER OFFICE
575 Queen Street South, Suite 111, Kitchener, Ontario, N2M 1A1
T 519.576.2150 F 519.576.5499 walterfedy.com
Copyright © 2021 WalterFedy Inc.

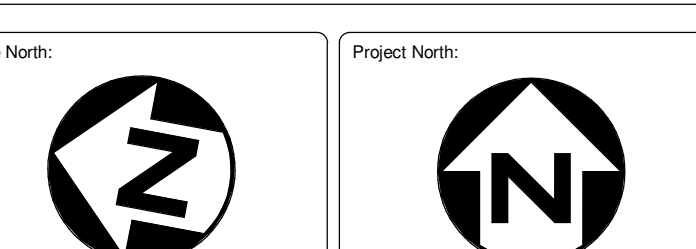

- EXISTING LEGEND:**
- EXISTING BSLS BOUNDARY
 - EXISTING AREA TO REMAIN
 - INTERIOR ALTERATION / NEW ADDITION
 - AREA OF FLOOR DEMOLITION
 - AREA OF DEMOLITION OF
HOUSEKEEPING PADS AND ANGLES
 - EXISTING ROOFING WITH WOOD DECK
BELOW TO BE DEMOLISHED
 - EXISTING ROOF FELTS TO BE
REMOVED, EXIST METAL DECK
BELOW TO REMAIN
 - EXIST WOOD DECK BELOW
TO REMAIN
 - EXISTING WALLS TO REMAIN
 - EXISTING WALLS AND PARTITIONS TO BE
REMOVED
 - EXISTING DOOR AND FRAME
 - DOOR AND FRAME TO BE
REMOVED

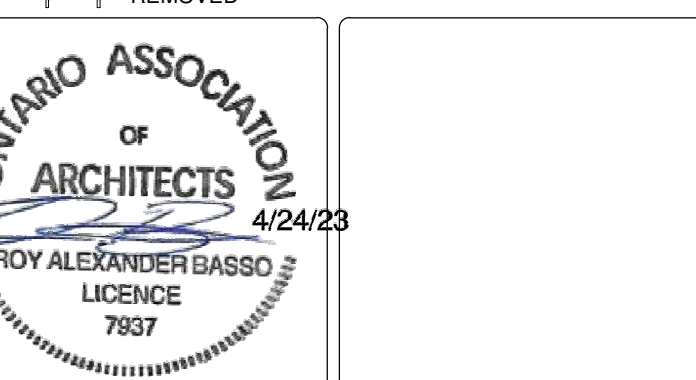

4	ISSUED FOR AS BUILT	WBA	27MAR2023
3	ISSUED FOR CON #028R1	WBA	01MAY2024
2	ISSUED FOR CON #028	WBA	25APR2024
1	ISSUED FOR ST #A-001	WBA	20JAN2024
0	ISSUED FOR CONSTRUCTION	WBA	20SEP2023
D	ISSUED FOR POST CONTRACT ADDENDUM	WBA	11SEP2023
C	ISSUED FOR TENDER ADDENDUM #02	WBA	15MAY2023
B	ISSUED FOR PERMIT AND TENDER	WBA	21APR2023
A	ISSUED FOR REV. DESIGN REVIEW	WBA	11FEB2023
REVISION	DESCRIPTION	BY	DATE

CURRENT DRAWING
Current Designer: INSITYA KAPASI I.K.
Current Designer: ROY BASSO R.B.
Current Design Verifier: ROY BASSO R.B.

ORIGINAL DRAWING
Drawing Creation Date: I.K.
Original Designer: I.K.
Original Design Verifier: I.K.

LOCATION
Bldg Number: Bldg Description:
Bldg Floor: Area/Functional Use:


TITLE
**DEMOLITION PENTHOUSE
LEVEL PLAN - OPENINGS AND
HOUSE KEEPING PADS**

Scale: AS NOTED Sheet Size: ANSI E

Drawing & File Name: 53P-2021-015-A202A

Layout Name: A202A


Old Elec File: Old Sheet Name:

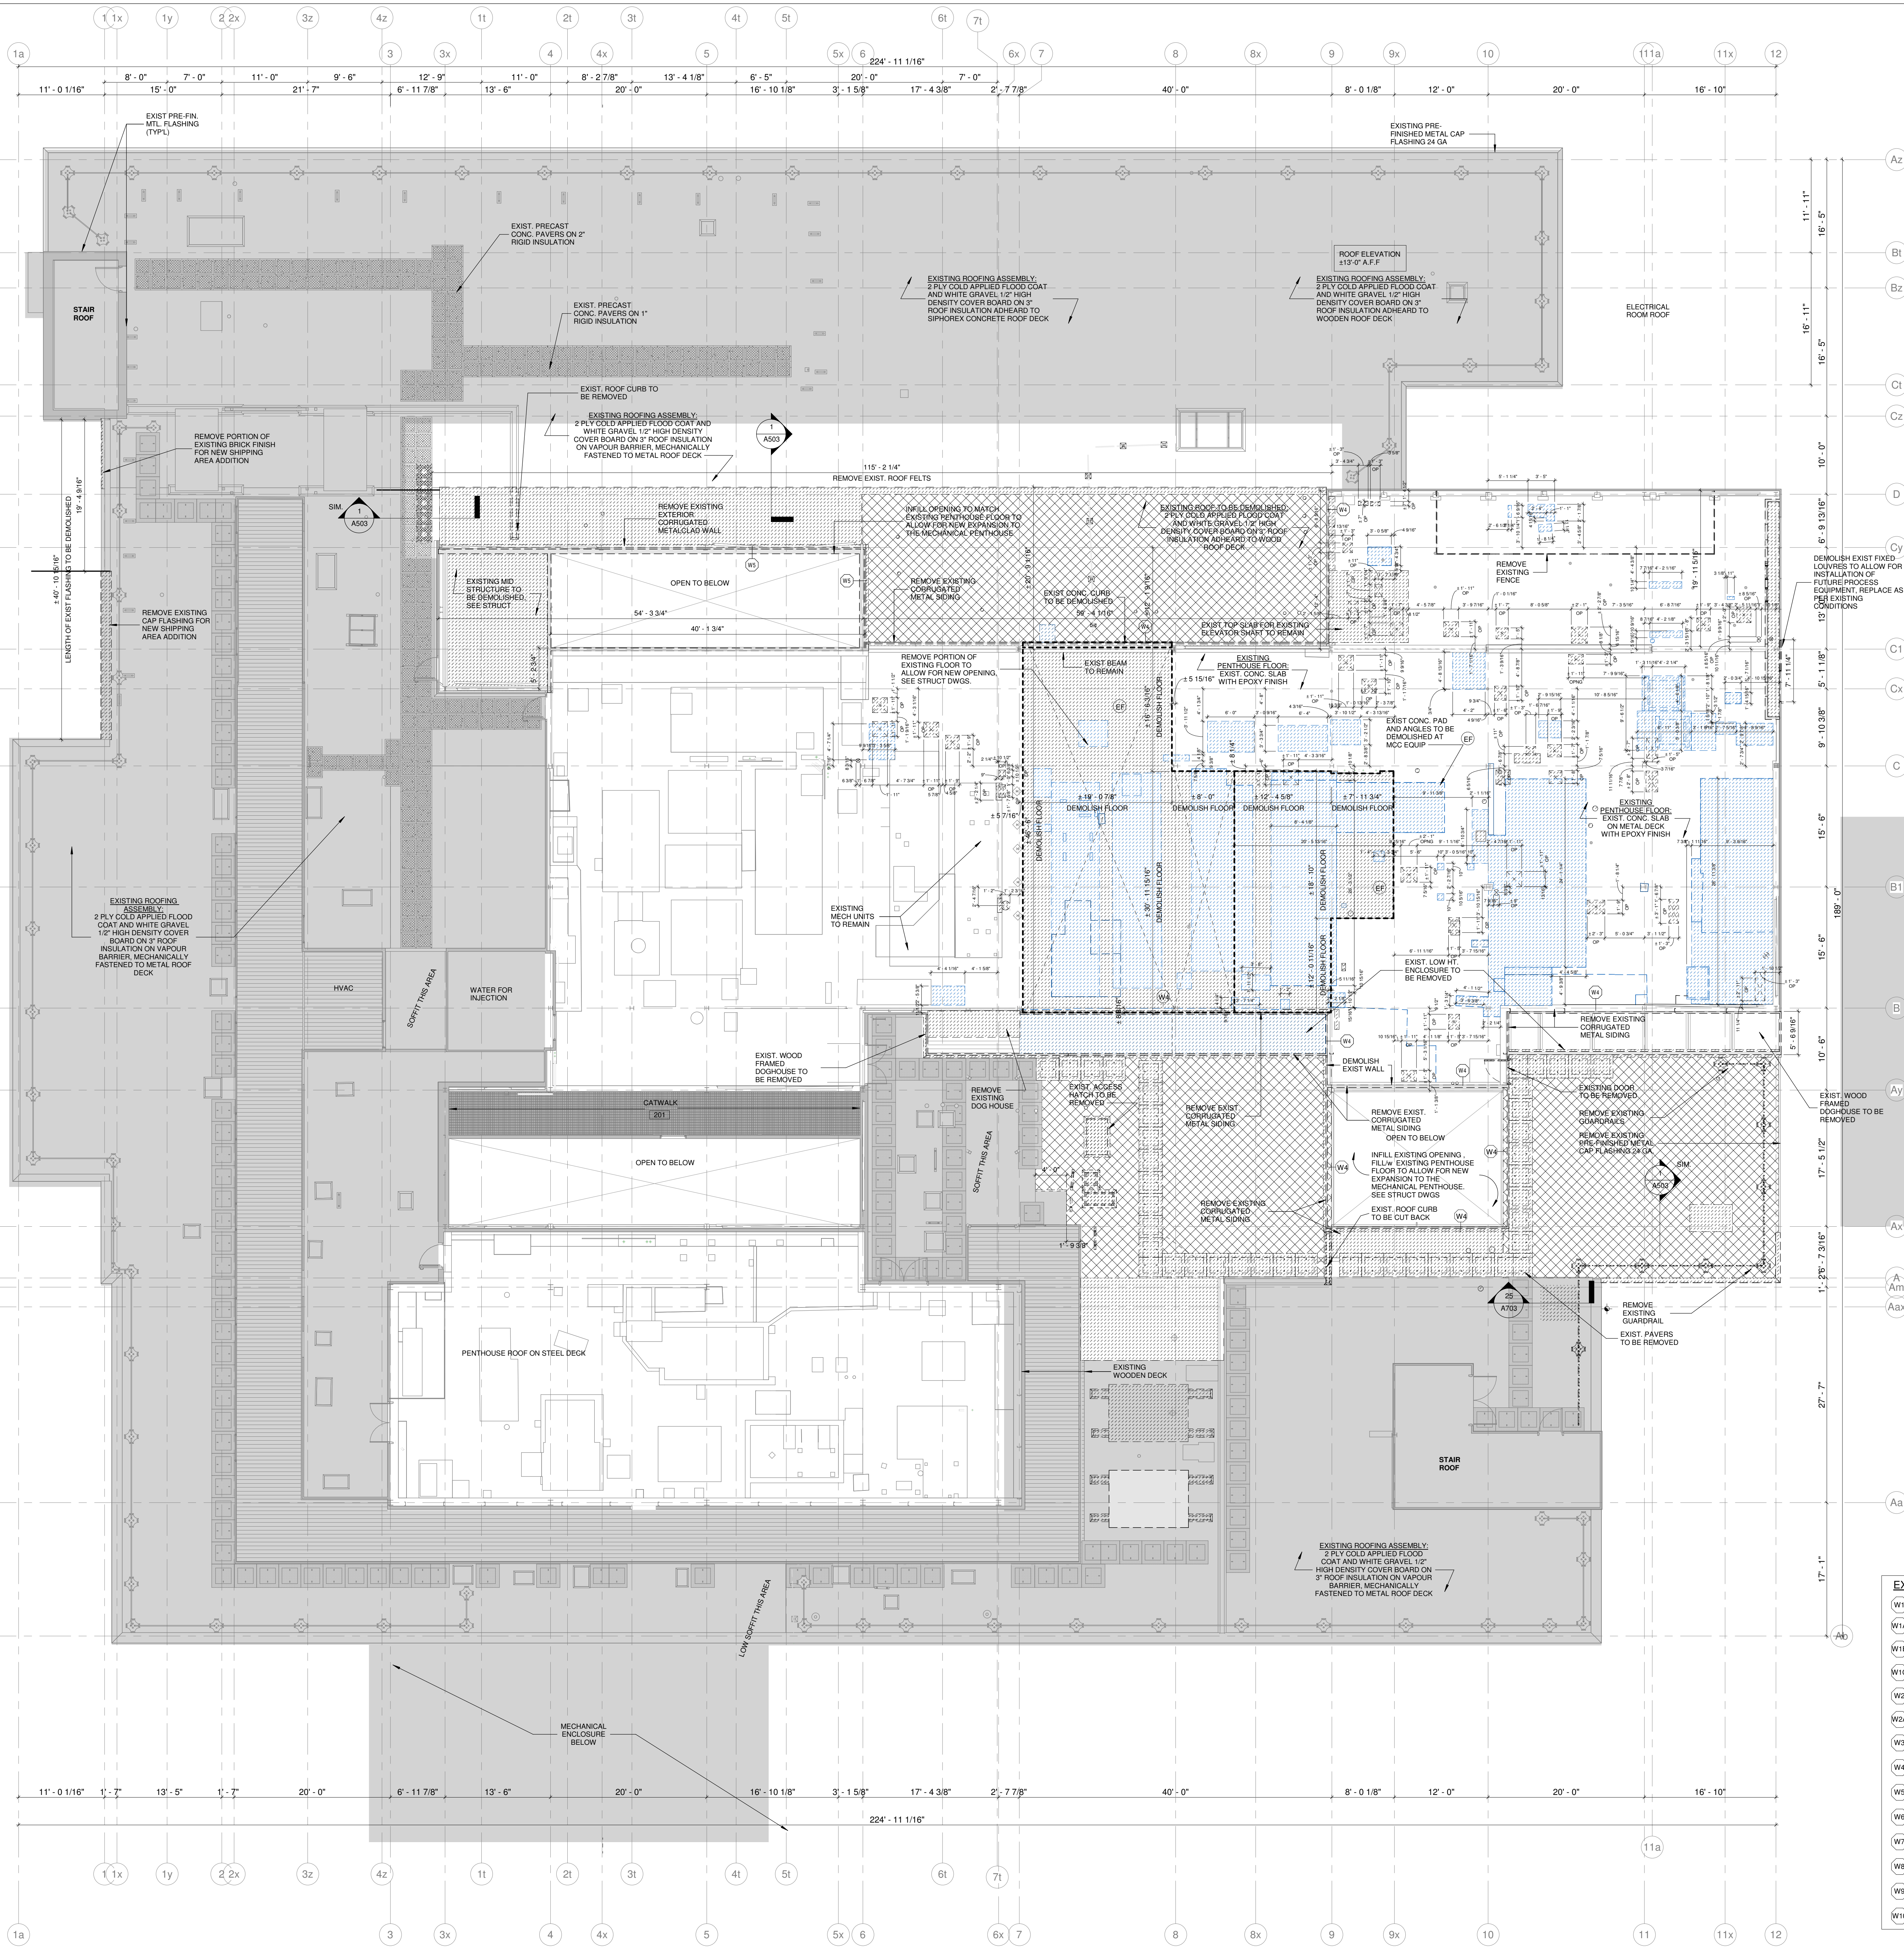

- EXIST. WALL LEGEND:**
- (W1) EXISTING CONCRETE BLOCK
 - (W1A) EXISTING CONCRETE BLOCK 6" THK
 - (W1B) EXISTING CONCRETE BLOCK 10" THK
 - (W1C) EXISTING CONCRETE BLOCK 8" THK
 - (W2) EXISTING GYP. BRD. ON BOTH
SIDES OF METAL STUDS
 - (W2A) EXISTING GYP. BRD. ON ONE
SIDE OF METAL STUDS
 - (W3) EXISTING 3 COURSE LOAD BEARING BRICK
MASONRY WALL WITH 1/2" AIR SPACE IN
BETWEEN
 - (W4) INSULATED METAL SIDING
 - (W5) INSULATED METAL SIDING ON AIR SPACE
ON 6" METAL STUD FILLED WITH BATT
INSULATION ON SHEATHING
 - (W6) EXIST FACE BRICK ON 3/4" AIR SPACE ON 8"
CONCRETE MASONRY BLOCK WALL
 - (W7) EXIST STUCCO ON RIGID INSULATION ON
FACE BRICK ON 3/4" AIR SPACE ON 8"
CONCRETE MASONRY BLOCK WALL
 - (W8) EXIST CONCRETE WALL
 - (W9) EXIST GYPSUM BOARD
 - (W10) EXIST INFILL
EXIST BRICK ON GYPSUM INSULATED WALL PANEL

DEMO PENTHOUSE LEVEL PLAN - OPENINGS AND HOUSEKEEPING PADS

1/8" = 1'-0"

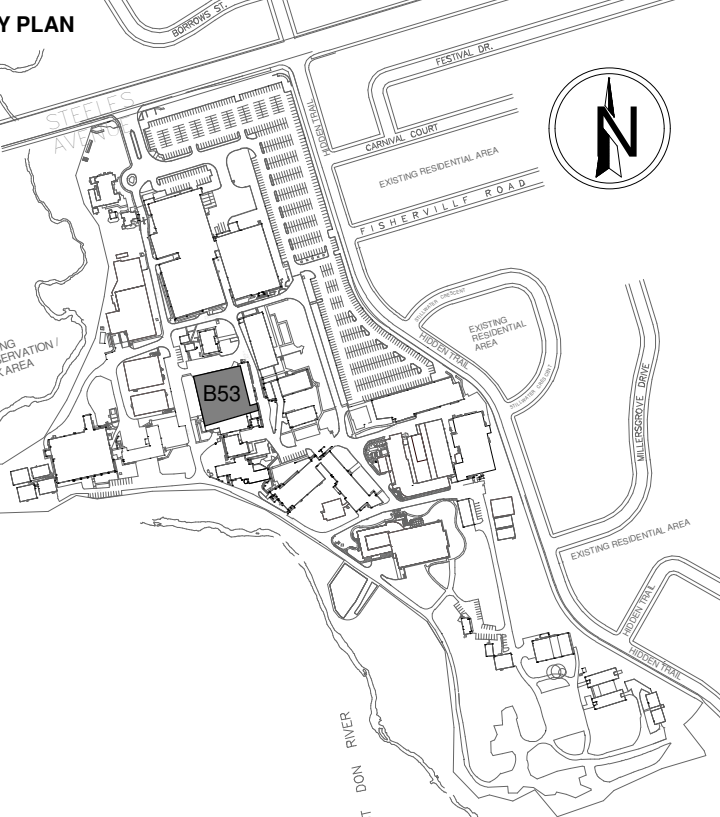

INTERNAL USE

Current Designer:

Version Description:

Version Date:

Approval Date:

Change Control Numbers:

DOCUMENT PERMISSIONS

Approval Date:

Approval Date:

PROJECT

sanofi pasteur

**SANOFI - B53 FORMULATION,
FILLING, INSPECTION &
PACKAGING (FFIP)**
1755 STEELES AVE. W. - NORTH YORK, ONTARIO M2R3T4
2210501

PRIME CONSULTANT

Cheme
35 Crawford Cres., Unit 1
P.O. Box 595
Campbellville, ON, L0P 1B0
T: (905) 450-0999 F: (905) 450-4115


CONSULTANT

wba
architects and engineers Inc.
3 - 530 Rossmore Dairy Road
Vaughan, Ontario L4L 8H2
Tel: (905) 881-7918
Fax: (905) 881-7918
Email: info@wbae.com


CONSULTANT

WALTERFEDY
KITCHENER OFFICE
575 Queen Street South, Suite 111, Kitchener, Ontario, N2M 1A1
T: 519.576.2150 F: 519.576.5499 walterfedy.com
Copyright © 2021 Walterfedy Inc.

True North:

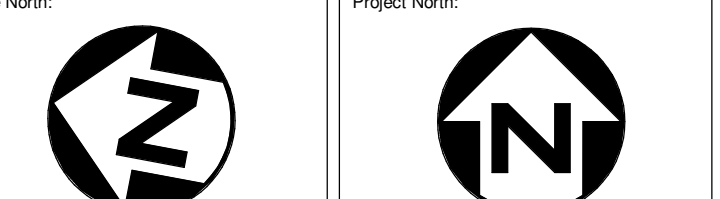


Project North:

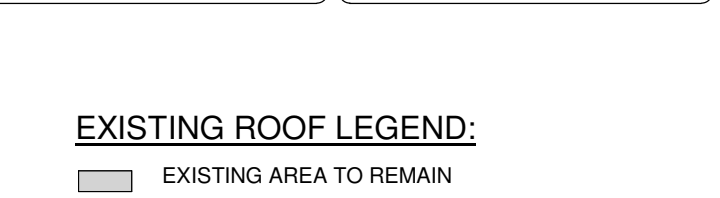

EXISTING ROOF LEGEND:

- EXISTING AREA TO REMAIN
- INTERIOR ALTERATION / NEW ADDITION
- EXISTING AREA OF WOOD DECK
- EXISTING ROOF FELTS TO BE REMOVED, EXIST METAL DECK BELOW TO REMAIN
- EXISTING ROOFING WITH ROOF DECK BELOW TO BE DEMOLISHED
- EXISTING WALLS TO REMAIN
- WALLS AND PARTITIONS TO BE REMOVED
- EXISTING DOOR AND FRAME

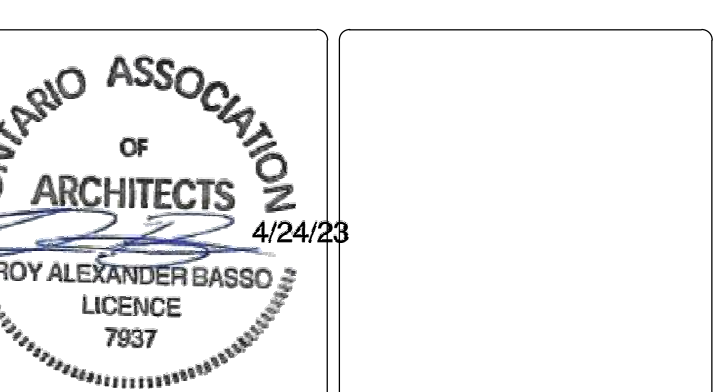

2	ISSUED FOR AS-BUILT	WBA	27MAR2026
1	ISSUED FOR CONSTRUCTION	WBA	12JAN2024
0	ISSUED FOR CONSTRUCTION	WBA	26SEP2023
I	ISSUED FOR TENDER ADDENDUM #02	WBA	15MAY2023
H	ISSUED FOR PERMIT AND TENDER	WBA	21APR2023
G	ISSUED FOR 90% DESIGN REVIEW	WBA	11FEB2023
F	ISSUED FOR 90% INTERIM REVIEW	WBA	16NOV2022
E	ISSUED FOR FINAL BASIC DESIGN	WBA	28APR2022
D	ISSUED FOR 60% UPDATES FOR CH-09	WBA	28APR2022
C	ISSUED FOR 60% DESIGN REVIEW	WBA	01APR2022
B	ISSUED FOR 30% DESIGN REVIEW	WBA	10FEB2022
A	ISSUED FOR 30% DESIGN REVIEW	WBA	10FEB2022

REVISION	DESCRIPTION	BY	DATE
2	ISSUED FOR AS-BUILT	WBA	27MAR2026
1	ISSUED FOR CONSTRUCTION	WBA	12JAN2024
0	ISSUED FOR CONSTRUCTION	WBA	26SEP2023
I	ISSUED FOR TENDER ADDENDUM #02	WBA	15MAY2023
H	ISSUED FOR PERMIT AND TENDER	WBA	21APR2023
G	ISSUED FOR 90% DESIGN REVIEW	WBA	11FEB2023
F	ISSUED FOR 90% INTERIM REVIEW	WBA	16NOV2022
E	ISSUED FOR FINAL BASIC DESIGN	WBA	28APR2022
D	ISSUED FOR 60% UPDATES FOR CH-09	WBA	28APR2022
C	ISSUED FOR 60% DESIGN REVIEW	WBA	01APR2022
B	ISSUED FOR 30% DESIGN REVIEW	WBA	10FEB2022
A	ISSUED FOR 30% DESIGN REVIEW	WBA	10FEB2022

Current Designer:	INSIYA KAPASI	IE:	I.K.
Current Designer:	ROY BASSO	IE:	R.B.
Current Design Verifier:	ROY BASSO	IE:	R.B.

Original Designer:		IE:	
Original Design Verifier:		IE:	



Block Number:		Block Description:	
Block Floor:		Block Functional Use:	

Scale:	AS NOTED	Sheet Size:	ANSI E
Drawing & File Name:	53P-2021-015-A203		
Layout Name:	A203		

Old Elec File: Old Sheet Name:

1 DEMO ROOF PLAN

A203 1/8" = 1'-0"

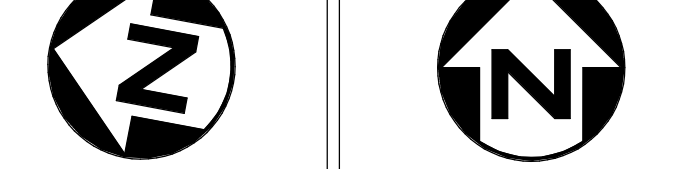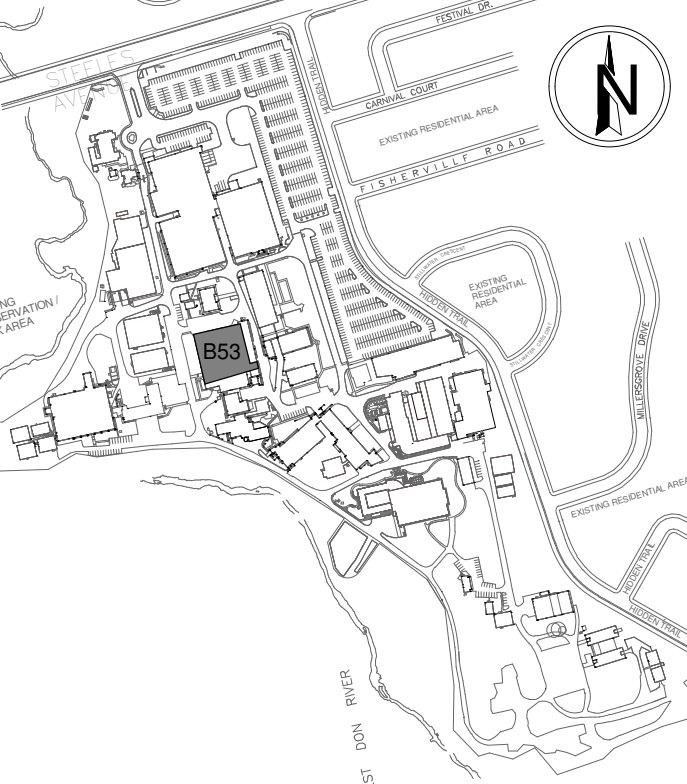

EXISTING CEILING LEGEND:

- EXISTING 2x4 LIGHT FIXTURE TO REMAIN
- EXISTING 1x4 LIGHT FIXTURE TO REMAIN
- EXISTING WALL MOUNTED LIGHT FIXTURE TO REMAIN
- EXISTING 1x4 CORNER LIGHT FIXTURE TO REMAIN
- EXISTING 2x2 LIGHT FIXTURE TO REMAIN
- EXISTING POT LIGHT FIXTURE TO REMAIN
- EXISTING 2x4 HEPA FILTER TO REMAIN
- EXISTING 2x2 DIFFUSER TO REMAIN
- EXISTING RETURN AIR GRILL TO REMAIN
- EXISTING EXIT SIGN TO REMAIN
- EXISTING SPRINKLER HEAD TO REMAIN
- EXISTING FIRE ALARM SPEAKER TO REMAIN
- EXISTING COMBINATION FIRE ALARM AND PUBLIC ADDRESS SPEAKER TO REMAIN
- EXTENT OF EXISTING CEILING TO BE REMOVED. REFER TO NEW PLAN FOR SCOPE OF WORK. COORDINATE WITH MECHANICAL AND ELECTRICAL DIVISION.
- EXTENT OF EXIST. LAP CEILING TO BE REMOVED.
- EXISTING 2x4 LIGHT FIXTURE TO BE REMOVED.
- EXISTING 1x4 LIGHT FIXTURE TO BE REMOVED.
- EXISTING WALL MOUNTED LIGHT FIXTURE TO BE REMOVED.
- EXISTING POT LIGHT FIXTURE TO BE REMOVED.
- EXISTING 2x2 LIGHT FIXTURE TO BE REMOVED.
- EXISTING 2x4 HEPA FILTER TO BE REMOVED.
- EXISTING 2x2 DIFFUSER TO BE REMOVED.
- EXISTING RETURN AIR GRILL TO BE REMOVED.
- EXISTING ACCESS PANEL TO BE REMOVED.
- EXISTING EXIT SIGN TO BE REMOVED.
- EXISTING SPRINKLER HEAD TO BE REMOVED AND RELOCATED. SEE NEW PLAN.

NOTE: ELECTRICAL AND MECHANICAL ITEMS ARE SHOWN FOR GENERAL REFERENCE ONLY. REFER TO THE RELATED DIVISION FOR FULL EXTENT OF WORK.

DEMOLITION REFLECTED CEILING PLAN - MAIN LEVEL

1
A211

1/8" = 1'-0"

Scale: AS NOTED Sheet Size: ANSI E


Drawing & File Name: 53P-2021-015-A211

Layout Name: A211

Old Elec File: Old Sheet Name:

CONFIDENTIAL - PROPRIETARY INFORMATION
 INGS, SPECIFICATIONS AND RELATED DOCUMENTS ARE INTENDED SOLELY FOR THE
 OF Sanofi Pasteur Limited AND MAY CONTAIN INFORMATION WHICH IS PRIVILEGED,
 CONFIDENTIAL, EXEMPT FROM DISCLOSURE UNDER APPLICABLE LAW OR SUBJECT TO
 URIGHT. ANY UNAUTHORIZED USE, DISCLOSURE, DISTRIBUTION, REPRODUCTION,
 REVIEW OR COPYING IS PROHIBITED AND MAY BE UNLAWFUL. THIS IS HIGHLY
 CONFIDENTIAL, COMMERCIAL AND PROPRIETARY INFORMATION WHICH CONSTITUTES
 TRADE SECRETS OF Sanofi Pasteur Limited™
VERIFY DIMENSIONS BEFORE USE

Y PLAN

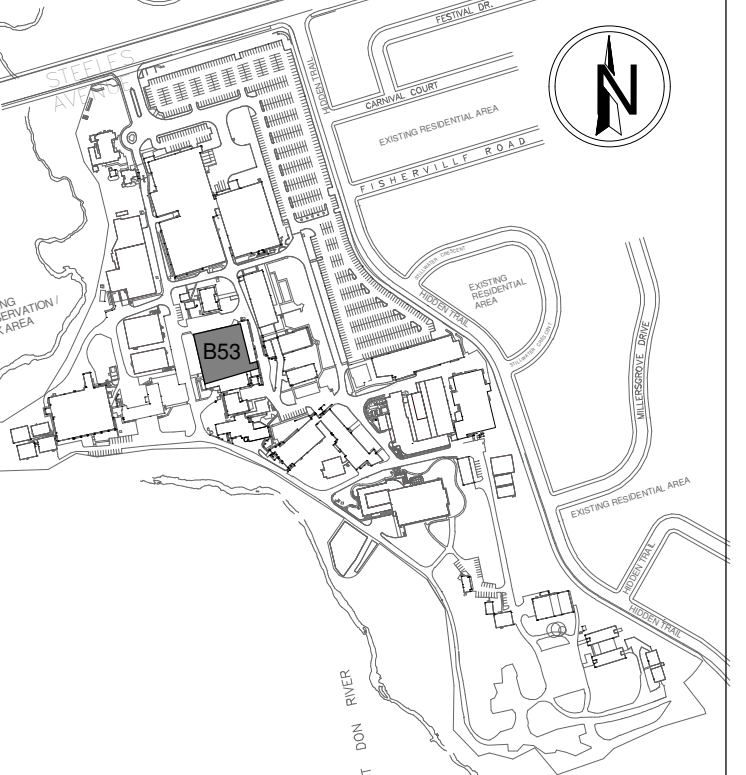

INTERNAL USE

it Designer:

in Description:

in Date:

Control Numbers:

DOCUMENT PERMISSIONS

val Date:

Final Date:

PROJECT

pastour

**ANOFI - B53 FORMULATION,
FILLING, INSPECTION &
PACKAGING (FFIP)**
1755 STEELES AVE W. NORTH YORK, ONTARIO M2R3T4
2210501

CONSULTANT





ULTANT



ULTANT



North:

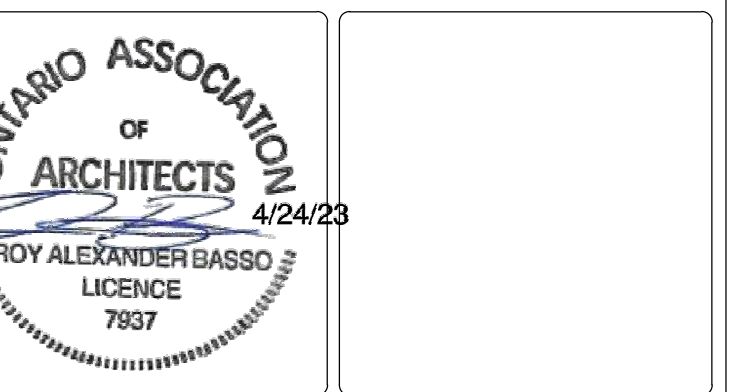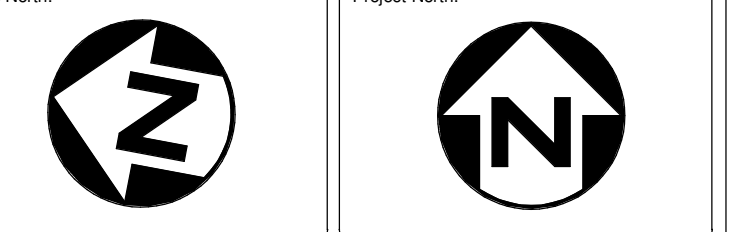

1	ISSUED FOR AS-BUILT	WBA	27MAR2026		
0	ISSUED FOR CONSTRUCTION	WBA	29SEP2023		
F	ISSUED FOR PERMIT AND TENDER	WBA	21APR2023		
E	ISSUED FOR 90% DESIGN REVIEW	WBA	17FEB2023		
D	ISSUED FOR 90% INTERM REVIEW	WBA	16NOV2022		
C	ISSUED FOR FINAL BASIC DESIGN	WBA	29APR2022		
B	ISSUED FOR 60% DESIGN REVIEW	WBA	01APR2022		
A	ISSUED FOR 30% DESIGN REVIEW	WBA	15FEB2022		
VISION	DESCRIPTION	BY	DATE		

CURRENT DRAWING

Drawn:	PRIYANKA SINHA	Init:	P.S.
Design:	ROY BASSO	Init:	R.B.
Design Verifier:	ROY BASSO	Init:	R.B.

AL DRAWING

Drawing Creation Date:	
Initial Drawer:	Init:
Initial Design Verifier	Init:

CATION

Number:	Bldg Description:
Floor:	Area/Functional Use:


DEMOLITION BUILDING ELEVATIONS


AS NOTED	Sheet Size:	ANGLE
----------	-------------	-------

g & File Name: **53P-2021-015-A212**

Name: A212

Old Sheet Name:

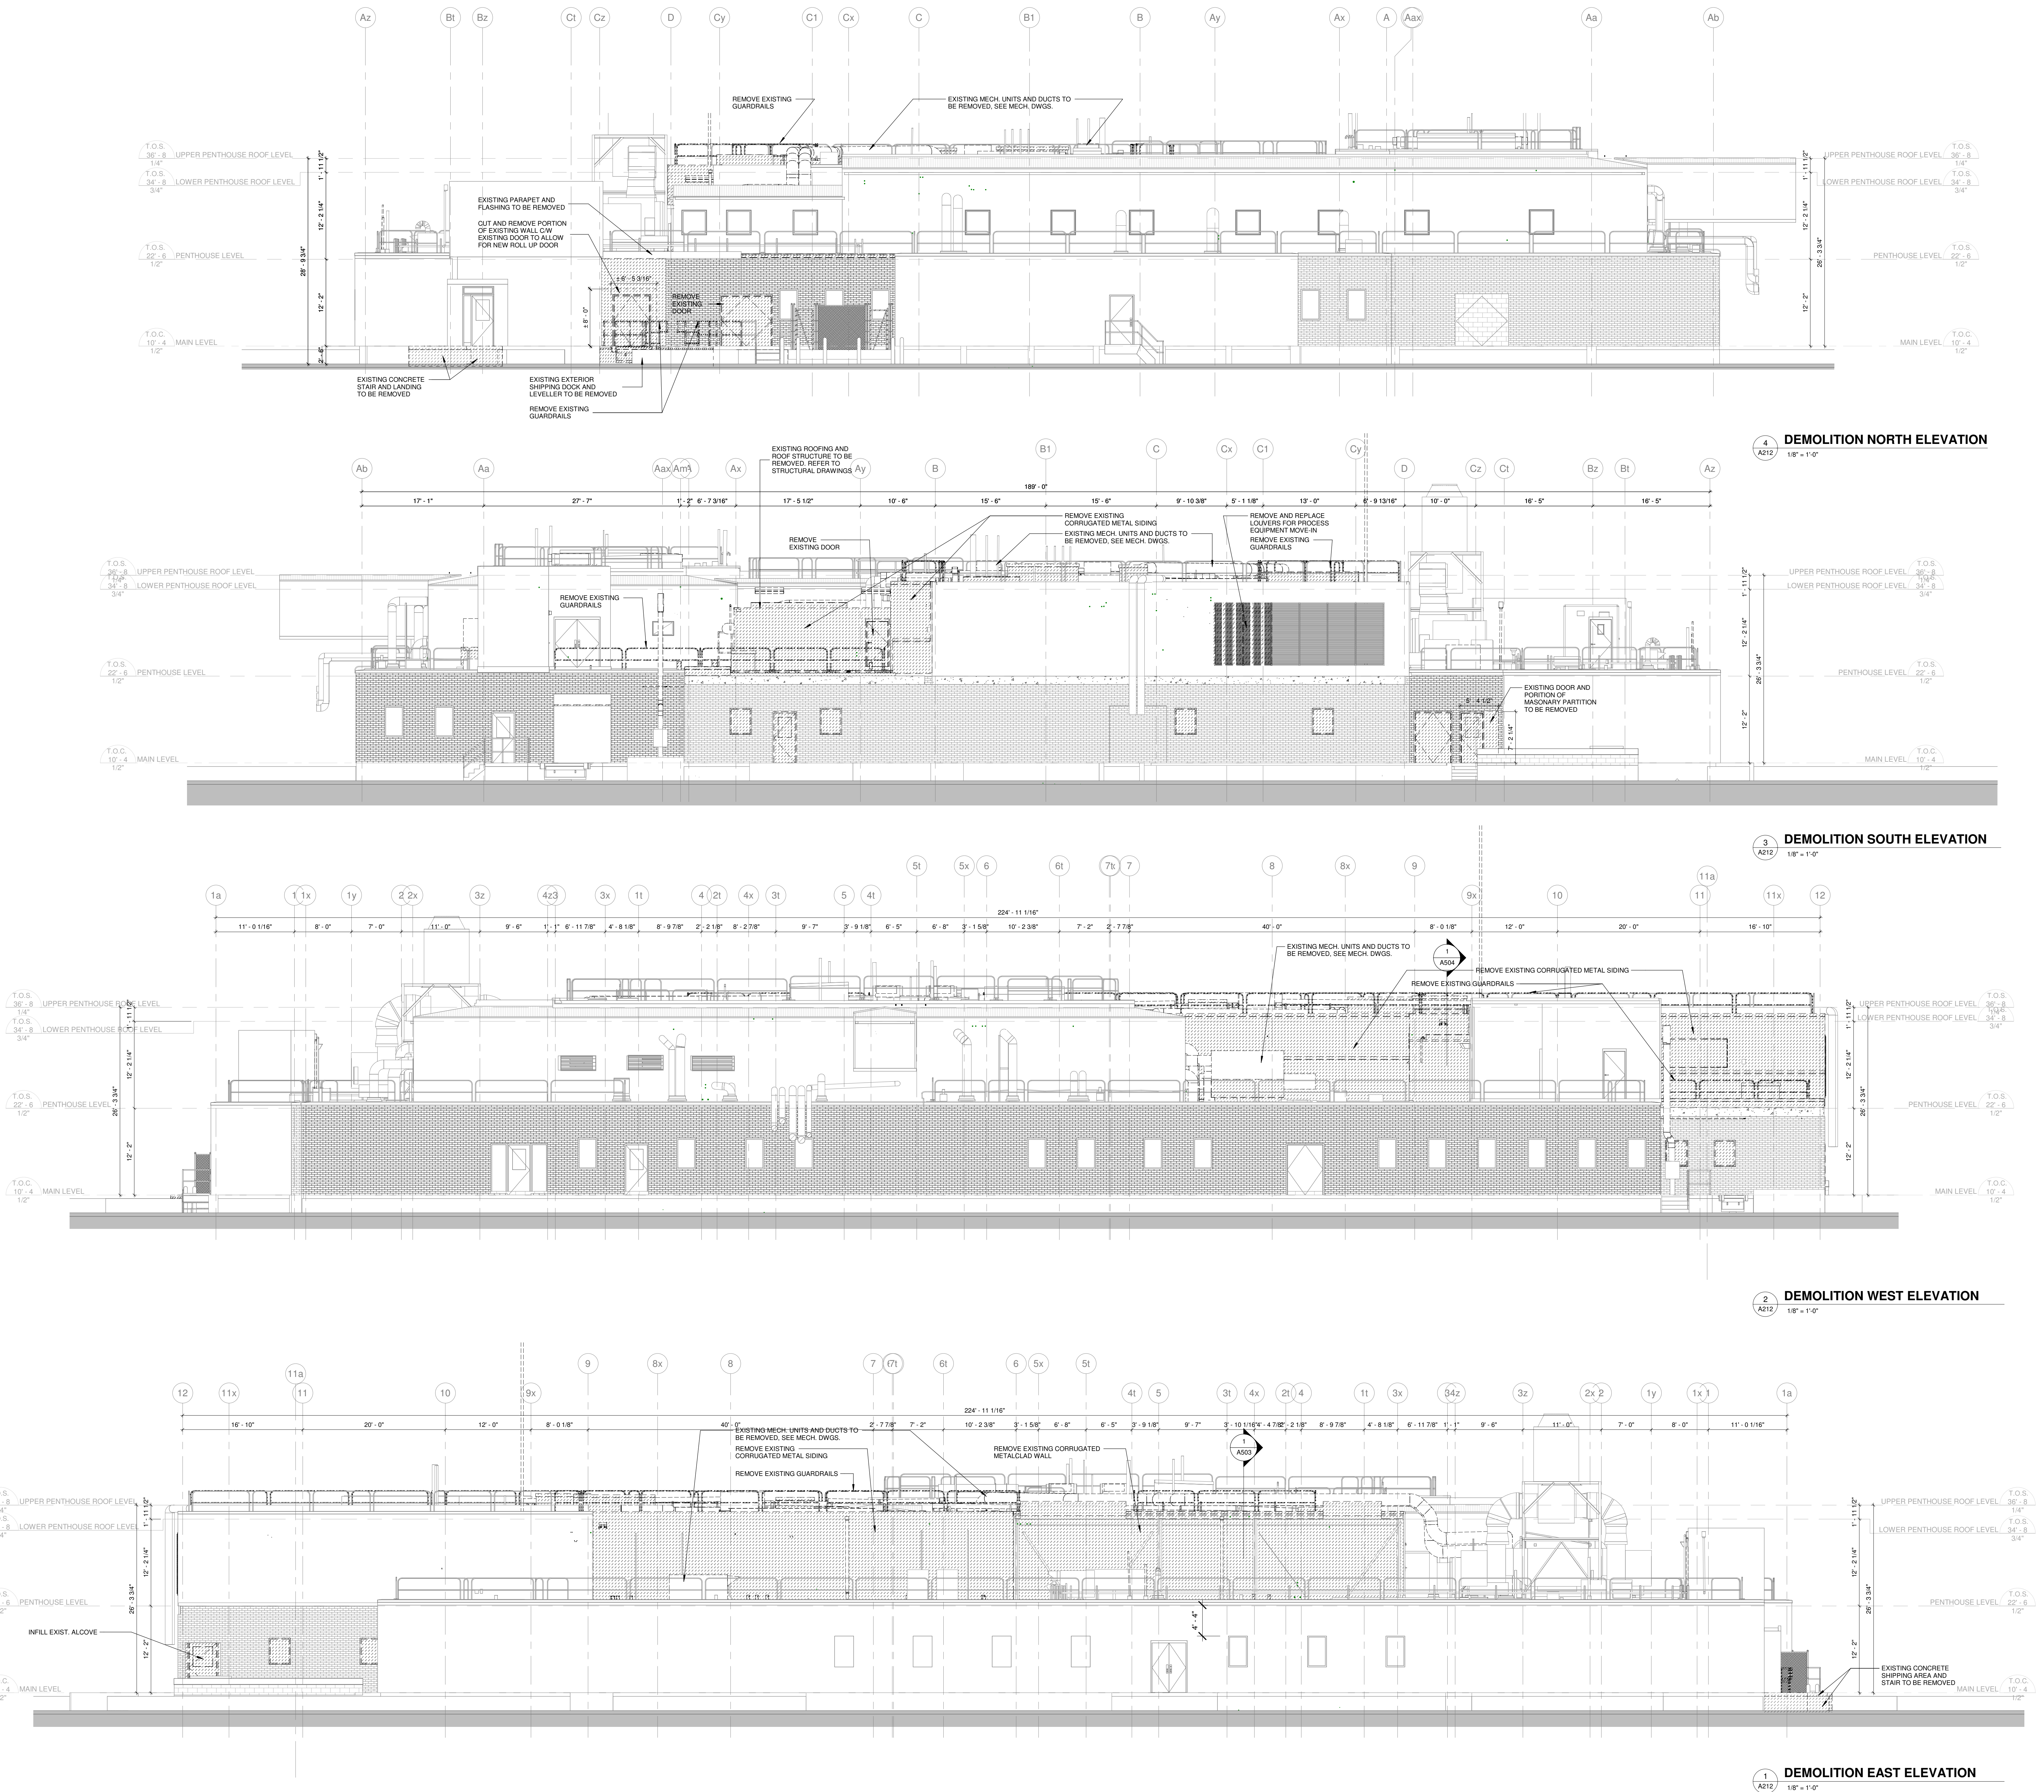

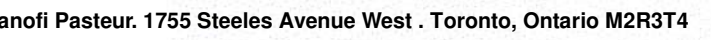

PLAN






in Description:






Print Date: _____

PROJECT

CONSULTANT

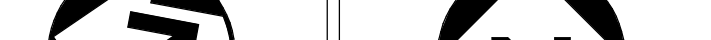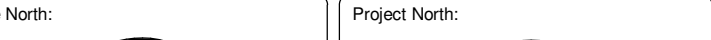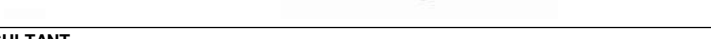

NEW ROOF LEGEND:

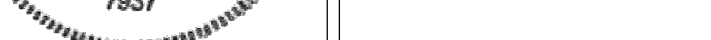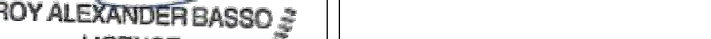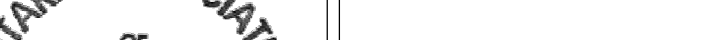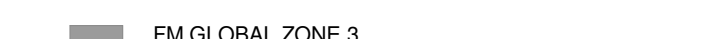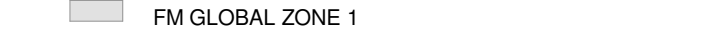

SION	DESCRIPTION	BY	DATE
------	-------------	----	------

Drawer: INSIYA KAPASI Init: I.K.

Design Verifier:	BOYASSO	init:	0.0
------------------	---------	-------	-----

ing Creation Cases.

Full Design Verifier	Init:
----------------------	-------

TITLE	
1	1. TITLE
2	2. AUTHOR
3	3. SUBJECT
4	4. DATE
5	5. LOCATION
6	6. PRICE
7	7. NOTES
8	8. INDEXING
9	9. SUMMARY
10	10. REFERENCES
11	11. ABSTRACT
12	12. FULLTEXT
13	13. CITATIONS
14	14. REVIEWS
15	15. COMMENTS
16	16. METADATA
17	17. BIBLIOGRAPHY
18	18. LITERATURE
19	19. JOURNAL
20	20. BOOK
21	21. ARTICLE
22	22. CHAPTER
23	23. EDITORIAL
24	24. INTRODUCTION
25	25. CONCLUSION
26	26. APPENDIX
27	27. SUPPLEMENT
28	28. ADDENDUM
29	29. CORRIGENDUM
30	30. REPLY
31	31. NOTICE
32	32. ANNOUNCEMENT
33	33. MEMORANDUM
34	34. REPORT
35	35. PAPER
36	36. THESIS
37	37. DISSERTATION
38	38. MONOGRAPH
39	39. TREATISE
40	40. COMPANION
41	41. SUPPLEMENTARY
42	42. ADDITIONAL
43	43. FURTHER
44	44. MORE
45	45. OTHER
46	46. ETC.
47	47. END
48	48. FINIS
49	49. THE END
50	50. FINIS



NEW BOOE PLAN

ANSI Z39.18	ANSI Z39.18
-------------	-------------

Name: A303

Doc File:	Old Sheet Name:
-----------	-----------------

1 NEW ROOF PLAN

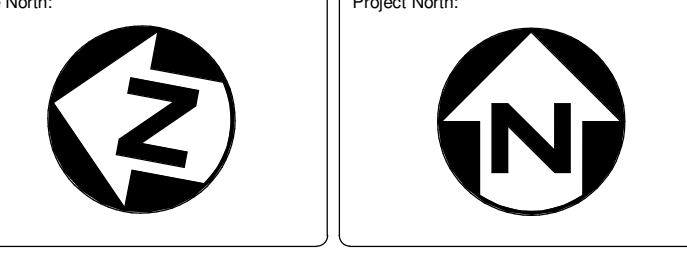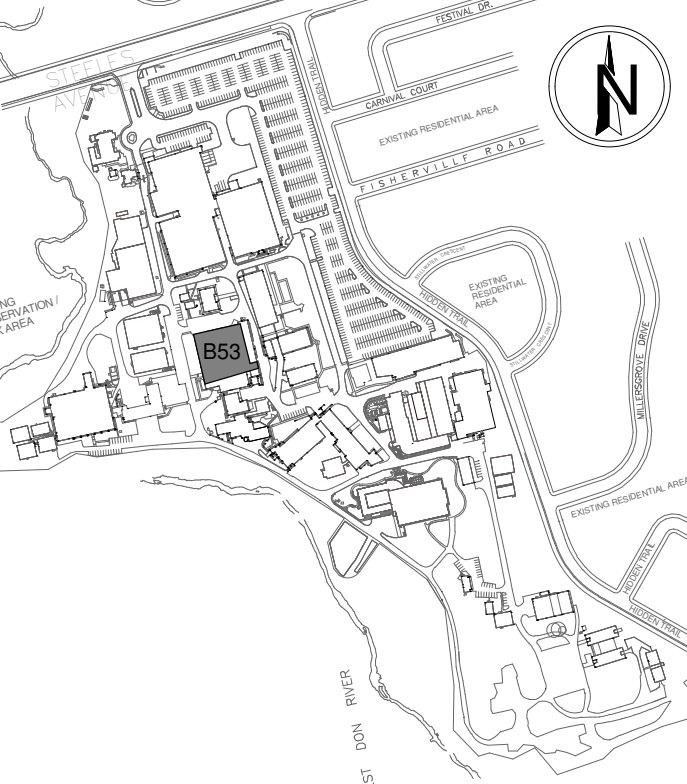

REVISION	DESCRIPTION	BY	DATE
1	ISSUED FOR AS-BUILT	WBA	27MAR2023
0	ISSUED FOR CONSTRUCTION	WBA	28SEP2023
F	ISSUED FOR PERMIT AND TENDER	WBA	21APR2023
E	ISSUED FOR 90% DESIGN REVIEW	WBA	17FEB2023
D	ISSUED FOR 90% INTERIM REVIEW	WBA	18NOV2022
C	ISSUED FOR FINAL BASIC DESIGN	WBA	29APR2022
B	ISSUED FOR 80% DESIGN REVIEW	WBA	01APR2022
A	ISSUED FOR 30% DESIGN REVIEW	WBA	10FEB2022

CURRENT DRAWING	
Current Designer:	INSIYA KAPASI
Current Designer:	ROY BASSO
Current Design Verifier:	ROY BASSO

ORIGINAL DRAWING	
Drawing Creation Date:	INC
Original Design Verifier:	INC

LOCATION	
Bldg Number:	Bldg Description:
Bldg Floor:	Area/Functional Use:





TITLE	
NEW BUILDING ELEVATIONS	


Scale:	AS NOTED	Sheet Size:	ANSI E
--------	----------	-------------	--------

Drawing & File Name:	53P-2021-015-A401
----------------------	--------------------------


Layout Name:	A401
--------------	-------------

Old Elec File:	Old Sheet Name:
----------------	-----------------

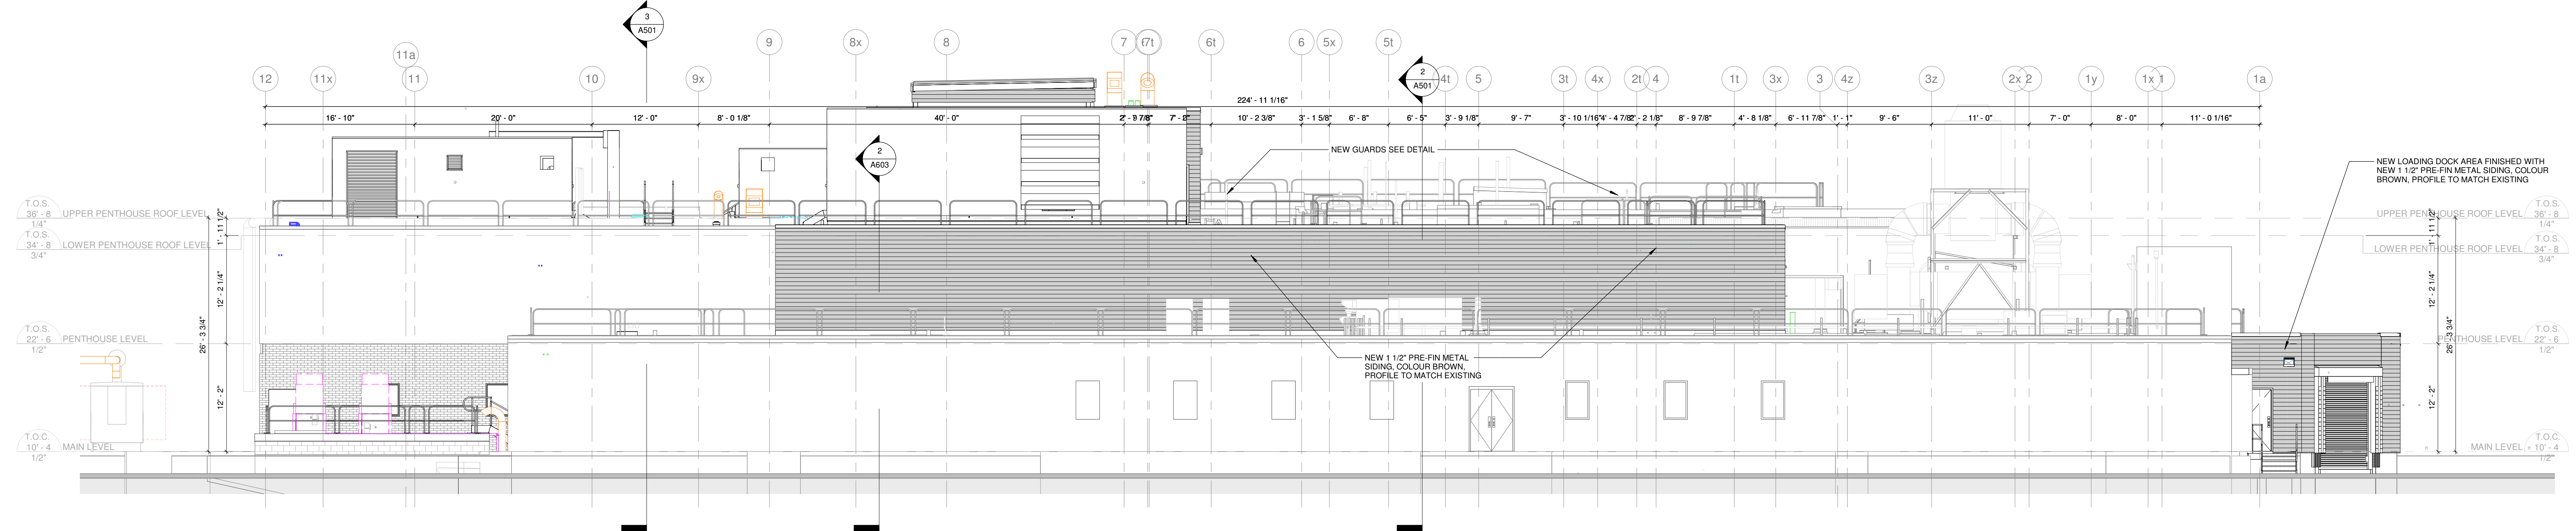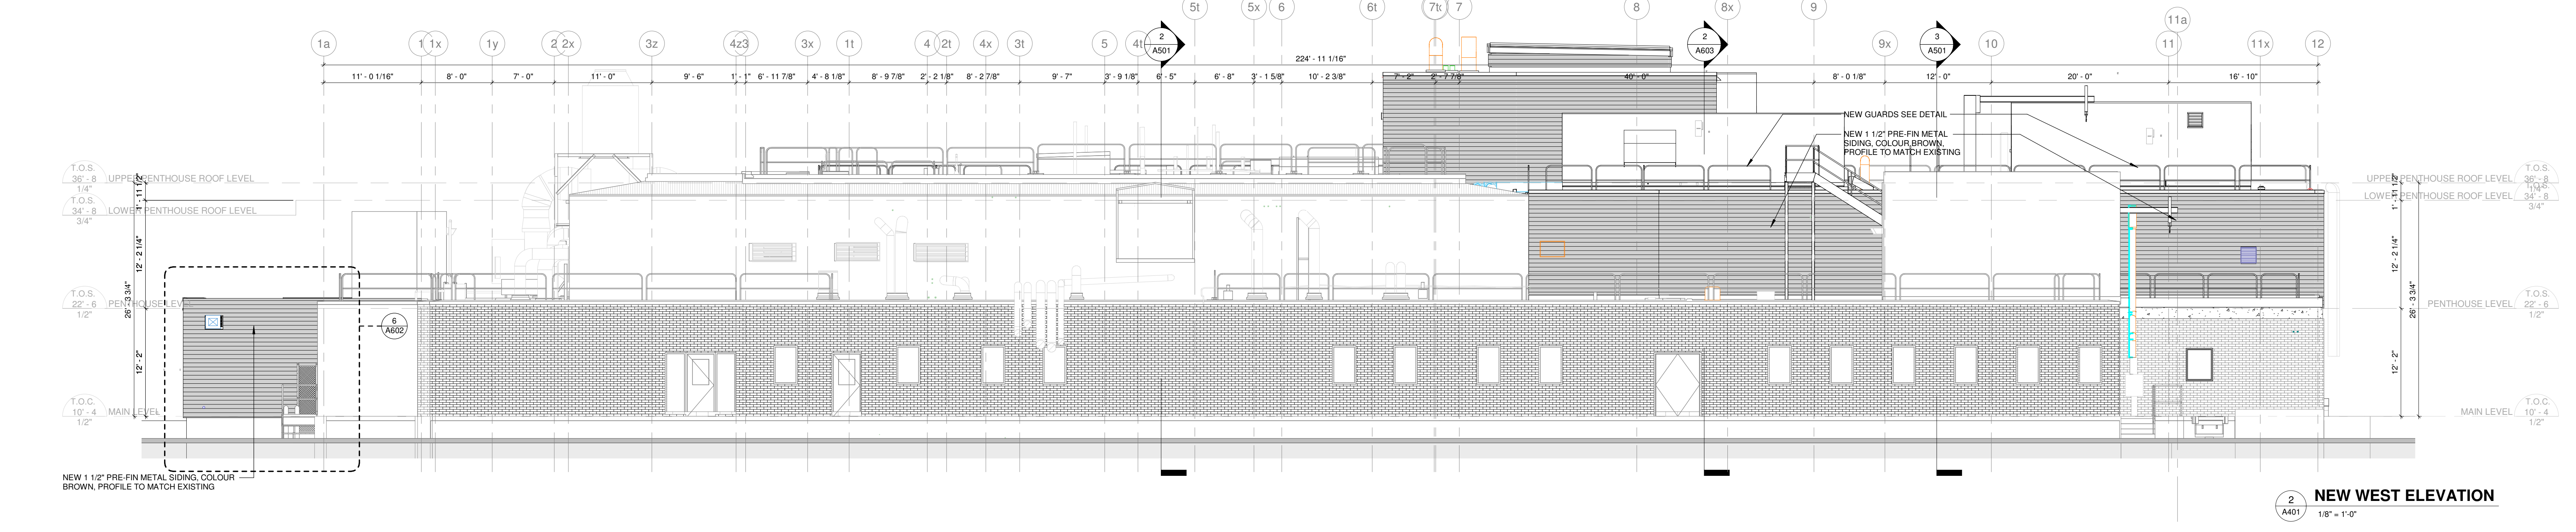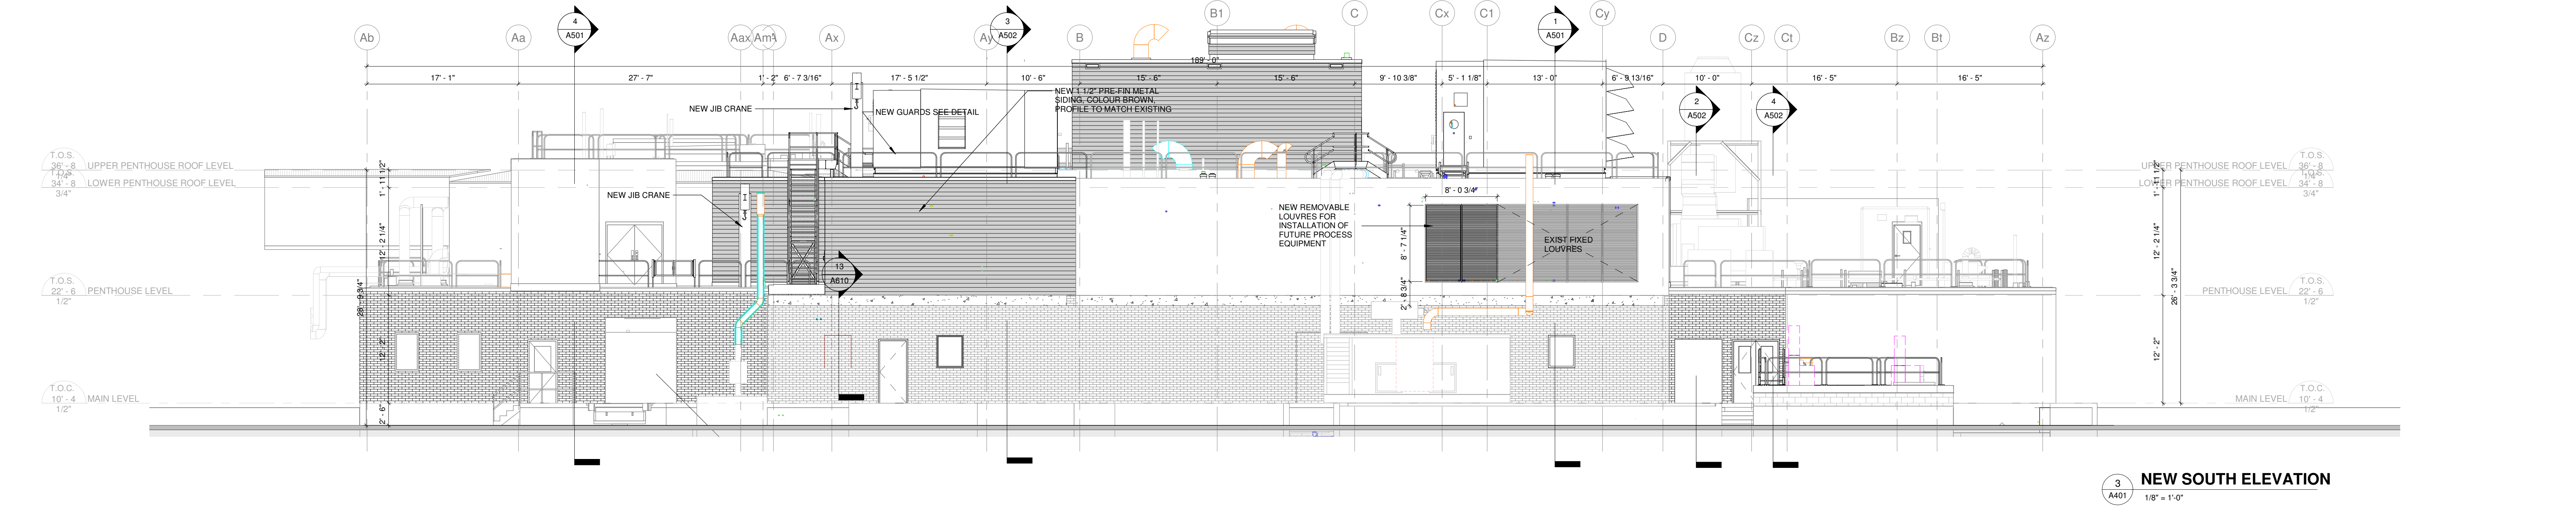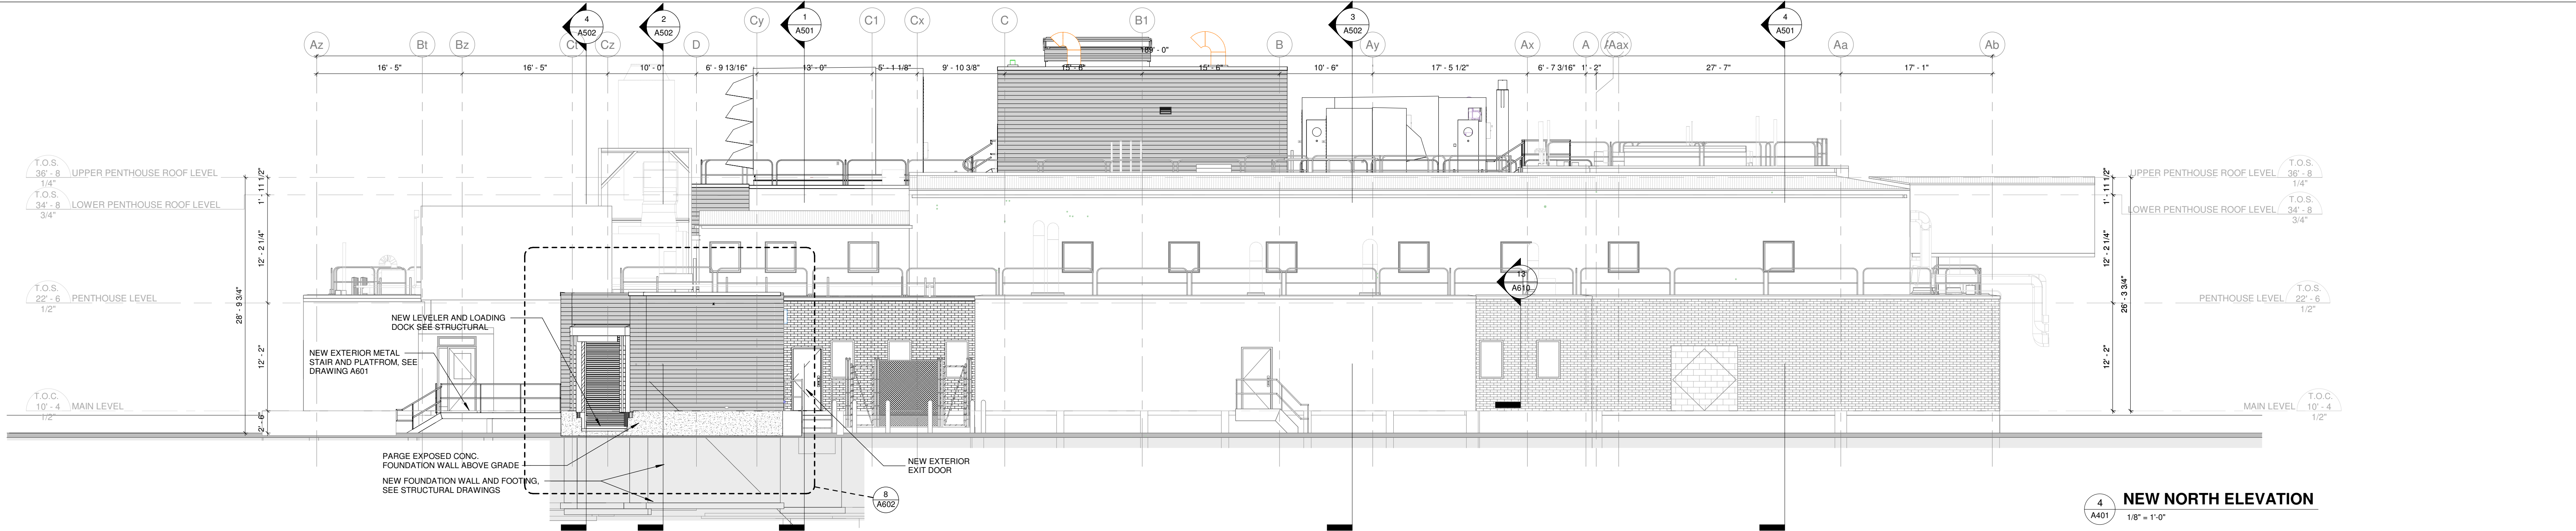


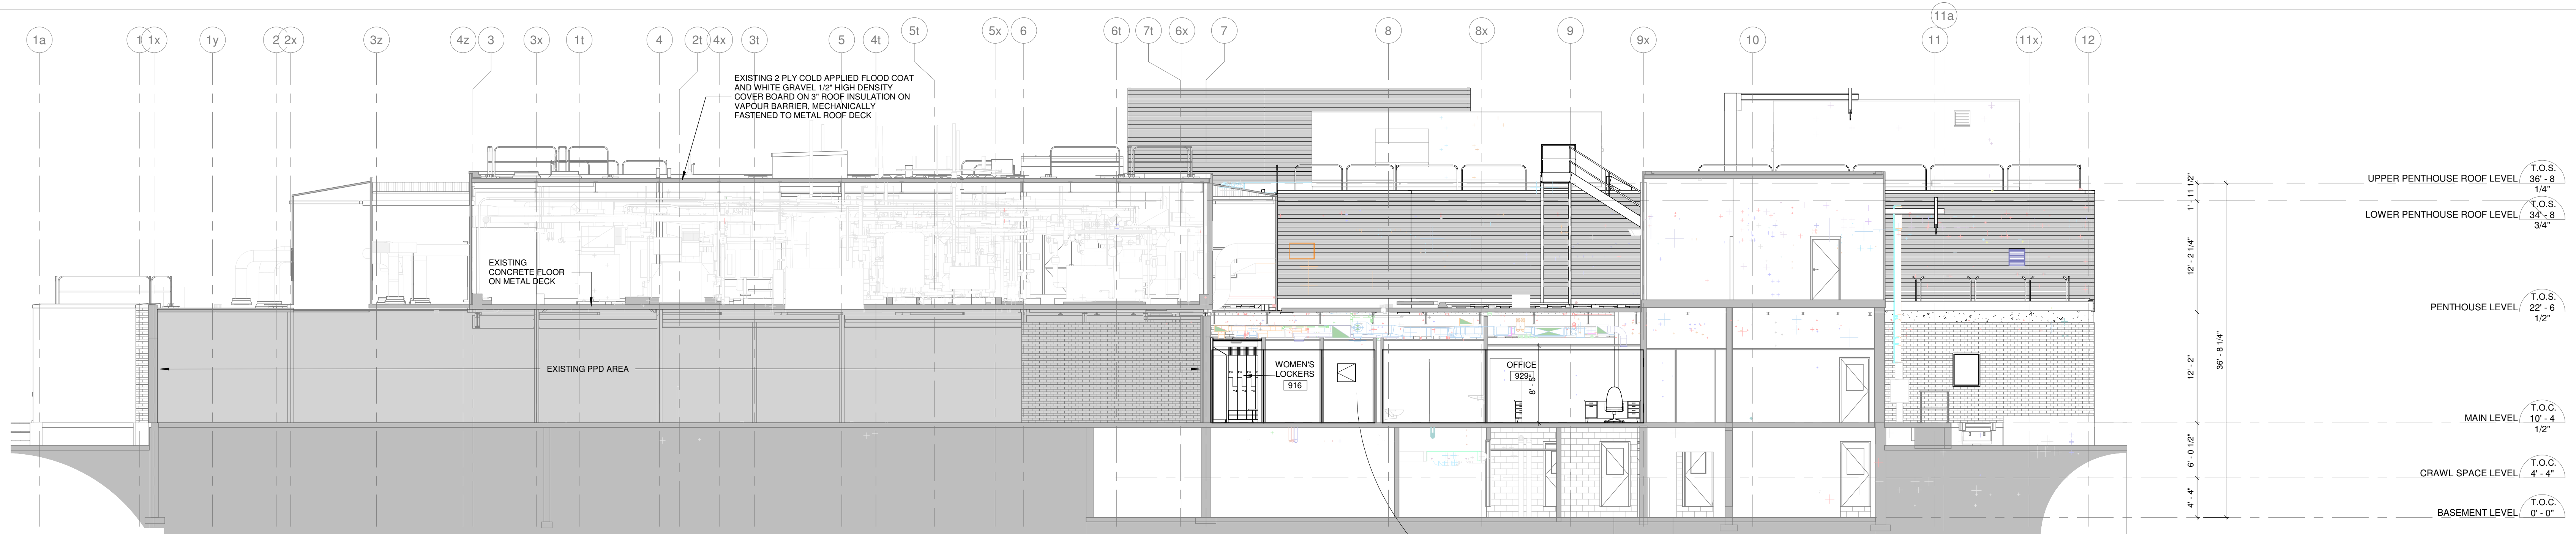


EAST-WEST SECTION 2
1/8" = 1'-0"

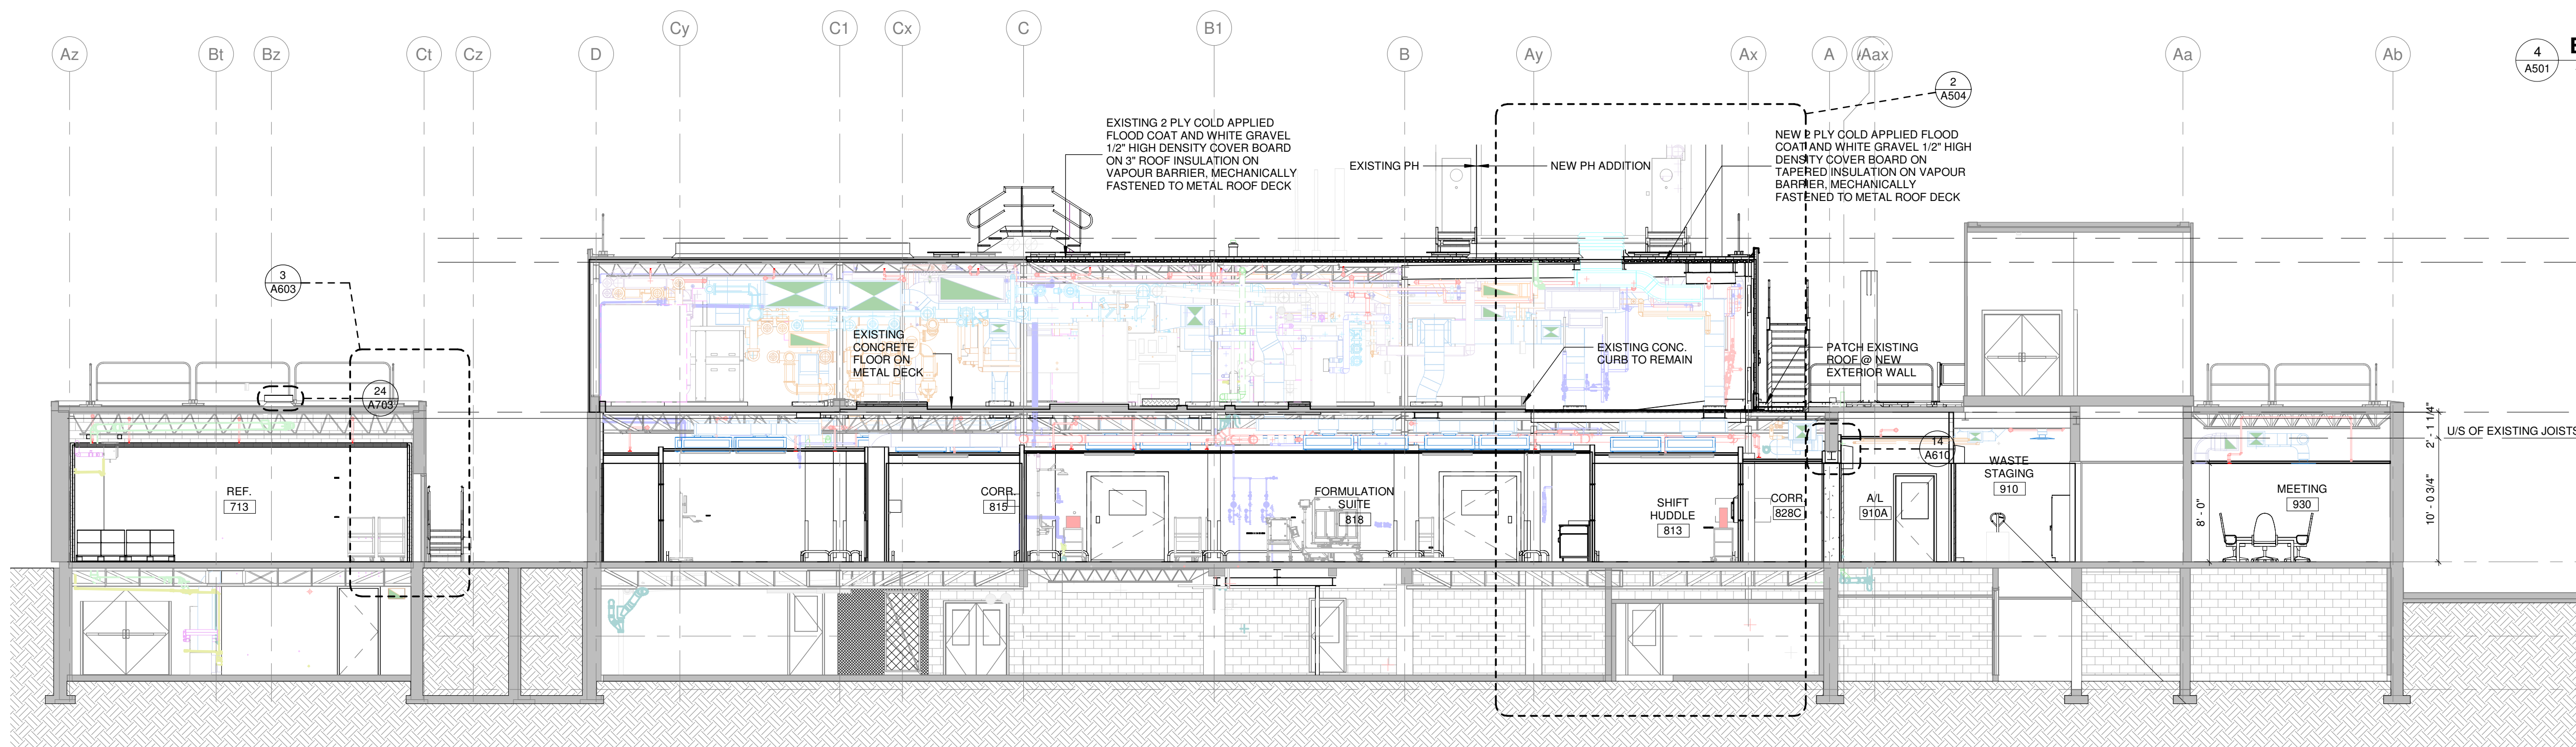

NORTH-SOUTH SECTION 2
1/8" = 1'-0"

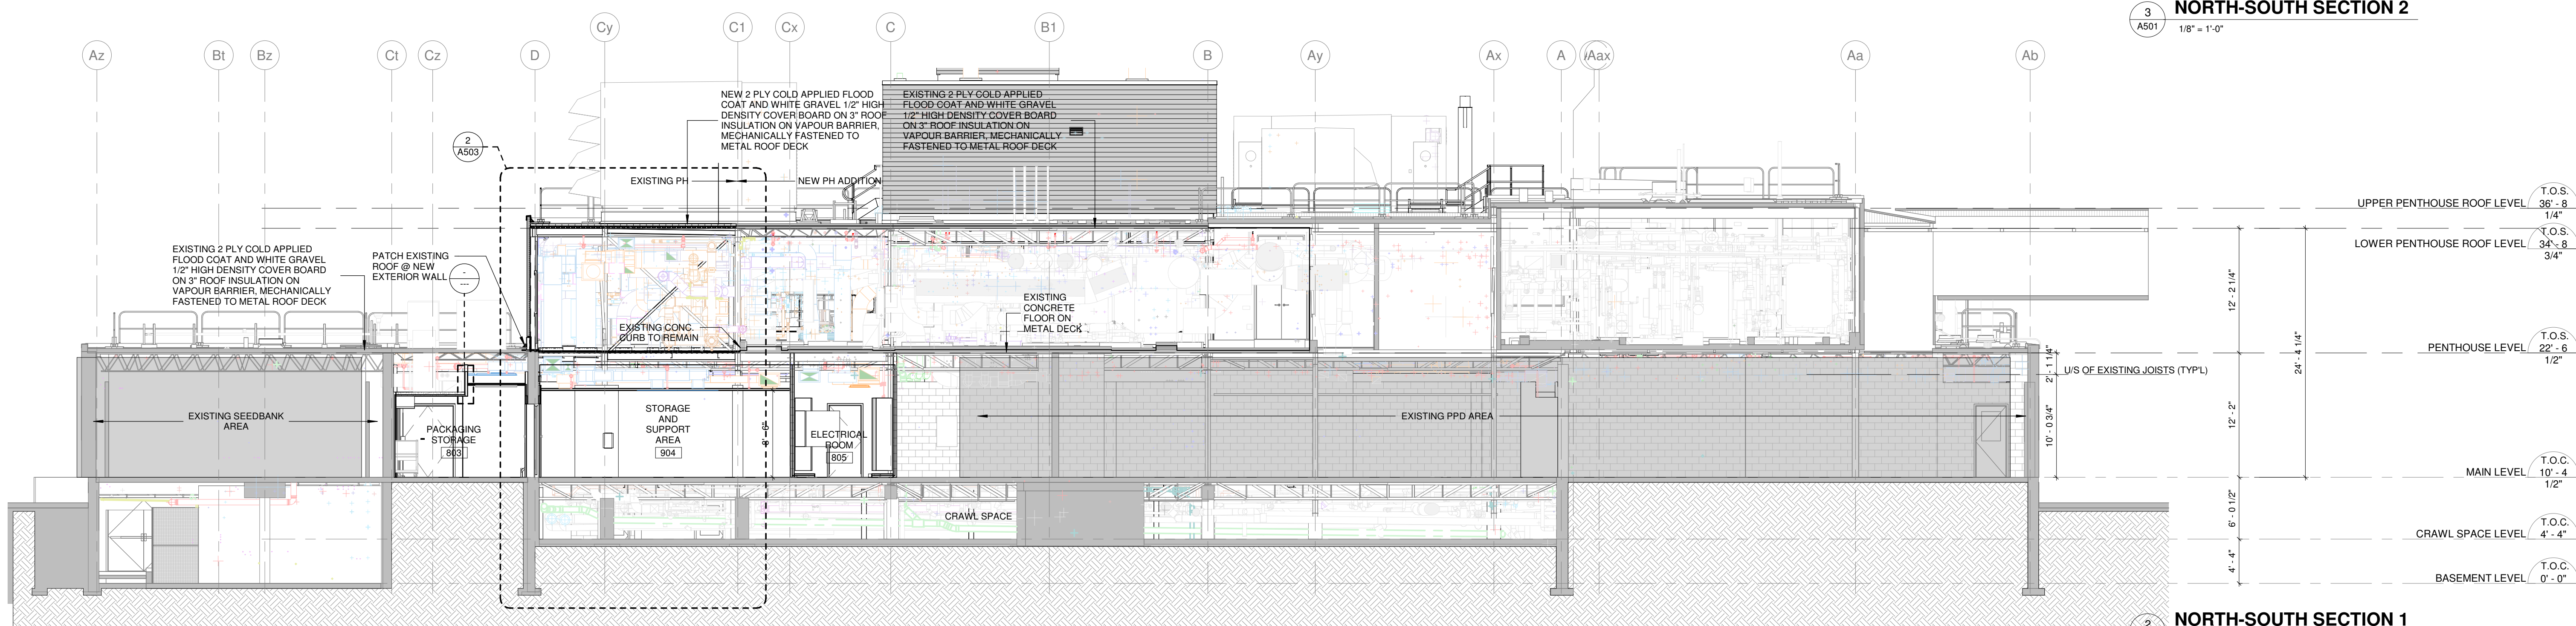

NORTH-SOUTH SECTION 1
1/8" = 1'-0"

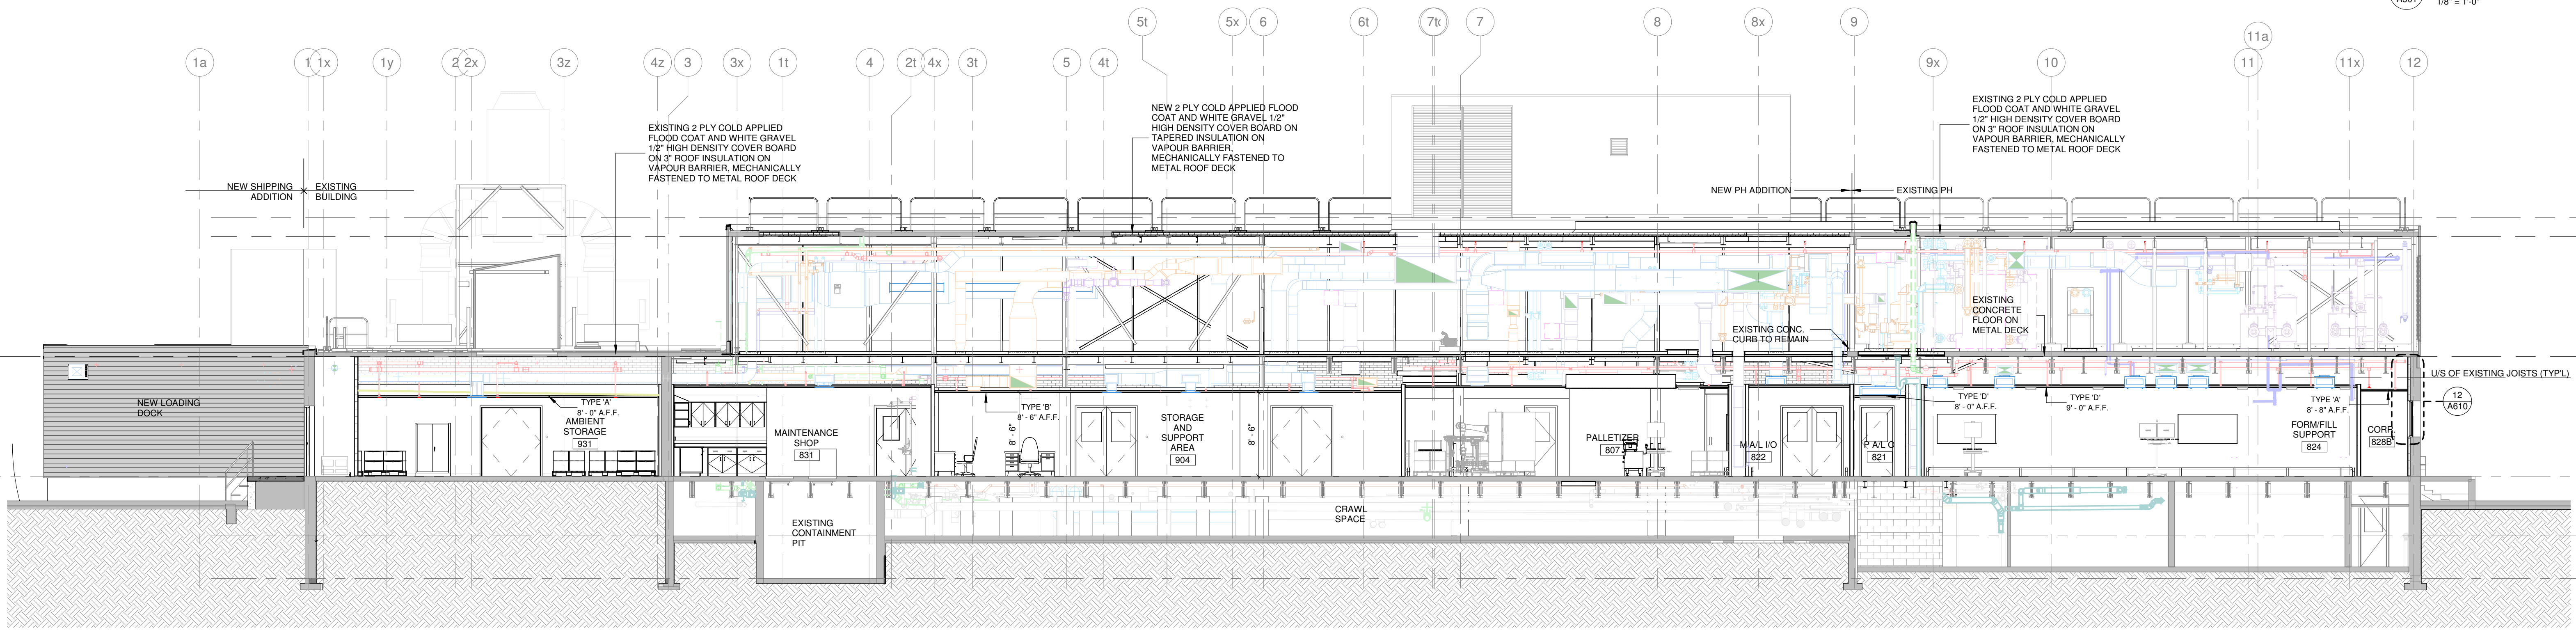


EAST-WEST SECTION 1
1/8" = 1'-0"

sanofi

Sanofi Pasteur, 1755 Steeles Avenue West - Toronto, Ontario M2R3T4

CONFIDENTIAL - PROPRIETARY INFORMATION
DRAWINGS, SPECIFICATIONS AND RELATED DOCUMENTS ARE INTENDED SOLELY FOR THE USE OF SANOFI PASTEUR LIMITED AND MAY CONTAIN INFORMATION WHICH IS PROPRIETARY, CONFIDENTIAL, TRADE SECRET OR OTHERWISE UNLAWFUL TO DISCLOSE OR TO REPRODUCE. ANY UNAUTHORIZED USE, DISCLOSURE, DISTRIBUTION, REPRODUCTION, REVIEW OR COPIING IS PROHIBITED AND MAY BE UNLAWFUL. THIS IS SOLELY THE PROPERTY OF SANOFI PASTEUR LIMITED.
VERIFY DIMENSIONS BEFORE USE

KEY PLAN

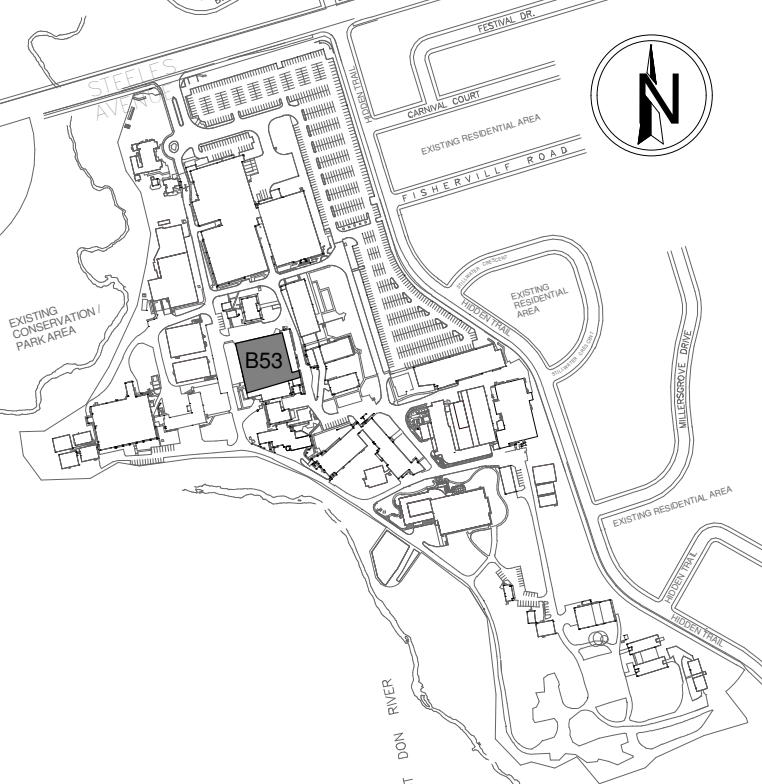

INTERNAL USE

Current Designer:
Version Description:
Version Date:
Approval Date:
Change Control Numbers:

DOCUMENT PERMISSIONS

Approval Date:
Approval Date:

PROJECT

sanofi pasteur
**SANOFI - B53 FORMULATION,
FILLING, INSPECTION &
PACKAGING (FFIP)**
1755 STEELES AVE. W., NORTH YORK, ONTARIO M2R3T4
2210501

PRIME CONSULTANT



Cheme
35 Crawford Cres., Unit 1
P.O. Box 595
Campbellville, ON, L0P 1B0
T: (905) 494-0999 F: (905) 494-4115

CONSULTANT

wba
architects and engineers Inc.
3 - 530 Rowntree Dairy Road
Vaughan, Ontario L4L 8H2
Tel: (905) 881-7128
Fax: (905) 881-7128
Email: info@wbaweb.com

CONSULTANT

WALTERFEDY
KITCHENER OFFICE
575 Queen Street South, Suite 111, Kitchener, Ontario, N2M 1A1
T: 519.576.2150 F: 519.576.5499 walterfedy.com
Copyright © 2021 WalterFedy Inc.

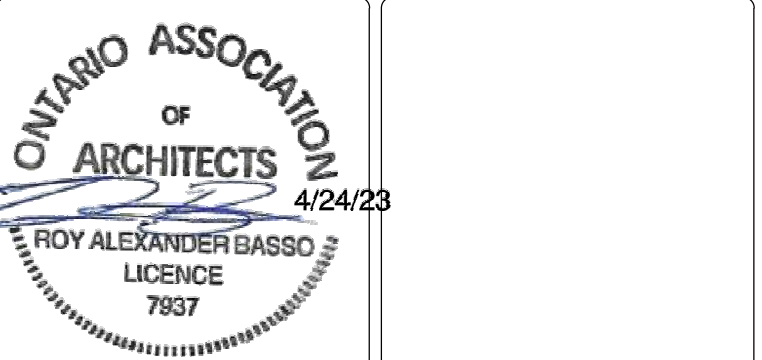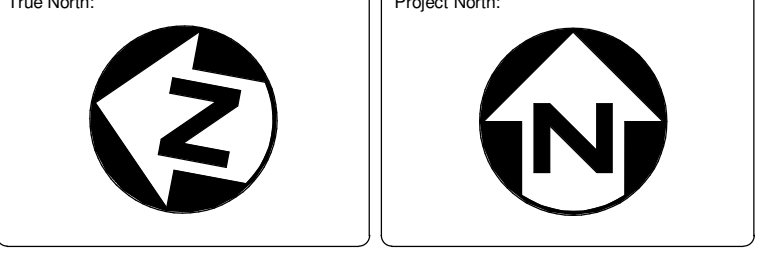

1	ISSUED FOR AS BUILT	WBA	27MAR2020
0	ISSUED FOR CONSTRUCTION	WBA	28SEP2020
H	ISSUED FOR POST CONTRACT ADDENDUM	WBA	11SEP2020
F	ISSUED FOR 30% DESIGN REVIEW	WBA	11FEB2021
G	ISSUED FOR PERMIT AND TENDER	WBA	21APR2021
F	ISSUED FOR 90% DESIGN REVIEW	WBA	16NOV2021
E	ISSUED FOR 90% INTERIM REVIEW	WBA	16NOV2021
D	ISSUED FOR FINAL BASIC DESIGN	WBA	28APR2022
C	ISSUED FOR 60% DESIGN REVIEW	WBA	01APR2022
B	ISSUED FOR 30% DESIGN REVIEW	WBA	15FEB2022
A	ISSUED FOR CLIENT REVIEW	WBA	12JUL2021
REVISION	DESCRIPTION	BY	DATE

CURRENT DRAWING

Current Designer: INSIVA KAPASI
Current Designer: ROY BASSO
Current Design Verifier: ROY BASSO

ORIGINAL DRAWING

Drawing Creation Date:
Original Design Verifier:

LOCATION

Block Number:
Block Description:

TITLE


NEW BUILDING SECTIONS

Scale: AS NOTED Sheet Size: ANSI E


Drawing & File Name: **53P-2021-015-A501**

Layout Name: **A501**


Old Elec File: Old Sheet Name:

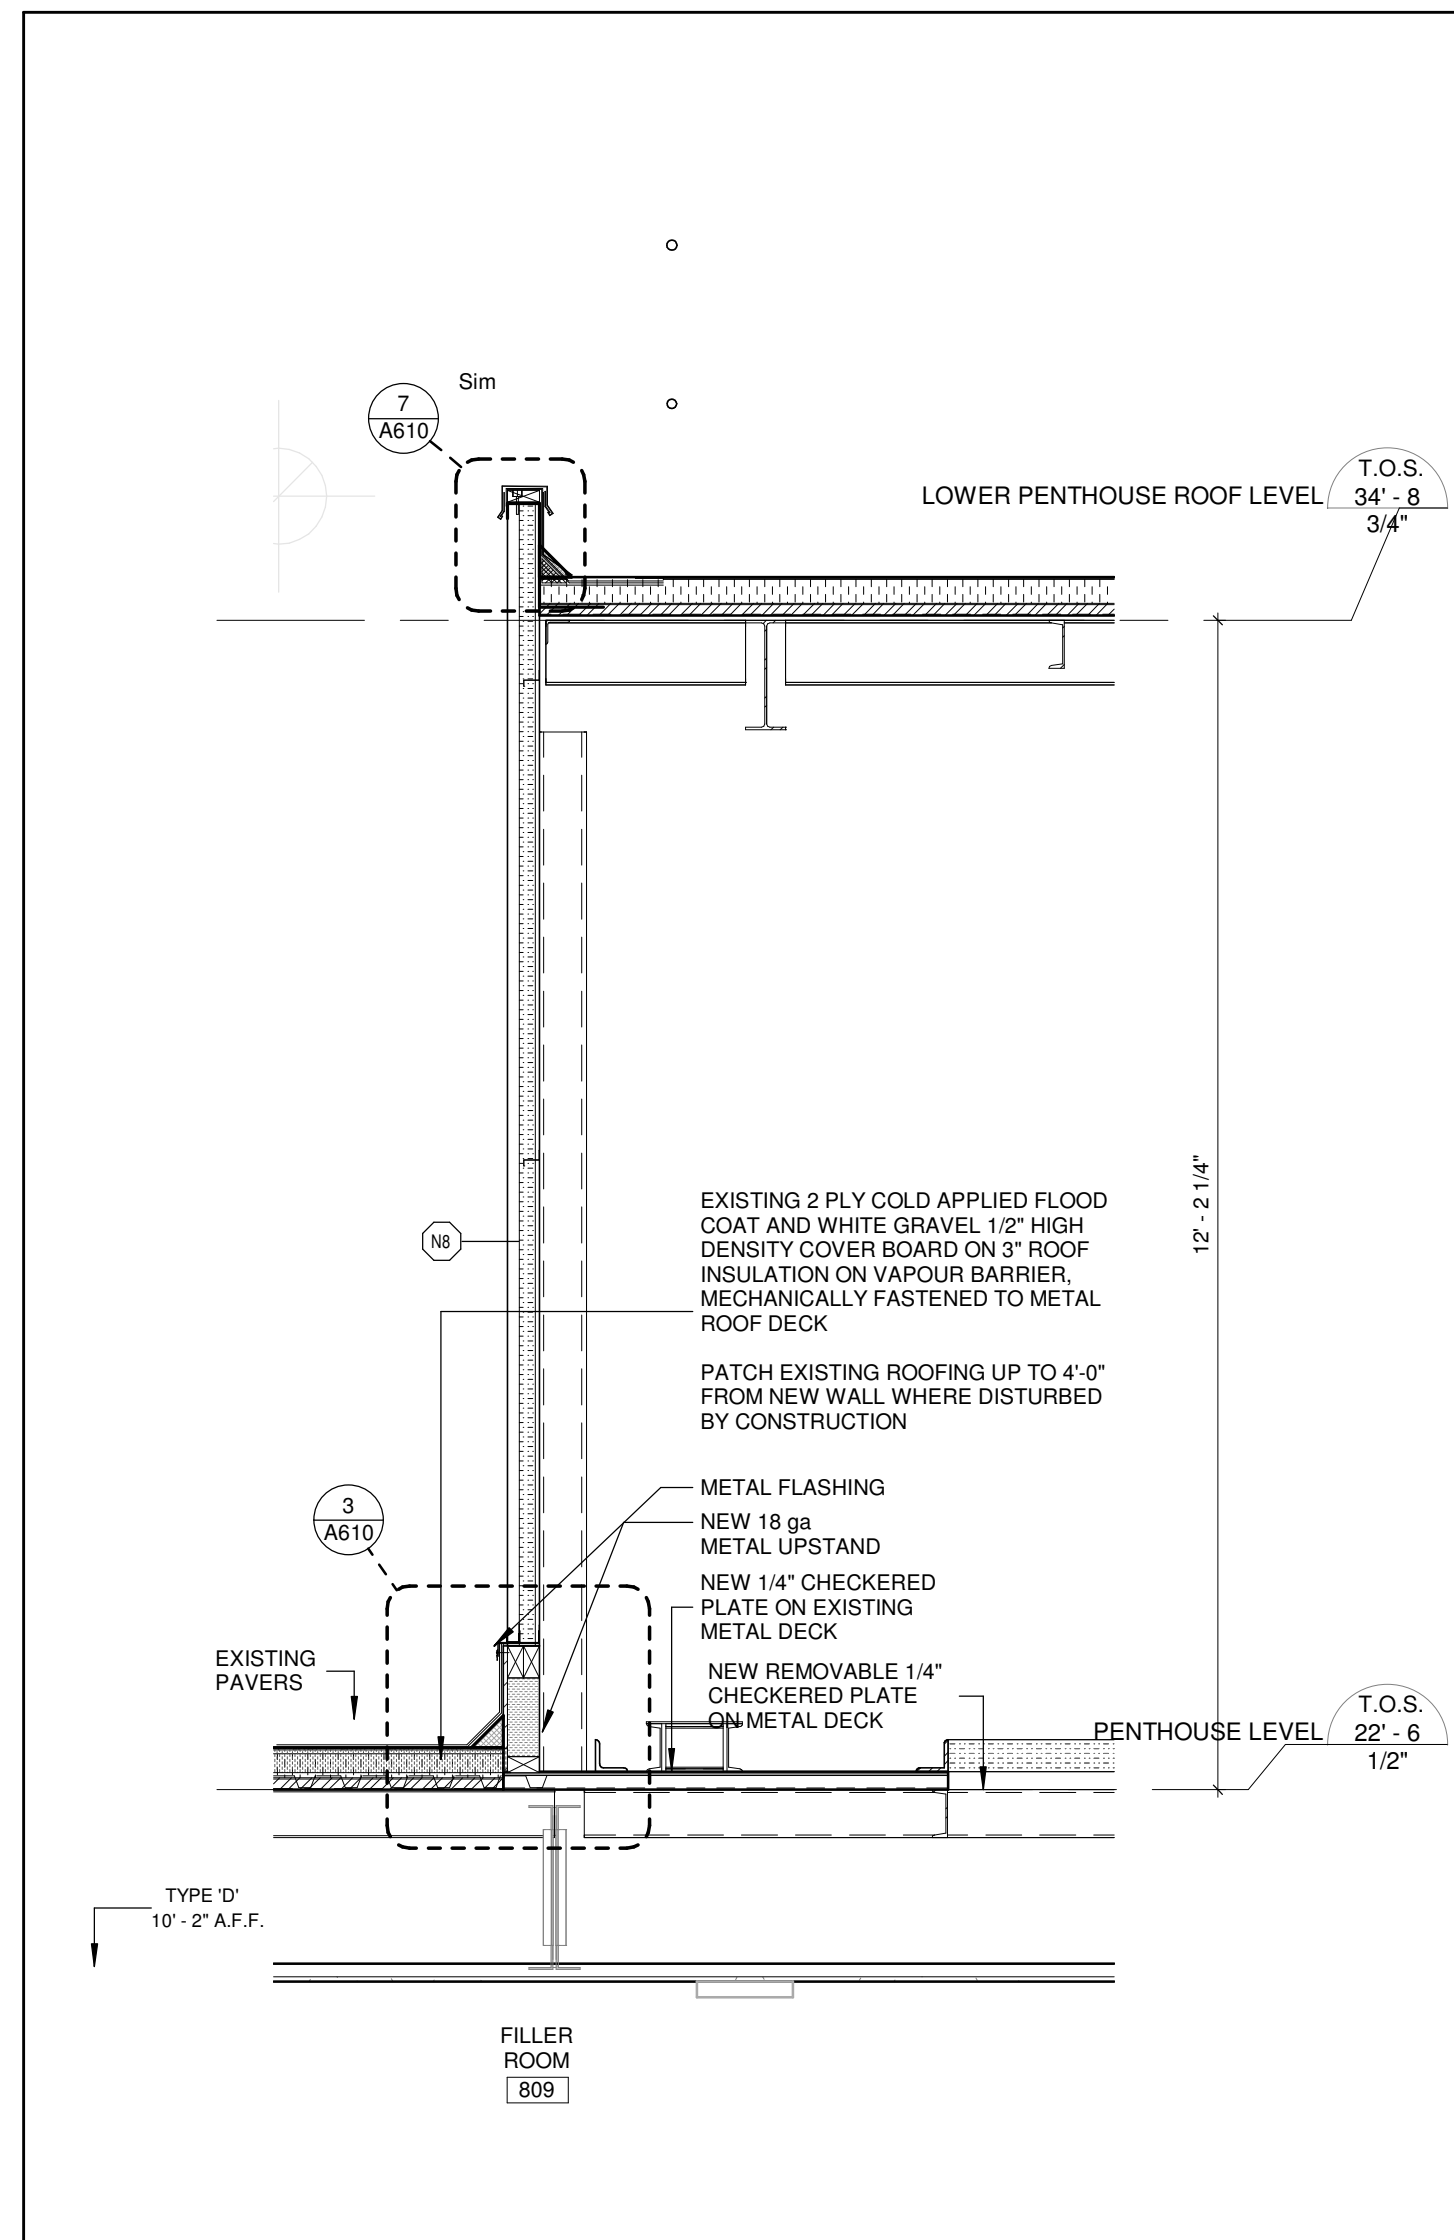


5
A505
1/2" = 1'-0"

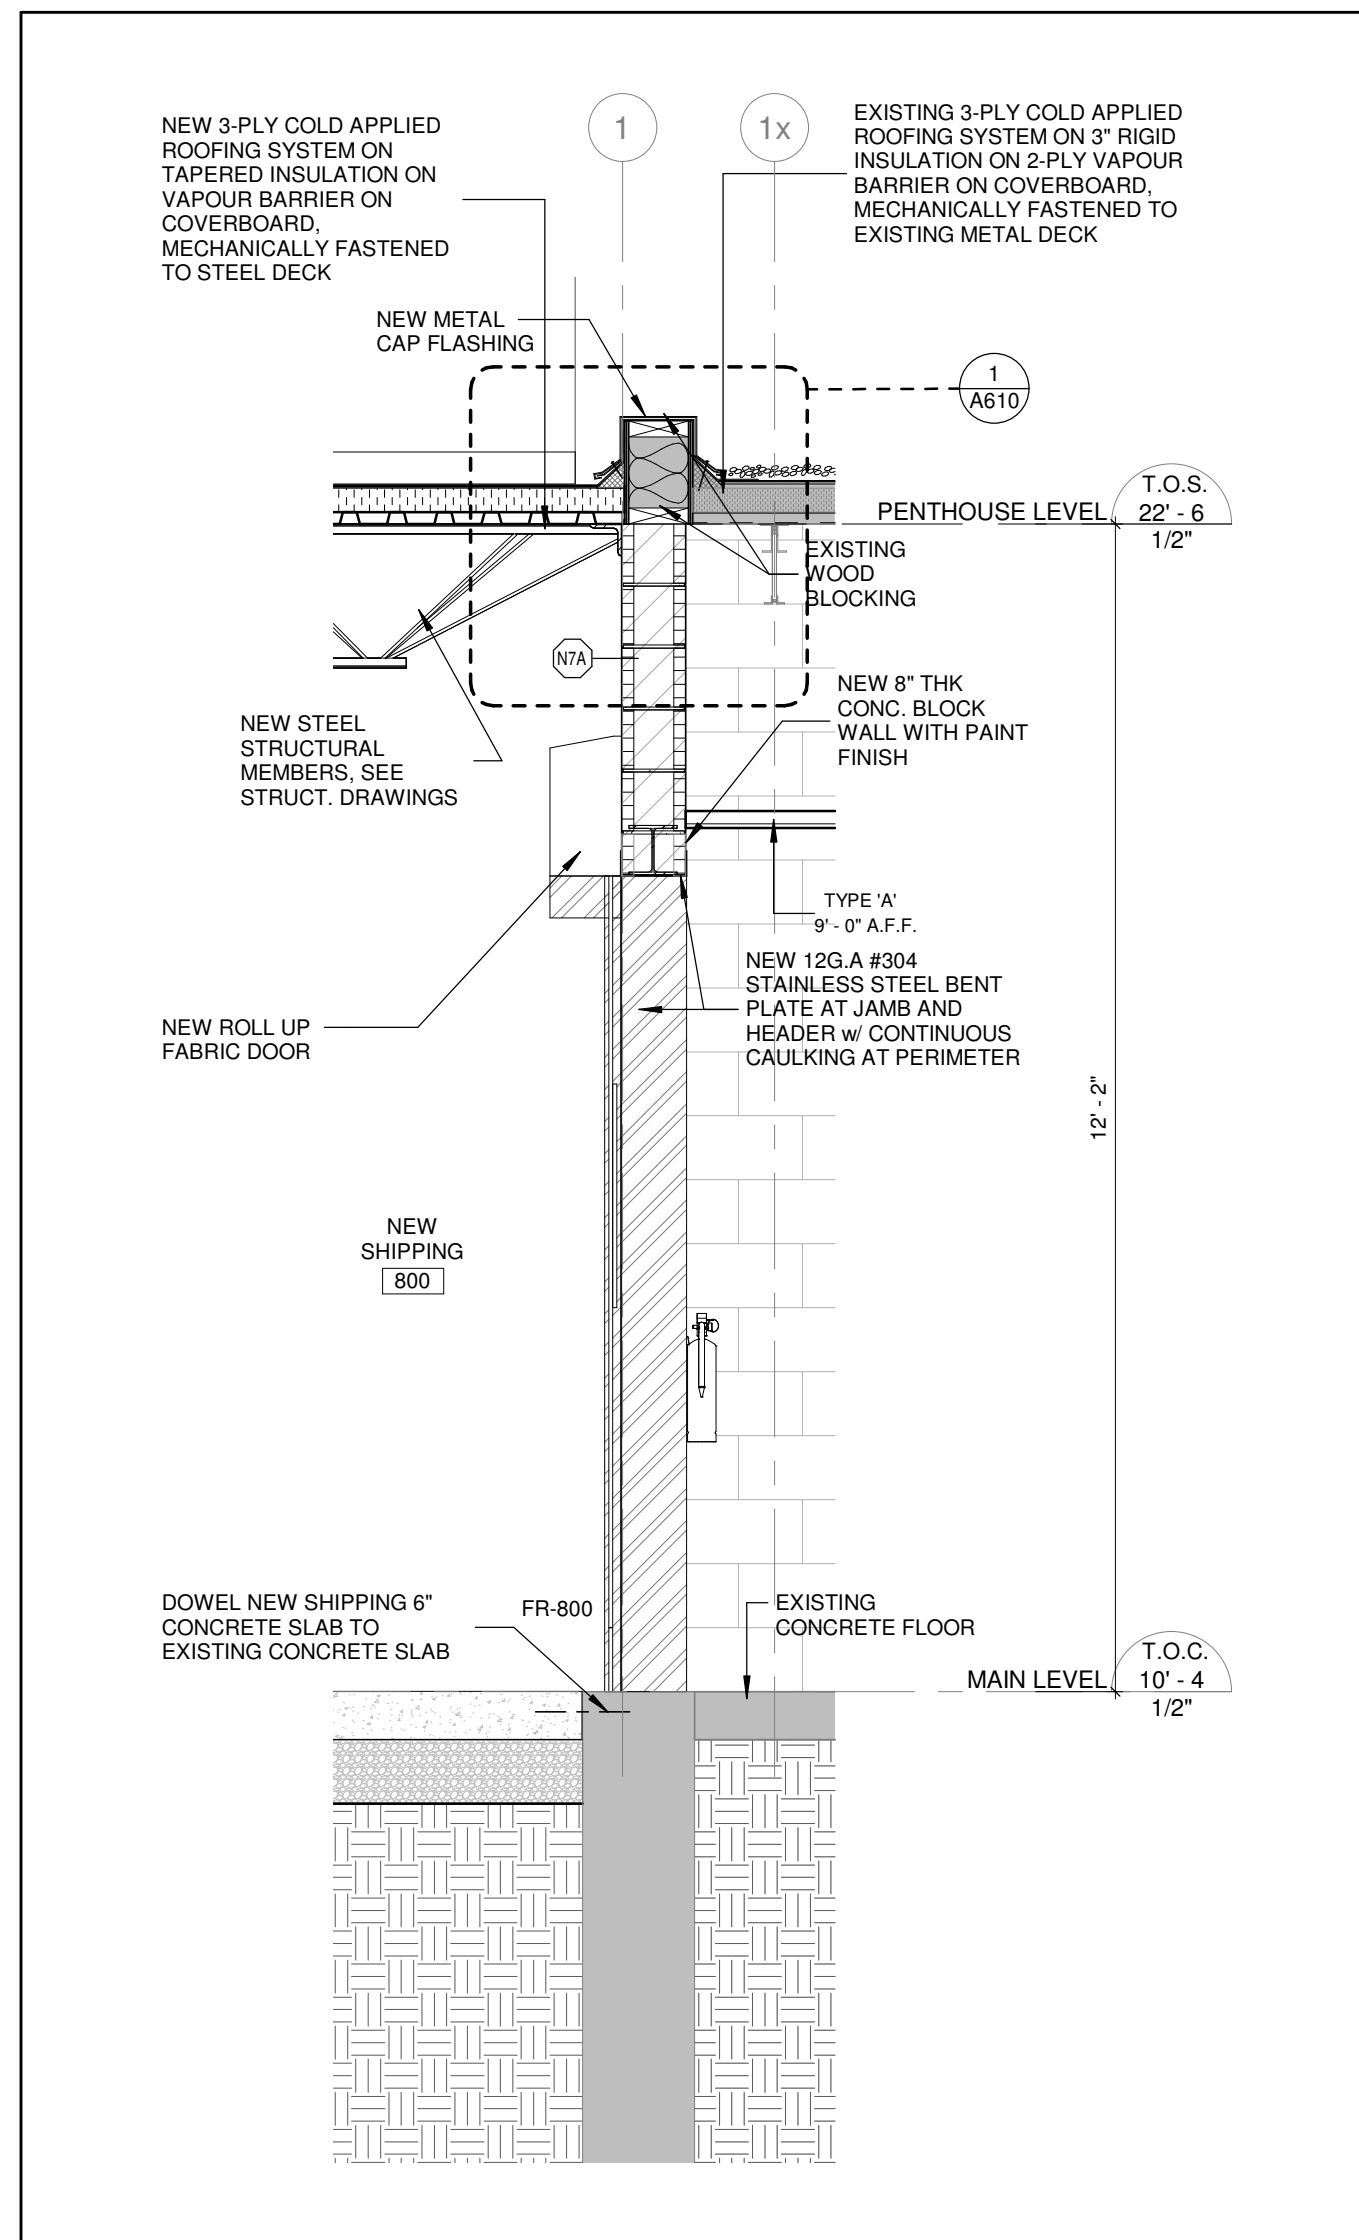


4
A505
1/2" = 1'-0"

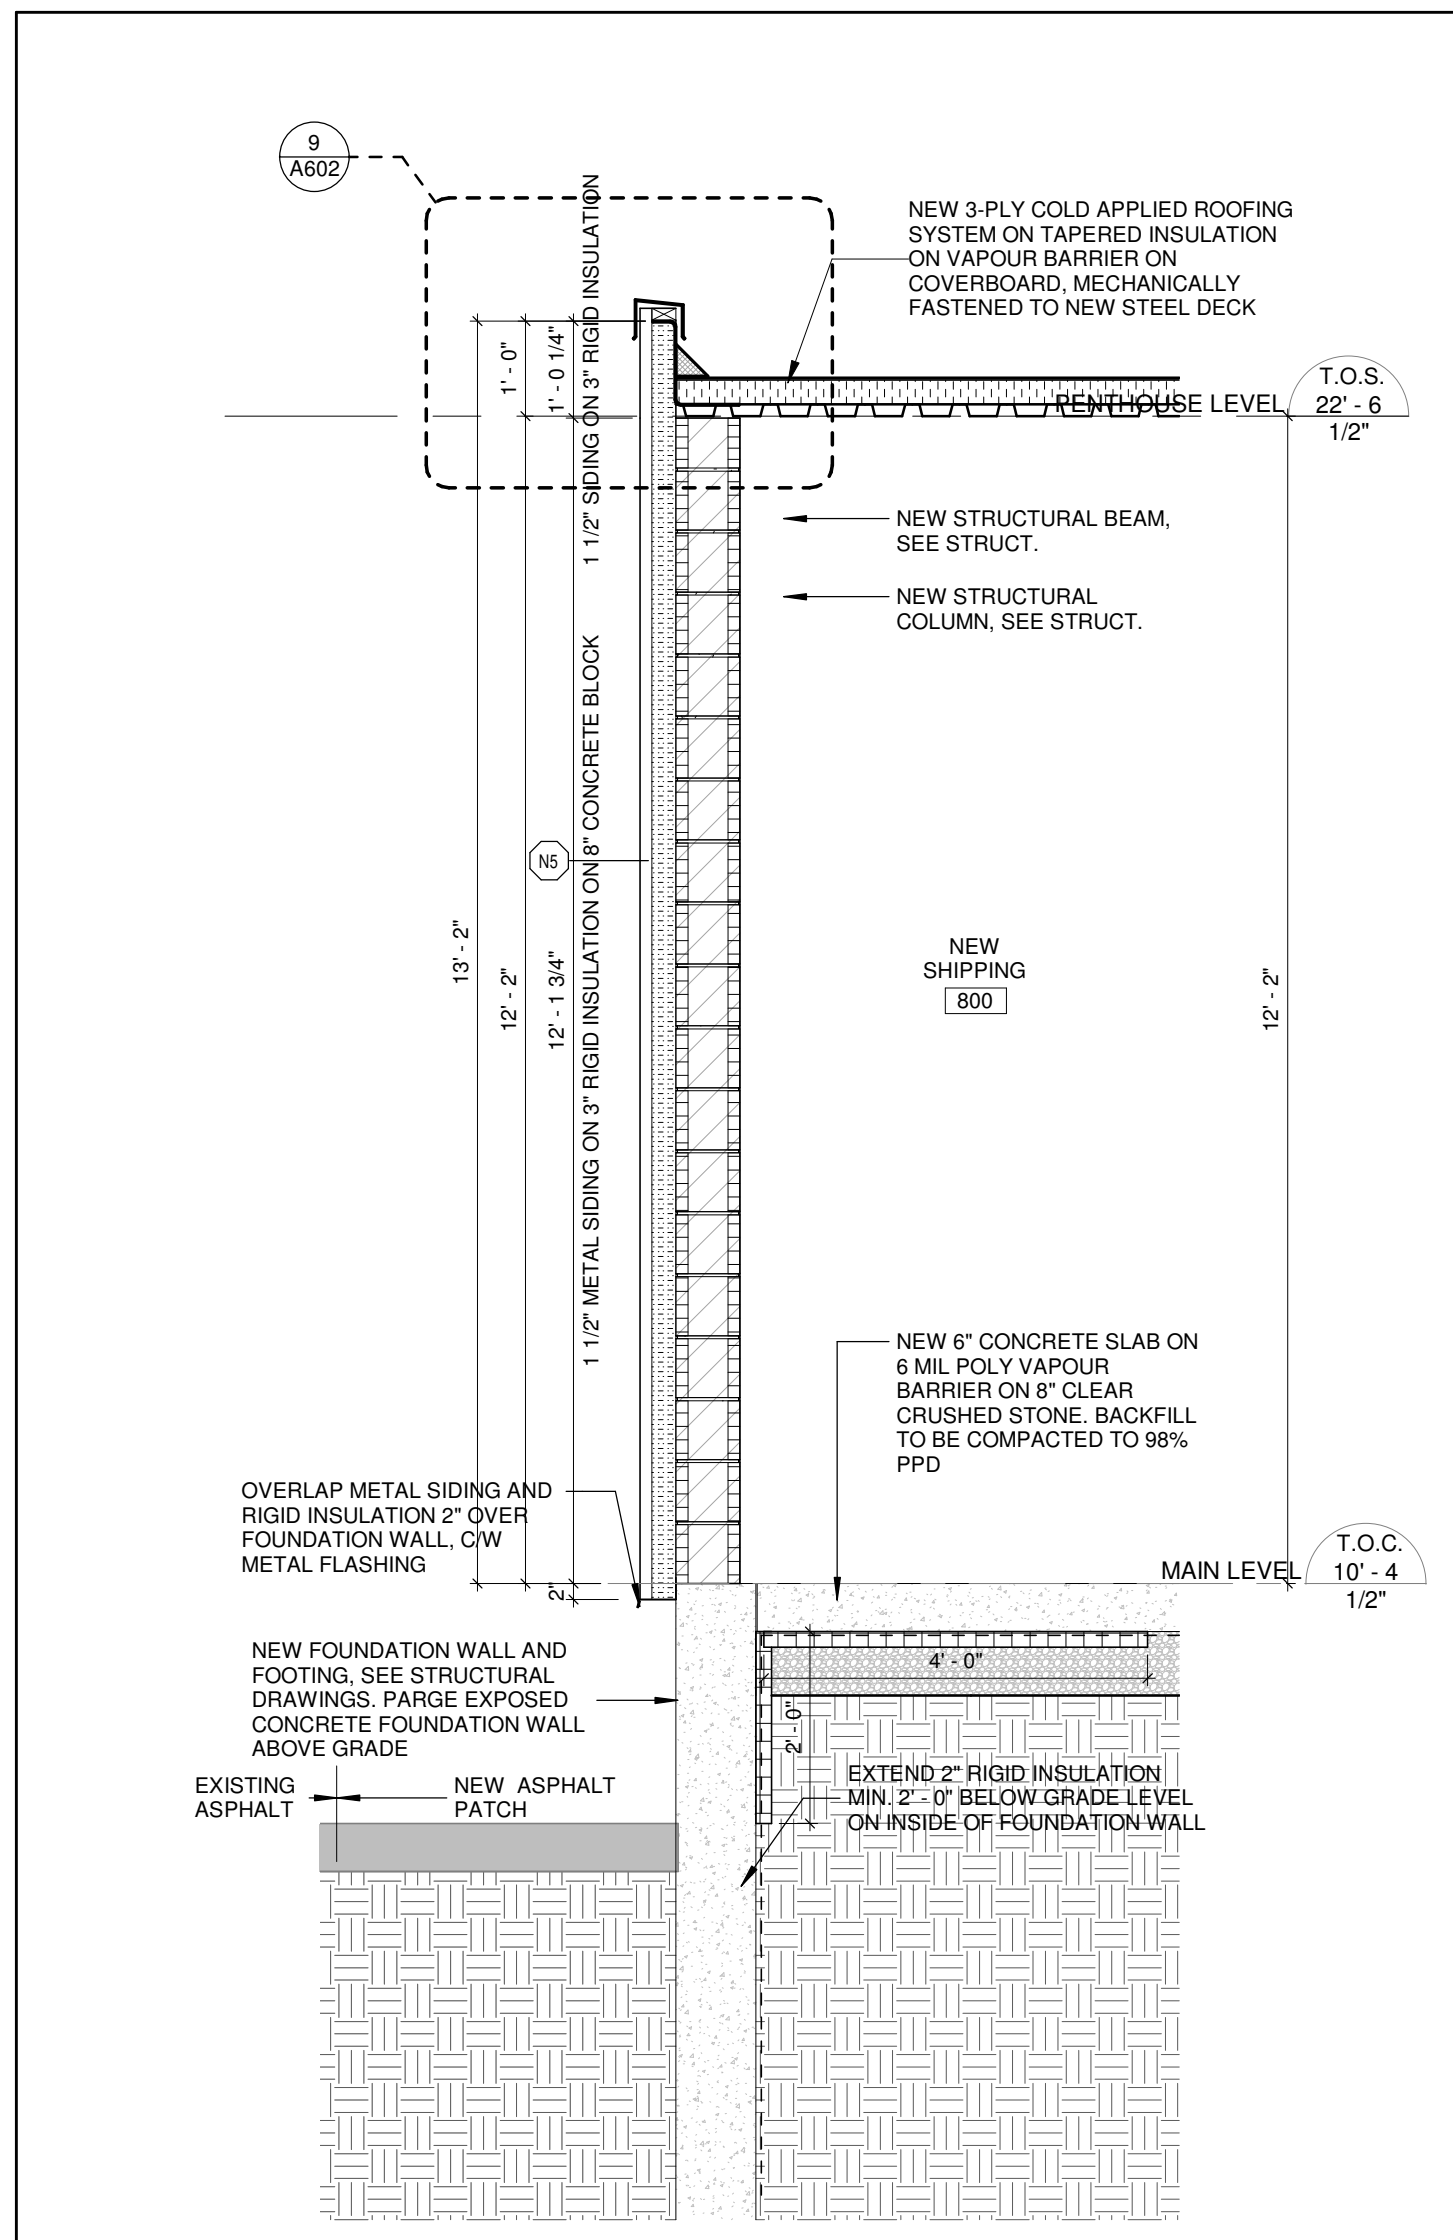

3
A505
1/2" = 1'-0"

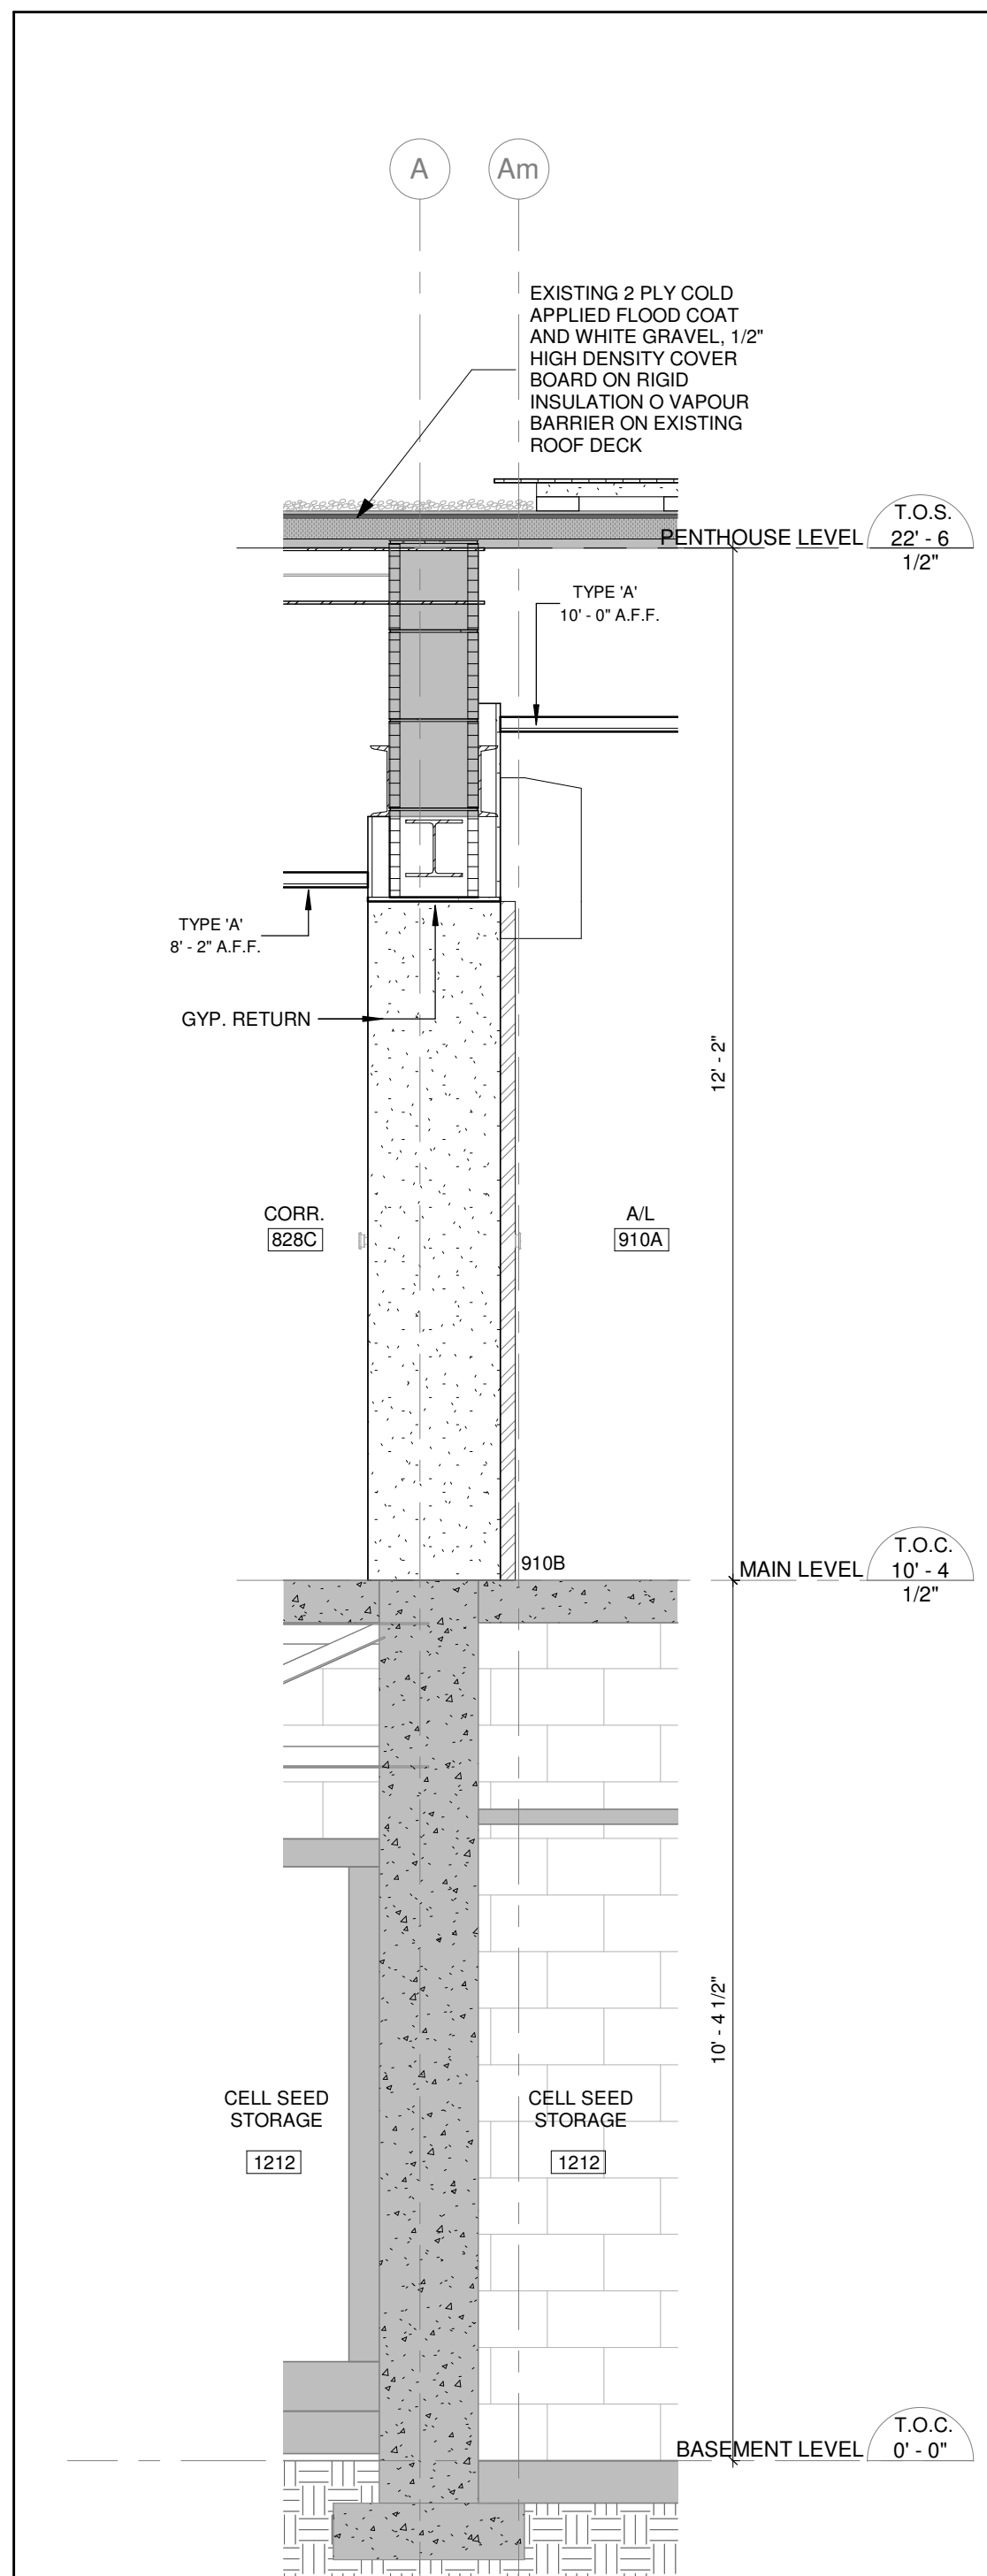


2
A505
1/2" = 1'-0"

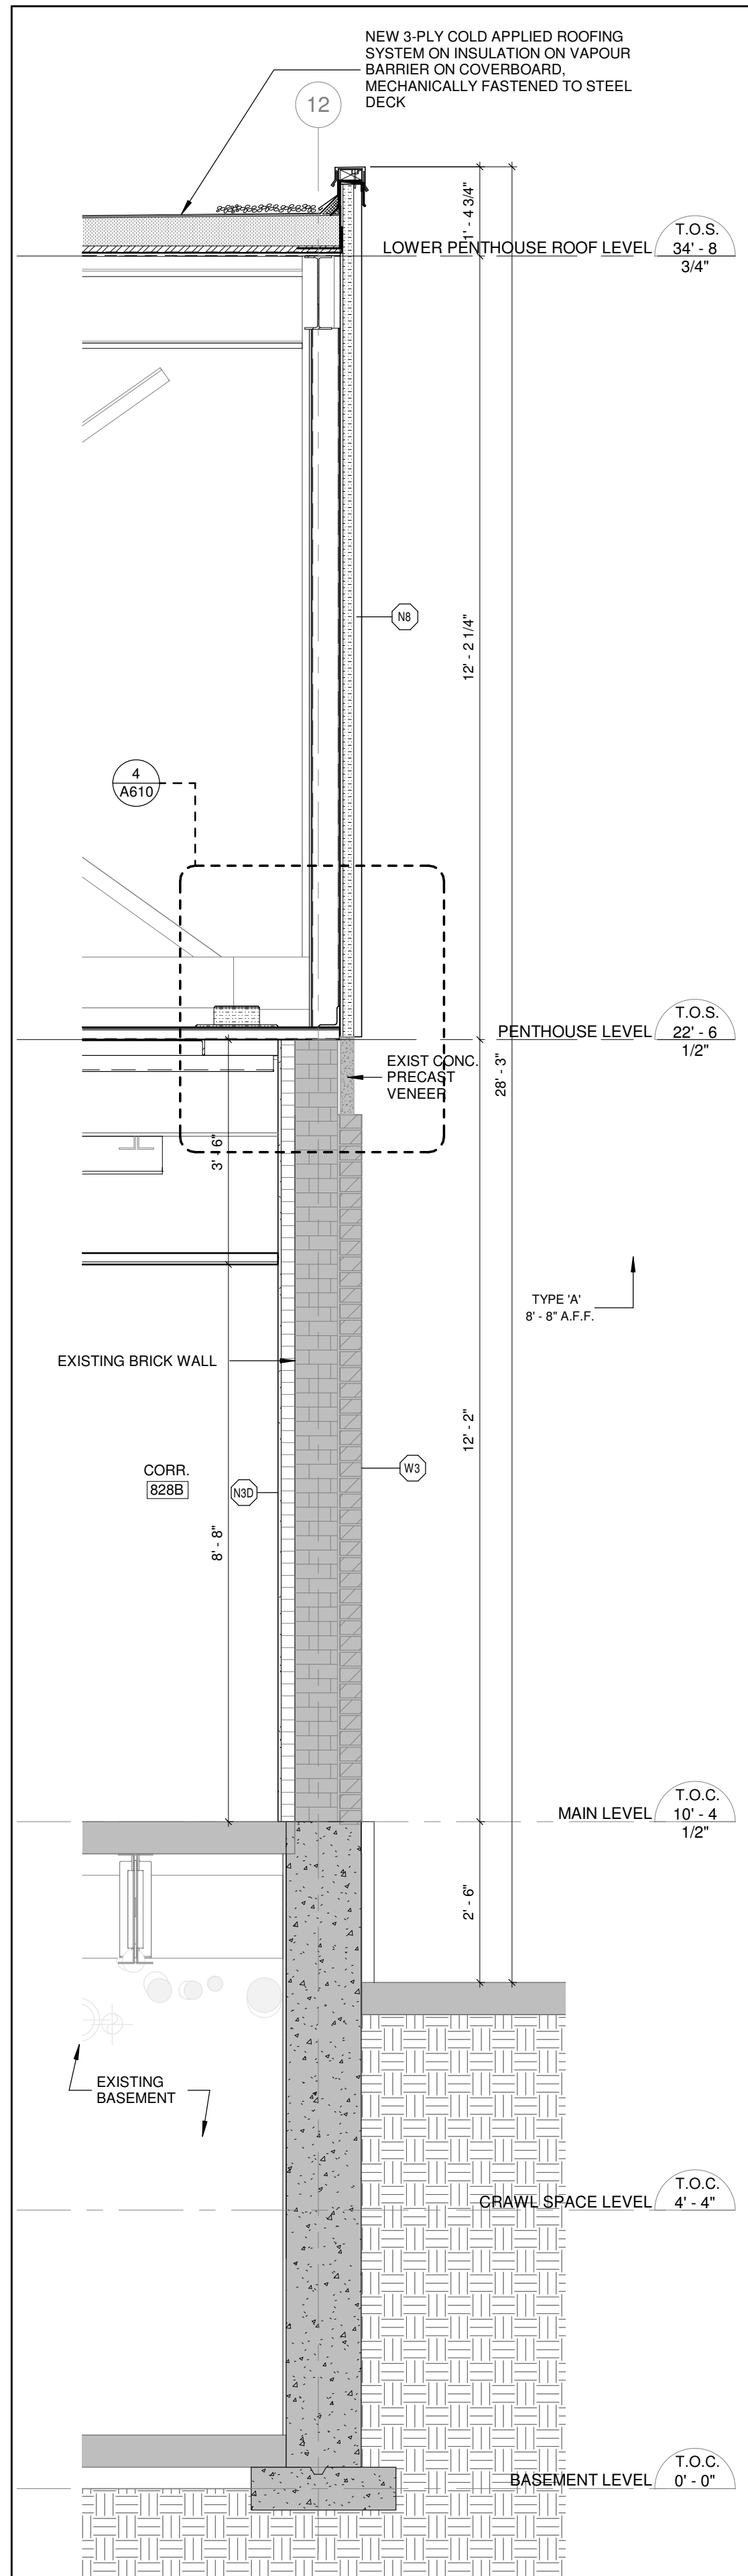

1
A505
1/2" = 1'-0"

- EXIST. WALL LEGEND:**
- (W1) EXISTING CONCRETE BLOCK
 - (W1A) EXISTING CONCRETE BLOCK 6" THK
 - (W1B) EXISTING CONCRETE BLOCK 10" THK
 - (W1C) EXISTING CONCRETE BLOCK 8" THK
 - (W2) EXISTING GYP. BRD. ON BOTH SIDES OF METAL STUDS
 - (W2A) EXISTING GYP. BRD. ON ONE SIDE OF METAL STUDS
 - (W3) EXISTING 3 COURSE LOAD BEARING BRICK MASONRY WALL WITH 1/2" AIR SPACE IN BETWEEN
 - (W4) INSULATED METAL SIDING
 - (W5) INSULATED METAL SIDING ON AIR SPACE ON 6" METAL STUD FILLED WITH BATT INSULATION ON SHEATHING
 - (W6) EXIST FACE BRICK ON 3/4" AIR SPACE ON 8" CONCRETE MASONRY BLOCK WALL
 - (W7) EXIST STUCCO ON RIGID INSULATION ON FACE BRICK ON 3/4" AIR SPACE ON 8" CONCRETE MASONRY BLOCK WALL
 - (W8) EXIST CONCRETE WALL
 - (W9) EXIST GYPSUM BOARD
 - (W10) EXIST INFILL
 - EXIST BRICK ON GYPSUM INSULATED WALL PANEL

- NEW WALL LEGEND:**
- (N1) 4" THK. INSULATED PRE-FIN. COOLER PANELS
 - (N2) 5/8" MOLD TOUGH GYPSUM BRD. ON BOTH SIDES OF 3/8" METAL STUDS TO 4" ABOVE FIN. CLNG. C.W. EPOXY BASE
 - (N2A) 5/8" MOLD TOUGH GYPSUM BRD. ON BOTH SIDES OF 8" METAL STUDS TO 4" ABOVE FIN. CLNG. C.W. EPOXY BASE
 - (N3) 5/8" MOLD TOUGH GYPSUM BRD. ON ONE SIDE OF 3/8" METAL STUDS TO 4" ABOVE FIN. CLNG. C.W. EPOXY BASE
 - (N3A) 5/8" MOLD TOUGH GYPSUM BRD. ON ONE SIDE OF 3/8" FURRING TO 4" ABOVE FIN. CLNG. C.W. EPOXY BASE
 - (N3B) 5/8" MOLD TOUGH GYPSUM BRD. ON ONE SIDE OF 3/8" FURRING TO 4" ABOVE FIN. CLNG. C.W. EPOXY BASE
 - (N3C) 5/8" MOLD TOUGH GYPSUM BRD. WHERE REQUIRED
 - (N3D) 5/8" MOLD TOUGH GYPSUM BRD. ON ONE SIDE OF 2 1/2" METAL STUDS 18 GAUGE AT 16" O.C. FILLED WITH CLOSED CELL SPRAY FOAM INSULATION BY CYCENE OR HEATLOW 507A HR. (R-14 UP TO US OF STRUCTURE ABOVE (12'-2" HT.))
 - (N4) 5/8" MOLD TOUGH GYPSUM BRD. ON BOTH SIDES OF 3/8" METAL STUDS. WALL TO EXTEND TO US OF STRUCTURE ABOVE (12'-2" HT.)
 - (N5) 1 1/2" PRE-FIN. METAL SIDING ON 3" RIGID INSULATION ON 8" CONCRETE BLOCK UP TO 10'-0" A.F.F. AND 1 1/2" PRE-FIN. METAL SIDING ON 3" RIGID INSULATION FROM 10'-0" A.F.F. TO 13'-4" A.F.F.
 - (N6) STUCCO FINISH ON BASE COAT ON FIBRE MESH ON 2" INSULATION (R-10) ON CURBOK AIRMOISTURE BARRIER ON 5/8" DENS GLASS GYD ON 8" METAL STUDS 18 GAUGE AT 16" O.C. BATT INSUL. (R-20) 8 MIL VAPOUR BARRIER AND 5/8" INTERIOR GYPSUM BOARD
 - (N7) CONCRETE BLOCK INFILL
 - (N7A) 8" THK CONC. MASONRY BLOCK WALL
 - (N7B) NEW FACE BRICK TO MATCH EXISTING ON 1/2" AIR GAP ON 8" THK CONC. MASONRY BLOCK WALL
 - (N8) 4" INSULATED CORRUGATED METAL SIDING TO MATCH EXISTING COLOR AND PROFILE FASTENED TO NEW METAL FRAMING MEMBERS. SEE STRUCT.

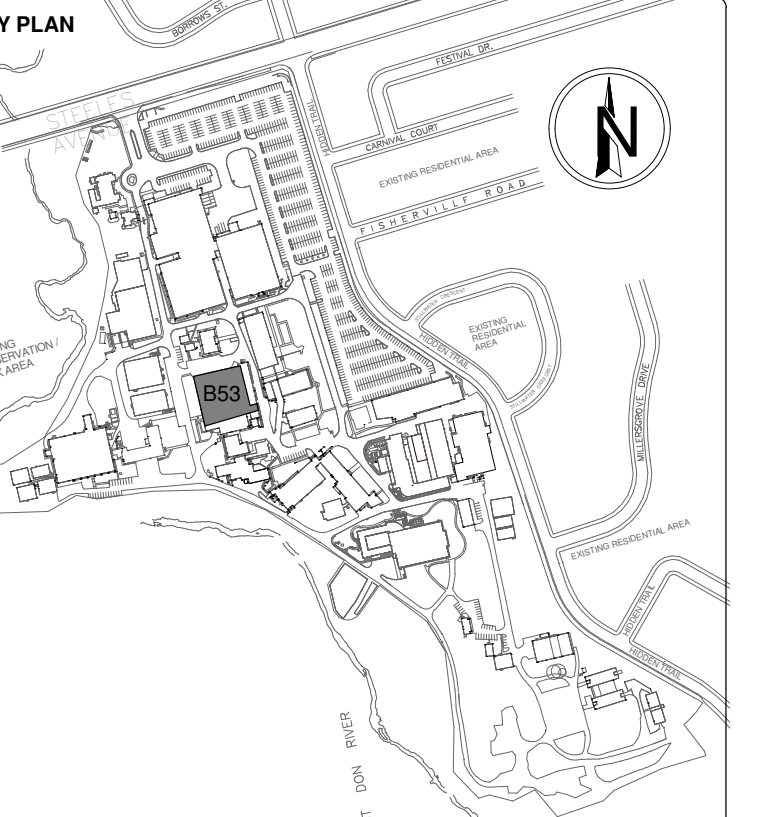

INTERNAL USE

Current Designer:
Version Description:
Version Date:
Approval Date:
Change Control Numbers:

DOCUMENT PERMISSIONS

Approval Date:
Approval Date:
Approval Date:

PROJECT

sanofi pasteur
SANOFI - B53 FORMULATION, FILLING, INSPECTION & PACKAGING (FFIP)
1755 STEELES AVE. W., NORTH YORK, ONTARIO M2R1T4
2210501

PRIME CONSULTANT



Cheme
3 - 530 Rowntree Dairy Road
Vaughan, Ontario L4L 8H2
Tel: 905-881-7118
Fax: 905-881-7118
Email: info@cheme.ca

CONSULTANT

wba
architects and engineers Inc.
3 - 530 Rowntree Dairy Road
Vaughan, Ontario L4L 8H2
Tel: 905-881-7118
Fax: 905-881-7118
Email: info@wba.ca

CONSULTANT

WALTERFEDY
KITCHENER OFFICE
575 Queen Street South, Suite 111, Kitchener, Ontario, N2M 1A1
T 519 576 2150 F 519 576 5489 www.walterfedy.com
Copyright © 2021 WalterFedy Inc.

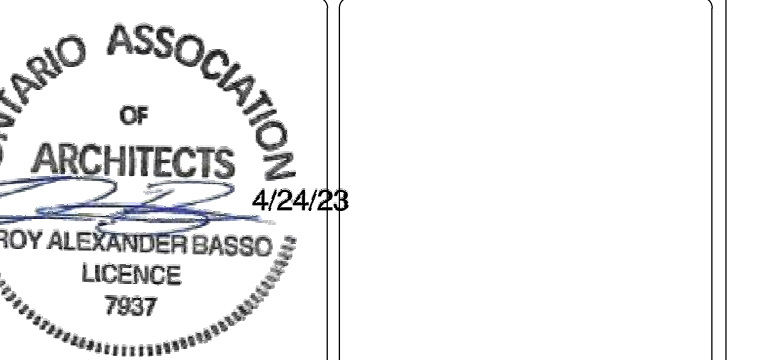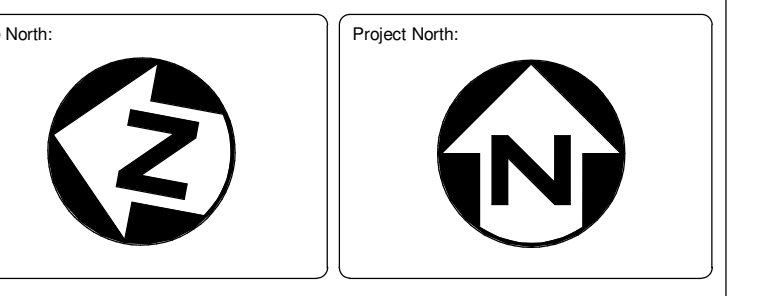

REVISION	DESCRIPTION	BY	DATE
2	ISSUED FOR AS BUILT	WBA	27MAR2024
1	ISSUED FOR CCN #165	WBA	11JUL2023
F	ISSUED FOR CONSTRUCTION	WBA	28SEP2023
F	ISSUED FOR PERMIT AND TENDER	WBA	21APR2023
E	ISSUED FOR 90% DESIGN REVIEW	WBA	17FEB2023
D	ISSUED FOR 90% INTERIM REVIEW	WBA	16NOV2022
C	ISSUED FOR FINAL BASIC DESIGN	WBA	29APR2022
B	ISSUED FOR 60% UPDATES FOR CN-09	WBA	26APR2022
A	ISSUED FOR 60% DESIGN REVIEW	WBA	01APR2022

CURRENT DRAWING

Current Designer: INSIVA KAPASI I.E. I.K.
Current Designer: ROY BASSO I.E. R.B.
Current Design Verifier: ROY BASSO I.E. R.B.

ORIGINAL DRAWING

Drawing Creation Date: I.E.
Original Design Verifier: I.E.

LOCATION

Blg Number: Blg Description:
Blg Floor: Area/Functional Use:




TITLE

WALL SECTIONS

Scale: AS NOTED Sheet Size: ANSI E

Drawing & File Name: **53P-2021-015-A505**
Layout Name: **A505**


Old Elec File: Old Sheet Name:

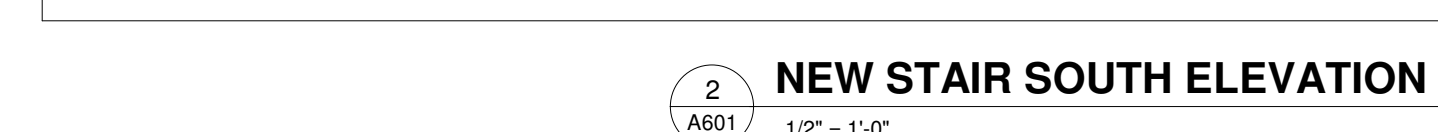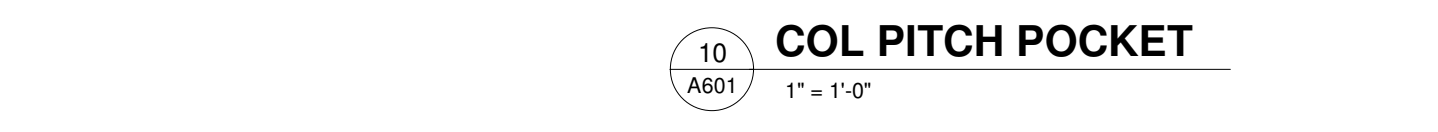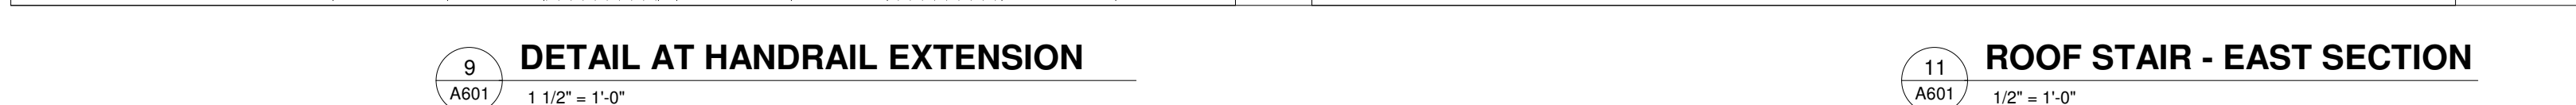


- EXIST. WALL LEGEND:**
- W1 EXISTING CONCRETE BLOCK
 - W1A EXISTING CONCRETE BLOCK 6" THK
 - W1B EXISTING CONCRETE BLOCK 10" THK
 - W1C EXISTING CONCRETE BLOCK 8" THK
 - W2 EXISTING GYP. BRD. ON BOTH SIDES OF METAL STUDS
 - W2A EXISTING GYP. BRD. ON ONE SIDE OF METAL STUDS
 - W3 EXISTING 3 COURSE LOAD BEARING BRICK MASONRY WALL WITH 1/2" AIR SPACE IN BETWEEN
 - W4 INSULATED METAL SIDING
 - W5 INSULATED METAL SIDING ON AIR SPACE ON 8" METAL STUD FILLED WITH BATT INSULATION ON SHEATHING
 - W6 EXIST FACE BRICK ON 3/4" AIR SPACE ON 8" CONCRETE MASONRY BLOCK WALL
 - W7 EXIST STUCCO ON RIGID INSULATION ON FACE BRICK ON 3/4" AIR SPACE ON 8" CONCRETE MASONRY BLOCK WALL
 - W8 EXIST CONCRETE WALL
 - W9 EXIST GYPSUM BOARD
 - W10 EXIST INFILL EXIST BRICK ON GYPSUM INSULATED WALL PANEL

- NEW LEGEND:**
- EXISTING AREA TO REMAIN
 - EXISTING AREA TO REMAIN

- NEW WALL LEGEND:**
- N1 4" THK. INSULATED PRE-FIN. COOLER PANELS.
 - N2 5/8" MOLD TOUGH GYPSUM BRD. ON BOTH SIDES OF 3/8" METAL STUDS TO 4" ABOVE FIN. CLING. C.W. EPOXY BASE
 - N2A 5/8" MOLD TOUGH GYPSUM BRD. ON BOTH SIDES OF 3/8" METAL STUDS TO 4" ABOVE FIN. CLING. C.W. EPOXY BASE
 - N3 5/8" MOLD TOUGH GYPSUM BRD. ON ONE SIDE OF 3/8" METAL STUDS TO 4" ABOVE FIN. CLING. C.W. EPOXY BASE
 - N3A 5/8" MOLD TOUGH GYPSUM BRD. ON ONE SIDE OF 3/8" METAL STUDS TO 4" ABOVE FIN. CLING. C.W. EPOXY BASE
 - N3B 5/8" MOLD TOUGH GYPSUM BRD. ON ONE SIDE OF 3/8" METAL STUDS TO 4" ABOVE FIN. CLING. C.W. EPOXY BASE
 - N3C 5/8" MOLD TOUGH GYPSUM BRD. WHERE REQUIRED
 - N3D 5/8" MOLD TOUGH GYPSUM BRD. ON ONE SIDE OF 3/8" METAL STUDS TO 4" ABOVE FIN. CLING. C.W. EPOXY BASE
 - N4 5/8" MOLD TOUGH GYPSUM BRD. ON BOTH SIDES OF 3/8" METAL STUDS. WALL TO EXTEND TO US OF STRUCTURE ABOVE (112"2" HT.)
 - N5 1 1/2" PRE-FIN. METAL SIDING ON 3" RIGID INSULATION ON 8" CONCRETE BLOCK UP TO 15' 0" A.F.F. AND 1 1/2" PRE-FIN. METAL SIDING ON 3" RIGID INSULATION FROM 10' 0" A.F.F. TO 15' 0" A.F.F.
 - N6 STUCCO FINISH ON BASE COAT ON FIBRE MESH ON 2" INSULATED BR. 10 ON DUROCK AIRMOISTURE BARRIER ON 5/8" DENS GLASS GOLD ON 1/2" METAL STUDS 18 GAUGE AT 16" o.c. 6" BATT INSUL. R-20 2 MIL VAPOUR BARRIER AND 5/8" INTERIOR GYPSUM BOARD
 - N7 CONCRETE BLOCK INFILL
 - N7A 8" THK CONC. MASONRY BLOCK WALL
 - N7B NEW FACE BRICK TO MATCH EXISTING ON 1/2" AIR GAP ON 8" THK CONC. MASONRY BLOCK WALL
 - N8 4" INSULATED CORRUGATED METAL SIDING TO MATCH EXISTING COLOR AND PROFILE FASTENED TO NEW METAL FRAMING MEMBERS. SEE STRUCT.

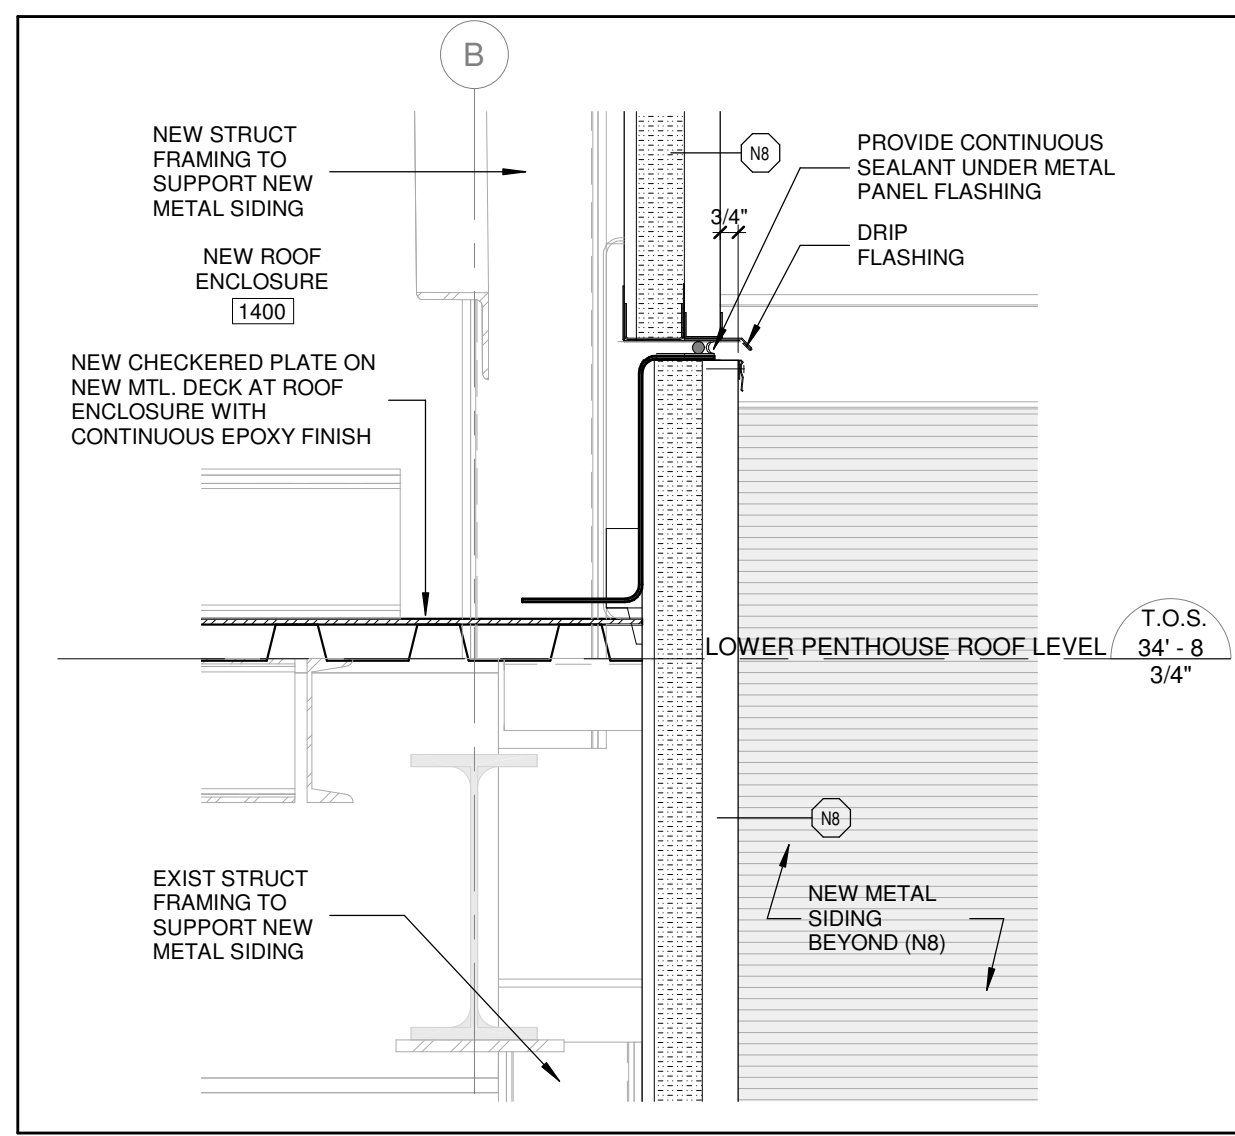


SECTION DETAIL AT OFFSET OF NEW SIDING
1 1/2" = 1'-0"

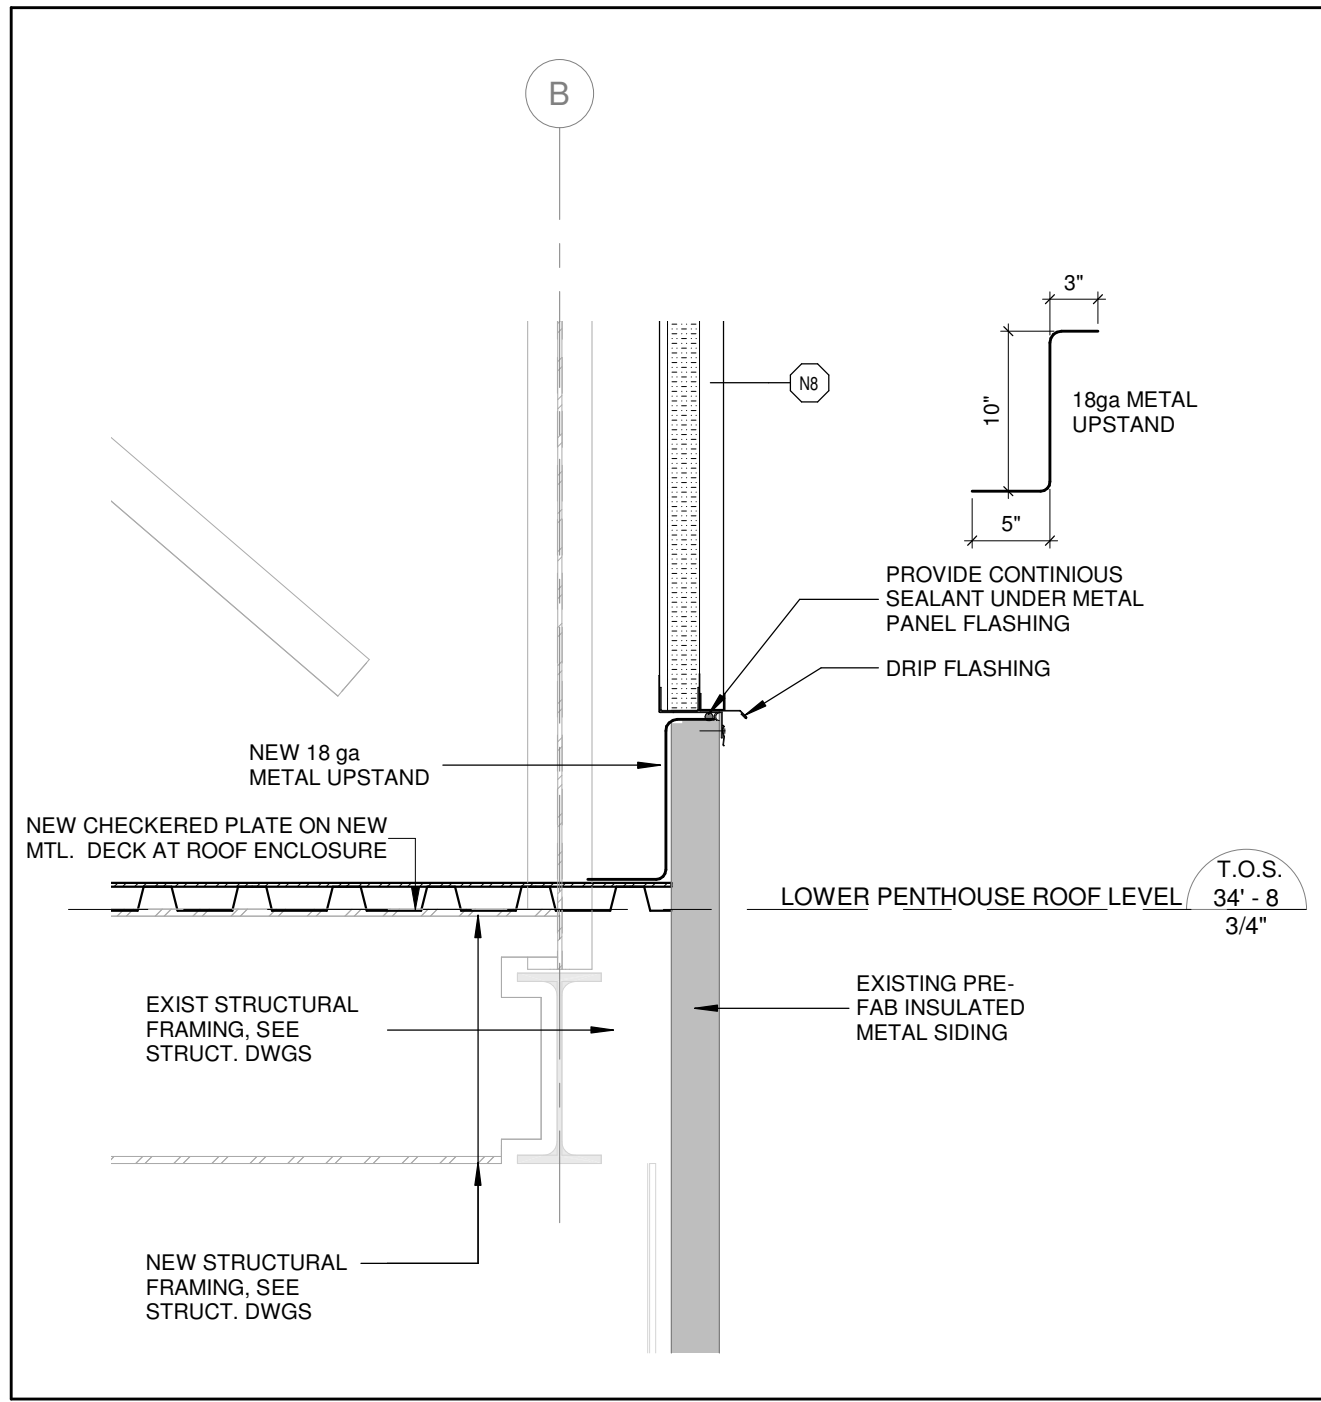


SECTION DETAIL @ EXISTING SIDING @ ROOF ENCLOSURE - NEW
1" = 1'-0"

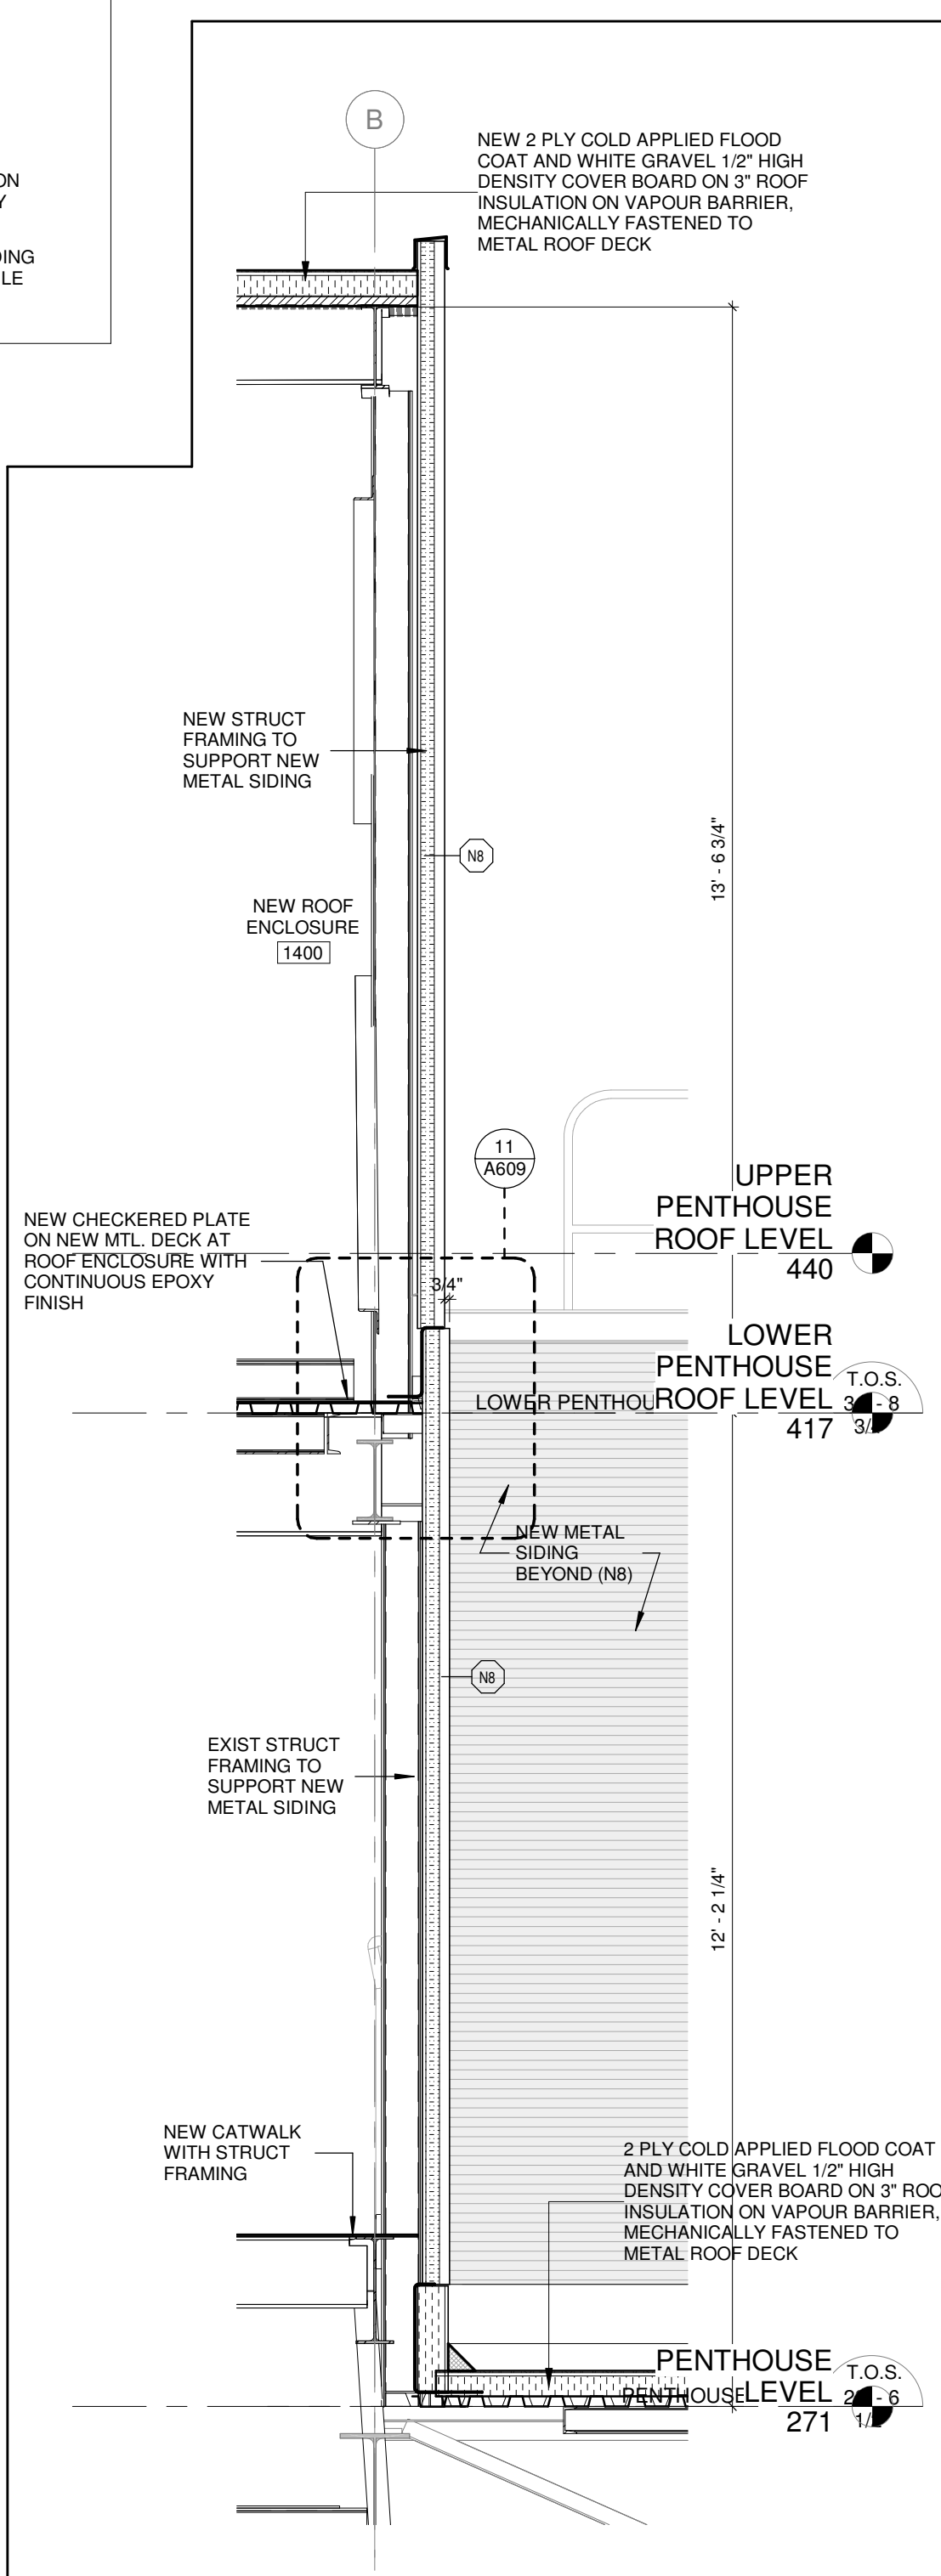


WALL SECTION AT NEW SIDING AT PENTHOUSE AND ROOF ENCLOSURE
1/2" = 1'-0"

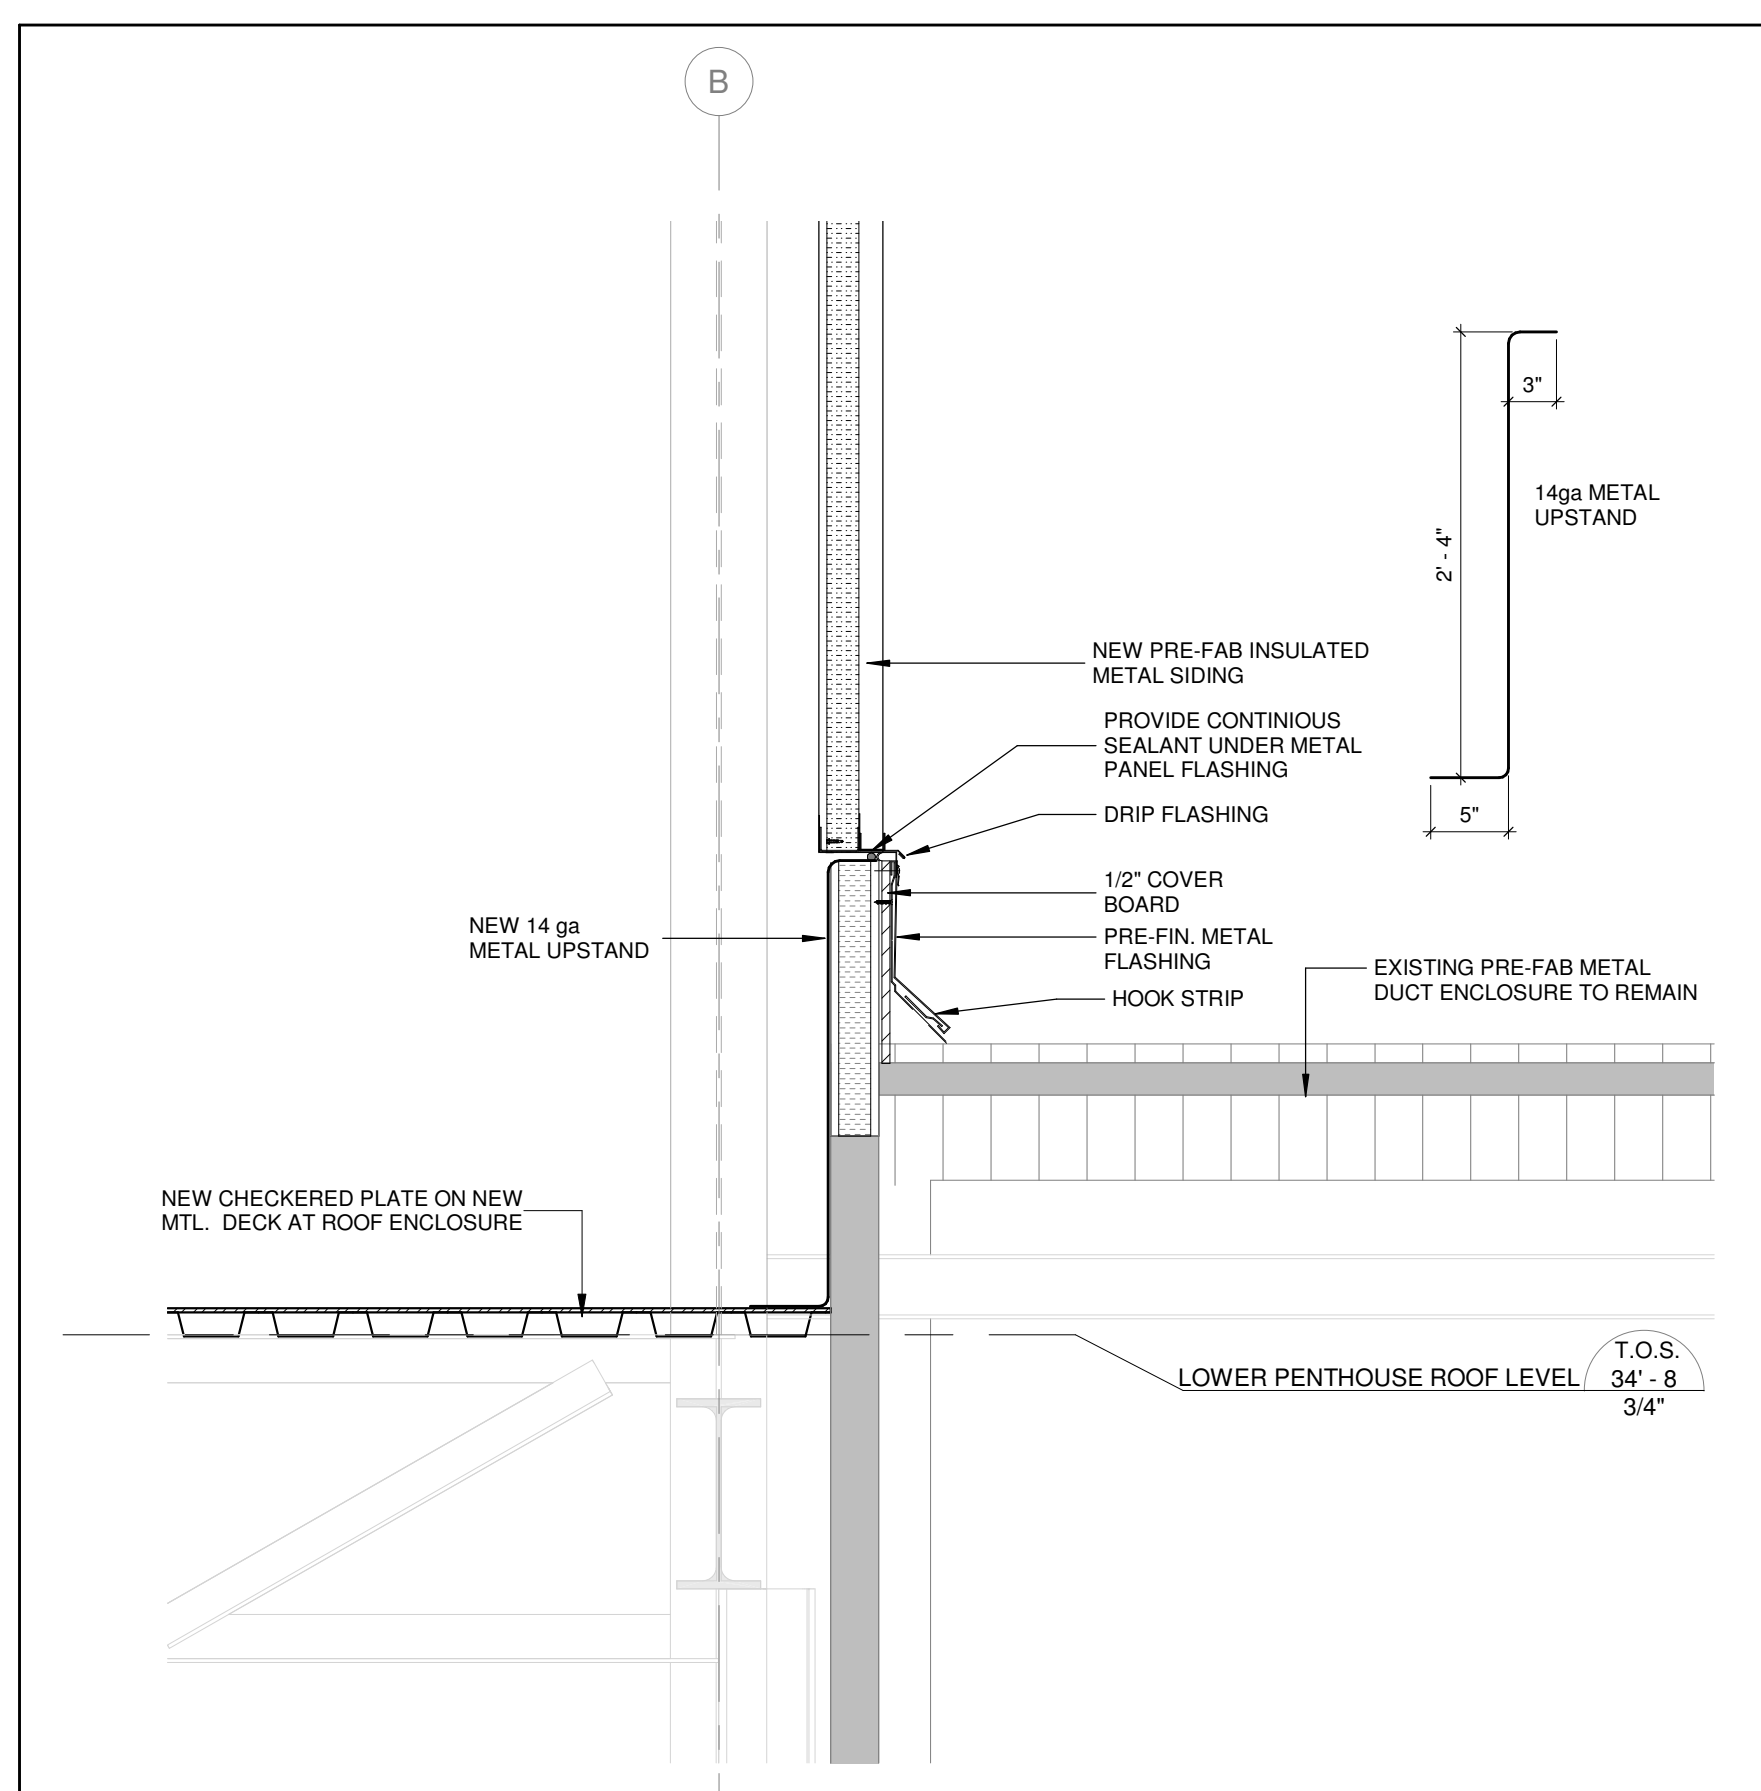


SECTION DETAIL @ CATWALK ROOF @ ROOF ENCLOSURE - NEW
1" = 1'-0"

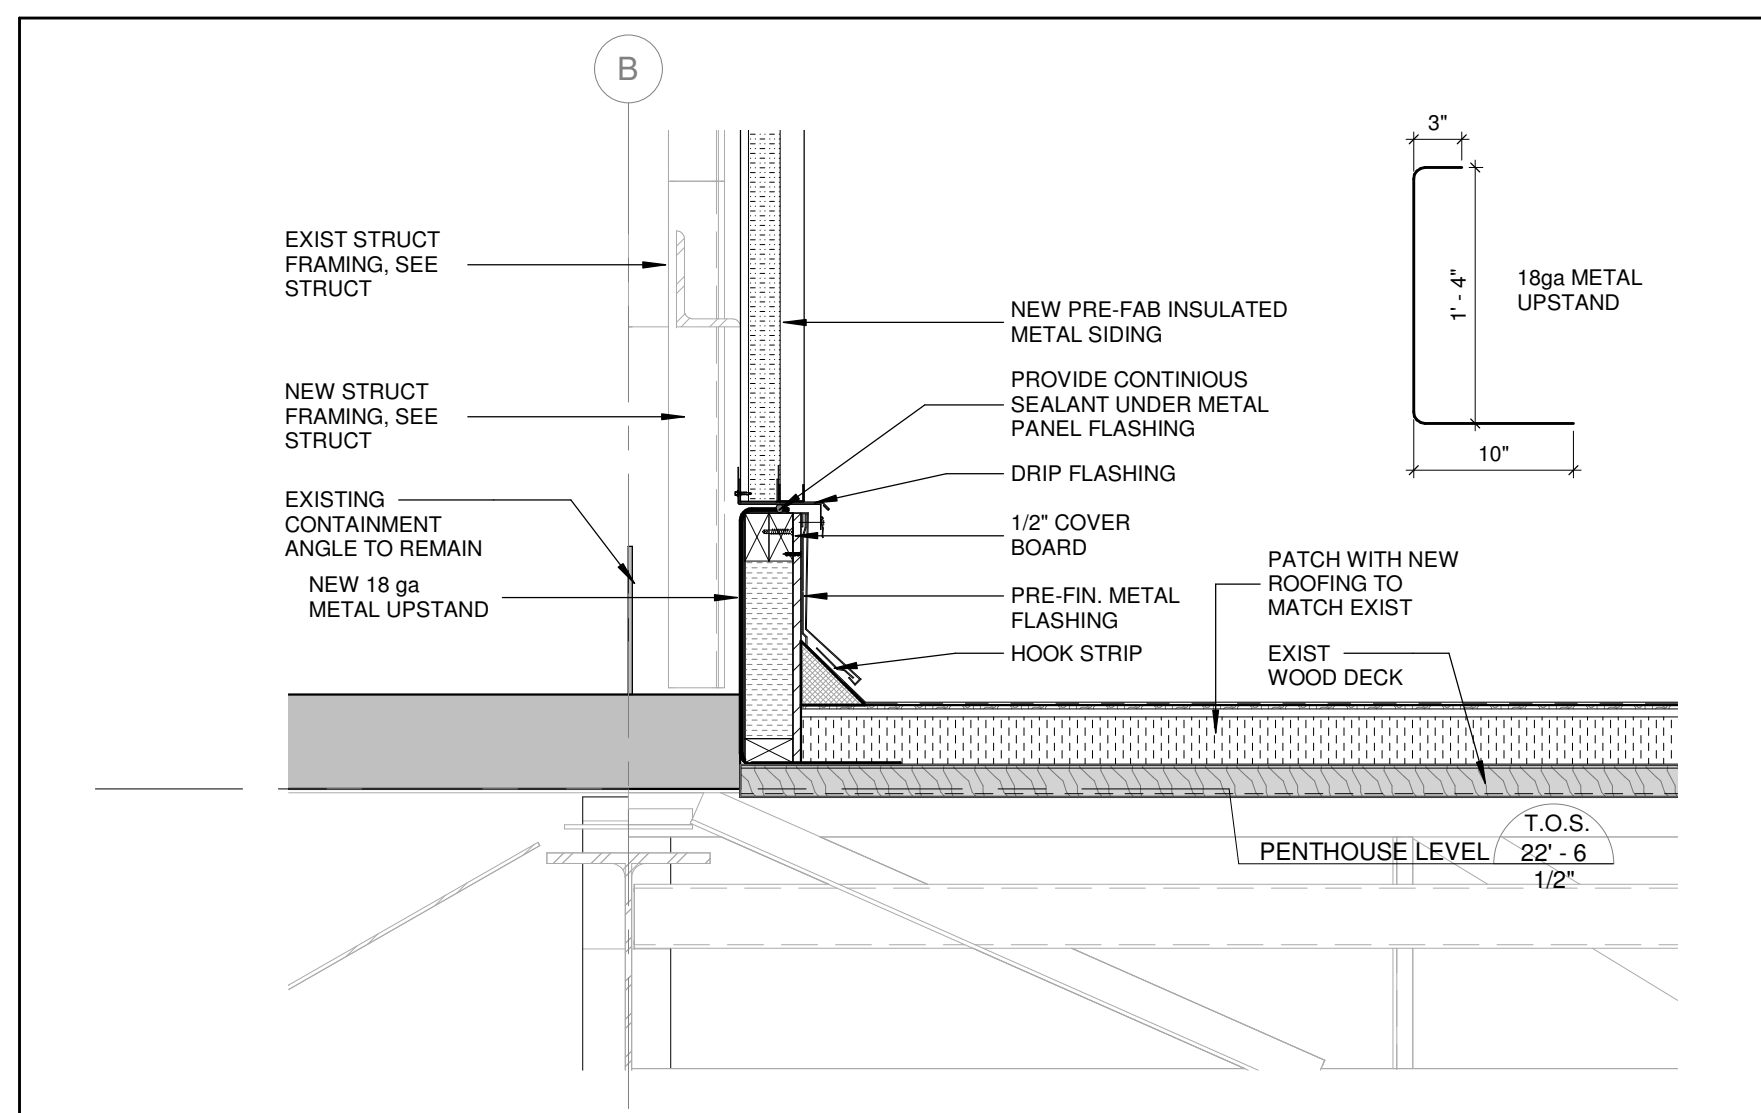


SECTION DETAIL @ WALL BASE @ ROOF ENCLOSURE - NEW
1" = 1'-0"

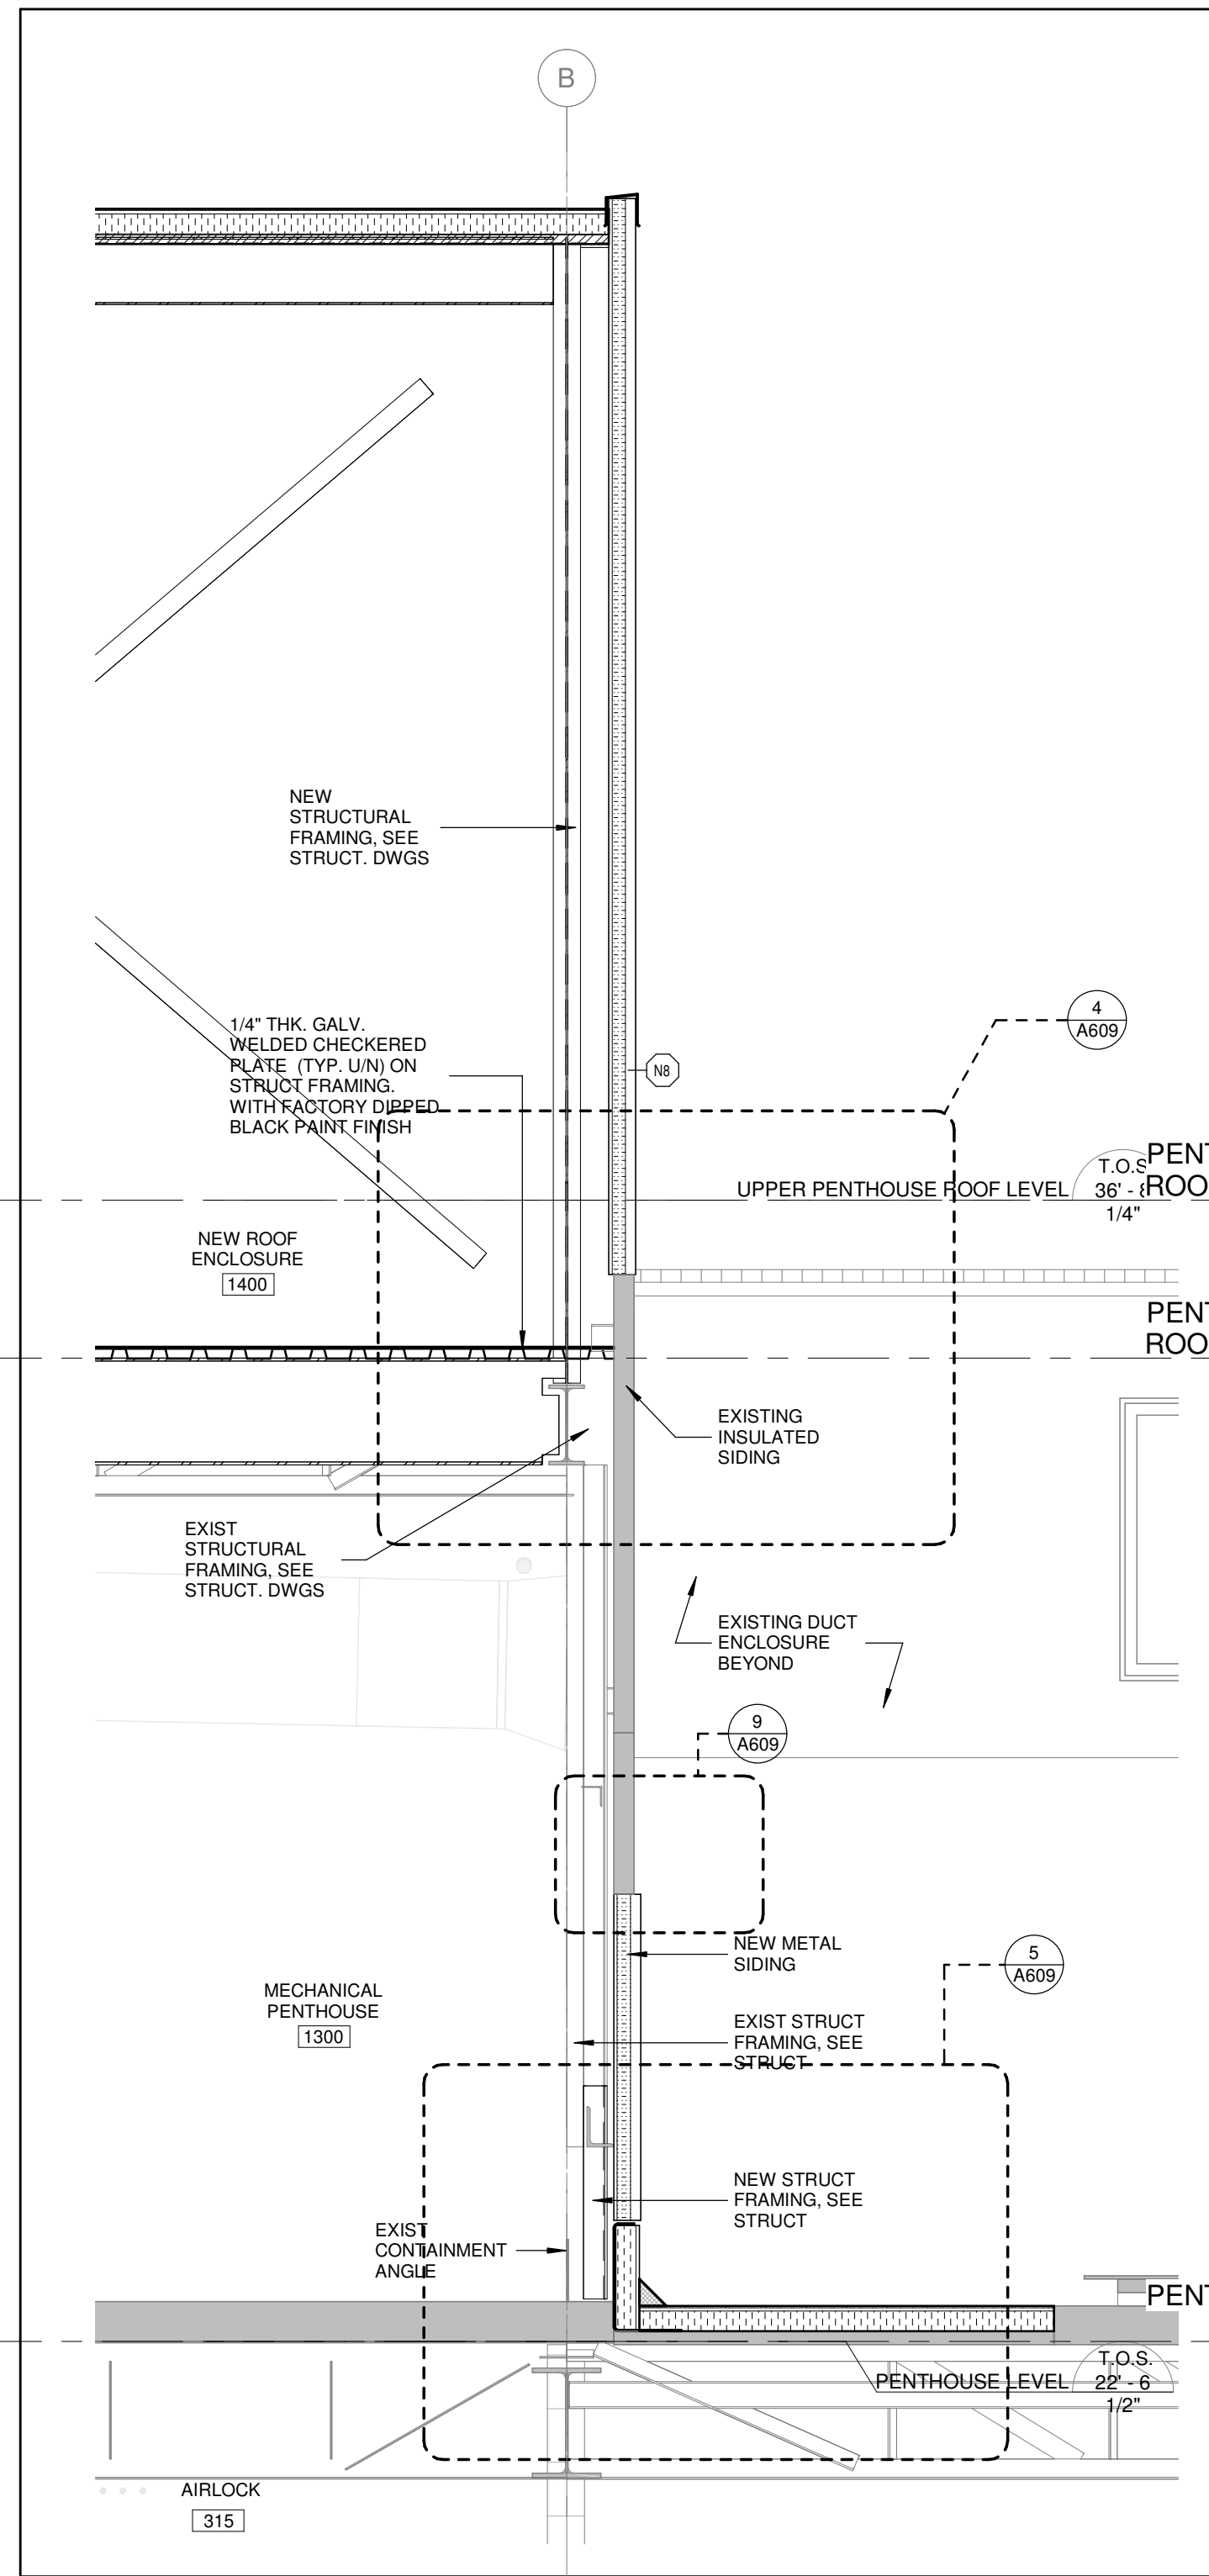


WALL SECT. @ NEW ROOF ENCLOSURE WEST WALL & EXIST SIDING - NEW
1/2" = 1'-0"

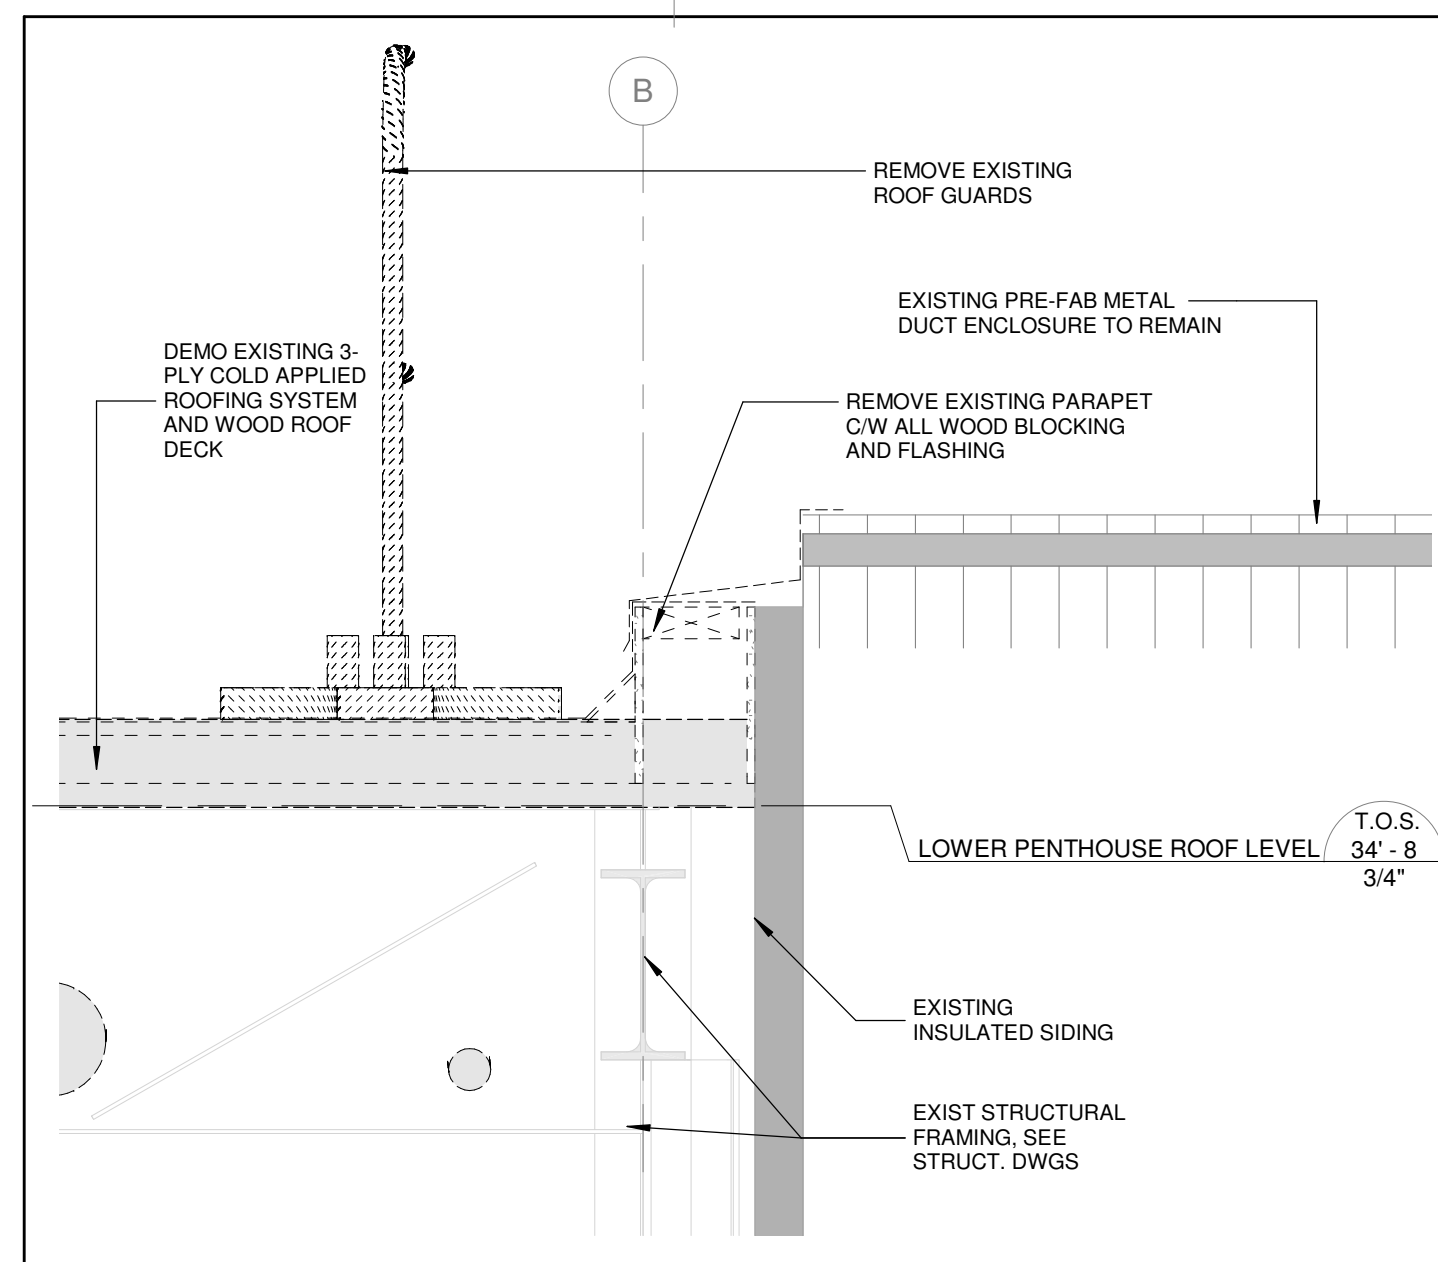


SECT. DETAIL @ PARAPET @ EXIST. WALL - DEMO
1" = 1'-0"

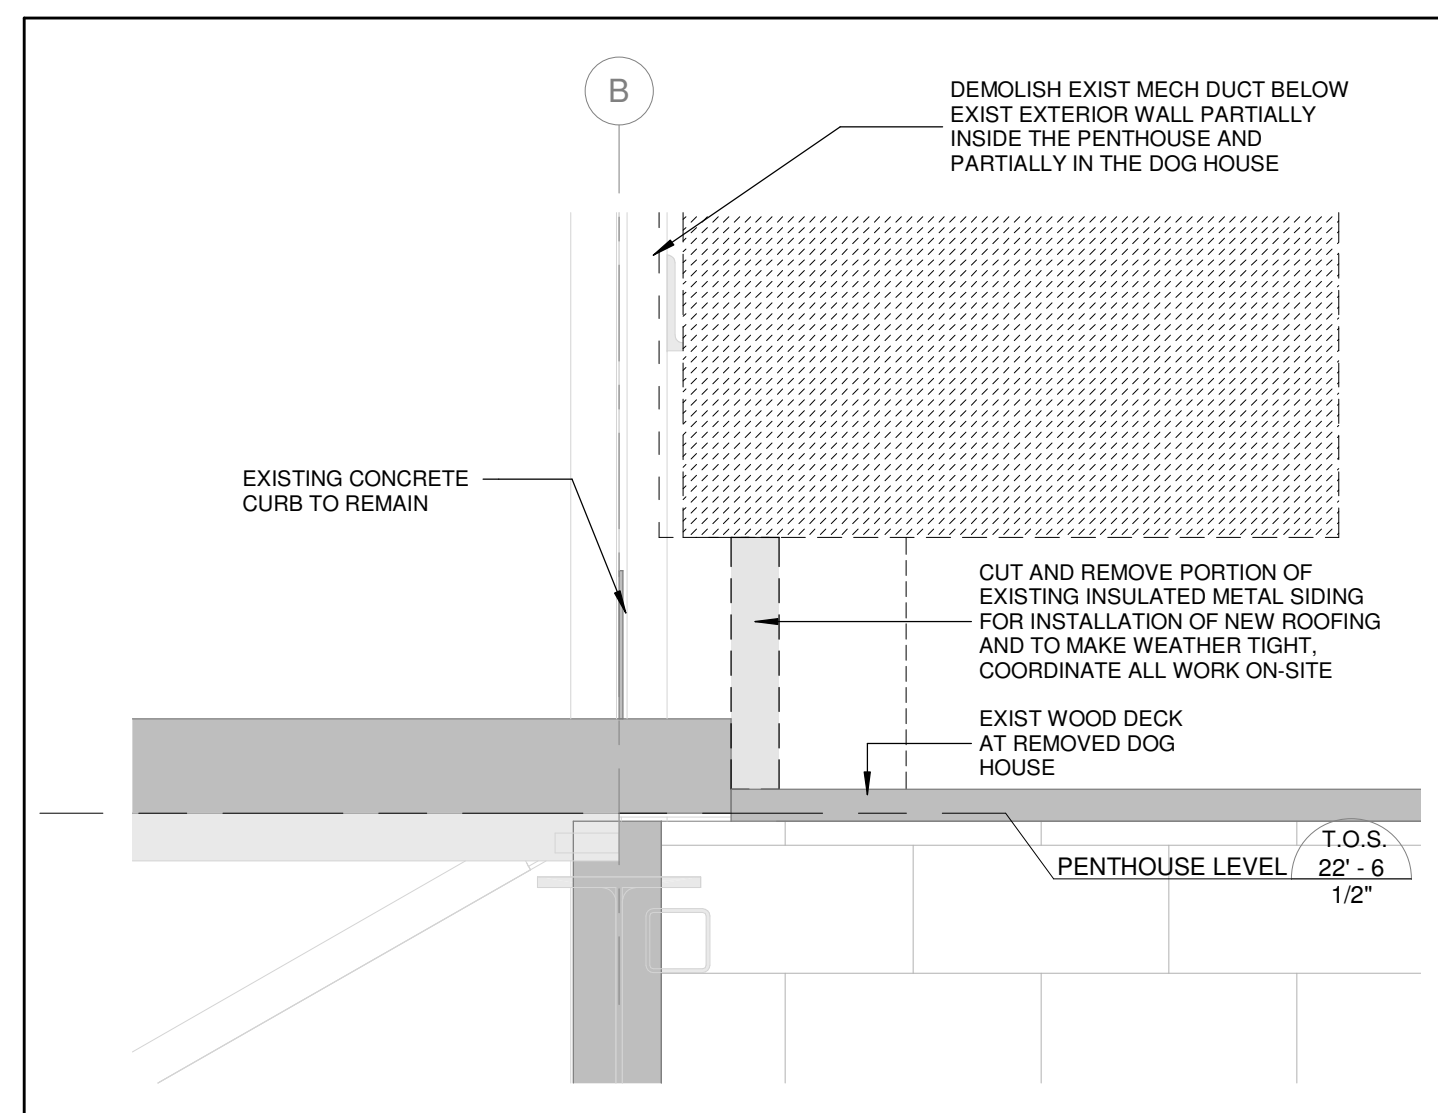

SECTION DETAIL @ WALL BASE @ EXST. WALL - DEMO
1" = 1'-0"

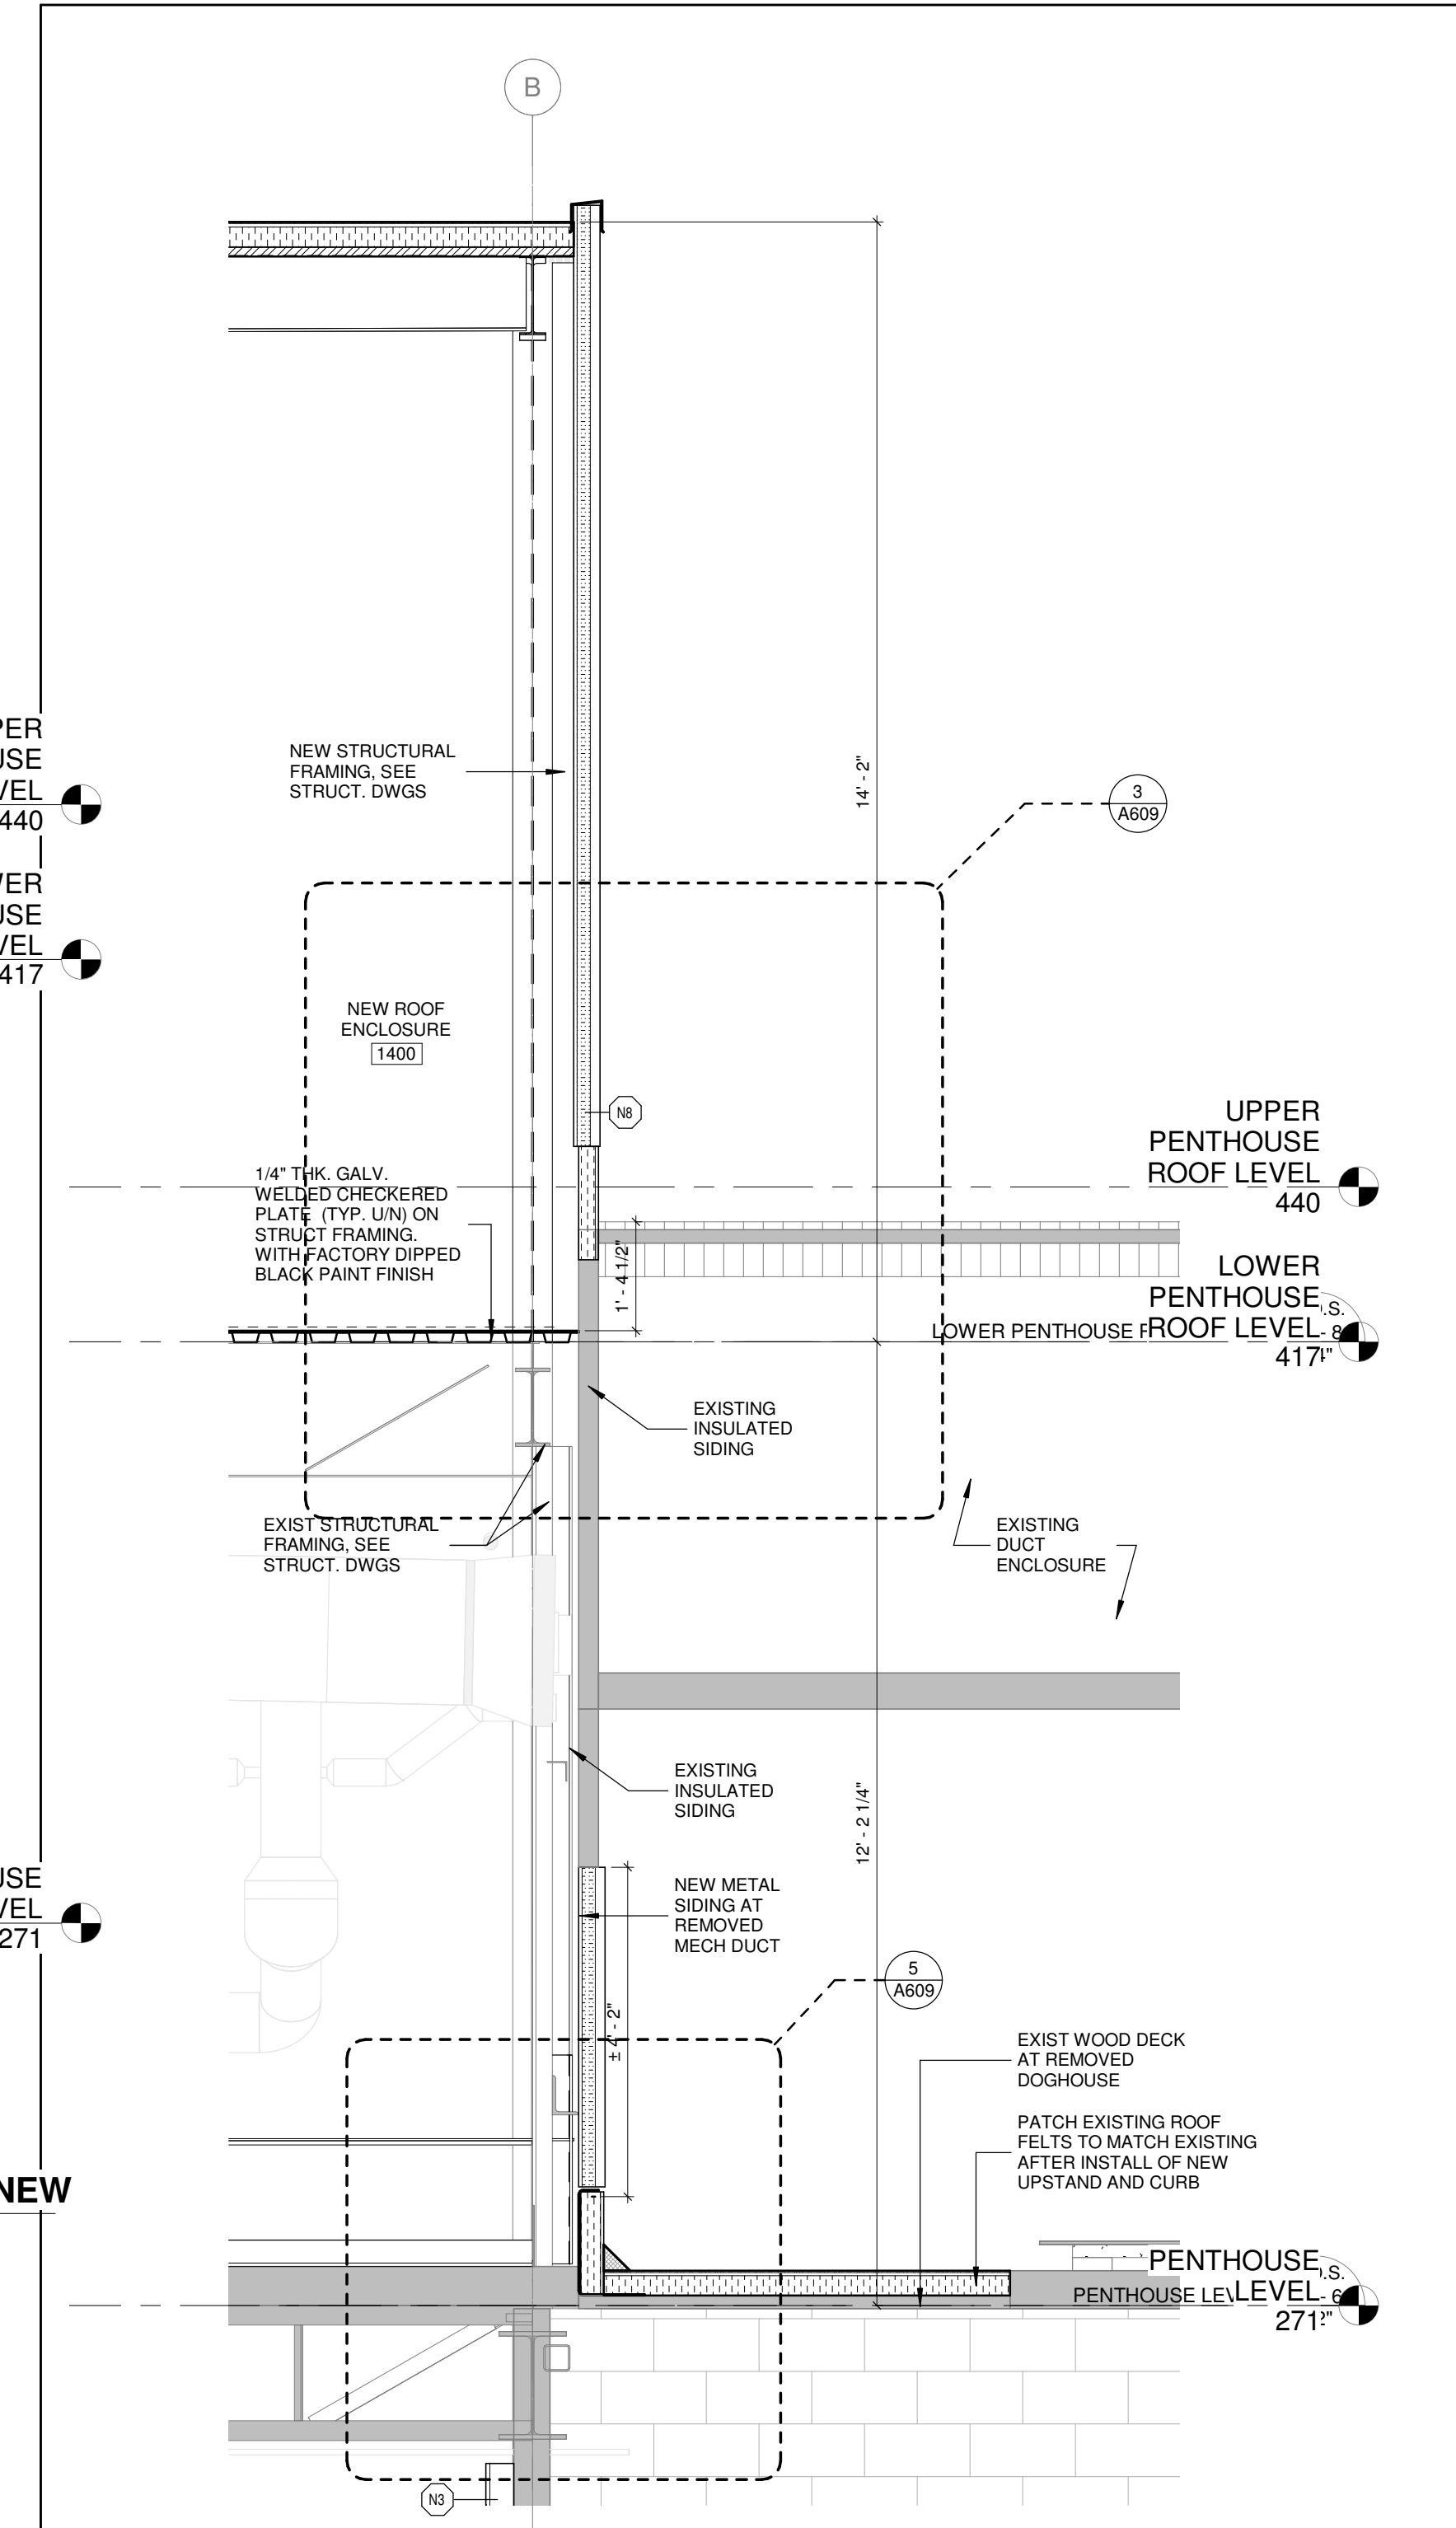

WALL SECT @ NEW ROOF ENCLOSURE WEST WALL & EXIST CATWALK - NEW
1/2" = 1'-0"

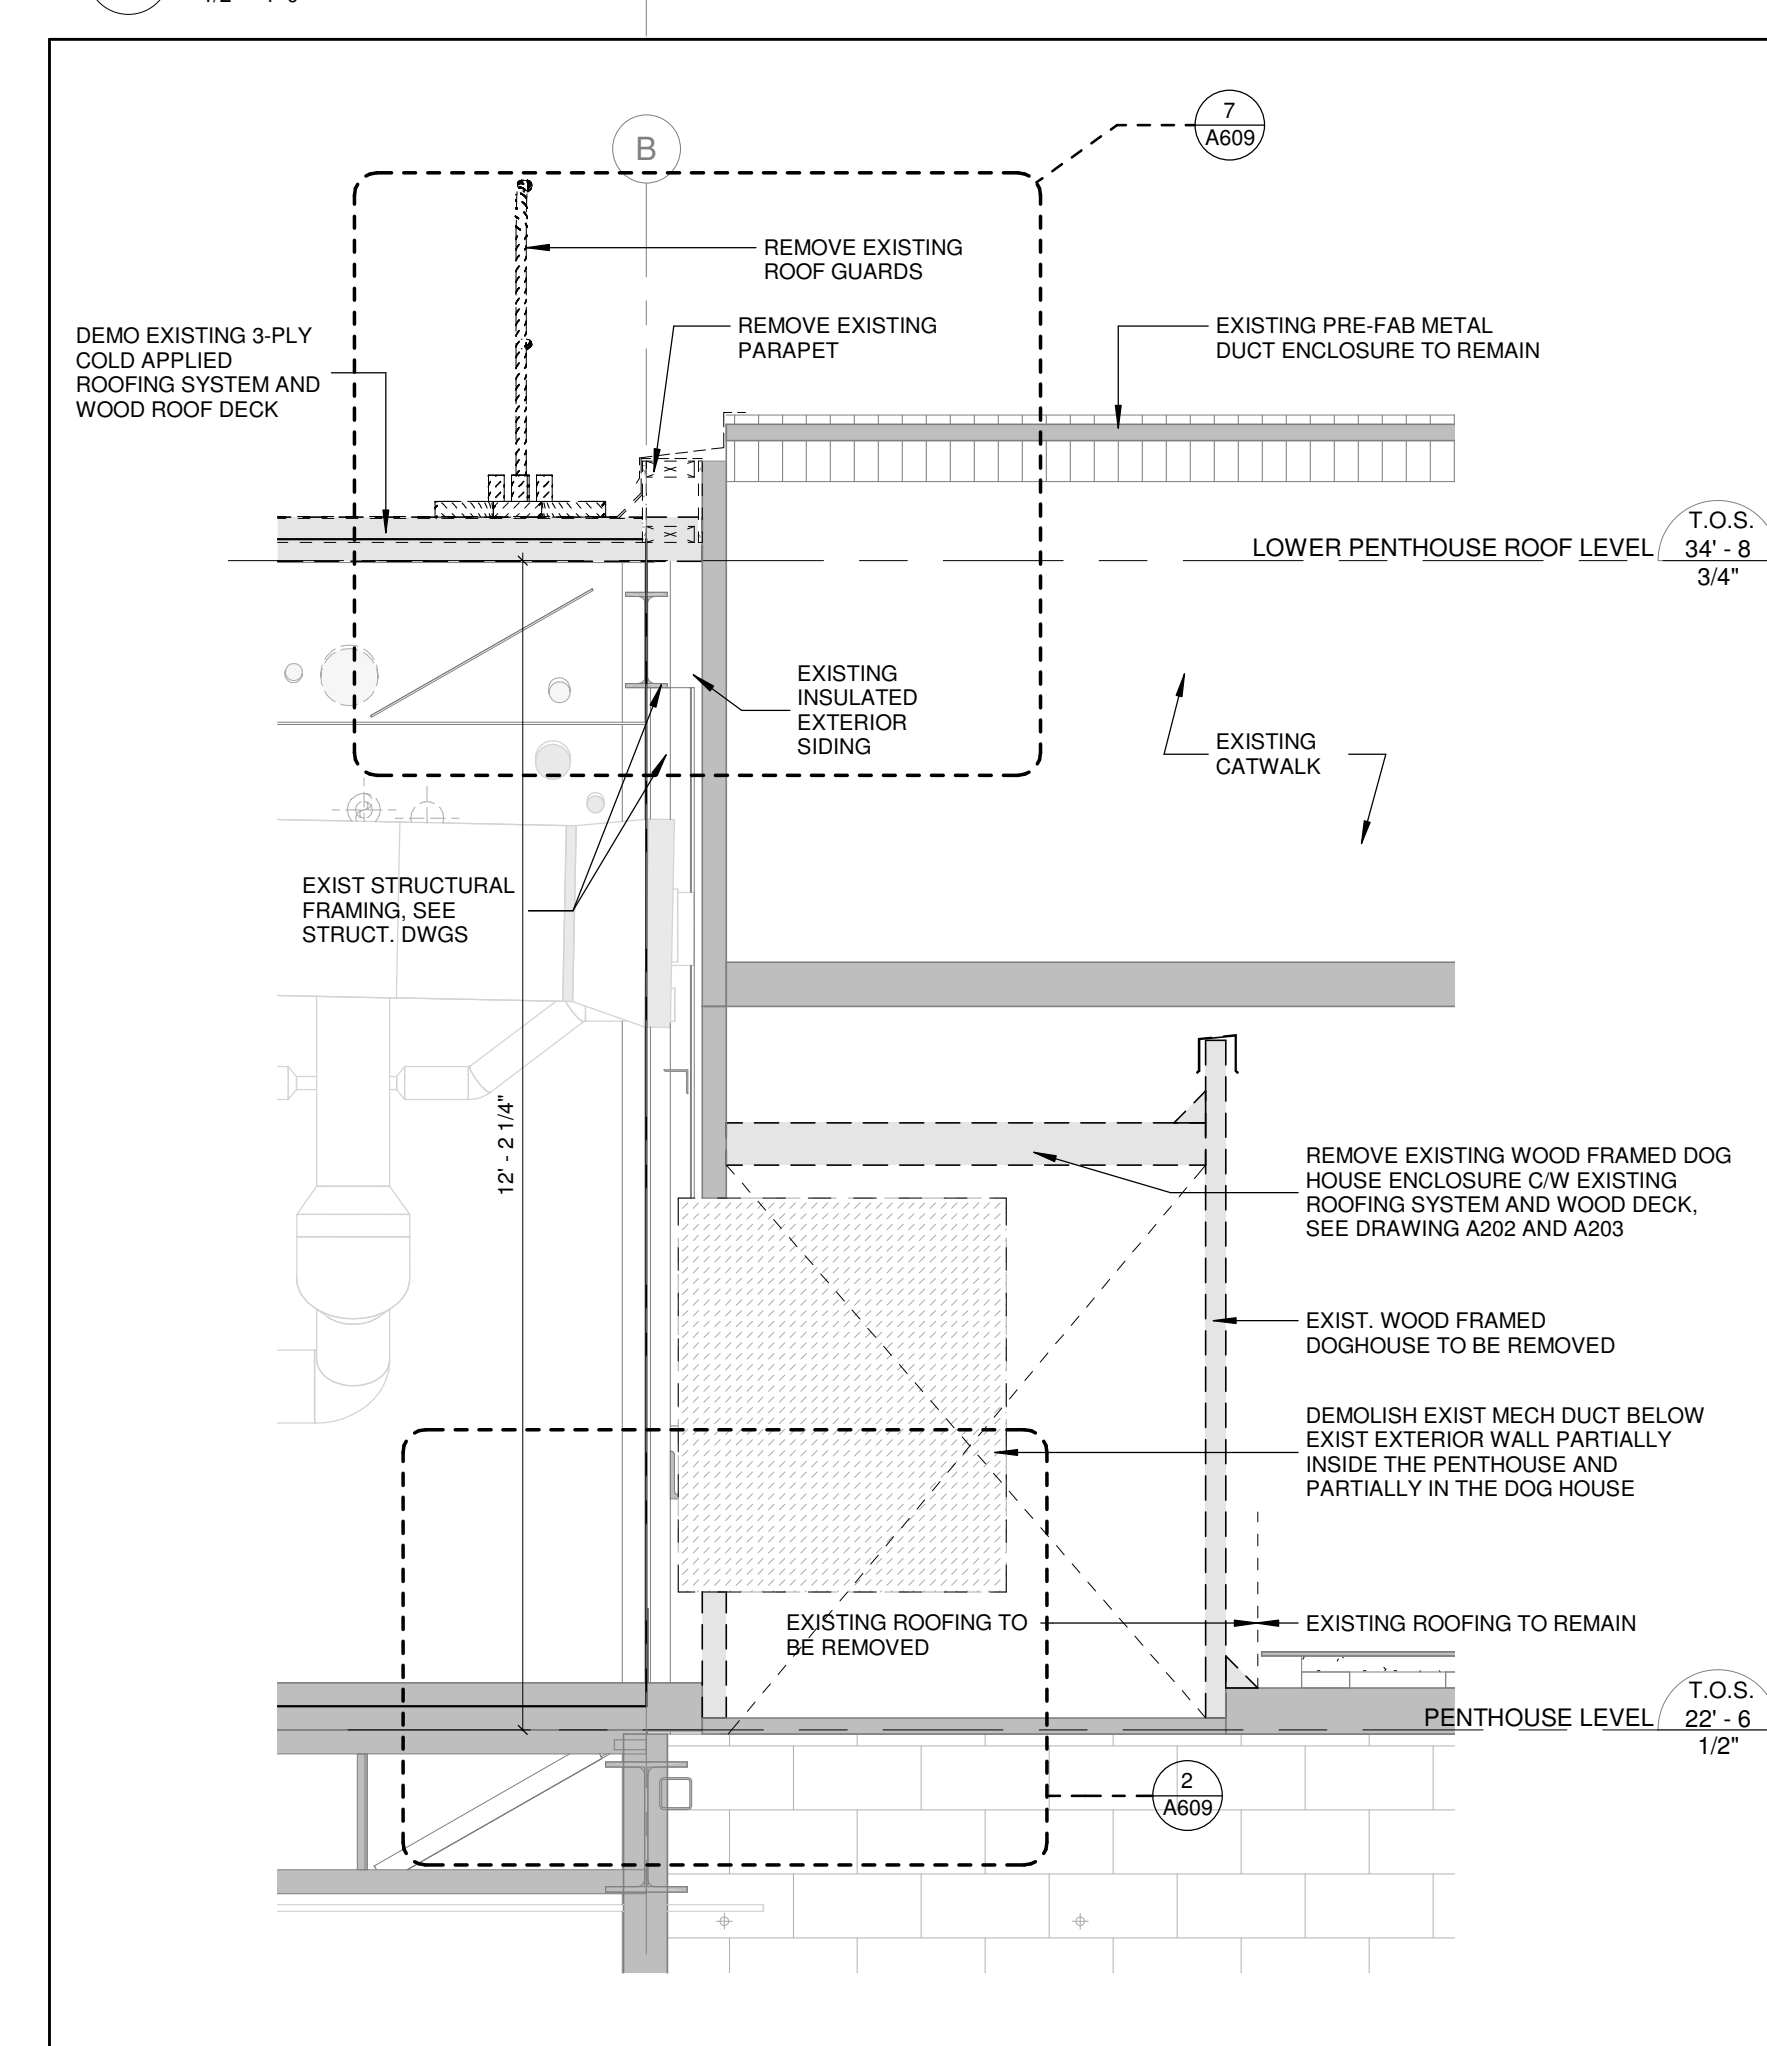


WALL SECT @ EXIST. CATWALK & DOG HOUSE @ WEST - DEMO
1/2" = 1'-0"

sanofi

Sanofi Pasteur, 1755 Steeles Avenue West, Toronto, Ontario M2R3T4

CONFIDENTIAL - PROPRIETARY INFORMATION
DRAWINGS, SPECIFICATIONS AND RELATED DOCUMENTS ARE INTENDED SOLELY FOR THE USE OF SANOFI PASTEUR LIMITED AND MAY CONTAIN INFORMATION WHICH IS PROPRIETARY, CONFIDENTIAL, TRADE SECRET OR OTHERWISE UNLAWFULLY OBTAINED. ANY UNAUTHORIZED USE, REPRODUCTION, DISTRIBUTION, REPRODUCTION, REVIEW OR COPIING IS PROHIBITED AND MAY BE A VIOLATION OF THE LAW. THIS IS SUBJECT TO THE SECRETS OF Sanofi Pasteur Limited.
VERIFY DIMENSIONS BEFORE USE

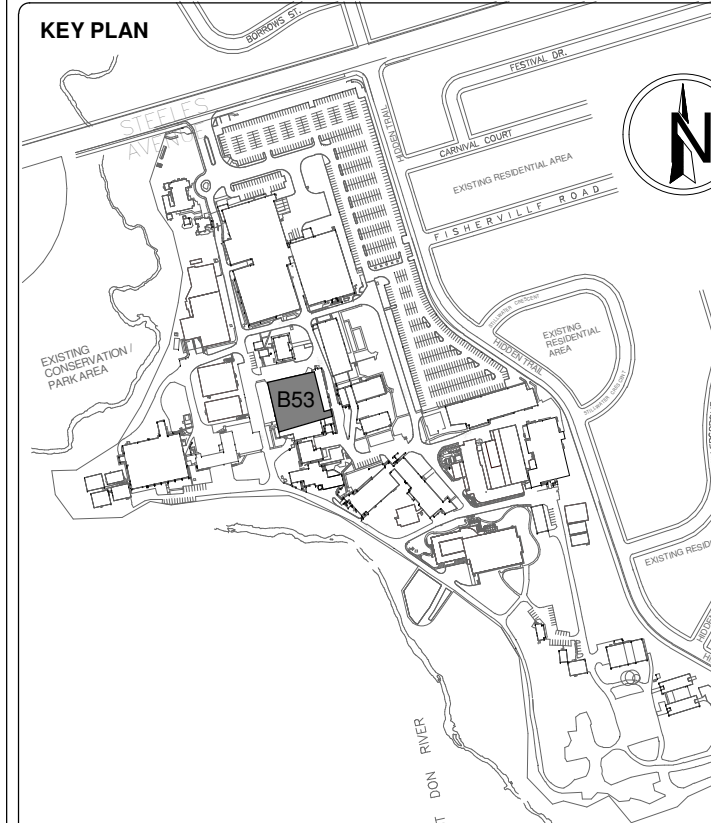

INTERNAL USE

Current Designer:
Version Description:
Version Date:
Approval Date:
Change Control Numbers:

DOCUMENT PERMISSIONS

Approval Date:

PROJECT

sanofi pasteur
SANOFI - B53 FORMULATION, FILLING, INSPECTION & PACKAGING (FFIP)
1755 STEELES AVE. W. NORTH YORK, ONTARIO M2R3T4
2210501

PRIME CONSULTANT

Cheme
35 Crawford Cres., Unit 1
P.O. Box 595
Campbellville, ON L0P 1B0
T: (905) 454-0999 F: (905) 454-1115


CONSULTANT

wba
architects and engineers Inc.
3 - 530 Rosedale Dairy Road
Vaughan, Ontario L4L 8H2
Tel: (905) 881-7128
Fax: (905) 881-7128
Email: info@wbae.com


CONSULTANT

WALTERFEDY
KITCHENER OFFICE
575 Queen Street South, Suite 111, Kitchener, Ontario, N2M 1A1
T 519.576.2150 F 519.576.5499 walterfedy.com
Copyright © 2021 Walterfedy Inc.

True North:

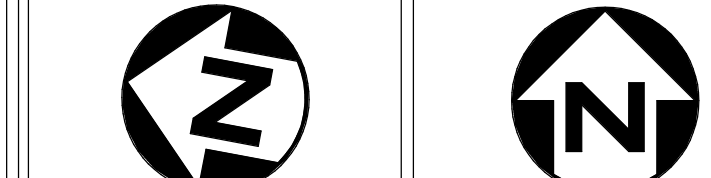

Project North:

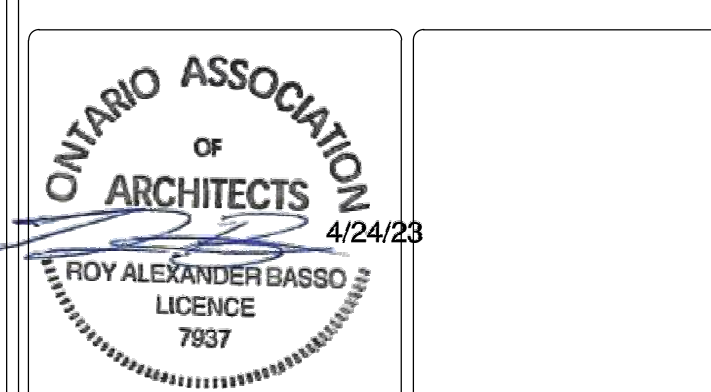

4/24/23

ROYAL ALXANDER BASSO
LICENCE
7537

REVISION

DESCRIPTION

BY

DATE

4 ISSUED FOR AS-BUILT WBA 27MAR2020

3 ISSUED FOR CCN #146 WBA 11FEB2020

2 ISSUED FOR SI #A-010 WBA 12DEC2024

1 ISSUED FOR CCN #003 WBA 31JAN2024

0 ISSUED FOR CONSTRUCTION WBA 28SEP2023

A ISSUED FOR TENDER ADDENDUM #02 WBA 15MAY2023

CURRENT DRAWING

Current Designer: inc

Current Designer: inc

Current Design Verifier: inc

ORIGINAL DRAWING

Drawing Creation Date:

Original Designer: inc

Original Design Verifier: inc

LOCATION

Block Number: Block Description:

Area/Functional Use:

TITLE



PENTHOUSE LEVEL AND NEW ROOF ENCLOSURE WALL SECTIONS

Scale: AS NOTED Sheet Size: ANSI E

Drawing & File Name: 53P-2021-015-A609

Layout Name: A609

Old Elec File: Old Sheet Name:

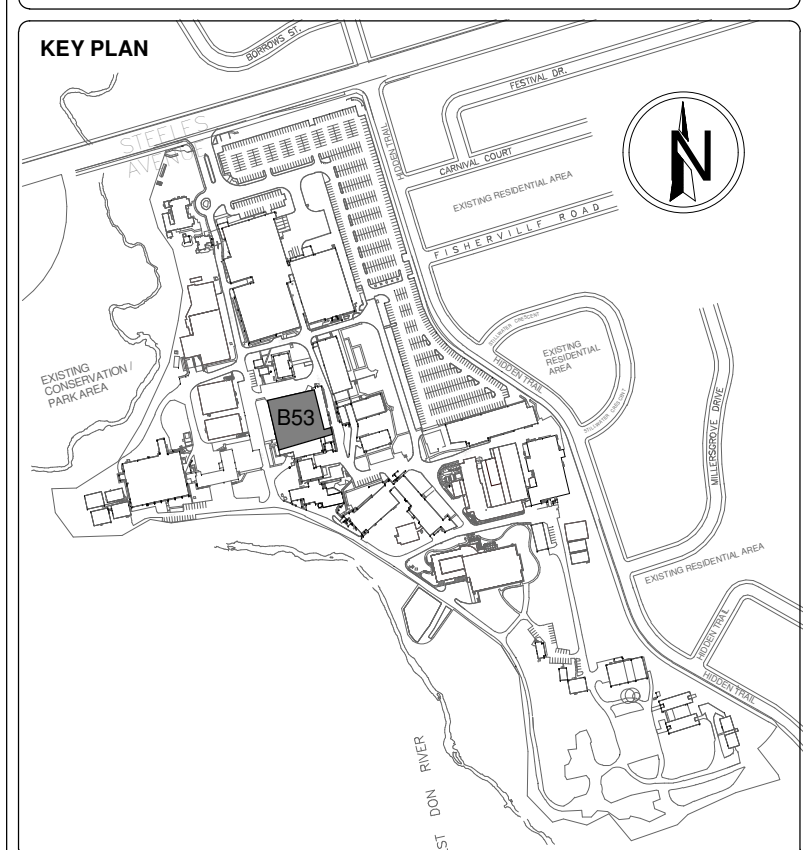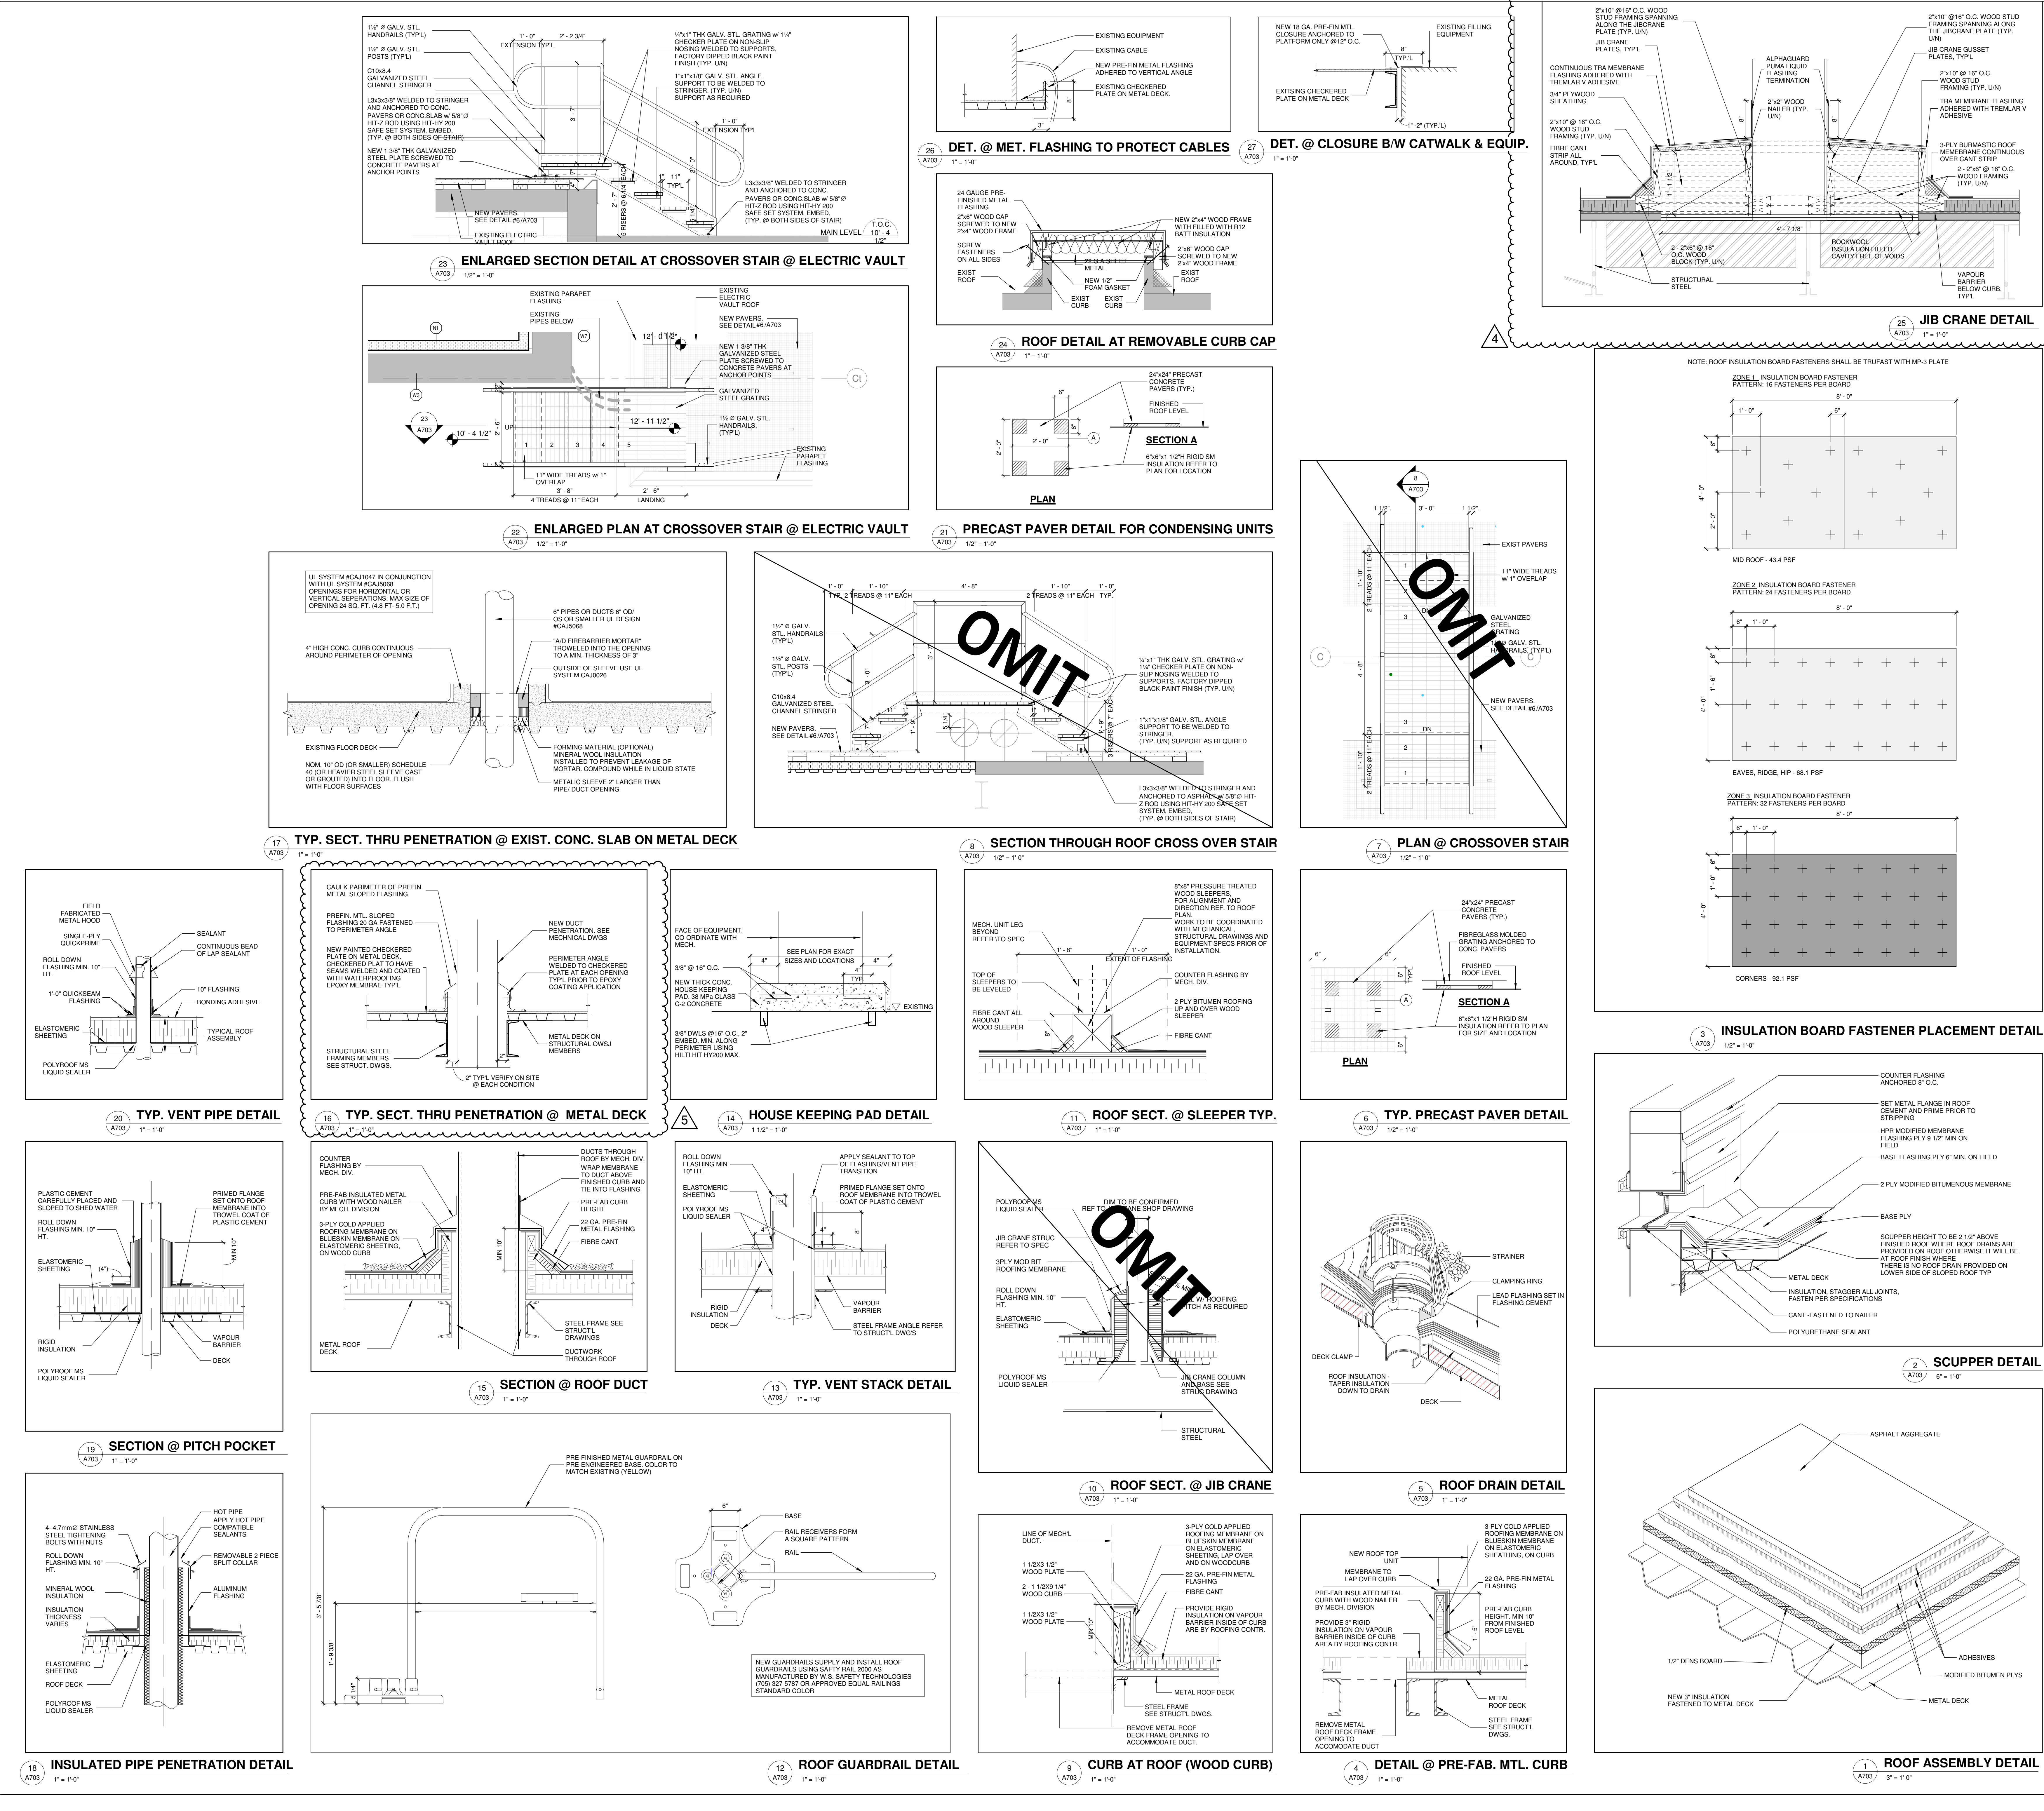

INTERNAL USE	
Current Designer:	
Version Description:	
Version Date:	
Approval Date:	
Change Control Numbers:	

DOCUMENT PERMISSIONS	
Approval Date:	
Approval Date:	

PROJECT	
Sanofi Pasteur	
SANOFI - B53 FORMULATION, FILLING, INSPECTION & PACKAGING (FFIP)	
1755 STEELES AVE. W. NORTH YORK, ONTARIO M2R3T4	
2210501	

PRIME CONSULTANT	
	35 Crawford Cres., Unit 1 P.O. Box 595 Campbellville, ON, L0P 1B0 Tel: (905) 881-7128 Fax: (905) 881-7128 Email: info@cheme.ca

CONSULTANT	
	3 - 530 Rosedale Dairy Road Vaughan, Ontario L4L 8H2 Tel: (905) 881-7128 Fax: (905) 881-7128 Email: info@wba.ca
architects and engineers Inc.	

CONSULTANT	
KITCHENER OFFICE 575 Queen Street South, Suite 111, Kitchener, Ontario, N2M 1A1 T 519.576.2150 F 519.576.5499 walterfedycan.com	
Copyright © 2021 Walter Fedy Inc.	

True North:	
Project North:	

ONTARIO ASSOCIATION OF ARCHITECTS	
4/24/23	
ROY ALEXANDER BASSO	
LICENCE 7837	

REVISION	DESCRIPTION	BY	DATE
6	ISSUED FOR AS-BUILT	WBA	27MAR2026
5	ISSUED FOR CCN #227	WBA	02OCT2025
4	ISSUED FOR CCN #197	WBA	04JUL2025
3	ISSUED FOR CCN #120	WBA	14JAN2025
2	ISSUED FOR CCN #011R1	WBA	30APR2024
1	ISSUED FOR CCN #011	WBA	29SEP2024
0	ISSUED FOR CONSTRUCTION	WBA	29SEP2023
F	ISSUED FOR PERMIT AND TENDER	WBA	21APR2023
E	ISSUED FOR 80% DESIGN REVIEW	WBA	11FEB2023
D	ISSUED FOR 90% INTERIM REVIEW	WBA	18NOV2022
C	ISSUED FOR FINAL BASIC DESIGN	WBA	29APR2022

CURRENT DRAWING	
Current Designer:	INSIYA KAPASI
Current Designer:	ROY BASSO
Current Design Verifier:	ROY BASSO

ORIGINAL DRAWING	
Drawing Creation Date:	
Original Designer:	
Original Design Verifier:	

LOCATION	
Block Number:	
Block Floor:	
Area/Functional Use:	

TITLE	
ROOF DETAILS	


Scale:	AS NOTED	Sheet Size:	ANSI E
--------	----------	-------------	--------

Drawing & File Name:	53P-2021-015-A703
Layout Name:	A703


Old Elec File:		Old Sheet Name:	
----------------	--	-----------------	--

NEW LEGEND:	
	EXISTING AREA TO REMAIN
	EXISTING AREA TO REMAIN
NEW WALL LEGEND:	
	4" THK. INSULATED PRE-FIN COOLER PANELS
	5/8" MOLD TOUGH GYPSUM BRD. ON BOTH SIDES OF 3/8" METAL STUDS TO 4" ABOVE FIN. CLNG. C/W EPOXY BASE
	5/8" MOLD TOUGH GYPSUM BRD. ON BOTH SIDES OF 3/8" METAL STUDS TO 4" ABOVE FIN. CLNG. C/W EPOXY BASE
	5/8" MOLD TOUGH GYPSUM BRD. ON ONE SIDE OF 3/8" METAL STUDS TO 4" ABOVE FIN. CLNG. C/W EPOXY BASE
	5/8" MOLD TOUGH GYPSUM BRD. ON ONE SIDE OF 3/8" METAL STUDS TO 4" ABOVE FIN. CLNG. C/W EPOXY BASE
	5/8" MOLD TOUGH GYPSUM BRD. ON ONE SIDE OF 3/8" METAL STUDS TO 4" ABOVE FIN. CLNG. C/W EPOXY BASE
	5/8" MOLD TOUGH GYPSUM BRD. WHERE REQUIRED
	5/8" MOLD TOUGH GYPSUM BRD. ON ONE SIDE OF 2 1/2" METAL STUDS 18 GAUGE AT 16" O.C. FILLED WITH CLOSED CELL SPRAY FOAM INSULATION BY ICYNENE OR HEATLOK SOYA HP (R-14) UP TO US OF STRUCTURE ABOVE (12'-2" HT.)
	5/8" MOLD TOUGH GYPSUM BRD. ON BOTH SIDES OF 3/8" METAL STUDS. WALL TO EXTEND TO US OF STRUCTURE ABOVE (12'-2" HT.)
	1 1/2" PRE-FIN METAL SIDING ON 3" RIGID INSULATION ON 4" CONCRETE BLOCK UP TO 10'-0" A.F.F. AND 1 1/2" PRE-FIN METAL SIDING ON 3" RIGID INSULATION FROM 10'-0" A.F.F. TO 13'-4" A.F.F.
	STUCCO FINISH ON BASE COAT ON FIBRE MESH ON 2" INSULBLOCK (R-10) ON DUMPOCK AIRMOISTURE BARRIER ON 8" DENS GLASS GOLF ON 6" METAL STUDS 18 GAUGE AT 16" O.C. BATT INSUL. (R-20) 6 MIL VAPOUR BARRIER AND 5/8" INTERIOR GYPSUM BOARD
	CONCRETE BLOCK INFILL
	8" THK CONC. MASONRY BLOCK WALL
	NEW FACE BRICK TO MATCH EXISTING ON 12" AIR GAP ON 8" THK CONC. MASONRY BLOCK WALL
	4" INSULATED CORRUGATED METAL SIDING TO MATCH EXISTING COLOR AND PROFILE FASTENED TO NEW METAL FRAMING MEMBERS. SEE STRUCT.


EXIST. WALL LEGEND:	
	EXISTING CONCRETE BLOCK
	EXISTING CONCRETE BLOCK 6" THK
	EXISTING CONCRETE BLOCK 10" THK
	EXISTING CONCRETE BLOCK 6" THK
	EXISTING GYP. BRD. ON BOTH SIDES OF METAL STUDS
	EXISTING GYP. BRD. ON ONE SIDE OF METAL STUDS
	EXISTING 3 COURSE LOAD BEARING BRICK MASONRY WALL WITH 1/2" AIR SPACE IN BETWEEN
	INSULATED METAL SIDING
	INSULATED METAL SIDING ON AIR SPACE ON 6" METAL STUD FILLED WITH BATT INSULATION ON SHEATHING
	EXIST FACE BRICK ON 3/4" AIR SPACE ON 8" CONCRETE MASONRY BLOCK WALL
	EXIST STUCCO ON RIGID INSULATION ON FACE BRICK ON 3/4" AIR SPACE ON 8" CONCRETE MASONRY BLOCK WALL
	EXIST CONCRETE WALL
	EXIST GYPSUM BOARD
	EXIST INFILL
	EXIST BRICK ON GYPSUM INSULATED WALL PANEL

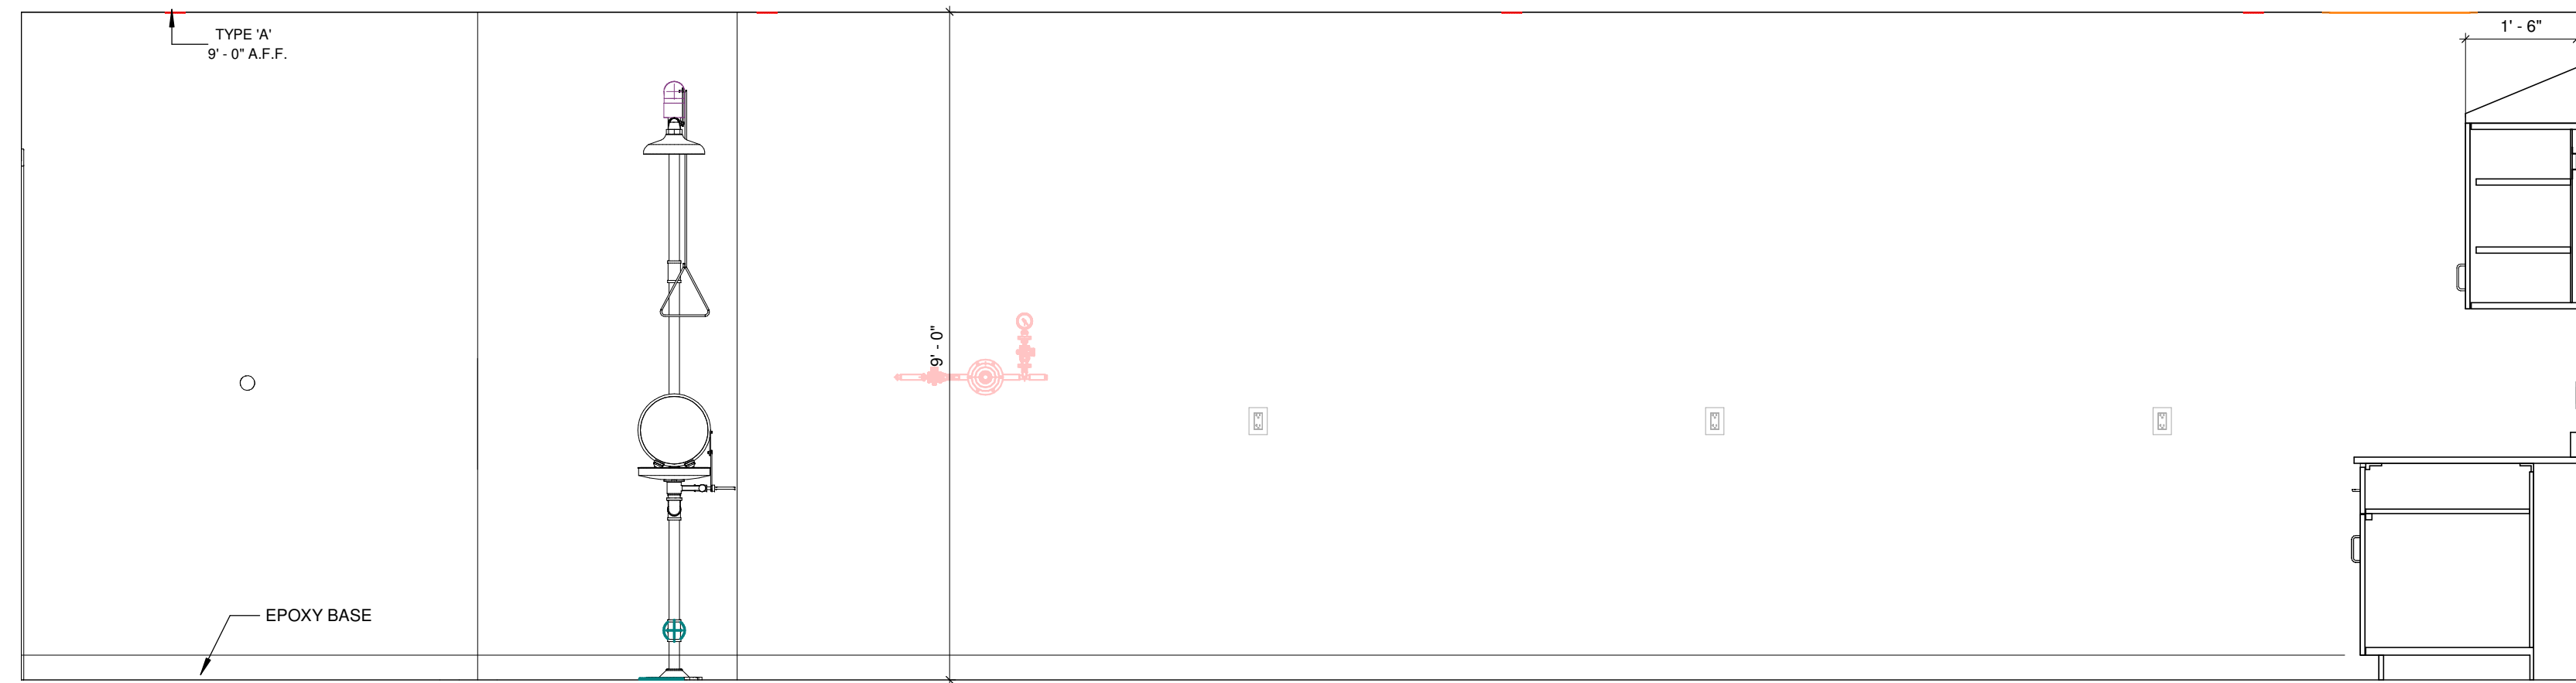


5 EAST ELEVATION @ MAINTENANCE SHOP
1 1/2" = 1'-0"

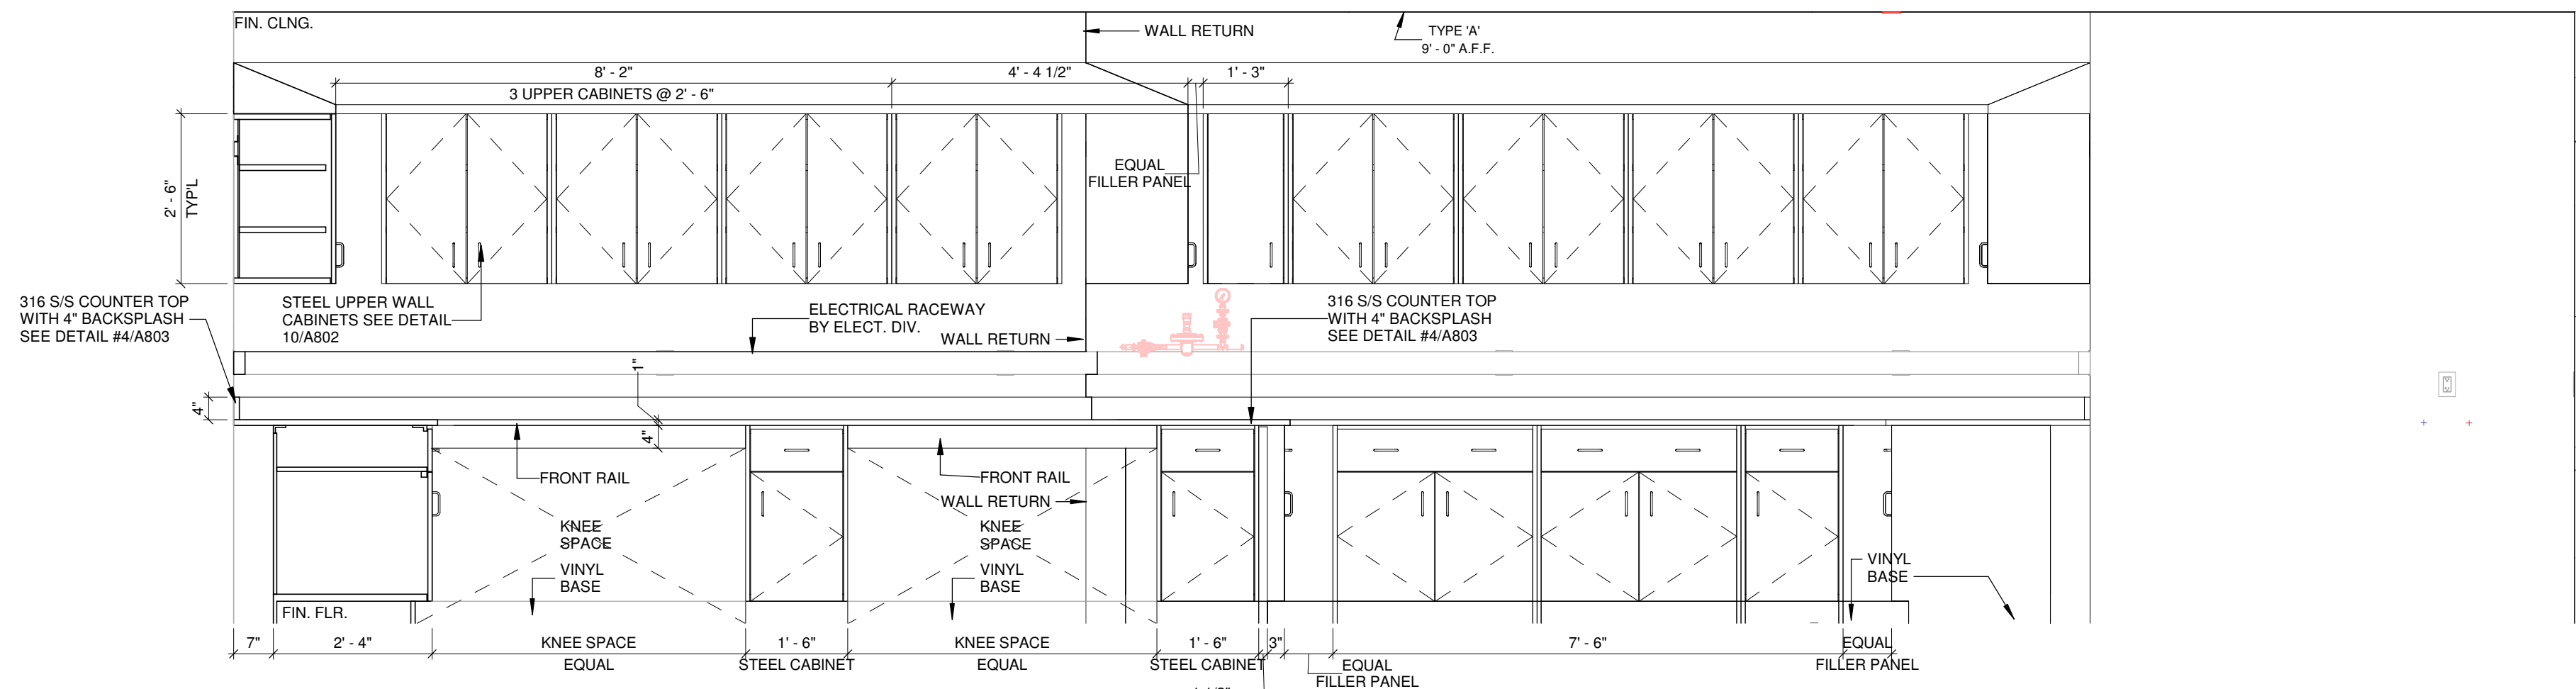


4 WEST ELEVATION @ MAINTENANCE SHOP
1 1/2" = 1'-0"

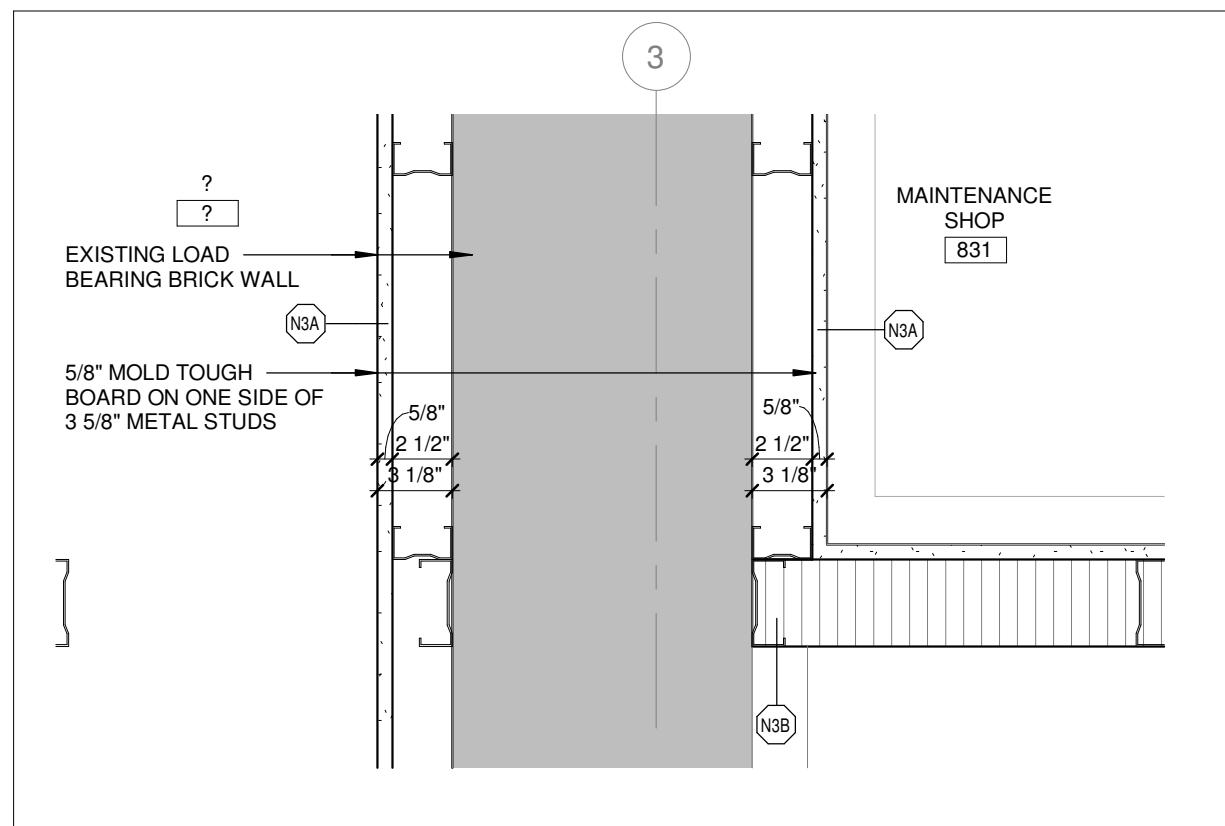


10 PLAN DETAIL AT CORNER
1 1/2" = 1'-0"

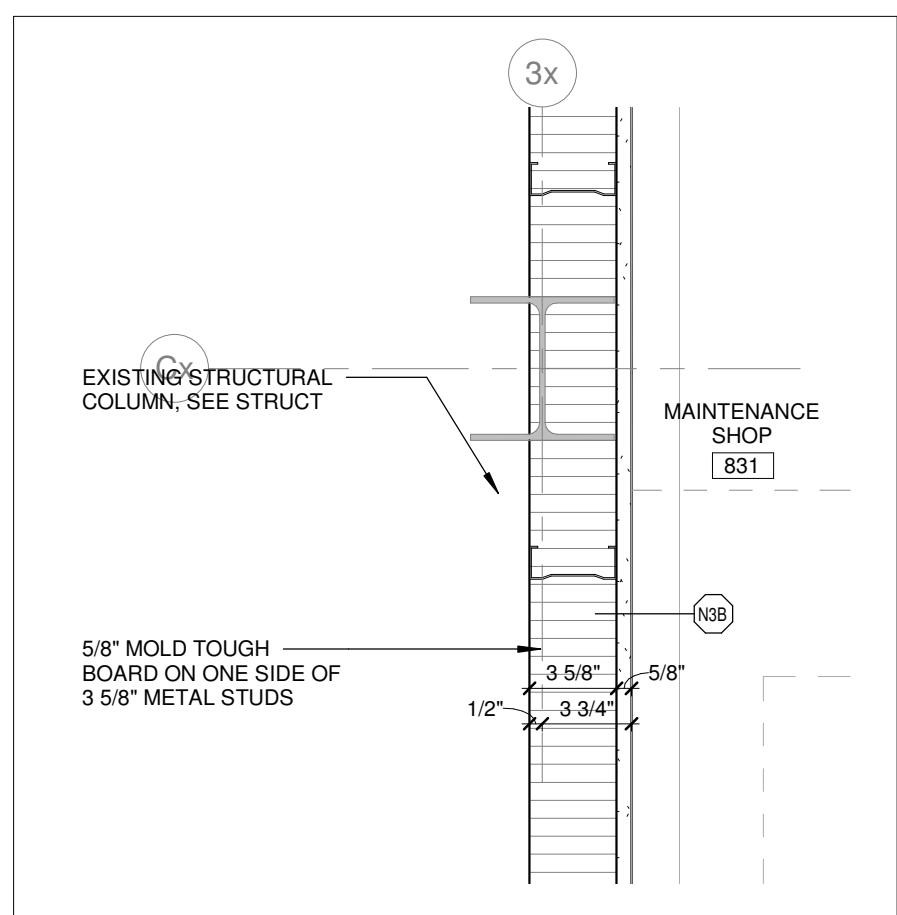


9 PLAN DETAIL AT GRID 'Cx' AND '3x'
1 1/2" = 1'-0"

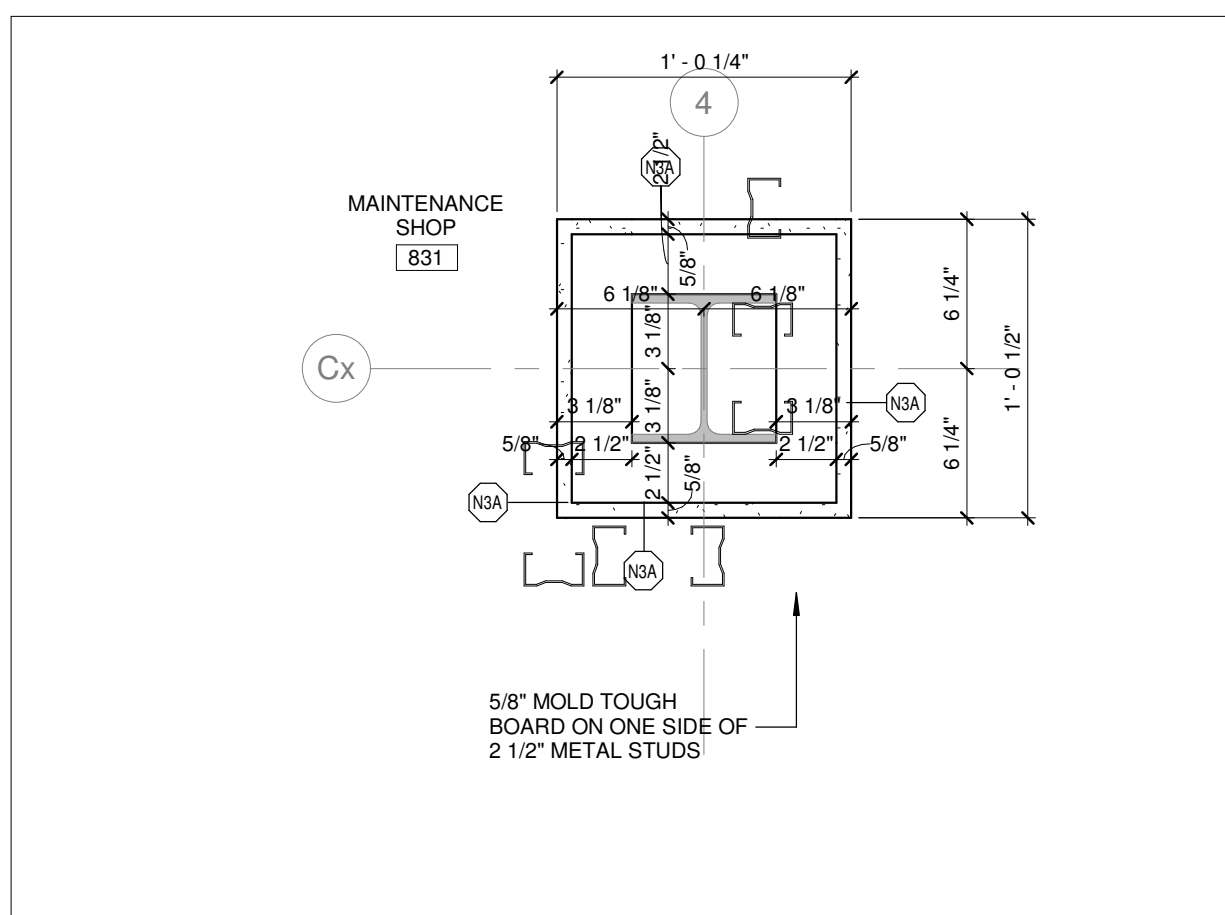


8 PLAN DETAIL AT GRID 'Cx' AND '4'
1 1/2" = 1'-0"

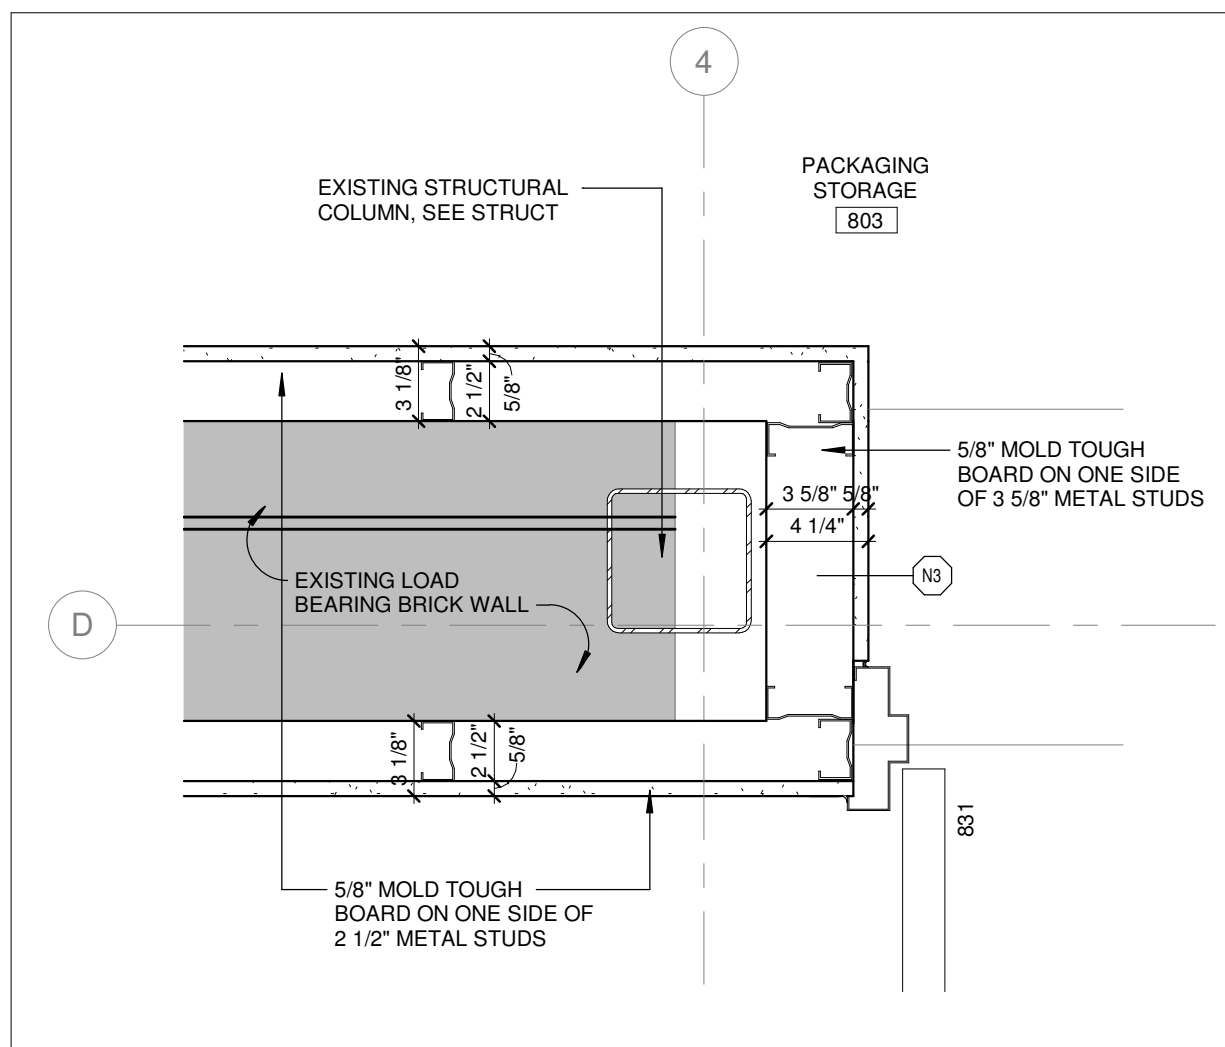


6 PLAN DETAIL AT MAINTENANCE ROOM ENTRANCE
1 1/2" = 1'-0"

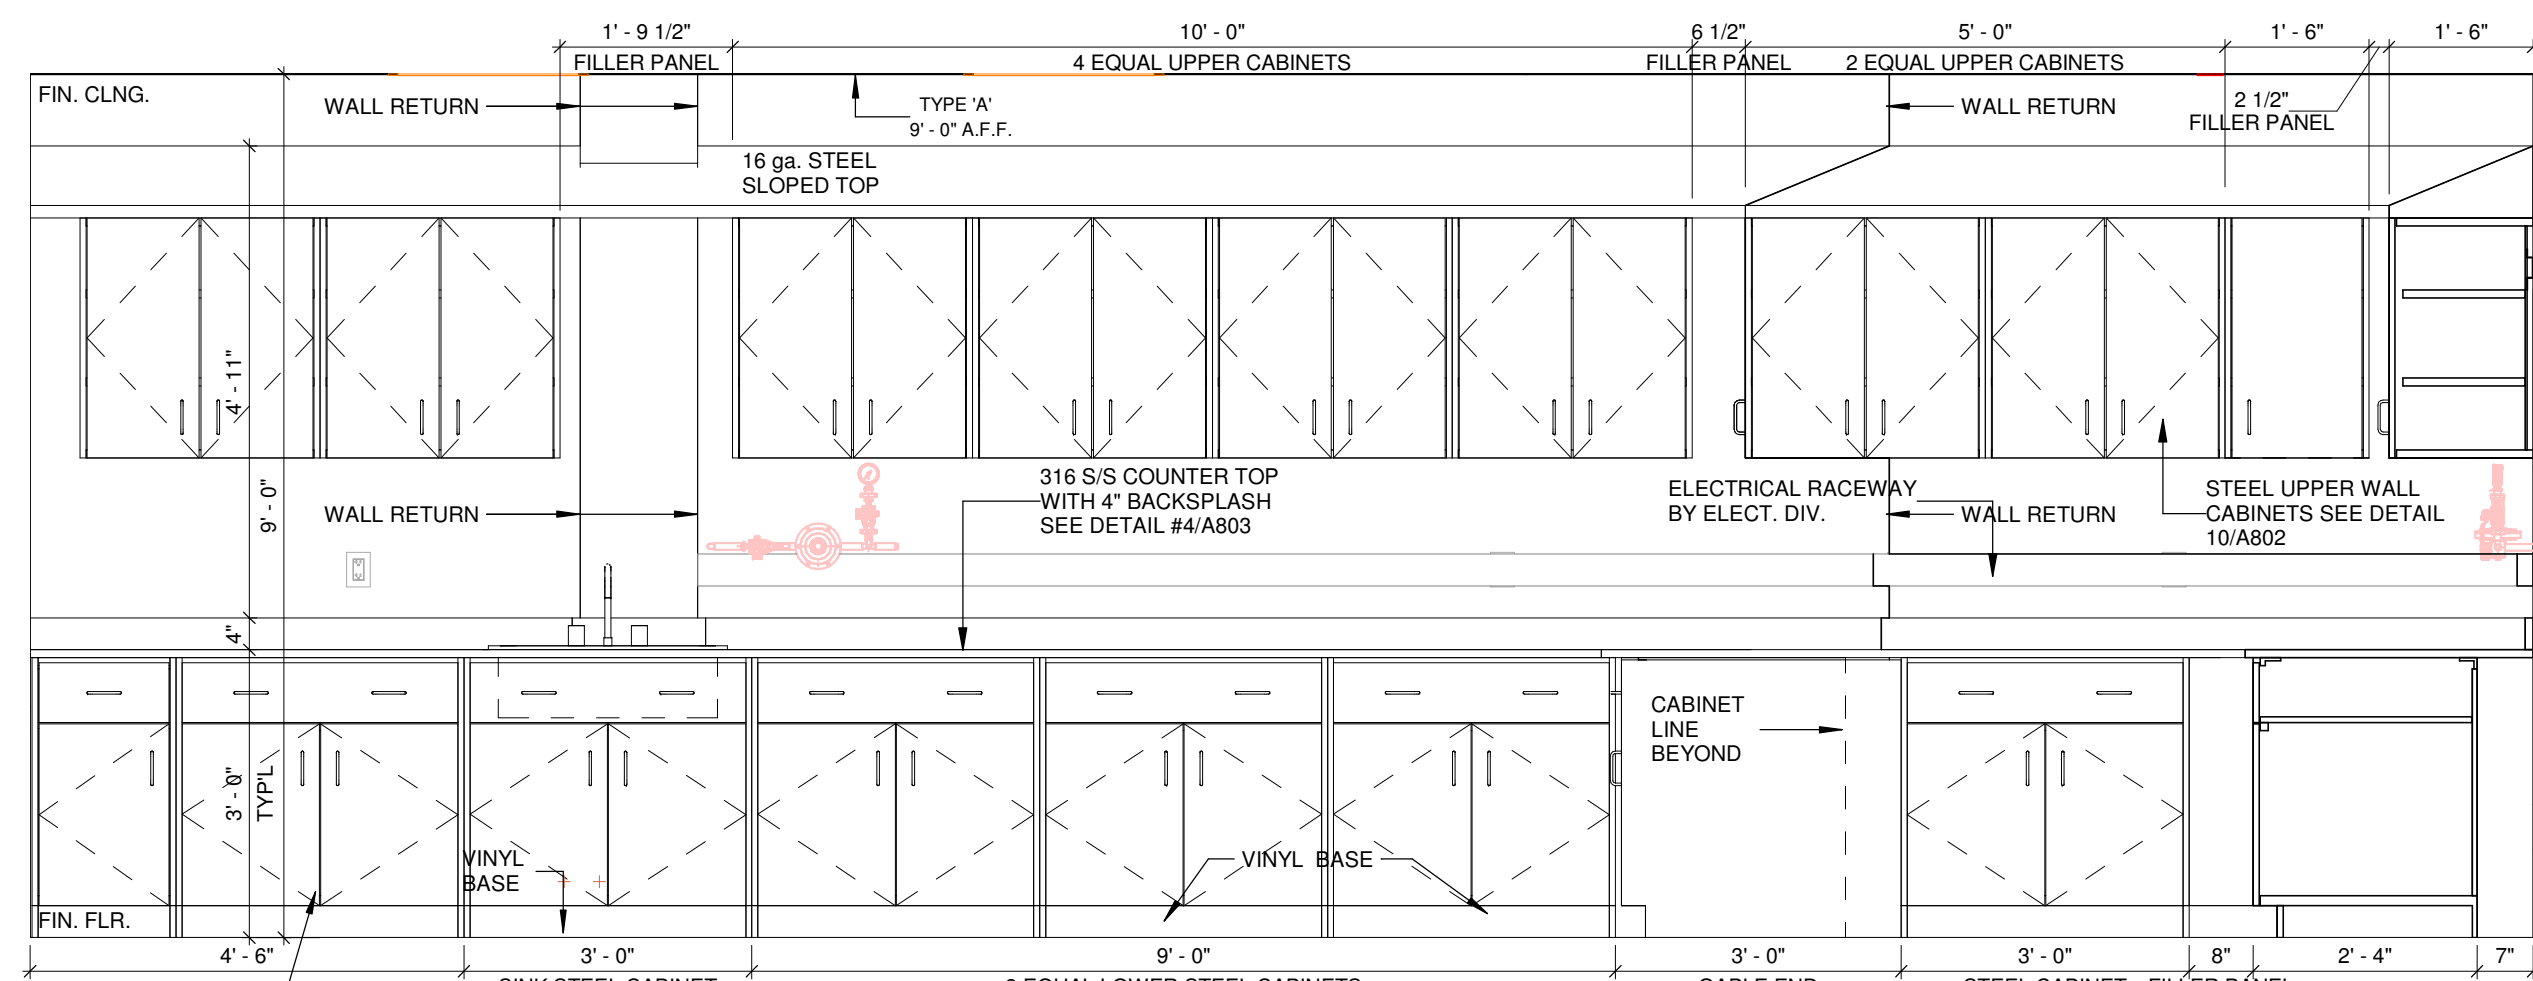


3 SOUTH ELEVATION @ MAINTENANCE SHOP
1 1/2" = 1'-0"

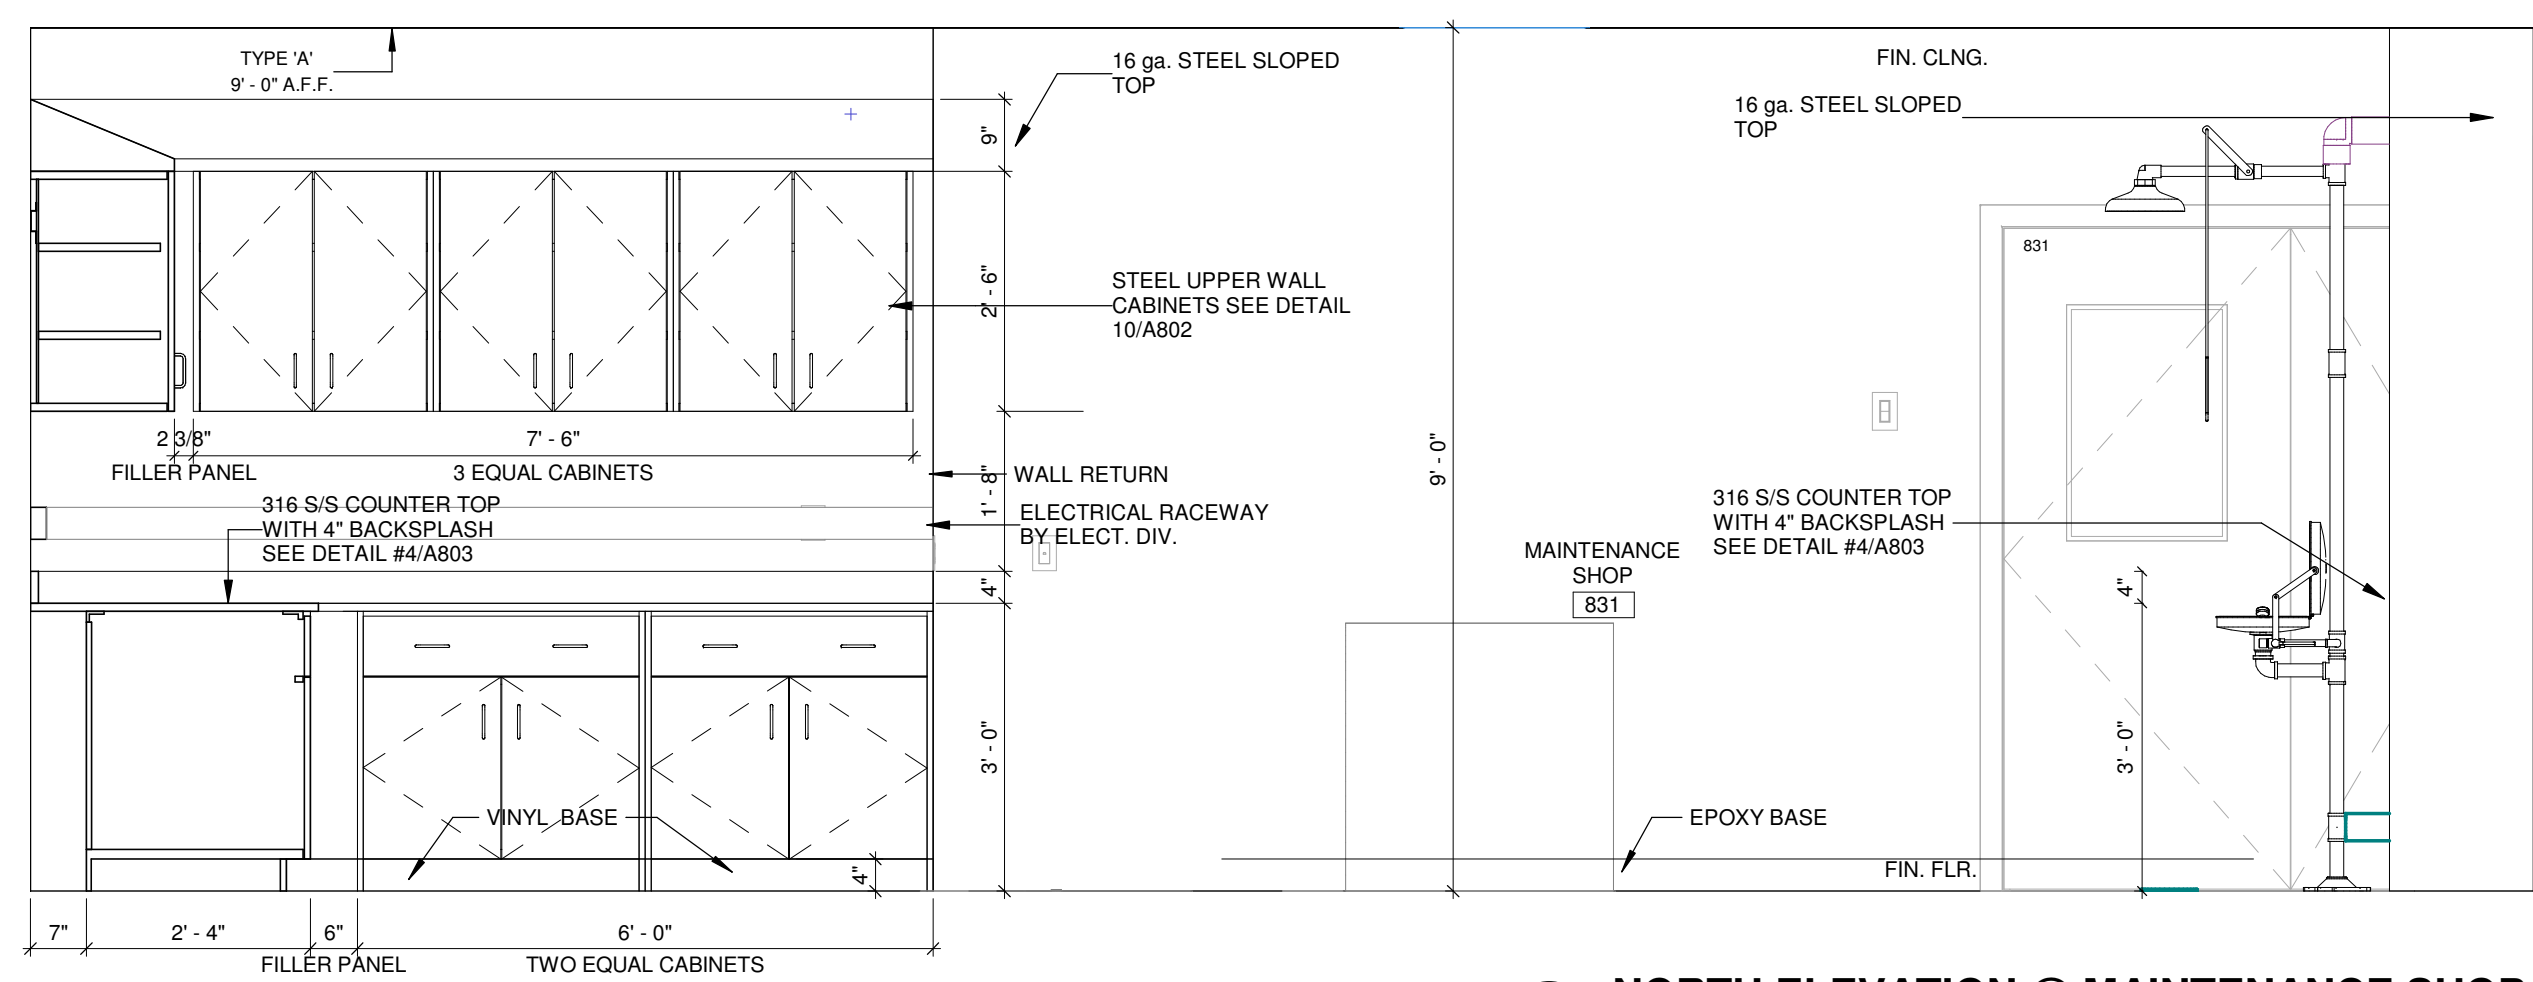


2 NORTH ELEVATION @ MAINTENANCE SHOP
1 1/2" = 1'-0"

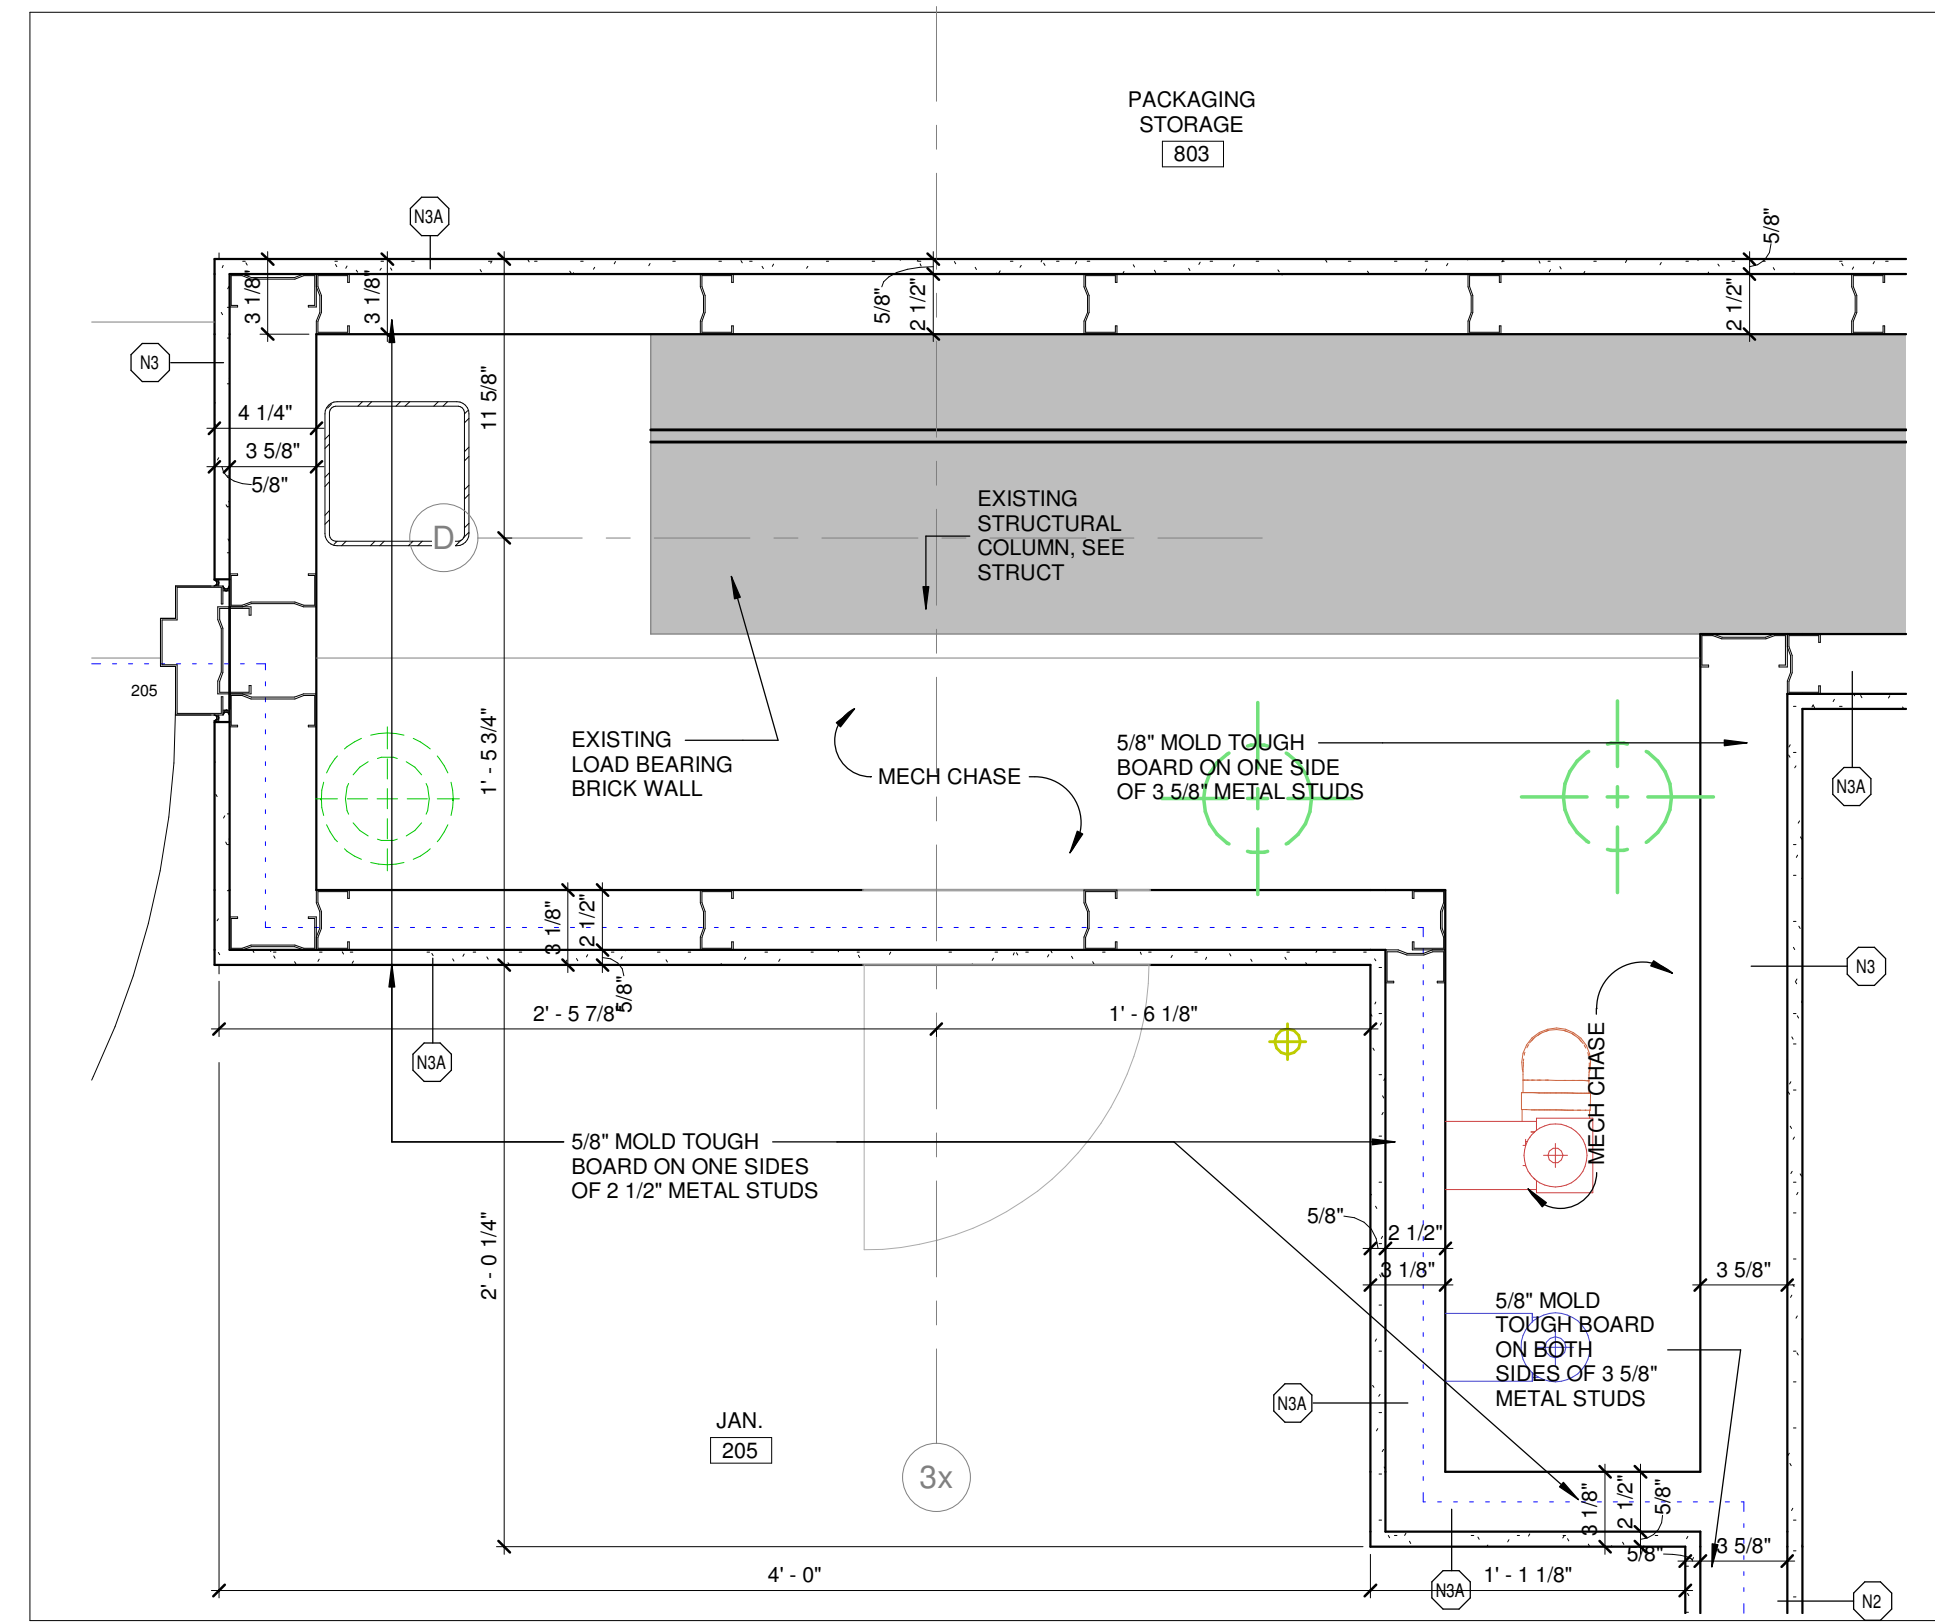

7 PLAN DETAIL AT GRID 'D' AND '3x'
1 1/2" = 1'-0"

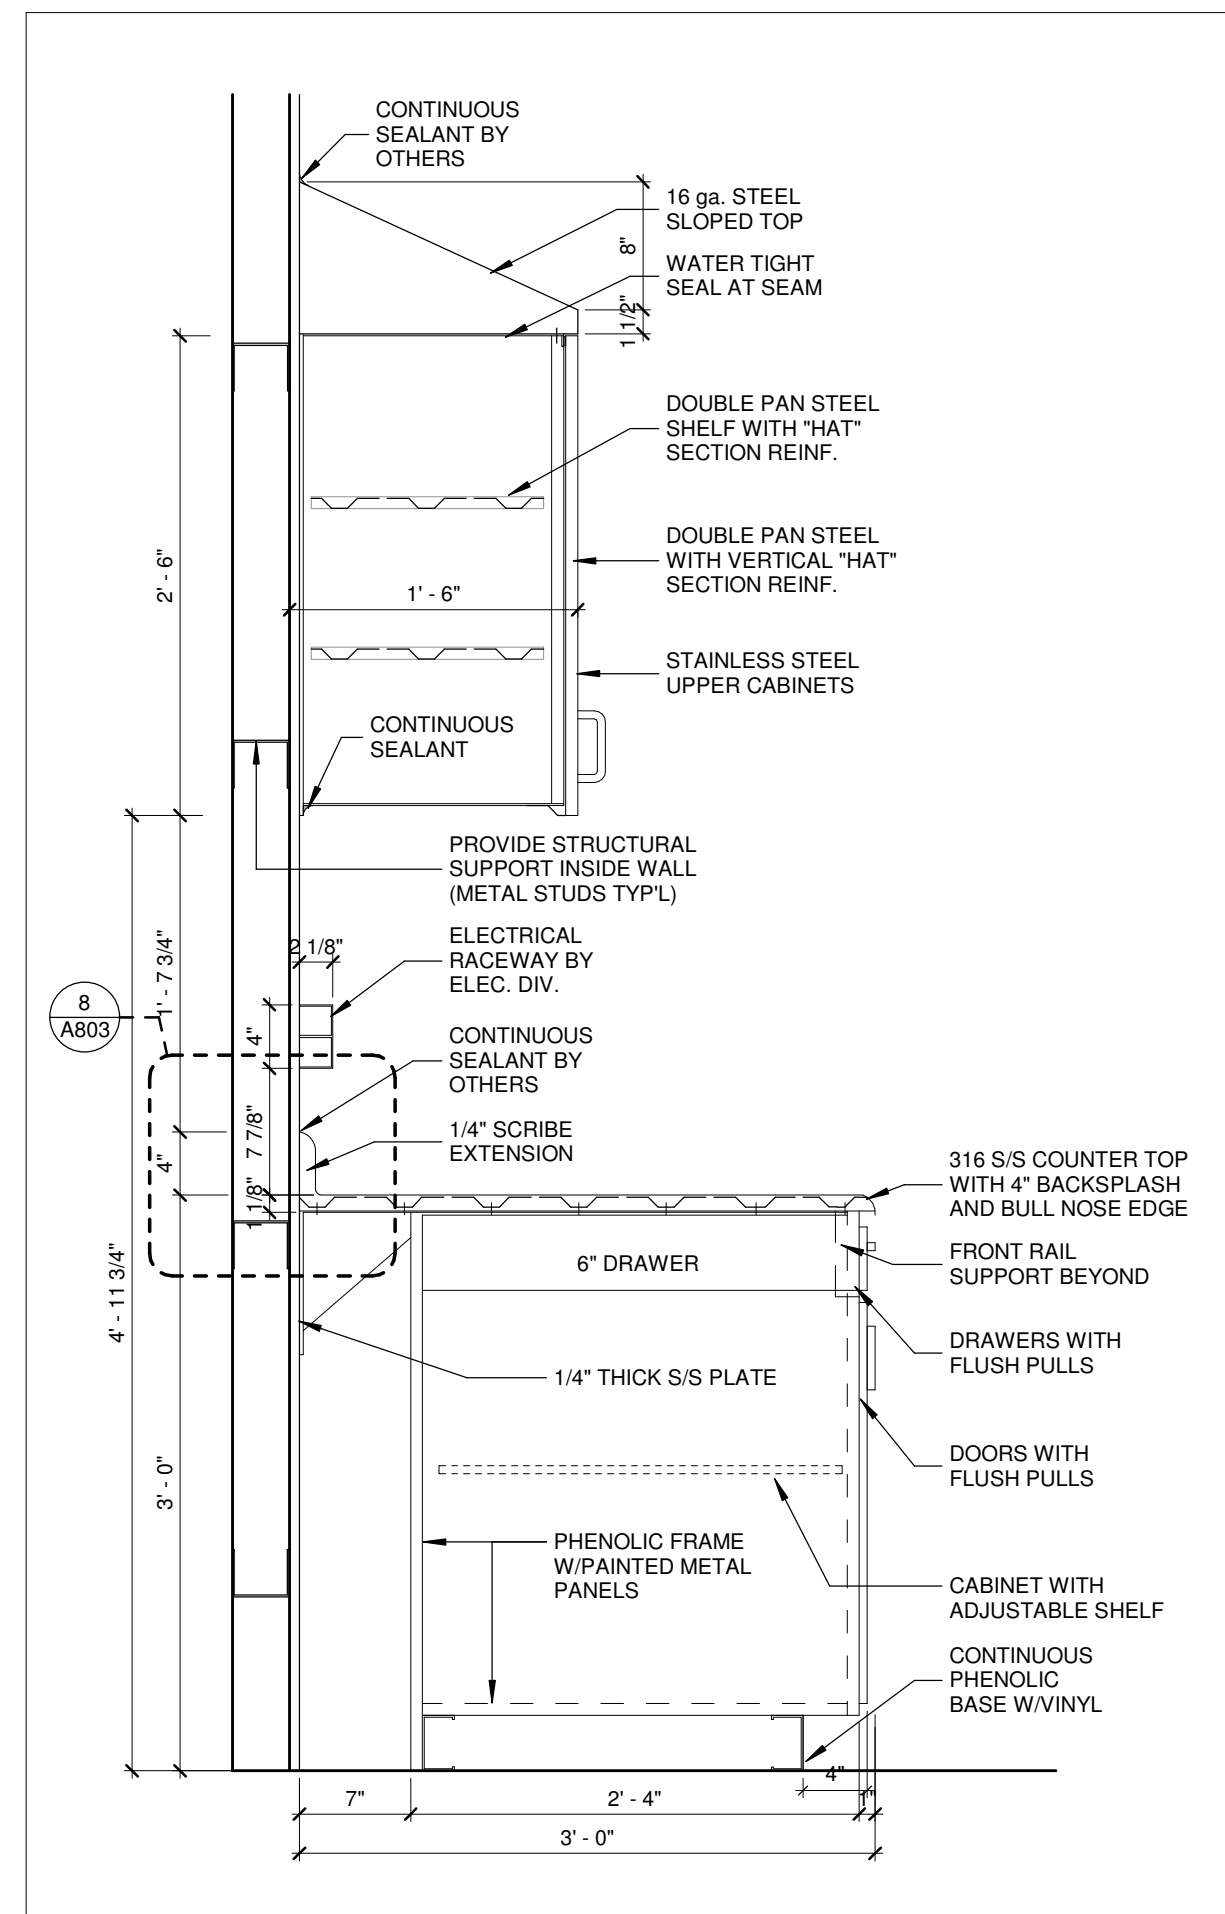

11 DETAIL AT BASE AND UPPER CABINETS
1" = 1'-0"

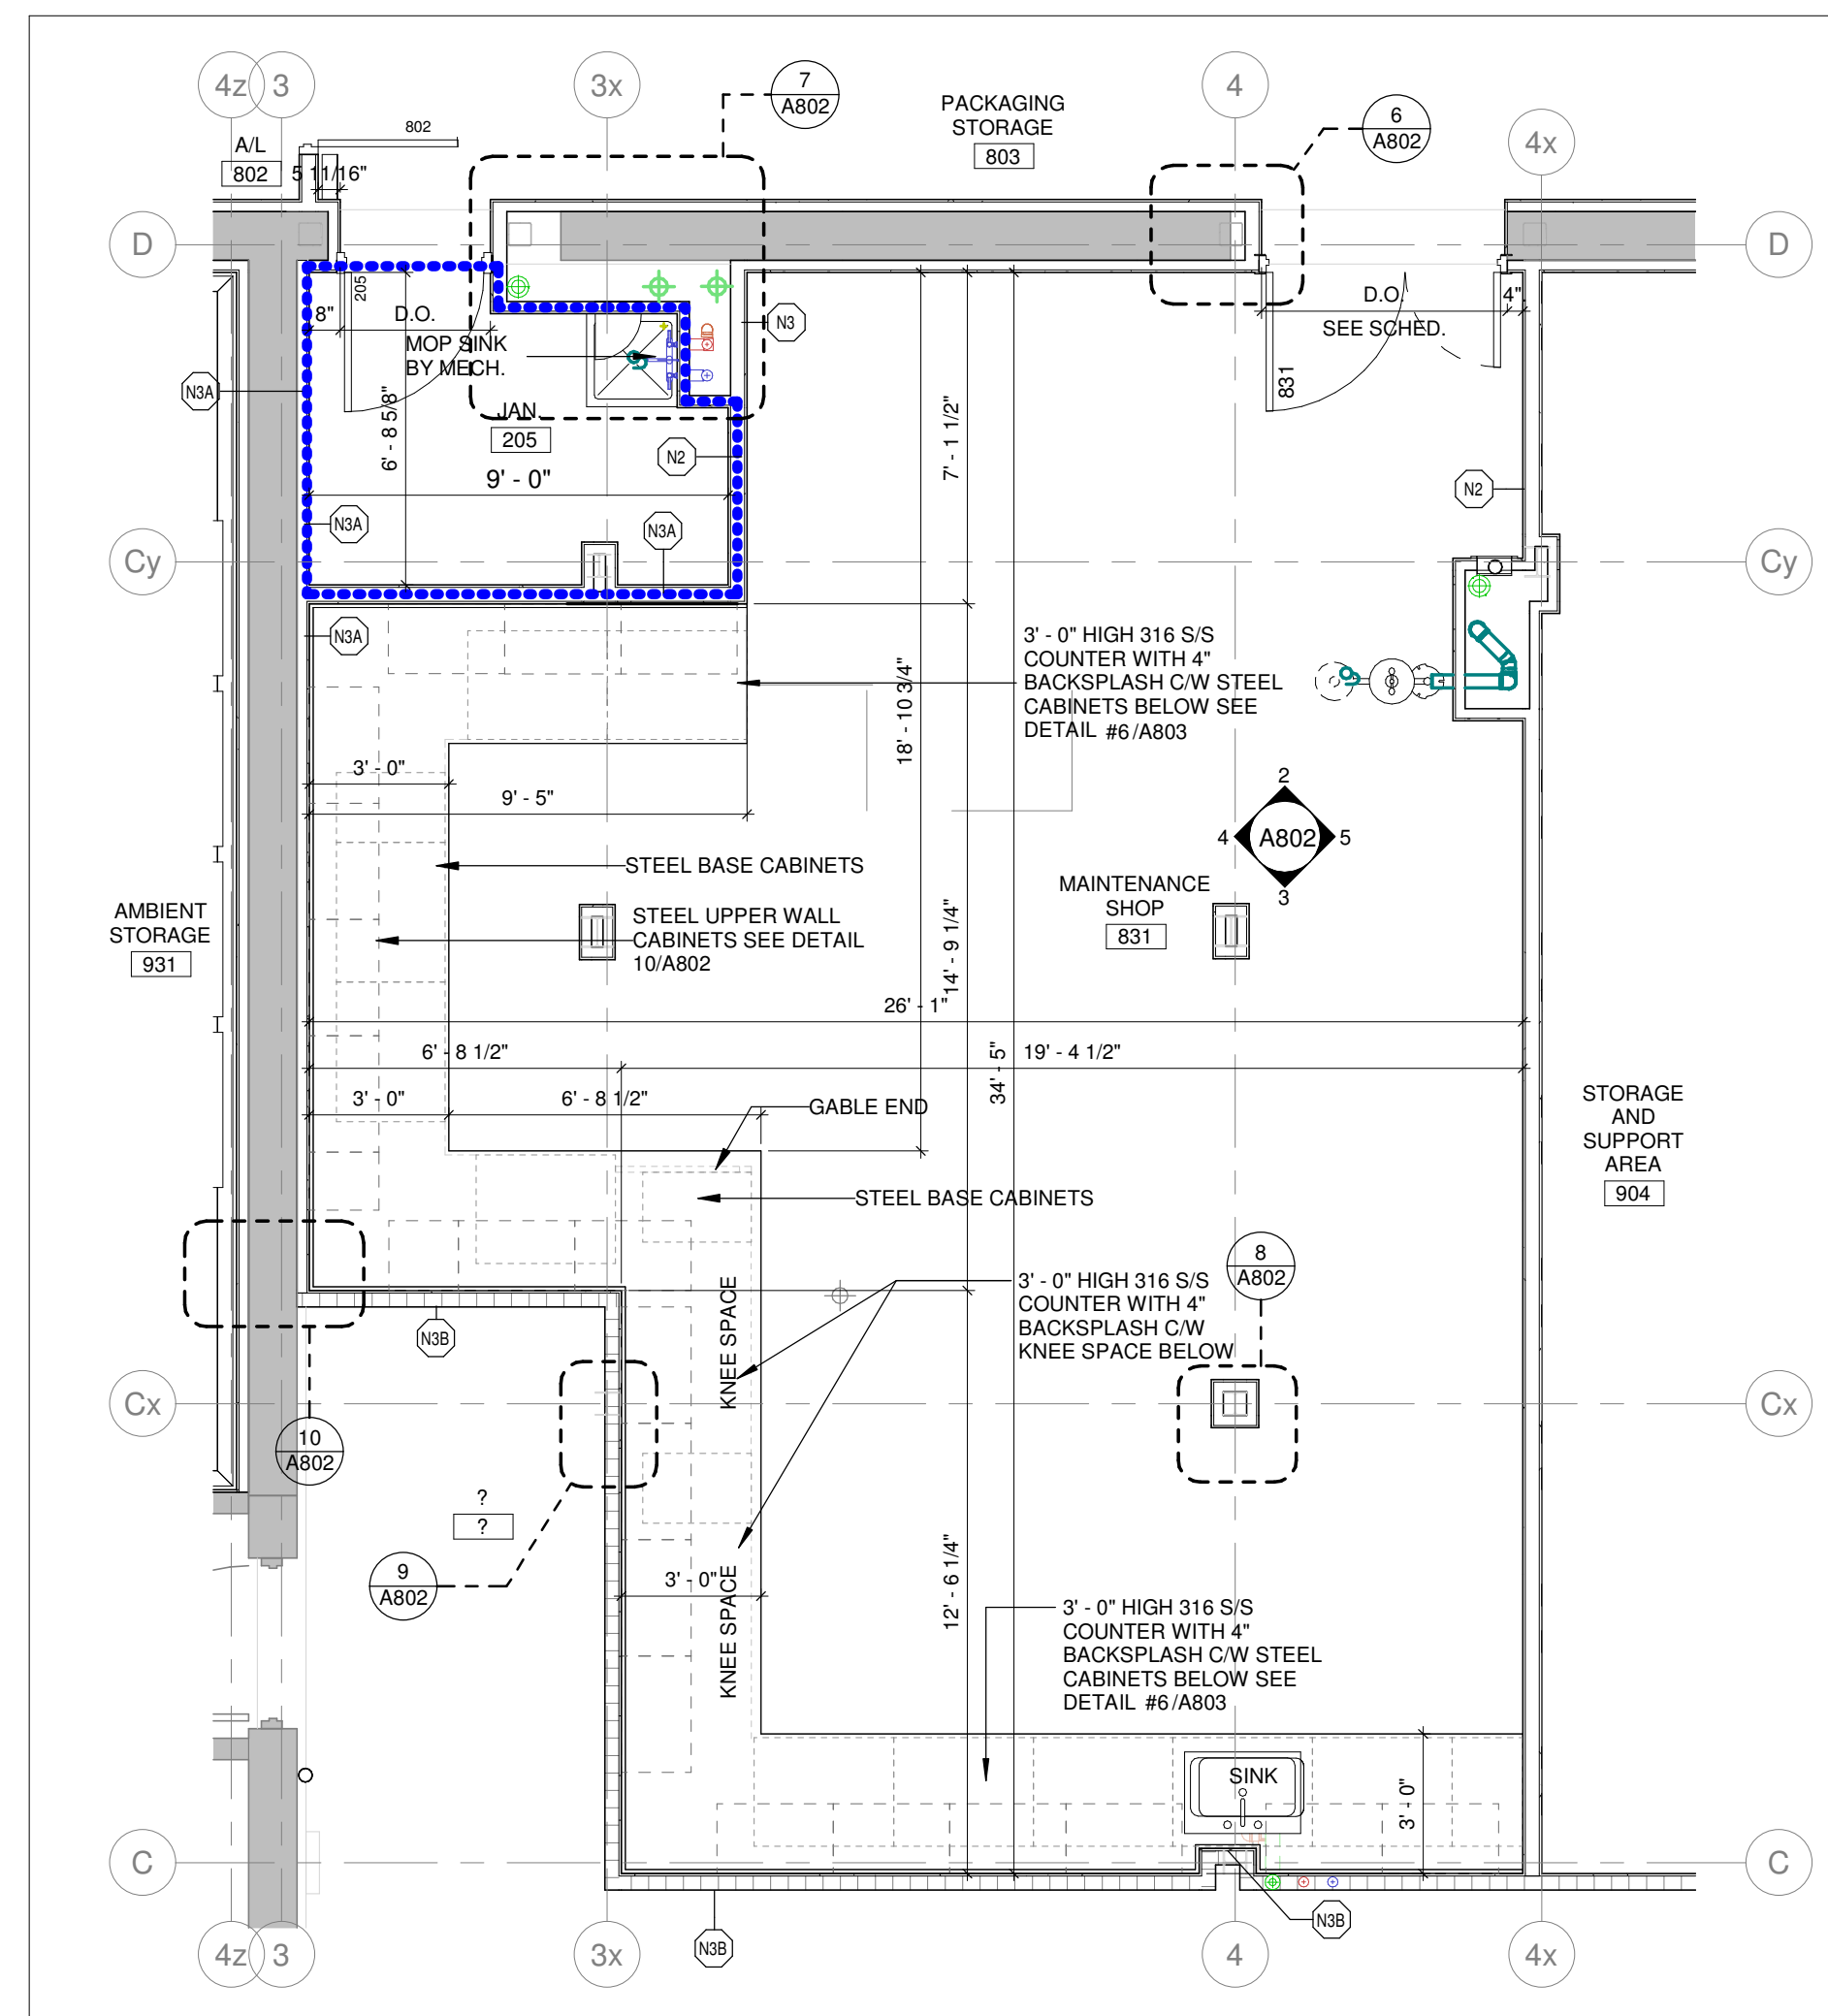


1 ENLARGED MAINTENANCE SHOP PLAN
1 1/4" = 1'-0"

sanofi

Sanofi Pasteur, 1755 Steeles Avenue West, Toronto, Ontario M2R3T4

CONFIDENTIAL - PROPRIETARY INFORMATION
DRAWINGS, SPECIFICATIONS AND RELATED DOCUMENTS ARE INTENDED SOLELY FOR THE USE OF SANOFI PASTEUR LIMITED AND MAY CONTAIN INFORMATION WHICH IS PROPRIETARY TO SANOFI PASTEUR LIMITED. IT IS THE POLICY OF SANOFI PASTEUR LIMITED TO PROTECT ALL INFORMATION WHICH IS PROPRIETARY TO SANOFI PASTEUR LIMITED. ANY UNAUTHORIZED USE, REPRODUCTION, DISTRIBUTION, REPRODUCTION, REVIEW OR COPIING IS PROHIBITED AND MAY BE IN VIOLATION OF THE PATENT ACT AND/OR OTHER APPLICABLE LAWS. THIS IS A STRICTLY CONFIDENTIAL, COMMERCIAL AND PROPRIETARY INFORMATION WHICH CONSTITUTES TRADE SECRETS OF Sanofi Pasteur Limited.
VERIFY DIMENSIONS BEFORE USE

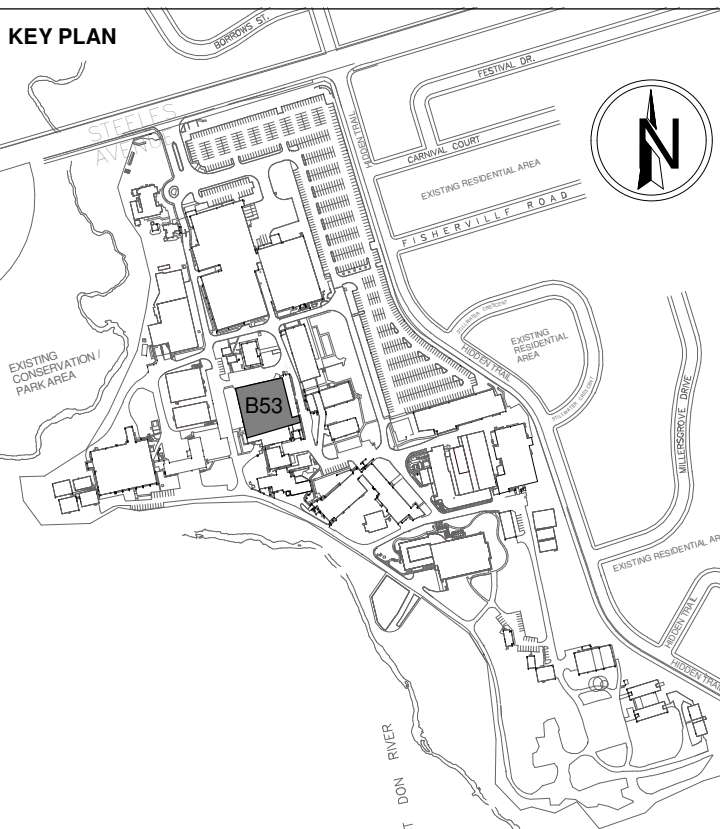

INTERNAL USE

Current Designer:

Version Description:

Version Date:

Approval Date:

Change Control Numbers:

DOCUMENT PERMISSIONS

Approval Date:

Approval Date:

Approval Date:

PROJECT

SANOFI - B53 FORMULATION, FILLING, INSPECTION & PACKAGING (FFIP)
1755 STEELES AVE. W. NORTH YORK, ONTARIO M2R3T4
2210501

PRIME CONSULTANT

Cheme
35 Crawford Cres., Unit 1
P.O. Box 595
Campbellville, ON, L0P 1B0
Tel: (905) 881-7728
Fax: (905) 881-7728
Email: info@cheme.ca

CONSULTANT




wba
architects and engineers Inc.
3 - 530 Rowntree Dairy Road
Vaughan, Ontario L4L 8H2
Tel: (905) 881-7728
Fax: (905) 881-7728
Email: info@wba.ca

CONSULTANT

WALTERFEDY
KITCHENER OFFICE
575 Queen Street South, Suite 111, Kitchener, Ontario, N2M 1A1
T 519.576.2150 F 519.576.5489 walterfedy.com
Copyright © 2021 WalterFedy Inc.

True North:

Project North:

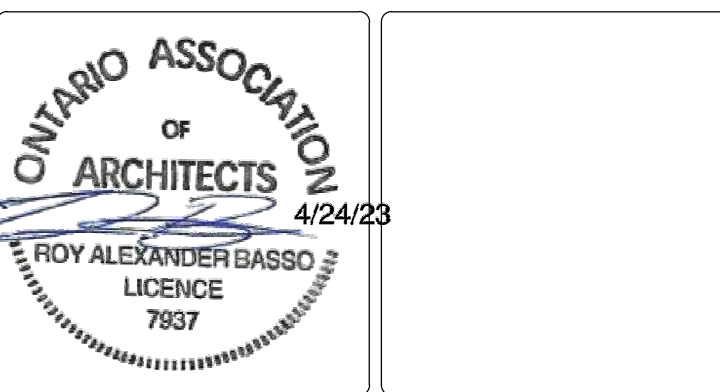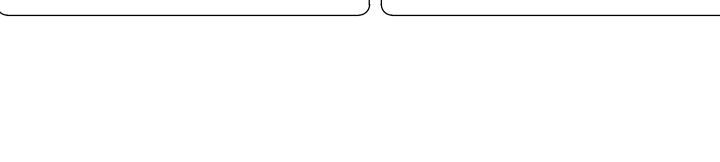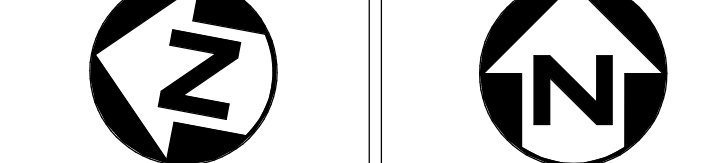

REV	DESCRIPTION	DATE
1	ISSUED FOR AS BUILT	27MAR2020
0	ISSUED FOR CONSTRUCTION	28SEP2020
E	ISSUED FOR PERMIT AND TENDER	21APR2021
D	ISSUED FOR 90% DESIGN REVIEW	17FEB2022
C	ISSUED FOR 80% INTERIM REVIEW	16NOV2022
B	ISSUED FOR FINAL BASIC DESIGN	28APR2022
A	ISSUED FOR 60% DESIGN REVIEW	01APR2022

NEW CEILING TYPES:

	TYPE A: 2 1/4" LAY IN ACOUSTIC PANEL CEILING
	TYPE B: 2 1/4" LAY IN GYPSUM PANEL CEILING w VINYL COATING
	TYPE C: 3" INSULATED PRE-FIN CEILING PANELS
	TYPE D: 1 LAYER OF 5/8" MOLDTOUGH GYP. BRD. w/MEMBRANE BETWEEN LAYERS ON SUSPENDED SUPPORT ASSEMBLY
	TYPE E: 1/2" THK GYP. BRD. CLNG.

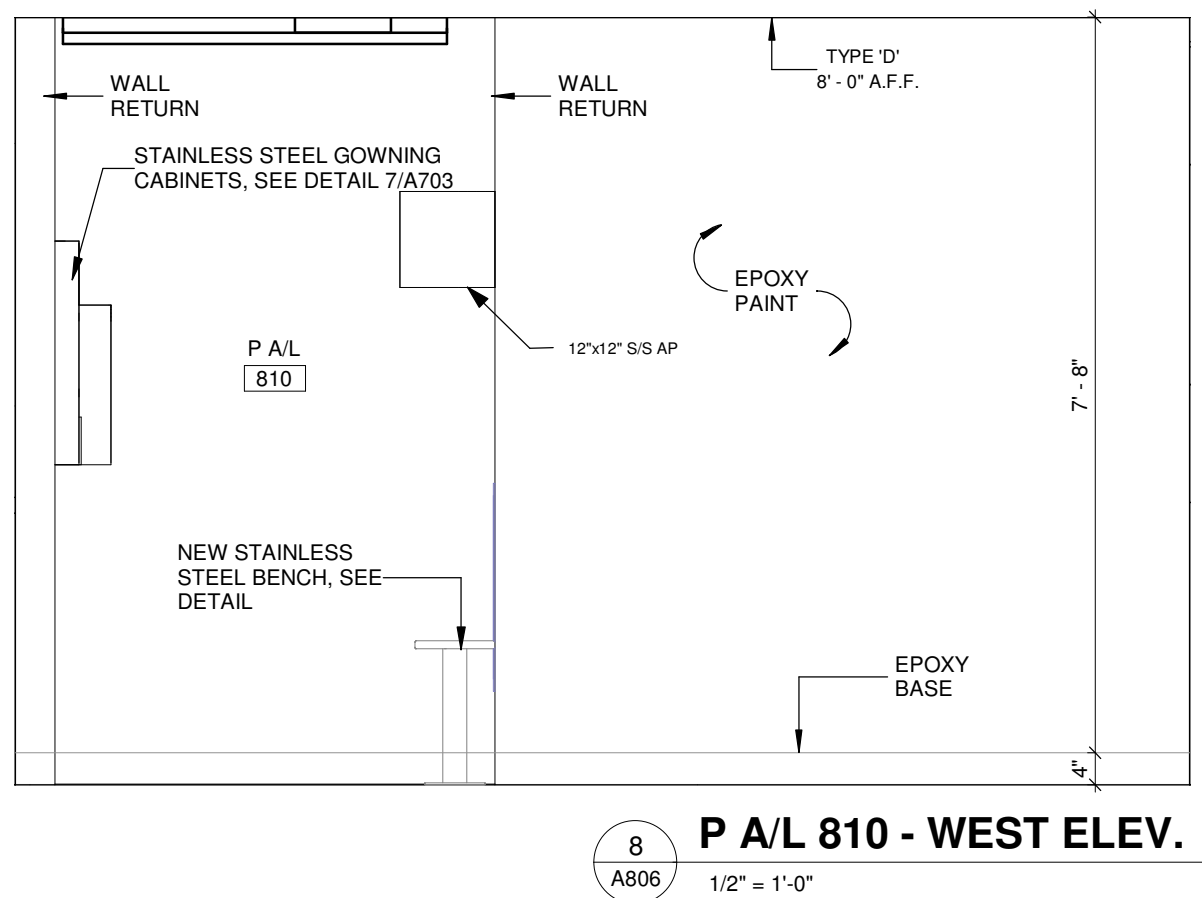

Sanofi Pasteur, 1755 Steeles Avenue West - Toronto, Ontario M2R2S4																																									
CONFIDENTIAL - PROPRIETARY INFORMATION DRAWINGS, SPECIFICATIONS AND RELATED DOCUMENTS ARE INTENDED SOLELY FOR THE USE OF Sanofi Pasteur Limited and MAY CONTAIN INFORMATION WHICH IS UNCLASSIFIED, CONFIDENTIAL, EXEMPT FROM DISCLOSURE UNDER APPLICABLE LAW OR SUBJECT TO COPYRIGHT, ANY UNAUTHORIZED USE, DISCLOSURE, DISTRIBUTION, REPRODUCTION, REVIEW OR COPYING IS PROHIBITED AND MAY BE ILLEGAL. THIS IS SUBJECT TO CONFIDENTIAL, COMMERCIAL AND PROPRIETARY INFORMATION WHICH CONSTITUTES TRADE SECRETS OF Sanofi Pasteur Limited. VERIFY DIMENSIONS BEFORE USE																																									
KEY PLAN																																									
INTERNAL USE Client Designer: Version Description: Version Date: Approval Date: Change Control Numbers:																																									
DOCUMENT PERMISSIONS Approval Code: Approval Date:																																									
PROJECT SANOFI - B53 FORMULATION, FILLING, INSPECTION & PACKAGING (FFIP) 1755 STEELS AVE W - NORTH YORK, ONTARIO M2R2T4 2210501																																									
PRIME CONSULTANT 35 Crawford Cres., Unit 1 P.O. BOX 995 Cambridgeville, ON L0P 1B0 T: (905) 654-9999 F: (905) 654-1111																																									
CONSULTANT 3 - 530 Rosedale Dairy Road Vaughan, Ontario L4L 8M2 Tel.: (905) 881-1318 Fax: (905) 881-7118 email: info@wba-a-e.com																																									
CONSULTANT KITCHENER OFFICE 675 Queen Street South, Suite 111, Kitchener, Ontario, N2M 1A1 T 519 576-2150 F 519 576-5499 walterfedy.com COPYRIGHT © 2021 Walter Fedy Inc.																																									
True North: Project North: 																																									
 ONTARIO ASSOCIATION OF ARCHITECTS 424/23 ROY ALDEN ROSS LICENCE 7937 <table><tr><td></td><td></td></tr><tr><td></td><td></td></tr><tr><td></td><td></td></tr><tr><td></td><td></td></tr><tr><td>3</td><td>ISSUED FOR AS-BUILT</td><td>WBA</td><td>27MAR2026</td></tr><tr><td>2</td><td>ISSUED FOR CON #014R1</td><td>WBA</td><td>26APR2024</td></tr><tr><td>T</td><td>ISSUED FOR CON #014</td><td>WBA</td><td>08MAR2024</td></tr><tr><td>I</td><td>ISSUED FOR CONSTRUCTION</td><td>WBA</td><td>29SEP2023</td></tr><tr><td>C</td><td>ISSUED FOR POST CONTRACT ADDENDUM</td><td>WBA</td><td>11SEP2023</td></tr><tr><td>B</td><td>ISSUED FOR PERMIT AND TENDER</td><td>WBA</td><td>21APR2023</td></tr><tr><td>A</td><td>ISSUED FOR 90% DESIGN REVIEW</td><td>WBA</td><td>17FEB2023</td></tr><tr><td>REVISION</td><td>DESCRIPTION</td><td>DY</td><td>DATE</td></tr></table>										3	ISSUED FOR AS-BUILT	WBA	27MAR2026	2	ISSUED FOR CON #014R1	WBA	26APR2024	T	ISSUED FOR CON #014	WBA	08MAR2024	I	ISSUED FOR CONSTRUCTION	WBA	29SEP2023	C	ISSUED FOR POST CONTRACT ADDENDUM	WBA	11SEP2023	B	ISSUED FOR PERMIT AND TENDER	WBA	21APR2023	A	ISSUED FOR 90% DESIGN REVIEW	WBA	17FEB2023	REVISION	DESCRIPTION	DY	DATE
3	ISSUED FOR AS-BUILT	WBA	27MAR2026																																						
2	ISSUED FOR CON #014R1	WBA	26APR2024																																						
T	ISSUED FOR CON #014	WBA	08MAR2024																																						
I	ISSUED FOR CONSTRUCTION	WBA	29SEP2023																																						
C	ISSUED FOR POST CONTRACT ADDENDUM	WBA	11SEP2023																																						
B	ISSUED FOR PERMIT AND TENDER	WBA	21APR2023																																						
A	ISSUED FOR 90% DESIGN REVIEW	WBA	17FEB2023																																						
REVISION	DESCRIPTION	DY	DATE																																						
CURRENT DRAWING Current Drawer: Current Designer: Current Design Writer:																																									
ORIGINAL DRAWING Original Drawer: Original Design Writer:																																									
LOCATION Bag Number: Bag Floor: Area Functional Use:																																									
TITLE AIRLOCK INTERIOR ELEVATIONS																																									
Scale: AS NOTED Sheet Size: ANSI E																																									
Drawing File Name: 53P-2021-015-A806																																									
Sheet Number: A806																																									
Cust Elec File: Cust Sheet Name:																																									

			DOOR									DOOR SCHEDULE																HARDWARE																			
DOOR NUMBER	SIZE	TYPE	THICKNESS	MATERIAL	FIRE RATING	METAL ASTRAGAL	FINISH	TYPE	MATERIAL	FIRE RATING	FINISH	LOCKSET	LATCH SET	PRIVACY SET	AUTO DOOR OPNER	DEAD BOLT THUMB TURN	PANIC SET	PUSH/PULL	CLOSER	HOLD OPEN W/ CLOSER	BUTT HINGES	FLUSH BOLTS	CONCEALED VERTICAL RODS	12" H KICK PLATE	36" H KICK PLATE	AUTO DOOR BOTTOM	THRESHOLD	WEATHER STRIP	WALL STOP	FLOOR STOP	OVERHEAD STOP	MAG LOCKS	ELECTRIC STRIKE	OCTA POD	REQUEST TO EXIT	CARD READER IN & OUT	CARD READER IN	INTERLOCK	SECURITY DOOR CONTACT	CLEAN TYPE DOORS AND FRAMES	STANDARD DOORS AND FRAMES	COMMENTS					
BASEMENT LEVEL																																															
137	2'-3'-0" x 7'-0"	EXIST		HM	-	-		EXIST.	HM	-	P.T	■ LHD							EXIST			EXIST RHD		■										■	■	■		■							REFER TO NOTE #5		
1224	3'-2" x 7'-0" x 1 3/4"	D3		HM	-	-	P.T	F1	HM	-	P.T	■							■																■	■	■		■								
1225	3'-2" x 7'-0" x 1 3/4"	D3		HM	-	-	P.T	F1	HM	-	P.T	■							■																■	■	■		■								
MAIN LEVEL																																															
205	3'-0" x 7'-0" x 1 3/4"	D3		HM	0 HR	-	P.T	F1	HM	0 HR	P.T	■ ALL			EXISTING		HARDWARE		TO	■	REMAIN	■																									
710	3'-0" x 7'-0" x 1 3/4"	EXIST		HM				EXIST.	HM		P.T	■																																			
713	5'-9" x 8'-4"	SEE SPECS		SEE SPECS																																											
802	2'-3'-0" x 8'-6" x 1 3/4"	D4A	1 3/4"	HM	-	-	P.T	F1	HM	-	P.T					■		■				■																									
802A	2'-3'-0" x 8'-6" x 1 3/4"	D4A	1 3/4"	HM	-	-	P.T	F1	HM	-	P.T					■		■				■																									
805	3'-2" x 7'-0" x 1 3/4"	D3	1 3/4"	HM	-	-	P.T	F1	HM	-	P.T					■		■				■																									
807	3'-2" x 7'-0" x 1 3/4"	D3	1 3/4"	HM	-	-	P.T	F1	HM	-	P.T					■		■				■																									
809	2'-3'-0" x 7'-0" x 1 3/4"	D2A	1 3/4"	HM	-	-	P.T	F2	HM	-	P.T					■		■				■																									
809A	3'-2" x 7'-0" x 1 3/4"	D1	1 3/4"	HM	-	-	P.T	F1	HM	-	P.T					■		■				■																									
810	3'-2" x 7'-0" x 1 3/4"	D2	1 3/4"	HM	-	-	P.T	F2	HM	-	P.T					■		■				■																									
810A	3'-0" x 7'-0" x 1 3/4"	D1	1 3/4"	HM	-	-	P.T	F2	HM	-	P.T					■		■				■																									
810B	3'-0" x 7'-0" x 1 3/4"	D1	1 3/4"	HM	-	-	P.T	F2	HM	-	P.T					■		■				■																									
811	3'-2" x 7'-0" x 1 3/4"	D2	1 3/4"	HM	-	-	P.T	F2	HM	-	P.T					■		■				■																									
811A	3'-2" x 7'-0" x 1 3/4"	D2	1 3/4"	HM	-	-	P.T	F2	HM	-	P.T					■		■				■																									
812	3'-2" x 7'-0" x 1 3/4"	D2	1 3/4"	HM	-	-	P.T	F2	HM	-	P.T					■		■				■																									
820	6'-0" x 7'-0"	SEE SPECS		SEE SPECS																																											
821	3'-2" x 7'-0" x 1 3/4"	D2	1 3/4"	HM	-	-	P.T	F2	HM	-	P.T					■		■				■																									
822	2'-3'-0" x 7'-0" x 1 3/4"	D2A	1 3/4"	HM	-	-	P.T	F2	HM	-	P.T					■		■				■																									
823	2'-3'-0" x 7'-0" x 1 3/4"	D2A	1 3/4"	HM	-	-	P.T	F2	HM	-	P.T					■		■				■																									
824	2'-3'-0" x 7'-0" x 1 3/4"	D2A	1 3/4"	HM	-	-	P.T	F2	HM	-	P.T					■		■				■																									
824A	2'-3'-0" x 7'-0" x 1 3/4"	D2A	1 3/4"	HM	-	-	P.T	F2	HM	-	P.T					■		■				■																									
824B	2'-3'-0" x 7'-0" x 1 3/4"	D2A	1 3/4"	HM	-	-	P.T	F2	HM	-	P.T					■		■				■																									
827	2'-2'-6" x 7'-0" x 1 3/4"	D2A	1 3/4"	HM	-	-	P.T	F1	HM	-	P.T					■		■				■																									
828A	3'-2" x 7'-0" x 1 3/4"	D4	1 3/4"	HM	-	-	P.T	F1	HM	-	P.T					■		■				■																									
828C	3'-2" x 7'-0" x 1 3/4"	D4	1 3/4"	HM	-	-	P.T	F1	HM	-	P.T					■		■				■																									
829	3'-0" x 7'-0" x 1 3/4"	D1	1 3/4"	HM	0 HR	-	P.T	F2	HM	0 HR	P.T					■		■				■																									
831	1'-2'-0" x 7'-0" x 1 3/4" 1'-3'-0" x 7'-0" x 1 3/4"	D5	1 3/4"	HM	-	-	P.T	F1	HM	-	P.T					■		■				■																									
904	2'-3'-0" x 7'-0" x 1 3/4"	D2A	1 3/4"	HM	-	-	P.T	F1	HM	-	P.T					■		■				■																									
904A	2'-3'-0" x 7'-0" x 1 3/4"	D3	1 3/4"	HM	-	-	P.T	F1	HM	-	P.T					■		■				■																									
910	3'-2" x 7'-0" x 1 3/4"	D6	1 3/4"	HM	-	-	P.T	F																																							

ROOM FINISH SCHEDULE-1																											
ROOM NUMBER	ROOM NAME	FLOOR FINISH	BASE	NORTH WALL				EAST WALL				SOUTH WALL				WEST WALL				WALL TO WALL VINYL COVE	CEILING				WALL TO CEILING VINYL COVE	REMARKS	
			MATERIAL	MATERIAL	FINISH	FIRE RATING	MATERIAL	FINISH	FIRE RATING	MATERIAL	FINISH	FIRE RATING	MATERIAL	FINISH	FIRE RATING	MATERIAL	FINISH	FIRE RATING	MATERIAL	FINISH	FIRE RATING	HEIGHT					
BASEMENT LEVEL																											
1224	MECH. ROOM	A.F.S.	VINYL	G.W.B	PT	-	G.W.B.	PT	-	G.W.B.	PT	-	G.W.B.	PT	-	G.W.B.	PT	-	EXP.	-	-	-					
1225	TELECOM ROOM	A.F.S.	VINYL	G.W.B	PT	-	G.W.B.	PT	-	G.W.B.	PT	-	G.W.B.	PT	-	G.W.B.	PT	-	EXP.	-	-	-					
MAIN LEVEL																											
9Q	CORRIDOR	PATCH EXIST. VINYL	PATCH EXIST. VINYL	G.W.B	PT		EXIST.	PT		EXIST.	PT		EXIST.	PT		EXIST.	PT			EXISTING			9'-0"			PATCH EXISTING VINYL FLOORING AND BASE AT REMOVED DOOR ON NORTH SIDE	
205	JAN.	EPOXY 'C'	EPOXY	MTB	W1	0 HR	MTB	W1	0 HR	MTB	W1	0 HR	MTB	W1	0 HR	MTB	W1	0 HR	Yes	MTB	C-1	0 HR	7'-6"	Yes			
713	REF.	EPOXY 'B'	EPOXY	IMP	-	-	IMP	-	-	IMP	-	-	IMP	-	-	IMP	-	-	Yes	IMP	-	-	9'-4" ± 12'-2" 1	Yes			
800	NEW SHIPPING	EPOXY 'B'	VINYL	CONC. BLK.	PT	-	CONC. BLK.	PT	-	CONC. BLK.	PT	-	CONC. BLK.	PT	-	CONC. BLK.	PT	-		EXP	-	-	8'-0" 8'-0"				
801	STAGING	EPOXY 'B'	VINYL	MTB	PT	-	MTB	PT	-	MTB	PT	-	MTB	PT	-	CONC. BLK.	PT	-		LAP 'A'	-	-	8'-0" 8'-0"				
802	A/L	EPOXY 'B'	EPOXY	MTB & W.C.	W1	-	MTB & W.C.	W1	-	MTB & W.C.	W1	-	MTB & W.C.	W1	-	MTB & W.C.	W1	-	Yes	LAP 'B'	-	-	9'-0"				
803	PACKAGING STORAGE	EPOXY 'B'	EPOXY	MTB & W.C.	W1	-	MTB & W.C.	W1	-	MTB & W.C.	W1	-	MTB & W.C.	W1	-	MTB & W.C.	W1	-		LAP 'B'	-	-	8'-0"/9'-0"				
805	ELECTRICAL ROOM	EPOXY 'B'	EPOXY	MTB	W1	-	MTB	W1	-	MTB	W1	-	MTB	W1	-	MTB	W1	-	Yes	EXP.	-	-	± 12'-6 1/2"				
807	PALLETIZER	EPOXY 'B'	EPOXY	MTB & W.C.	W1	-	MTB & W.C.	W1	-	MTB & W.C.	W1	-	MTB & W.C.	W1	-	MTB & W.C.	W1	-	Yes	LAP 'B'	-	-	9'-0"	No			
808	SURVEIL. CORR.	EPOXY 'B'	EPOXY	MTB & W.C.	W1	-	MTB & W.C.	W1	-	MTB & W.C.	W1	-	MTB & W.C.	W1	-	MTB & W.C.	W1	-	Yes	LAP 'B'	-	-	9'-0"	No			
808A	CORR.	EPOXY 'B'	EPOXY	MTB	W1	-	MTB	W1	-	MTB	W1	-	MTB	W1	-	MTB	W1	-	Yes	MTB	C-1	-	8'-0"	Yes			
809	FILLER ROOM	EPOXY 'B'	EPOXY	MTB & W.C.	W1	-	MTB & W.C.	W1	-	MTB & W.C.	W1	-	MTB & W.C.	W1	-	MTB & W.C.	W1	-	Yes	MTB	C-1	-	9'-0"/9'-10"	Yes			
810	P A/L	EPOXY 'B'	EPOXY	MTB	W1	-	MTB	W1	-	MTB	W1	-	MTB	W1	-	MTB	W1	-	Yes	MTB	C-1	-	8'-0"	Yes			
810A	P A/L	EPOXY 'B'	EPOXY	MTB	W1	-	MTB	W1	-	MTB	W1	-	MTB	W1	-	MTB	W1	-	Yes	MTB	C-1	-	8'-8"	Yes			
810B	P A/L	EPOXY 'B'	EPOXY	MTB	W1	-	MTB	W1	-	MTB	W1	-	MTB	W1	-	MTB	W1	-	Yes	MTB	C-1	-	8'-8"	Yes			
811	P A/L IN	EPOXY 'B'	EPOXY	MTB	W1	-	MTB	W1	-	MTB	W1	-	MTB	W1	-	MTB	W1	-	Yes	MTB	C-1	-	9'-0"	Yes			
812	P A/L OUT	EPOXY 'B'	EPOXY	MTB	W1	-	MTB	W1	-	MTB	W1	-	MTB	W1	-	MTB	W1	-	Yes	MTB	C-1	-	9'-0"	Yes			
813	SHIFT Huddle	EPOXY 'B'	EPOXY	MTB & W.C.	W1	-	MTB & W.C.	W1	-	MTB & W.C.	W1	-	MTB & W.C.	W1	-	MTB & W.C.	W1	-	Yes	MTB	C-1	-	8'-8"	Yes			
814	EQUIPMENT/COMPONENT STORAGE	EPOXY 'B'	EPOXY	MTB & W.C.	W1	-	MTB & W.C.	W1	-	MTB & W.C.	W1	-	MTB & W.C.	W1	-	MTB & W.C.	W1	-	Yes	MTB	C-1	-	8'-8"	Yes			
815	CORR.	EPOXY 'B'	EPOXY	MTB & W.C.	W1	-	MTB & W.C.	W1	-	MTB & W.C.	W1	-	MTB & W.C.	W1	-	MTB & W.C.	W1	-	Yes	MTB	C-1	-	8'-8"	Yes			
816	W A/L OUT	EPOXY 'B'	EPOXY	MTB	W1	-	MTB	W1	-	MTB	W1	-	MTB	W1	-	MTB	W1	-	Yes	MTB	C-1	-	9'-0"	Yes			
817	W A/L OUT	EPOXY 'B'	EPOXY	MTB	W1	-	MTB	W1	-	MTB	W1	-	MTB	W1	-	MTB	W1	-	Yes	MTB	C-1	-	9'-0"	Yes			
818	FORMULATION SUITE	EPOXY 'B'	EPOXY	MTB & W.C.	W1	-	MTB & W.C.	W1	-	MTB & W.C.	W1	-	MTB & W.C.	W1	-	MTB & W.C.	W1	-	Yes	MTB	C-1	-	8'-10"	Yes			
819	P A/L O	EPOXY 'B'	EPOXY	MTB & W.C.	W1	-	MTB & W.C.	W1	-	MTB & W.C.	W1	-	MTB & W.C.	W1	-	MTB & W.C.	W1	-	Yes	MTB	C-1	-	8'-0"	Yes			
820	COLDROOM	EPOXY 'B'	EPOXY	IMP	-	-	IMP	-	-	IMP	-	-	IMP	-	-	IMP	-	-	Yes	IMP	-	-	8'-0"	Yes			
821	P A/L O	EPOXY 'B'	EPOXY	MTB & W.C.	W1	-	MTB & W.C.	W1	-	MTB & W.C.	W1	-	MTB & W.C.	W1	-	MTB & W.C.	W1	-	Yes	MTB	C-1	-	8'-0"	Yes			
822	M A/L IO	EPOXY 'B'	EPOXY	MTB & W.C.	W1	-	MTB & W.C.	W1	-	MTB & W.C.	W1	-	MTB & W.C.	W1	-	MTB & W.C.	W1	-	Yes	MTB	C-1	-	9'-0"	Yes			
823	M A/L IO	EPOXY 'B'	EPOXY	MTB & W.C.	W1	-	MTB & W.C.	W1	-	MTB & W.C.	W1	-	MTB & W.C.	W1	-	MTB & W.C.	W1	-	Yes	MTB	C-1	-	9'-0"	Yes			
824	FORM/FILL SUPPORT	EPOXY 'B'	EPOXY	MTB & W.C.	W1	-	MTB & W.C.	W1	-	MTB & W.C.	W1	-	MTB & W.C.	W1	-	MTB & W.C.	W1	-	Yes	MTB	C-1	-	9'-0"	Yes			
827	NEW A/L	EPOXY 'B'	EPOXY	MTB & W.C.	W1	-	MTB & W.C.	W1	-	MTB & W.C.	W1	-	MTB & W.C.	W1	-	MTB & W.C.	W1	-		MTB			8'-7"	Yes			
828A	CORR.	EPOXY 'B'	EPOXY	MTB & W.C.	W1	-	MTB & W.C.	W1	-	MTB & W.C.	W1	-	MTB & W.C.	W1	-	MTB & W.C.	W1	-		LAP 'A'	-	-	8'-8"				
828B	CORR.	EPOXY 'B'	EPOXY	MTB & W.C.	W1	-	MTB & W.C.	W1	-	MTB & W.C.	W1	-	MTB & W.C.	W1	-	MTB & W.C.	W1	-		LAP 'A'	-	-	8'-8"				
828C	CORR.	EPOXY 'B'	EPOXY	MTB & W.C.	W1	-	MTB & W.C.	W1	-	MTB & W.C.	W1	-	MTB & W.C.	W1	-	MTB & W.C.	W1	-		LAP 'A'	-	-	8'-2"				
829	JAN.	EPOXY 'B'	EPOXY	MTB & W.C.	W1	0 HR	MTB & W.C.	W1	0 HR	MTB & W.C.	W1	0 HR	MTB & W.C.	W1	0 HR	MTB & W.C.	W1	0 HR	Yes	MTB	C-1	0 HR	9'-0"	Yes			
831	MAINTENANCE SHOP	EPOXY 'B'	EPOXY	MTB & W.C.	W1	-	MTB & W.C.	W1	-	MTB	W1	-	MTB & W.C.	W1	-	MTB & W.C.	W1	-	Yes	LAP 'A'	-	-	9'-0"				
904	STORAGE AND SUPPORT AREA	EPOXY 'B'	EPOXY	MTB & W.C.	W1	-	MTB & W.C.	W1	-	MTB & W.C.	W1	-	MTB & W.C.	W1	-	MTB & W.C.	W1	-		LAP 'B'	-	-	8'-6"				
907	OFFICE	VINYL	VINYL	G.W.B	PT	-	G.W.B.	PT	-	G.W.B.	PT	-	G.W.B.	PT	-	G.W.B.	PT	-		LAP 'A'	-	-	9'-0"				
910	WASTE STAGING	A.F.S.	VINYL	CONC. BLK.	PT	-	CONC. BLK.	PT	-	CONC. BLK.	PT	-	CONC. BLK.	PT	-	CONC. BLK.	PT	-		EXP.	-	-	± 12'-6 1/2"				
910A	A/L	EPOXY 'B'	VINYL	MTB	PT	-	MTB	PT	-	MTB	PT	-	MTB	PT	-	MTB	PT	-		LAP 'A'	-	-	10'-0"				
916	WOMEN'S LOCKERS	EPOXY 'B'	EPOXY	MTB	W1	-	MTB	W1	-	MTB	W1	-	MTB	W1	-	MTB	W1	-	No	MTB	C-1	-	9'-0"	No			
917	MEN'S LOCKER	EPOXY 'B'	EPOXY	MTB	W1	-	MTB	W1	-	MTB	W1	-	MTB	W1	-	MTB	W1	-	No	MTB	C-1	-	8'-8"	No			
918	W.C.	EXIST.	EXIST.	EXIST.	PT		EXIST.	PT		EXIST.	PT		EXIST.	PT		EXIST.	PT			EXISTING			9'-0"				
919	A/L	EXIST.	EXIST.	EXIST.	PT		EXIST.	PT		EXIST.	PT		EXIST.	PT		EXIST.	PT			EXISTING			9'-0"				
920	A/L	EXIST.	EXIST.	EXIST.	PT		EXIST.	PT		EXIST.	PT		EXIST.	PT		EXIST.	PT			EXISTING			9'-0"				
921	MEN'S WASHROOM	EXIST.	EXIST.	EXIST.	PT		EXIST.	PT		EXIST.	PT		EXIST.	PT		EXIST.	PT			EXISTING			9'-0"				
922	WOMEN'S WASHROOM	EXIST.	EXIST.	EXIST.	PT		EXIST.	PT		EXIST.	PT		EXIST.	PT		EXIST.	PT			EXISTING			9'-0"				
923	A/L	EXIST.	EXIST.	EXIST.	PT		EXIST.	PT		EXIST.	PT		EXIST.	PT		EXIST.	PT			EXISTING			9'-0"				
924	A/L	EXIST.	EXIST.	EXIST.	PT		EXIST.	PT		EXIST.	PT		EXIST.	PT		EXIST.	PT			EXISTING			8'-0"				
926	ENTRY	EXIST.	EXIST.	EXIST.	PT		EXIST.	PT		EXIST.	PT		EXIST.	PT		EXIST.	PT			EXISTING			8'-11"				
927	GENERAL OFFICE	EXIST.	EXIST.	EXIST.	PT		EXIST.	PT		EXIST.	PT		EXIST.	PT		EXIST.	PT			EXISTING			8'-4"				
928	KITCHENETTE	EXIST.	EXIST.	EXIST.	PT		EXIST.	PT		EXIST.	PT		EXIST.	PT		EXIST.	PT			EXISTING			8'-6"				
929	OFFICE	VINYL	VINYL	G.W.B	PT	-	G.W.B.	PT	-	G.W.B.	PT	-	G.W.B.	PT	-	G.W.B.	PT	-		LAP 'A'	-	-	8'-5"				
930	MEETING	VINYL	VINYL	G.W.B	PT	-	G.W.B.	PT	-	G.W.B.	PT	-	G.W.B.	PT	-	G.W.B.	PT	-		LAP 'A'	-	-	8'-0"				
931	AMBIENT STORAGE	VINYL	VINYL	MTB	PT	-	MTB	PT	-	MTB	PT	-	MTB	PT	-	MTB	PT	-		LAP 'A'	-	-	8'-0"				
1320	STORAGE ROOM	EXIST.	EXIST.	EXIST.	PT		EXIST.	PT		EXIST.	PT		EXIST.	PT		G.W.B.	PT			EXISTING			9'-0"				
PENTHOUSE LEVEL																											
1300	MECHANICAL PENTHOUSE	EPOXY 'B'	EPOXY	EXIST AND NEW SIDING			EXIST AND NEW SIDING			EXIST AND NEW SIDING			EXIST AND NEW SIDING			EXIST AND NEW SIDING				EXP.			± 12'-2"				
UPPER PENTHOUSE ROOF LEVEL																											
1400	NEW ROOF ENCLOSURE	EPOXY 'B'	EPOXY	NEW SIDING			NEW SIDING			NEW SIDING			NEW SIDING			NEW SIDING				EXP.			± 13'-7"				

ACST - ACOUSTIC
AFF - ABOVE FLOOR FINISH
A.F.S. - ASHFORD FORMULA SEALER
ALUM. - ALUMINUM
BLK. - BLOCK
BLDG. - BUILDING
CARPET - CARPET TILE
CLG. - CEILING
CEM. BRD. - CEMENT BOARD
CERT. - CERAMIC TILE
CLR. - CLEAR
CMU - CONCRETE MASONRY UNIT
COL. - COLUMN
CONC. - CONCRETE
CONC. BLK. - CONCRETE BLOCK
CW - COMPLETE WITH
E - EXTERIOR
EPOXY FLR - EPOXY FLR